

US Army Corps of Engineers
 San Francisco District
 450 Market Street
 San Francisco, CA 94102

DISCLAIMER: The United States Government furnishes no warranty, expressed or implied, concerning the accuracy, completeness, or reliability of this information. The user is responsible for the results of any use of this information. The user is responsible for the results of any use of this information. The user is responsible for the results of any use of this information.


NAD 83 CHANNEL ANGLE POINTS

Station	Δ PT	X	Y	Δ PT	X	Y	Δ PT	X	Y		
1	0408873.57	230046.64	47	0404920.47	228514.44	83	0404298.27	225227.24	139	0404190.67	2287601.84
2	0505024.67	2298956.64	48	0404930.77	2284491.14	94	0404574.57	2256380.54	140	0404924.67	2287705.64
3	0505023.27	2298929.34	49	0404928.77	2283841.84	95	0404820.57	2256914.24	141	0404210.67	2288166.44
4	0505030.17	2299201.14	50	0404928.97	2283148.54	96	0404181.27	2257566.34	142	0404922.87	2288516.44
5	0505030.27	2299393.74	51	0404820.67	2279884.34	97	0404116.17	2258023.54	143	0404883.17	2289301.14
6	0505036.57	2299292.84	52	0404950.87	2278592.34	98	0404957.87	2258659.04	144	0404860.27	2290109.14
7	0505022.27	2299176.84	53	0404961.87	2277596.34	99	0404216.47	2260379.94	145	0404861.57	2290447.34
8	0505016.57	2299074.94	54	0404824.67	2276357.34	100	0404339.47	2261458.94	146	0404756.57	2290261.34
9	0505010.67	2298979.84	55	0404734.67	2275096.34	101	0404309.17	2262182.24	147	0404887.57	2290758.24
10	0505015.67	2298984.34	56	0404769.67	2274999.34	102	0404008.17	2263335.04	148	0404921.67	2290872.64
11	0505037.67	2298200.34	57	0404816.67	2274013.34	103	0404056.67	2263787.24	149	0404932.87	2291081.64
12	0505043.67	2297901.34	58	0404885.67	2273086.34	104	0404535.87	2264731.14	150	0404982.67	2291392.64
13	0505040.67	2297791.34	59	0404874.67	2272932.34	105	0404392.17	2265208.54	151	0404759.67	2291553.64
14	0404965.67	2298886.34	60	0404027.67	2274440.34	106	0404363.87	2266814.94	152	0404988.27	2292043.64
15	0404982.97	2298190.84	61	0404887.67	2274244.34	107	0404241.77	2268207.44	153	0505071.17	2292414.14
16	0404741.87	2298286.34	62	0404927.67	2273971.34	108	0404271.07	2269896.74	154	0505078.67	2292731.34
17	0404902.67	2298116.54	63	0404289.67	2273516.34	109	0404765.47	2269501.94	155	0404997.67	2292940.34
18	0404902.67	2298425.54	64	0404177.67	2273546.34	110	0404425.07	2270626.74	156	0404759.67	2293176.34
19	0404910.67	2298461.94	65	0404159.67	2271791.34	111	0404470.17	2271906.74	157	0404916.67	2293271.34
20	0404935.47	2298321.84	66	0404152.67	2270640.34	112	0404184.17	2272583.44	158	0404942.27	2293419.44
21	0404937.67	2298366.34	67	0404185.57	2269548.54	113	0404209.87	2273580.14	159	0404939.67	2293470.34
22	0505093.67	2298308.34	68	0404237.67	2268724.04	114	0404278.34	2274606.64	160	0404937.67	2293481.34
23	0505021.67	2297725.34	69	0404235.67	2268399.34	115	0404364.07	2274336.34	161	0404937.67	2293581.34
24	0505058.67	2298131.34	70	0404321.47	2267775.44	116	0404368.57	2274221.74	162	0404236.17	2293496.34
25	0404982.47	2297121.44	71	0404292.47	2266266.44	117	0404915.47	2273731.54	163	0404932.27	2293587.34
26	0404743.97	2297148.14	72	0404617.67	2264671.34	118	0404821.07	2273900.74	164	0404905.67	2293511.34
27	0404949.27	2297102.14	73	0404610.57	2263171.04	119	0404808.77	2274113.54	165	0404778.67	2293621.34
28	0404965.77	2296811.74	74	0404114.97	226317.64	120	0404754.97	2274611.64	166	0404984.74	2293681.54
29	0404939.07	2297073.64	75	0404408.67	2262196.34	121	0404785.87	2274225.44	167	0505030.17	2293716.74
30	0404911.67	2296976.74	76	0404439.67	2261455.34	122	0404114.07	2274949.54	168	0505033.67	2293791.74
31	0404937.37	2296422.44	77	0404317.67	2260384.34	123	0404226.67	2275628.34	169	0505032.97	2293817.94
32	0404879.07	2296113.14	78	0404901.67	2258993.34	124	0404279.57	2276384.64	170	0505082.17	2293875.14
33	0404905.17	2295816.14	79	0404860.67	2258492.34	125	0404409.57	2276901.84	171	0505084.34	2293964.34
34	0404982.87	2295887.44	80	0404115.47	2258219.34	126	0404724.37	2279191.74	172	0505093.27	2294105.54
35	0404900.67	2295543.54	81	0404227.87	2257612.54	127	0404106.27	2281073.74	173	0505168.77	2294211.54
36	0404920.67	2295276.54	82	0404872.97	2257005.84	128	0404165.47	2281483.74	174	0505272.17	2294339.34
37	0404939.67	2294913.34	83	0404649.57	2256449.54	129	0404122.77	2282492.54	175	0505237.67	2294486.04
38	0404934.67	2294738.34	84	0404932.27	2255984.24	130	0404364.97	2284113.94	176	0505237.67	2294633.04
39	0404925.67	2294556.34	85	0404955.17	2255482.84	131	0404937.87	2285554.34	177	0505172.17	2294782.04
40	0404947.67	2294276.34	86	0404207.47	2254999.84	132	0404230.87	2286937.34	178	0404967.47	2294907.94
41	0404920.67	2293931.34	87	0404556.47	2254742.94	133	0404875.07	2288369.14	179	0404909.17	2295007.14
42	0404967.67	2293625.34	88	0404864.47	2254383.94	134	0404967.47	2289820.44			
43	0404786.67	2293239.34	89	0404776.47	2254081.94	135	0404959.77	2291251.54			
44	0404924.67	2292828.34	90	0404545.77	2253890.64	136	0404865.57	2292762.74			
45	0404926.67	2292583.34	91	0404104.57	2253601.44	137	0404879.77	2294298.14			
46	0404959.67	2292326.34	92	0404463.57	2253389.24	138	0404886.47	2295831.64			

NAD 83 CENTERLINE ANGLE POINTS

Station	Δ PT	X	Y	Δ PT	X	Y
1	0404941.67	2300026.94	49	0404941.67	2285525.34	
2	0404996.07	2299832.24	50	0404950.57	2285335.44	
3	0505021.77	2299806.14	51	0404947.87	2284552.54	
4	0505021.37	2299803.84	52	0404914.77	2283887.14	
5	0505031.17	2299391.54	53	0404921.77	2283156.14	
6	0505032.17	2299310.24	54	0404917.67	2282116.14	
7	0505197.07	2299199.14	55	0404872.57	2281898.04	
8	0505127.97	2299090.24	56	0404859.07	2281660.14	
9	0505092.67	2298961.04	57	0404830.67	2281761.04	
10	0505118.87	2298884.74	58	0404824.17	2281766.34	
11	0505038.87	2298188.84	59	0404816.97	2281648.44	
12	0505041.67	2297999.54	60	0404789.27	2281608.84	
13	0505067.67	2297903.34	61	0404762.37	2281655.44	
14	0404990.47	2297868.44	62	0404681.77	2281603.44	
15	0404981.77	2296196.14	63	0404583.37	2278553.54	
16	0404967.67	2295983.84	64	0404485.07	2275332.34	
17	0404982.67	2295148.94	65	0404988.17	2274481.04	
18	0404982.67	2294828.44	66	0404967.37	2274290.34	
19	0404985.27	2294466.14	67	0404962.97	2274015.64	
20	0404913.87	2294370.84	68	0404249.97	2273548.24	
21	0404987.17	2293288.64	69	0404151.97	2271799.04	
22	0404758.67	2293221.34	70	0404175.37	2270533.54	
23	0505063.67	2292989.34	71	0404181.47	2269525.24	
24	0505148.17	2292728.04	72	0404231.97	2268710.44	
25	0505106.67	2292401.94	73	0404254.77	2268303.34	
26	0505023.67	2292331.14	74	0404242.67	2268252.44	
27	0404993.57	2291537.54	75	0404192.87	2266237.54	
28	0404713.07	2291370.44	76	0404076.77	2264701.24	
29	0404936.07	2291051.84	77	0404108.57	2263779.14	
30	0404943.67	2290942.14	78	0404061.57	2263326.34	
31	0404913.27	2290730.94	79	0404038.97	2262189.24	
32	0404979.07	2290599.94	80	0404389.57	2261457.14	
33	0404987.47	2290534.84	81	0404987.07	2261362.14	
34	0404840.67	2290111.14	82	0404058.47	2258826.14	
35	0404868.27	2289308.84	83	0404071.27	2258575.64	
36	0404944.67	2288995.94	84	0404158.77	2258117.44	
37	0404861.77	2288529.24	85	0404210.77	2257586.34	
38	0404925.67	2288221.44	86	0404851.27	2256900.04	
39	0404901.67	2288140.84	87	0404617.07	2256415.94	
40	0404913.67	2287847.84	88	0404634.47	2255244.34	
41	0404919.17	2287770.94	89	0404614.37	2253886.04	
42	0404922.17	2287579.94	90	0404515.37	2248600.64	
43	0404913.67	2287282.24	91	0404551.07	2247016.84	
44	0404866.17	2286782.04	92	0404819.87	2243829.54	
45	0404867.77	2286523.44				
46	0404702.07	2286224.34				
47	0404899.87	2285997.74				
48	0404925.67	2285762.84				

Chart Date: Jun 28, 2022
Designed by: PDT
Drawn by: PDT
Checked by: PDT
Surveyed by: LT COLONEL C.E. DISTRICT ENGINEER
Plotted by: Hydro Survey Team Leader
Recommended: Chief, Hydro Survey Section
Approved: Chief, Construction Branch

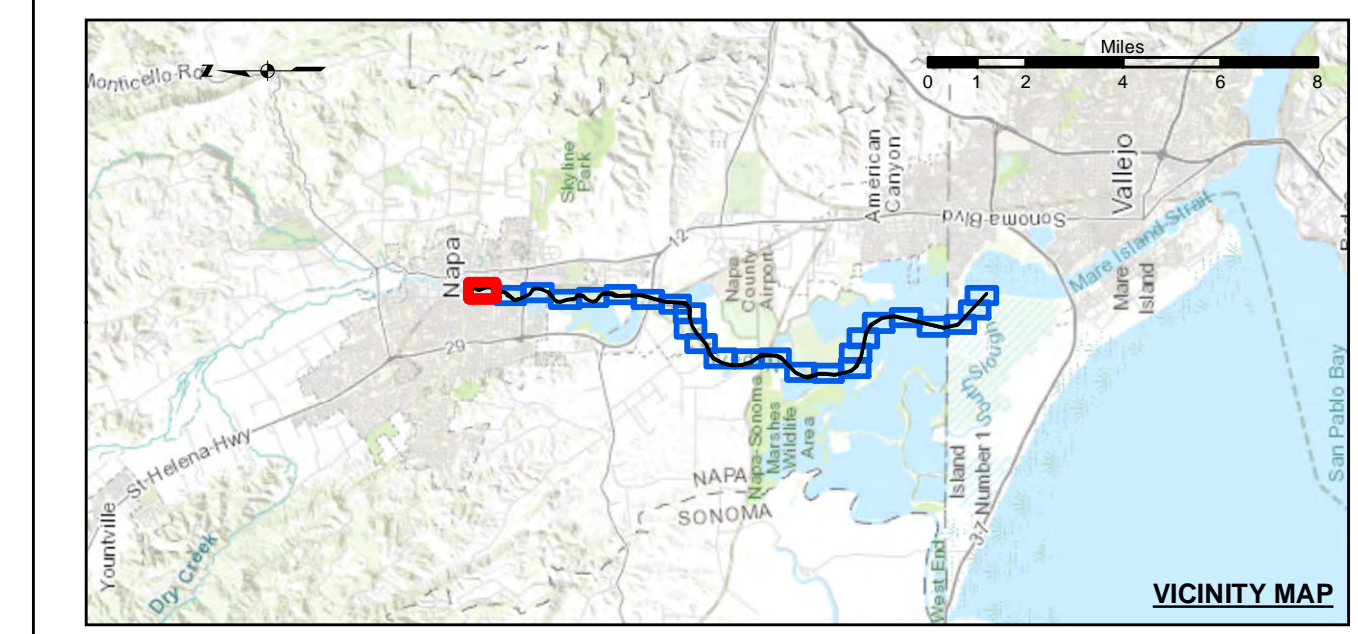

Federal Navigation Channel	Beacon, General
Shoaling Area	Obstruction Point
Placement Area	Navigation Buoy
Anchorage Area	Navigation Buoy
Wreck Area	Shoalest Sounding*
Submerged Wreck	
Angle Point	

Contours


- 10 (Black line)
- 9 (Green line)
- 8 (Blue line)
- 7 (Cyan line)
- 6 (Red line)

NOTES:
 HORIZONTAL COORDINATE SYSTEM:
 NORTH AMERICAN DATUM OF 1983 (NAD83), PROJECTED TO THE STATE PLANE COORDINATE SYSTEM (SPCS), CALIFORNIA ZONE II. DISTANCE UNITS IN U.S. SURVEY FEET.

VERTICAL DATUM:
 SOUNDINGS ARE SHOWN IN FEET AND INDICATE DEPTHS BELOW MEAN LOWER LOW WATER.

THE INFORMATION DEPICTED ON THIS MAP REPRESENTS THE RESULTS OF A SURVEY CONDUCTED ON THE DATE INDICATED AND CAN ONLY BE CONSIDERED TO REPRESENT THE GENERAL CONDITION EXISTING AT THAT TIME.

PLANE GRID, BEARING AND COORDINATES ARE BASED ON THE STATE OF CALIFORNIA COORDINATE SYSTEM.
 LAMBERT CONFORMAL PROJECTION,

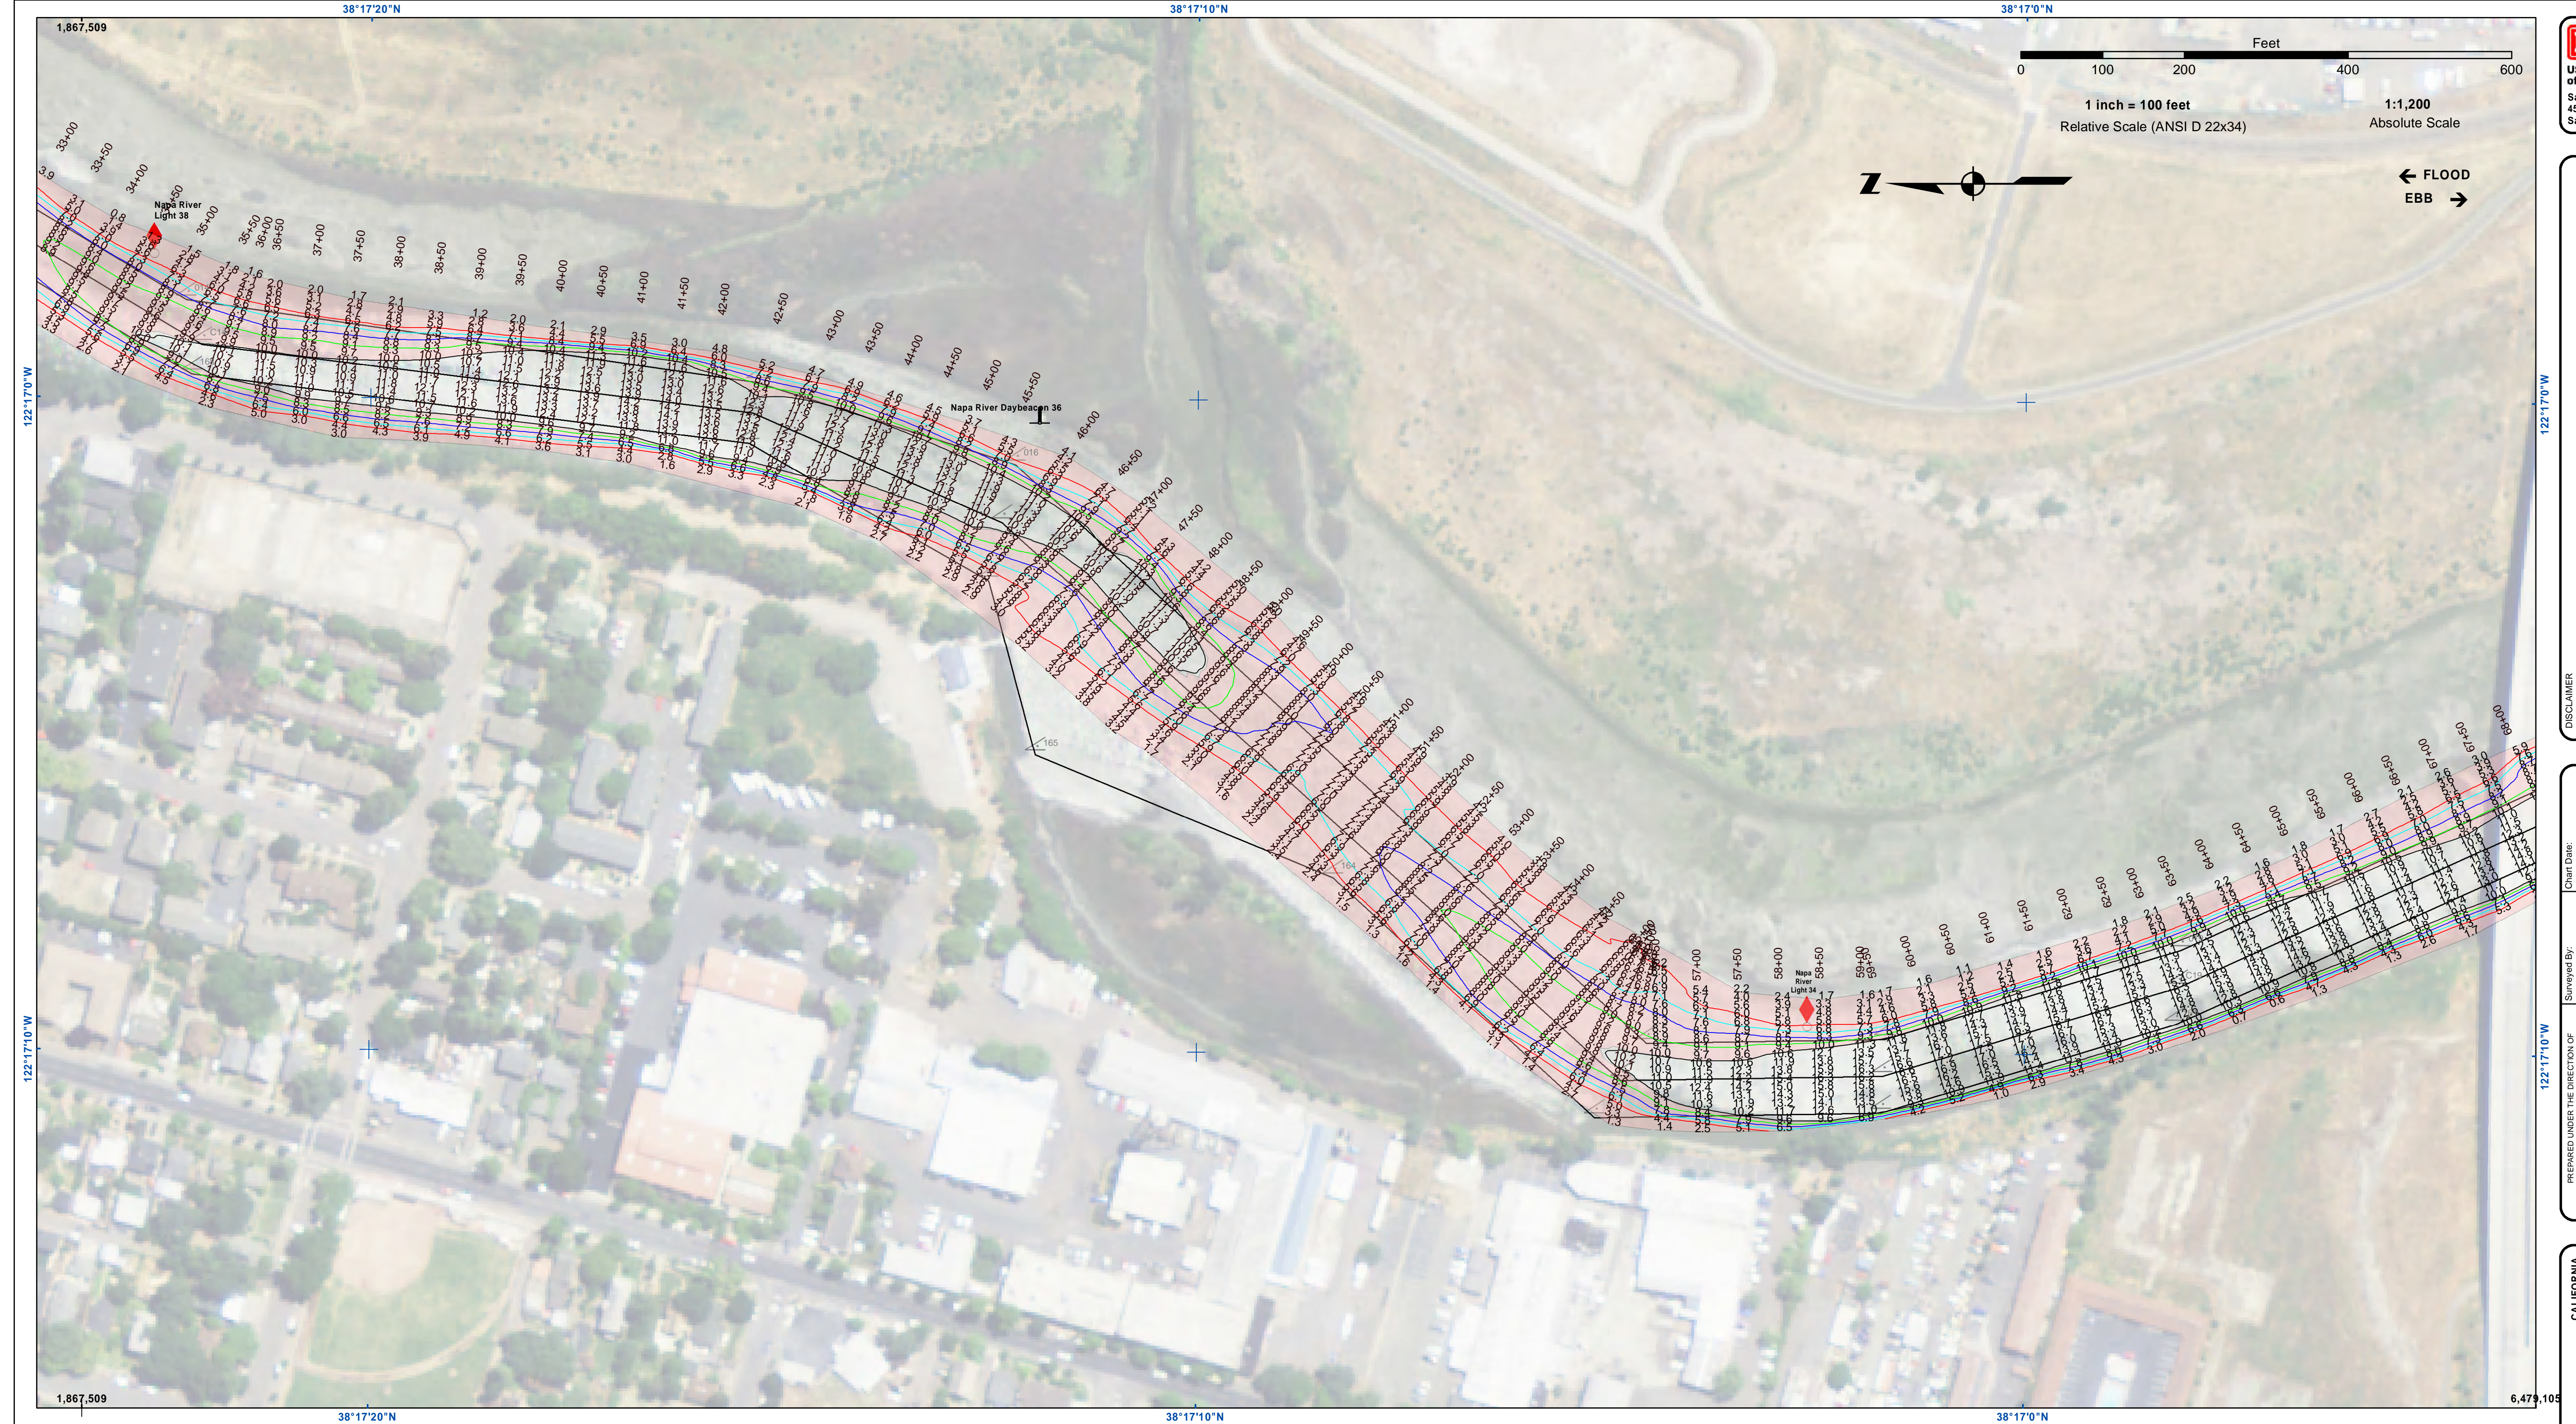


US Army Corps of Engineers
 San Francisco District
 450 Market Street
 San Francisco, CA 94102

DISCLAIMER
 The United States Government furnishes no warranty, expressed or implied, concerning the accuracy, completeness, or reliability of this information. The user is responsible for the results of any application of the data for other than its intended purpose. These data belong to the Government. Therefore, the recipient may not transfer these data to others without also transferring this disclaimer.

Chart Date:	Jun 28, 2022
Designed by:	PDT
Drawn by:	PDT
Surveyed By:	KEVIN P. ARNETT
Plotted By:	PDT
Checked By:	PDT
Approved:	Chief, Construction Branch

CALIFORNIA
 NAPA COUNTY
**NAPA RIVER
 UPPER NAPA
 CONDITION SURVEY**
 14-15 JUNE 2022


**Sheet
 Reference
 Number**
 2 of 25

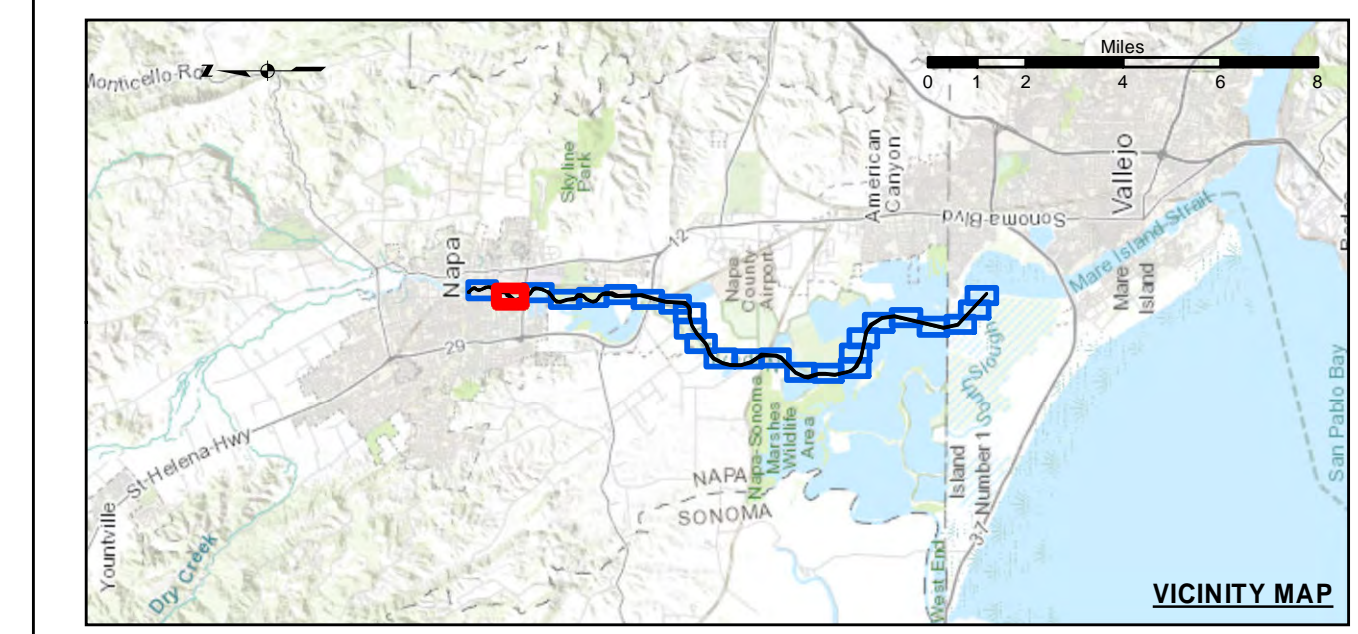

Federal Navigation Channel	Beacon, General	Contours
Shoaling Area	Obstruction Point	
Placement Area	Navigation Buoy	
Anchorage Area	Navigation Buoy	
Wreck Area	Shoalest Sounding*	
Submerged Wreck		
Angle Point		-10
		-9
		-8
		-7
		-6

NOTES:
 HORIZONTAL COORDINATE SYSTEM:
 NORTH AMERICAN DATUM OF 1983 (NAD83), PROJECTED TO THE STATE PLANE COORDINATE SYSTEM (SPCS), CALIFORNIA ZONE II. DISTANCE UNITS IN U.S. SURVEY FEET.
 VERTICAL DATUM:
 SOUNDINGS ARE SHOWN IN FEET AND INDICATE DEPTHS BELOW MEAN LOWER LOW WATER.
 THE INFORMATION DEPICTED ON THIS MAP REPRESENTS THE RESULTS OF A SURVEY CONDUCTED ON THE DATE INDICATED AND CAN ONLY BE CONSIDERED TO REPRESENT THE GENERAL CONDITION EXISTING AT THAT TIME.
 PLANE GRID, BEARING AND COORDINATES ARE BASED ON THE STATE OF CALIFORNIA COORDINATE SYSTEM, LAMBERT CONFORMAL PROJECTION, ZONE II NAD 83, CALIFORNIA, AS DESCRIBED IN SPECIAL PUBLICATION NO. 235, PUBLISHED BY NATIONAL OCEAN SURVEY. BASE MAPS ARE USDA NAIP 2010.
 *SHOALEST SOUNDING PER QUARTER PER REACH

DRAWING NOT TO BE USED FOR NAVIGATION. ONLY CHANNEL CONDITION AT DATE OF SURVEY.
 THE LOCATION OF ALL NAVIGATION AIDS ARE BASED ON INFORMATION PROVIDED BY THE U.S. COAST GUARD. BUOY LOCATIONS REPRESENT THE POSITION OF THE SINKER ONLY. SURVEYED BY THE CORPS OF ENGINEERS.
 SOUNDINGS FOR THE OUTSIDE CHANNEL (100 FT. WIDE) TAKEN BY FATHOMETER. THE INSIDE CHANNEL, (60 FT. WIDE) TAKEN BY LEADLINE, AND ARE SHOWN TO THE NEAREST FOOT AND TENTHS OF A FOOT.
 SOUNDINGS ARE BASED ON THE DATUM OF MEAN LOWER LOW WATER AT THE LOCALITY.
 THE PROJECT DEPTH IS 15 FEET FROM ENTRANCE AT THE MARE ISLAND CAUSEWAY TO ASYLUM SLOUGH, THENCE 10 FEET TO HEAD OF NAVIGATION.
 VERTICAL CONTROLS:
 0+00 TO 175+00 - NRFP4 - 30.54ft - USACE - RTK BASE STATION TRANSECT 11 - 6.593m MLLW - USACE - MLLW LEVELED FROM 20 AND TIDAL 5 FROM TIDE STATION 941 5623 ON 3/29/2012.
 176+00 TO 224+00 - NAPA01 - 2.652m MLLW, -29.111m WGS-84 - USACE - RTK BASE STATION WGS-84 ELEVATION FROM OPUS SOLUTION MLLW ELEV. CALCULATED FROM TRANSECT 11 AND NRFP4 USING RTK OBSERVATIONS PID PENDING.
 225+00 TO 640+00 - NAPA02 - 3.653m MLLW -28.241m WGS-84 - USACE - RTK BASE STATION WGS-84 ELEVATION FROM OPUS SOLUTION MLLW ELEV. CALCULATED BY INTERPOLATING ELEVATIONS BETWEEN NOAA TIDE STATIONS 941 5623 AND 941 5218 PID PENDING.
 641+00 TO 692+00 - NAPA03 - 3.553m MLLW -28.416m WGS-84 - USACE - RTK BASE STATION WGS-84 ELEVATION FROM OPUS SOLUTION MLLW ELEV. TRANSFERRED FROM BM 5218 J 1976 VIA RTK ON 4/10/2012 PID PENDING.

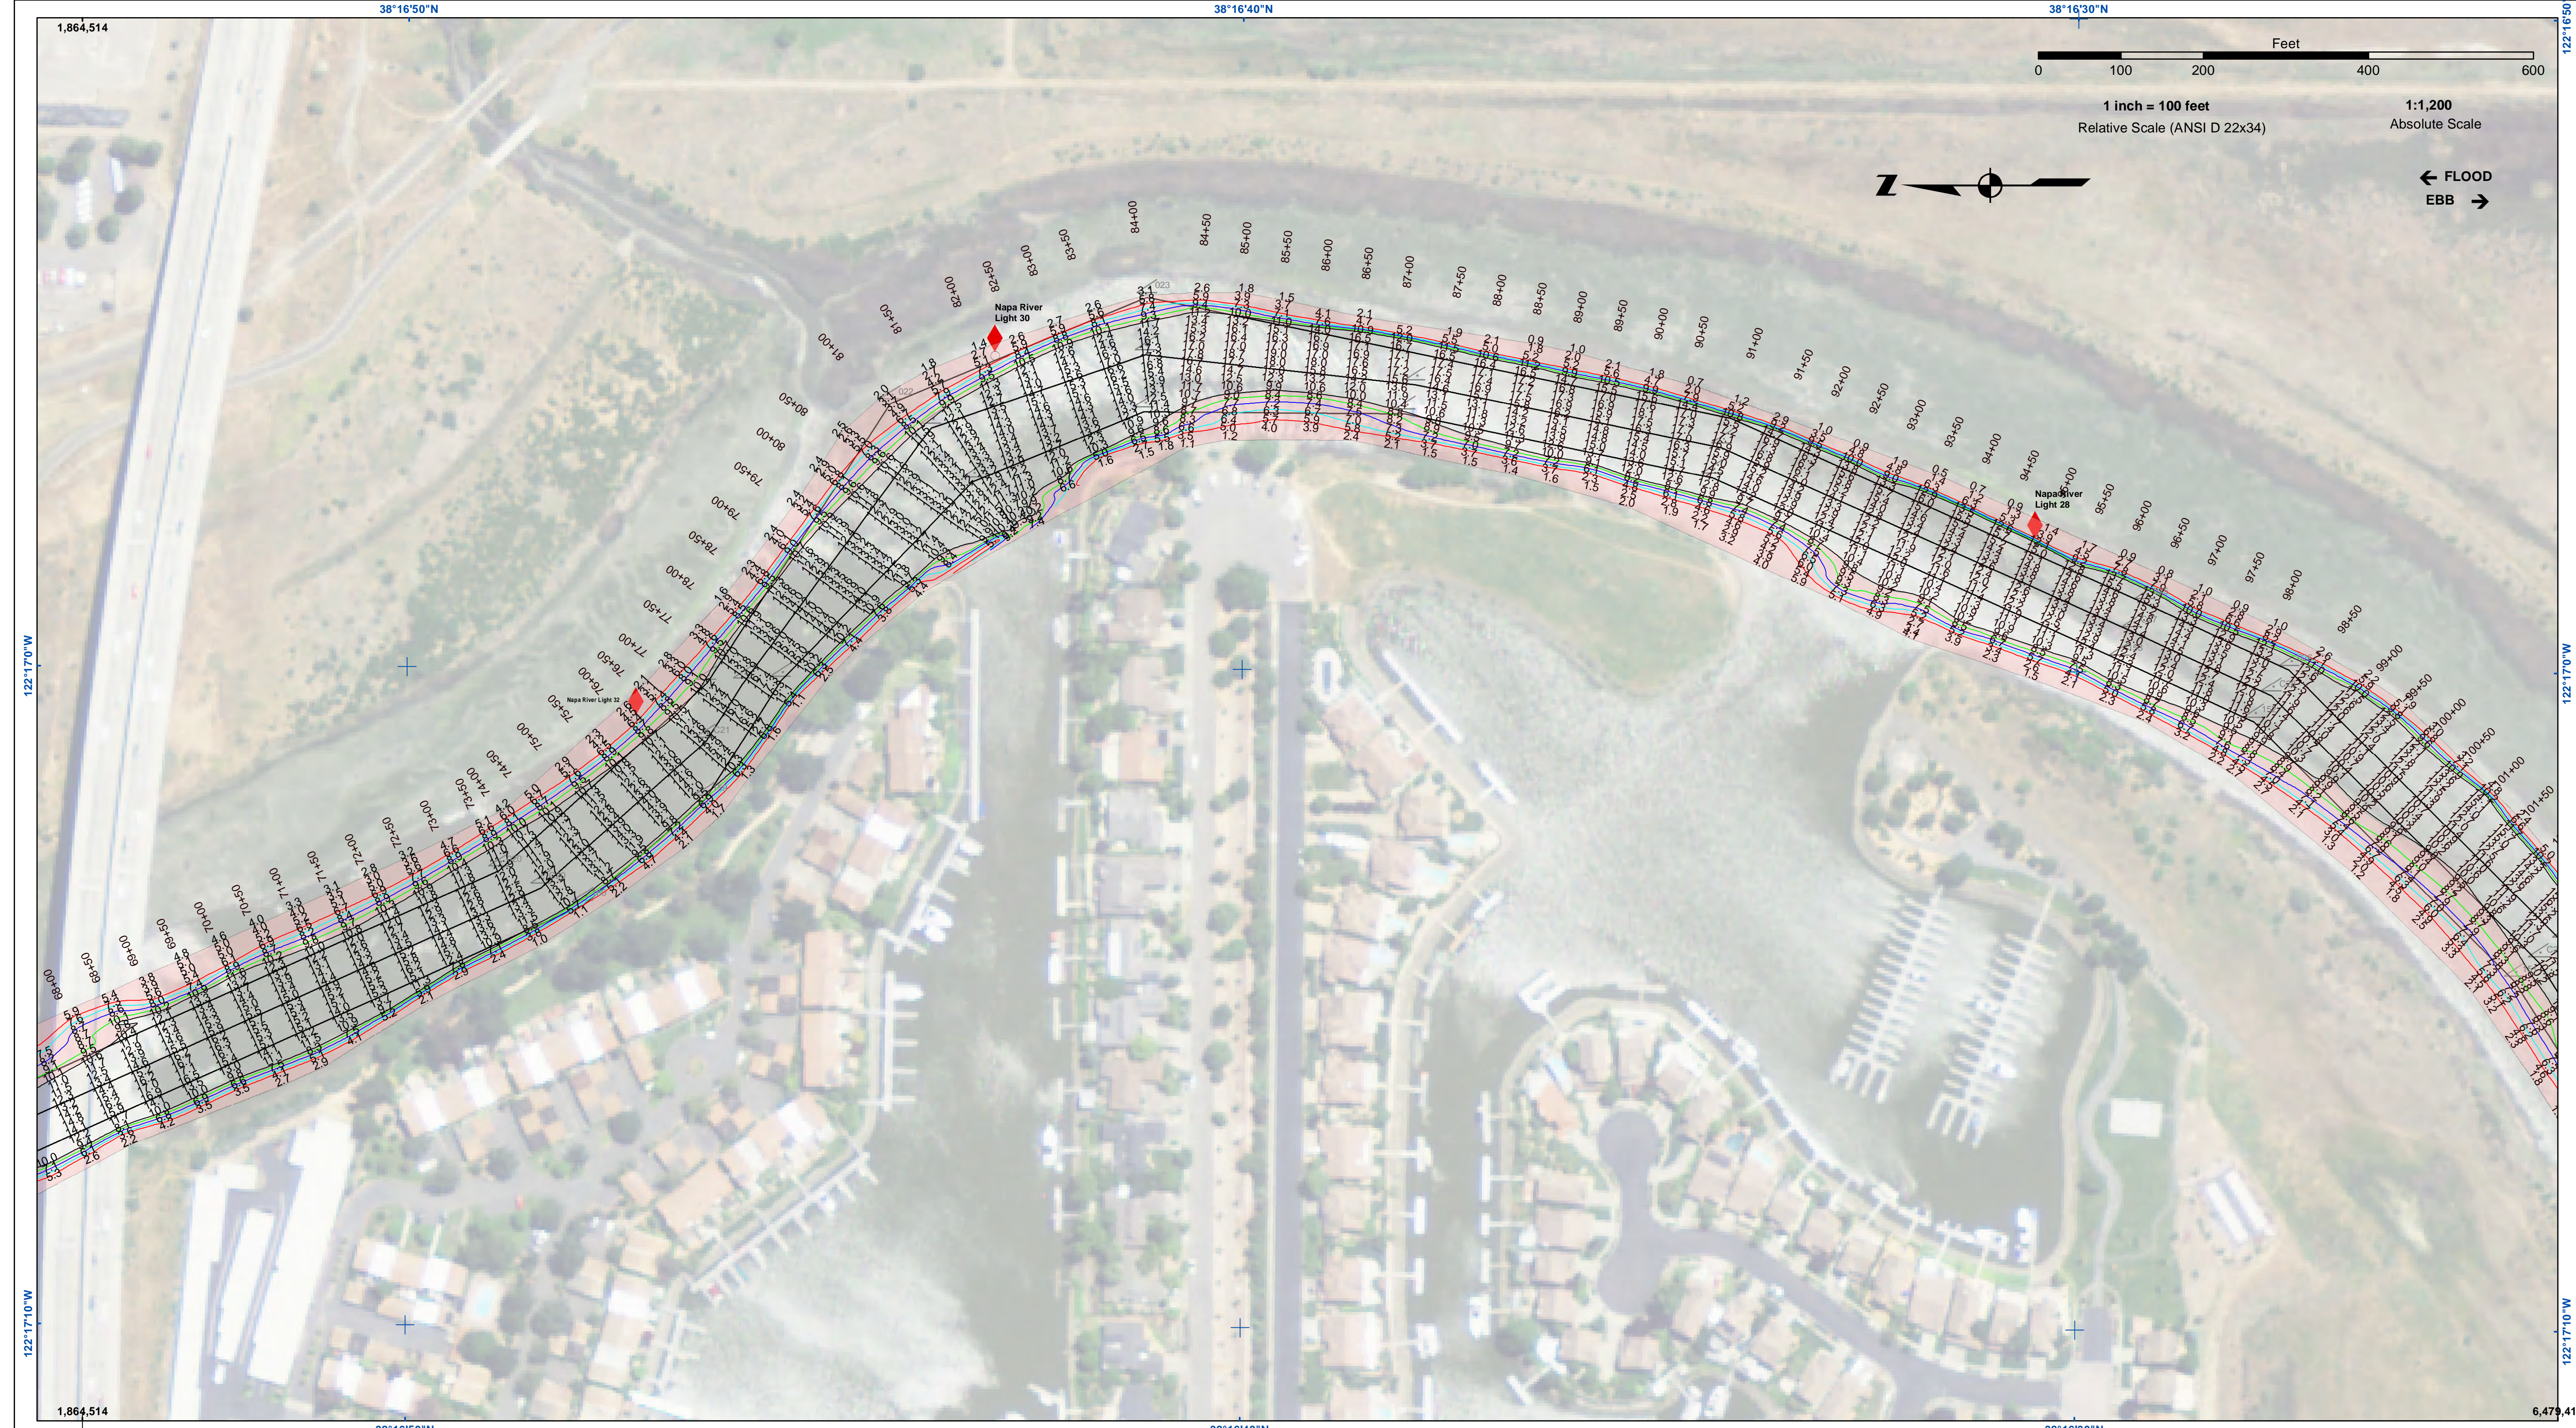


US Army Corps of Engineers
 San Francisco District
 450 Market Street
 San Francisco, CA 94102

DISCLAIMER
 The United States Government furnishes this information as a public service. It is not intended to be used for any purpose other than the intended purpose. The user is responsible for the results of any application of the data for other than the intended purpose. The user is responsible for the results of any application of the data for other than the intended purpose. The user is responsible for the results of any application of the data for other than the intended purpose.

Prepared Under the Direction of	Chart Date
KEVIN P. ARNETT	Jun 28, 2022
Submittal	Plotted By
Hydro Survey Team Leader	PDT
Recommended	Checked By
Chief, Hydro Survey Section	PDT
Approved	Drawn by
Chief, Construction Branch	PDT

CALIFORNIA
 NAPA COUNTY
NAPA RIVER
 UPPER NAPA
 CONDITION SURVEY
 14-15 JUNE 2022


Sheet
Number
3 of 25

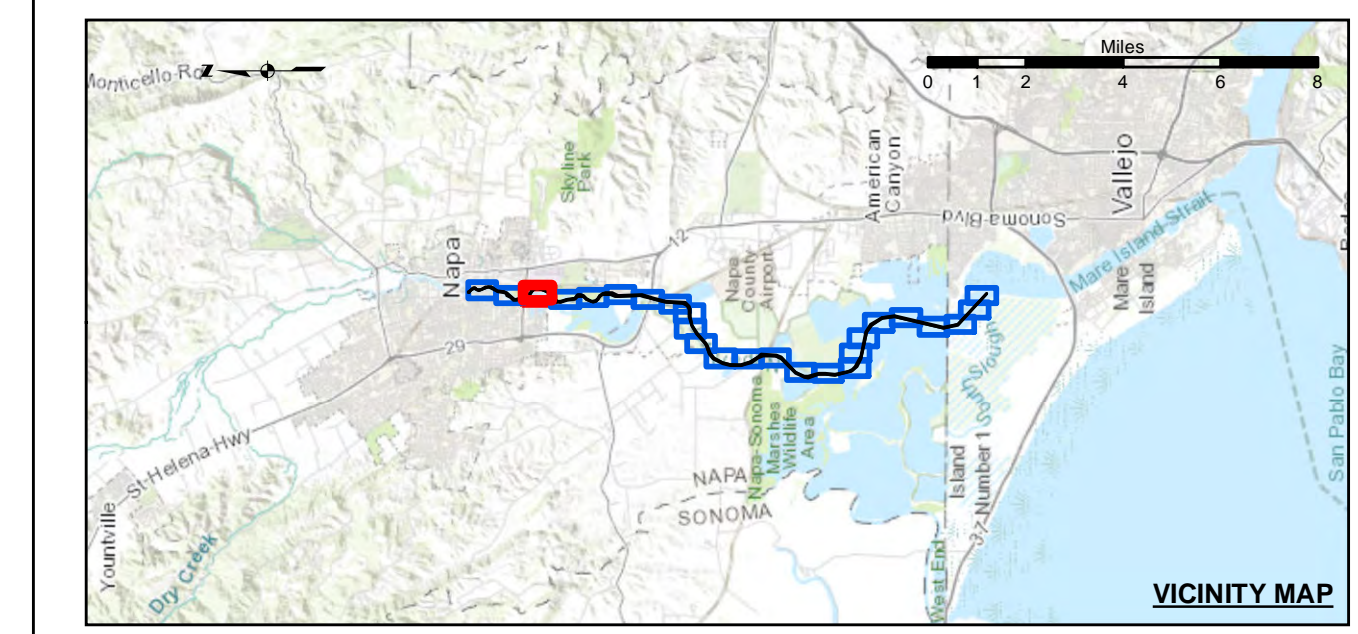

Federal Navigation Channel	Beacon, General	Contours
Shoaling Area	Obstruction Point	
Placement Area	Navigation Buoy	
Anchorage Area	Navigation Buoy	
Wreck Area	Shoalest Sounding*	
Submerged Wreck		
Angle Point		-10
		-9
		-8
		-7
		-6

NOTES:
 HORIZONTAL COORDINATE SYSTEM:
 NORTH AMERICAN DATUM OF 1983 (NAD83), PROJECTED TO THE STATE PLANE COORDINATE SYSTEM (SPCS), CALIFORNIA ZONE II. DISTANCE UNITS IN U.S. SURVEY FEET.
 VERTICAL DATUM:
 SOUNDINGS ARE SHOWN IN FEET AND INDICATE DEPTHS BELOW MEAN LOWER LOW WATER.
 THE INFORMATION DEPICTED ON THIS MAP REPRESENTS THE RESULTS OF A SURVEY CONDUCTED ON THE DATE INDICATED AND CAN ONLY BE CONSIDERED TO REPRESENT THE GENERAL CONDITION EXISTING AT THAT TIME.
 PLANE GRID, BEARING AND COORDINATES ARE BASED ON THE STATE OF CALIFORNIA COORDINATE SYSTEM, LAMBERT CONFORMAL PROJECTION, ZONE II NAD 83, CALIFORNIA, AS DESCRIBED IN SPECIAL PUBLICATION NO. 235, PUBLISHED BY NATIONAL OCEAN SURVEY. BASE MAPS ARE USDA NAIP 2010.
 *SHOALEST SOUNDING PER QUARTER PER REACH


DRAWING NOT TO BE USED FOR NAVIGATION. ONLY CHANNEL CONDITION AT DATE OF SURVEY.
 THE LOCATION OF ALL NAVIGATION AIDS ARE BASED ON INFORMATION PROVIDED BY THE U.S. COAST GUARD. BUOY LOCATIONS REPRESENT THE POSITION OF THE SINKER ONLY. SOUNDINGS FOR THE OUTSIDE CHANNEL (100 FT. WIDE) TAKEN BY FATHOMETER. THE INSIDE CHANNEL (60 FT. WIDE) TAKEN BY LEADLINE, AND ARE SHOWN TO THE NEAREST FOOT AND TENTHS OF A FOOT. SOUNDINGS ARE BASED ON THE DATUM OF MEAN LOWER LOW WATER AT THE LOCALITY.
 THE PROJECT DEPTH IS 15 FEET ON ENTRANCE AT THE MARE ISLAND CAUSEWAY TO ASYLUM SLOUGH, THENCE 10 FEET TO HEAD OF NAVIGATION.
 VERTICAL CONTROLS:
 0+00 TO 175+00 - NRFP4 - 30.54ft - USACE - RTK BASE STATION TRANSECT 11 - 6.593m MLLW - USACE - MLLW LEVELLED FROM 20 AND TIDAL 5 FROM TIDE STATION 941 5623 ON 3/29/2012.
 176+00 TO 224+00 - NAPA01 - 2.652m MLLW, -29.111m WGS-84 - USACE - RTK BASE STATION WGS-84 ELEVATION FROM OPUS SOLUTION MLLW ELEV. CALCULATED FROM TRANSECT 11 AND NRFP4 USING RTK OBSERVATIONS PID PENDING.
 225+00 TO 640+00 - NAPA02 - 3.653m MLLW -28.241m WGS-84 - USACE - RTK BASE STATION WGS-84 ELEVATION FROM OPUS SOLUTION MLLW ELEV. CALCULATED BY INTERPOLATING ELEVATIONS BETWEEN NOAA TIDE STATIONS 941 5623 AND 941 5218 PID PENDING.
 641+00 TO 692+00 - NAPA03 - 3.553m MLLW -28.416m WGS-84 - USACE - RTK BASE STATION WGS-84 ELEVATION FROM OPUS SOLUTION MLLW ELEV. TRANSFERRED FROM BM 5218 J 1976 VIA RTK ON 4/10/2012 PID PENDING.

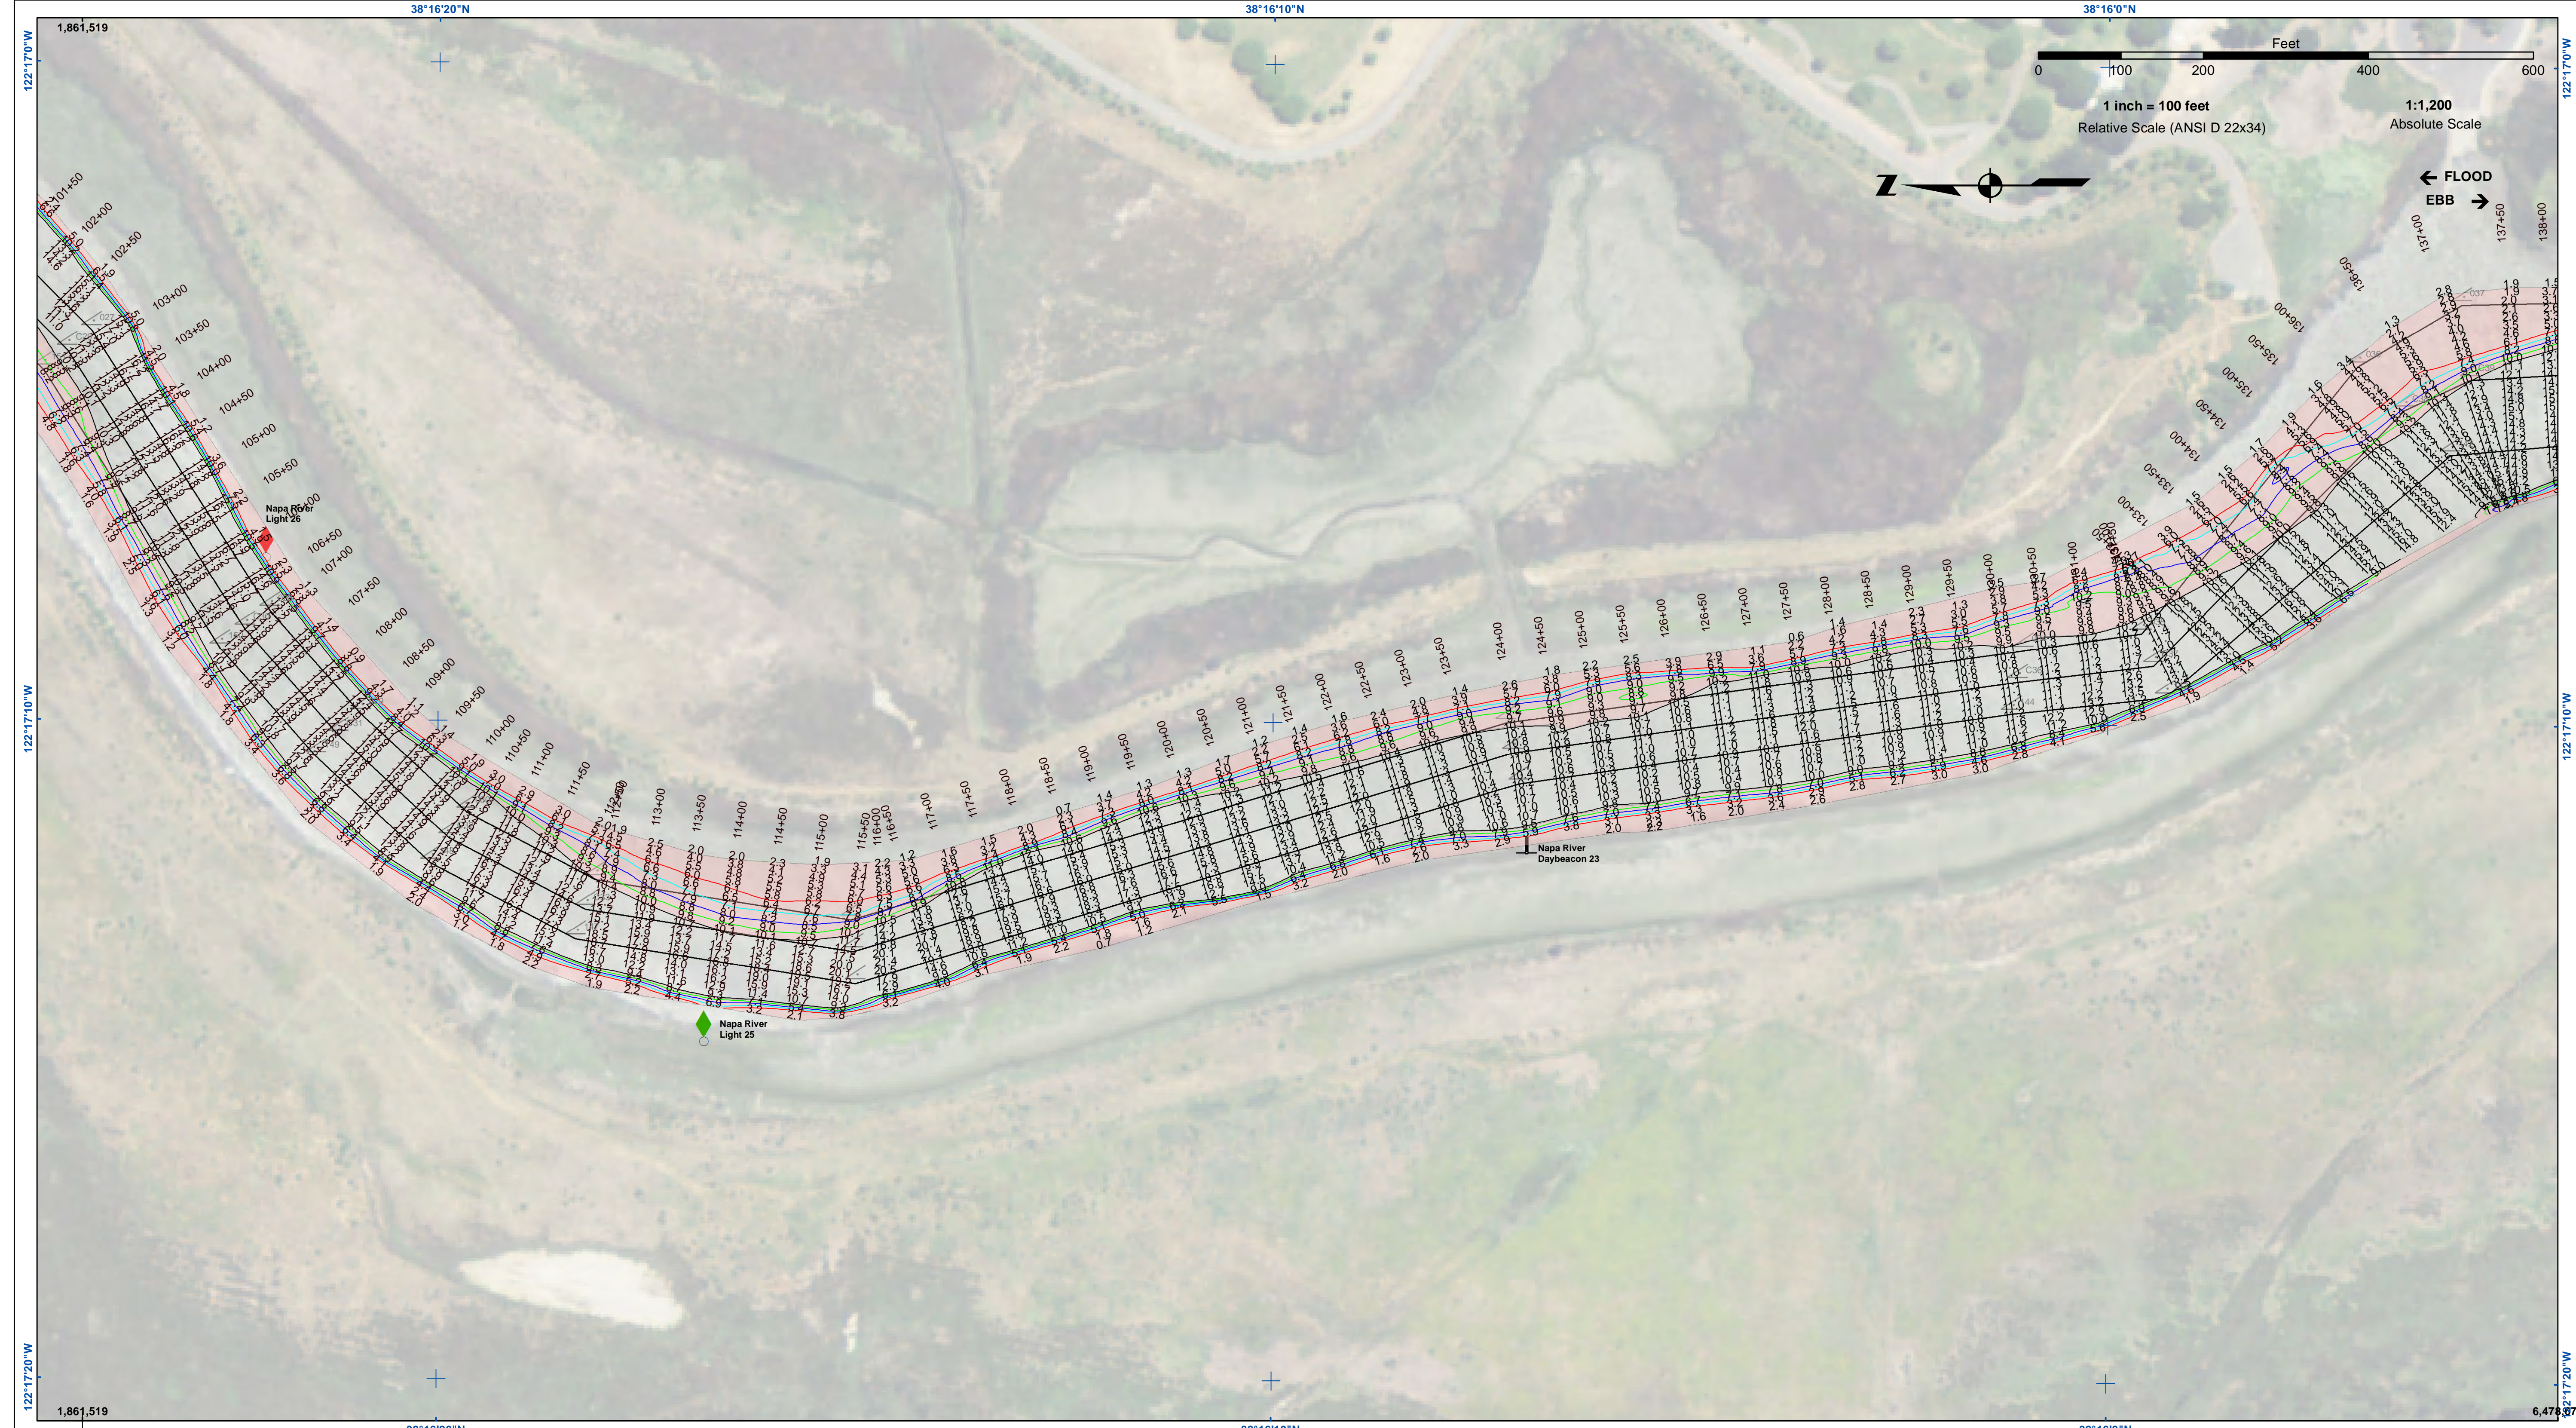

US Army Corps of Engineers
 San Francisco District
 450 Market Street
 San Francisco, CA 94102

DISCLAIMER
 The United States Government furnishes this information as a public service. It is not intended to be used for any purpose other than that for which it was prepared. The United States Government makes no warranty, expressed or implied, concerning the accuracy, completeness, or timeliness of the information. The user is responsible for the results of any application of the data for other than its intended purpose. The United States Government assumes no liability whatsoever for any use made thereof. These data belong to the Government. Therefore, the user is prohibited from disseminating these data to others without also transferring this disclaimer.

Prepared Under the Direction of	Chart Date
KEVIN P. ARNETT	Jun 28, 2022
Submittal	Plotted By:
Hydro Survey Team Leader	PDT
Recommended	Checked By:
Chief, Hydro Survey Section	PDT
Approved	Chief, Construction Branch
Drawn by:	PDT

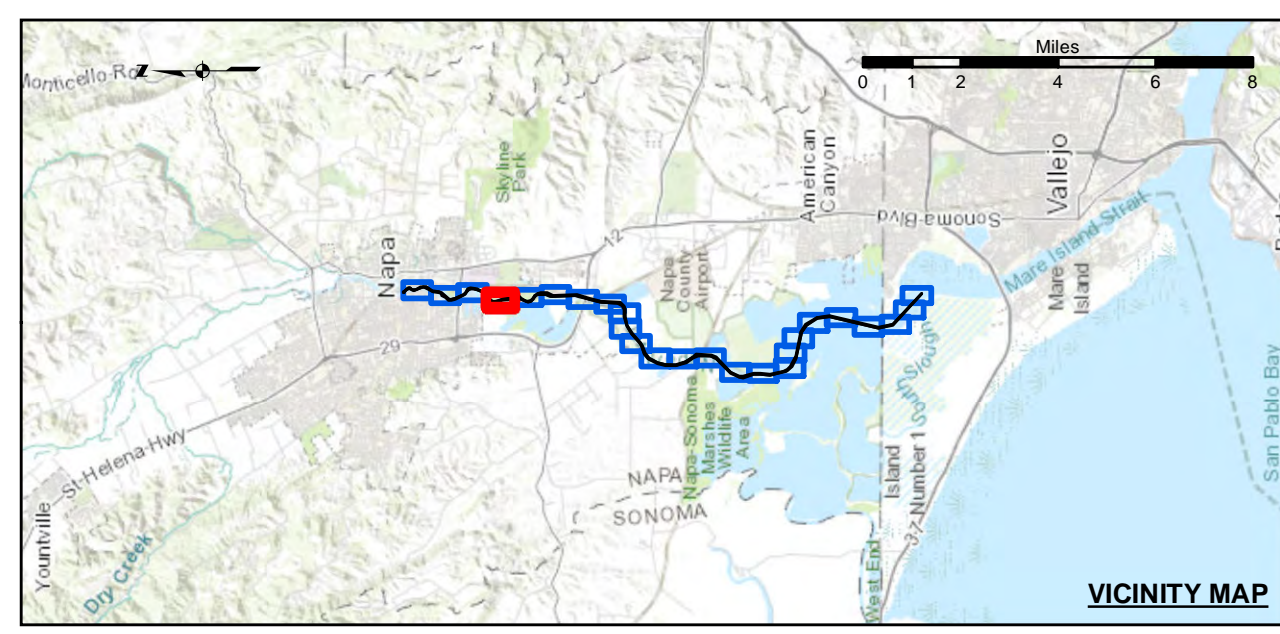


Federal Navigation Channel	Beacon, General	Contours
Shoaling Area	Obstruction Point	
Placement Area	Navigation Buoy	
Anchorage Area	Navigation Buoy	
Wreck Area	Shoalest Sounding*	
Submerged Wreck		-10
Angle Point		-9
		-8
		-7
		-6

NOTES:
 HORIZONTAL COORDINATE SYSTEM:
 NORTH AMERICAN DATUM OF 1983 (NAD83), PROJECTED TO THE STATE PLANE COORDINATE SYSTEM (SPCS), CALIFORNIA ZONE II. DISTANCE UNITS IN U.S. SURVEY FEET.
 VERTICAL DATUM:
 SOUNDINGS ARE SHOWN IN FEET AND INDICATE DEPTHS BELOW MEAN LOWER LOW WATER.
 THE INFORMATION DEPICTED ON THIS MAP REPRESENTS THE RESULTS OF A SURVEY CONDUCTED ON THE DATE INDICATED AND CAN ONLY BE CONSIDERED TO REPRESENT THE GENERAL CONDITION EXISTING AT THAT TIME.
 PLANE GRID, BEARING AND COORDINATES ARE BASED ON THE STATE OF CALIFORNIA COORDINATE SYSTEM, LAMBERT CONFORMAL PROJECTION, ZONE II NAD 83, CALIFORNIA, AS DESCRIBED IN SPECIAL PUBLICATION NO. 235, PUBLISHED BY NATIONAL OCEAN SURVEY. BASE MAPS ARE USDA NAIP 2010.
 *SHOALEST SOUNDING PER QUARTER PER REACH

DRAWING NOT TO BE USED FOR NAVIGATION. ONLY CHANNEL CONDITION AT DATE OF SURVEY.
 THE LOCATION OF ALL NAVIGATION AIDS ARE BASED ON INFORMATION PROVIDED BY THE U.S. COAST GUARD. BUOY LOCATIONS REPRESENT THE POSITION OF THE SINKER ONLY. SURVEYED BY THE CORPS OF ENGINEERS.
 SOUNDINGS FOR THE OUTSIDE CHANNEL (100FT. WIDE) TAKEN BY FATHOMETER. THE INSIDE CHANNEL (60 FT. WIDE) TAKEN BY LEADLINE, AND ARE SHOWN TO THE NEAREST FOOT AND TENTHS OF A FOOT.
 SOUNDINGS ARE BASED ON THE DATUM OF MEAN LOWER LOW WATER AT THE LOCALITY.
 THE PROJECT DEPTH IS 15' FROM ENTRANCE AT THE MARE ISLAND CAUSEWAY TO ASYLUM SLOUGH, THENCE 10 FEET TO HEAD OF NAVIGATION.
 VERTICAL CONTROLS:
 0+00 TO 175+00 - NRFP4 - 30.54ft - USACE - RTK BASE STATION TRANSECT 11 - 6.593m MLLW - USACE - MLLW LEVELED FROM 20 AND TIDAL 5 FROM TIDE STATION 941 5623 ON 3/29/2012.
 176+00 TO 224+00 - NAPA01 - 2.652m MLLW - 29.111m WGS-84 - USACE - RTK BASE STATION WGS-84 ELEVATION FROM OPUS SOLUTION MLLW ELEV. CALCULATED FROM TRANSECT 11 AND NRFP4 USING RTK OBSERVATIONS PID PENDING.
 225+00 TO 640+00 - NAPA02 - 3.653m MLLW - 28.241m WGS-84 - USACE - RTK BASE STATION WGS-84 ELEVATION FROM OPUS SOLUTION MLLW ELEV. CALCULATED BY INTERPOLATING ELEVATIONS BETWEEN NOAA TIDE STATIONS 941 5623 AND 941 5218 PID PENDING.
 641+00 TO 692+00 - NAPA03 - 3.553m MLLW - 28.416m WGS-84 - USACE - RTK BASE STATION WGS-84 ELEVATION FROM OPUS SOLUTION MLLW ELEV. TRANSFERRED FROM BM 5218 J 1976 VIA RTK ON 4/10/2012 PID PENDING.

CALIFORNIA
 NAPA COUNTY
 NAPA RIVER
 UPPER NAPA
 CONDITION SURVEY
 14-15 JUNE 2022

Sheet
 Number
 4 of 25

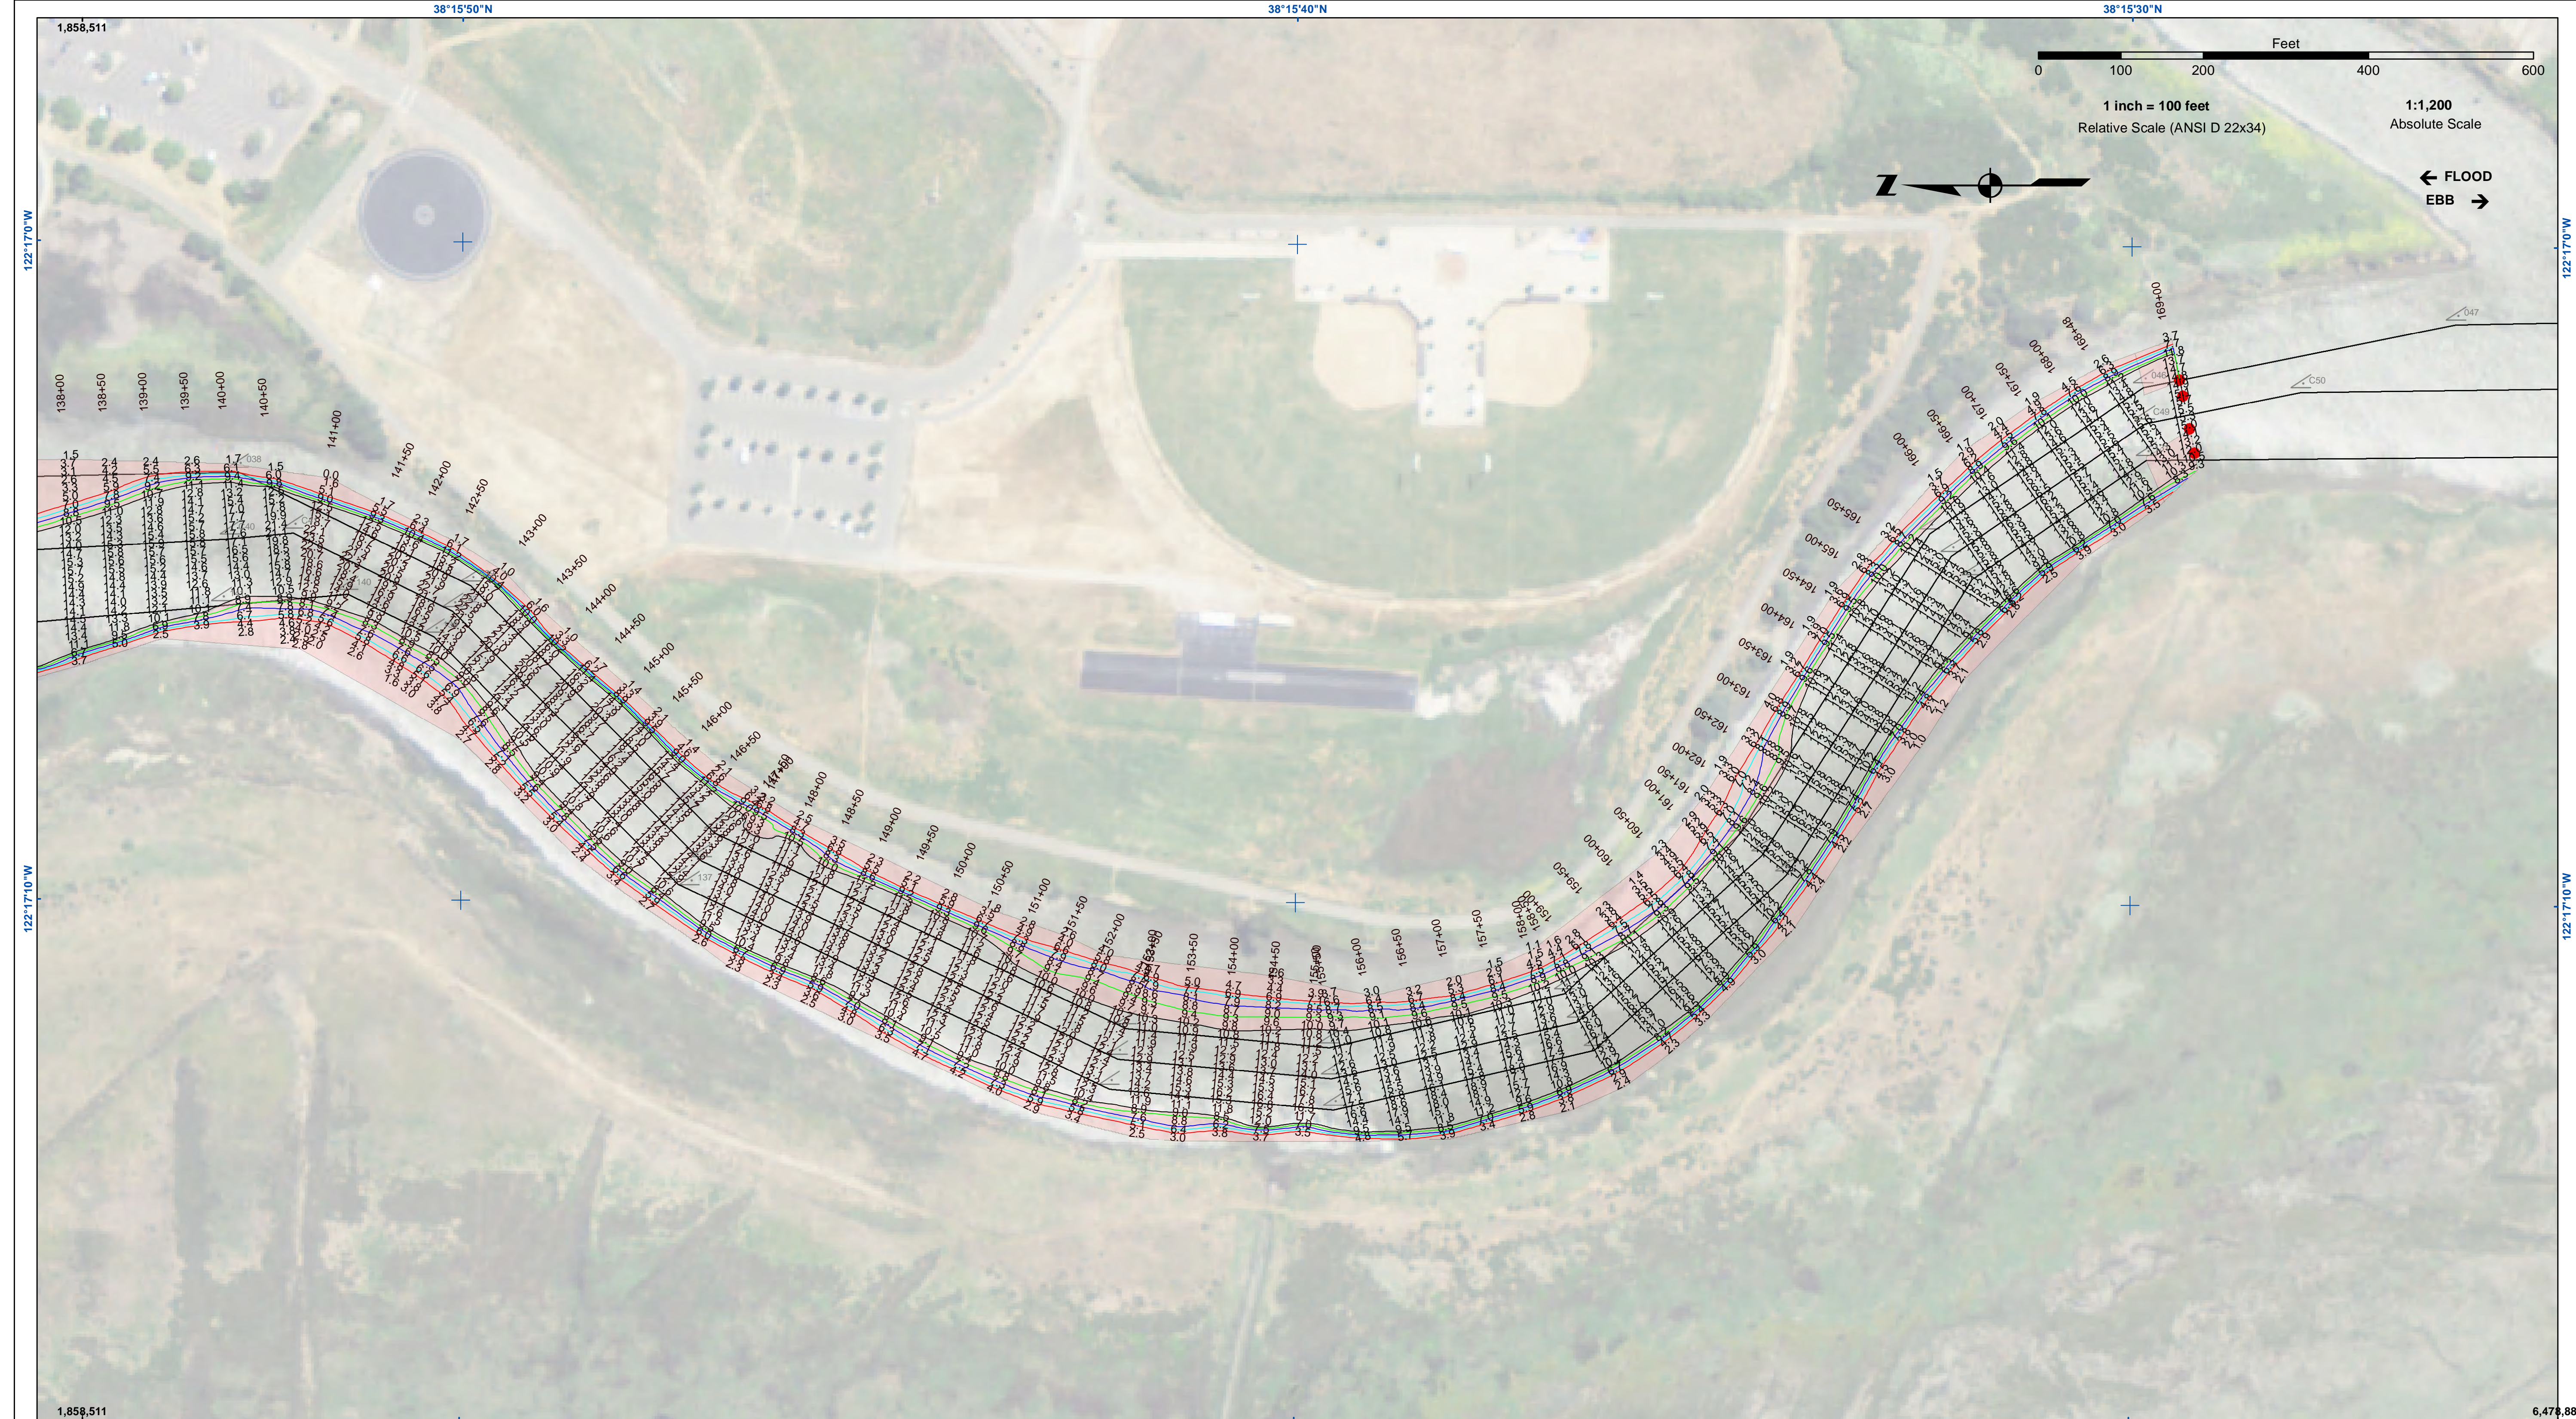


US Army Corps of Engineers
 San Francisco District
 450 Market Street
 San Francisco, CA 94102

DISCLAIMER
 The United States Government furnishes this information as a public service. It is not intended to be used for any purpose other than the intended purpose. The user is responsible for the results of any application of the data for other than the intended purpose. The United States Government makes no warranty, expressed or implied, concerning the accuracy, completeness, or reliability of the information furnished. The United States Government under no liability whatsoever to any person by reason of any use made thereof. These data belong to the Government. Therefore the user is advised that the data are not to be used for any purpose other than the intended purpose. The recipient may not transfer these data to others without also transferring this disclaimer.

Prepared Under the Direction of	Chart Date:
LT COLONEL C.E. DISTRICT ENGINEER	Jun 28, 2022
Submittal:	Plotted By:
Hydro Survey Team Leader	PDT
Recommended:	Checked By:
Chief, Hydro Survey Section	PDT
Approved:	Drawn by:
Chief, Construction Branch	PDT

CALIFORNIA
 NAPA COUNTY
 NAPA RIVER
 UPPER NAPA
 CONDITION SURVEY
 14-15 JUNE 2022

Sheet
 Reference
 Number
5 of 25

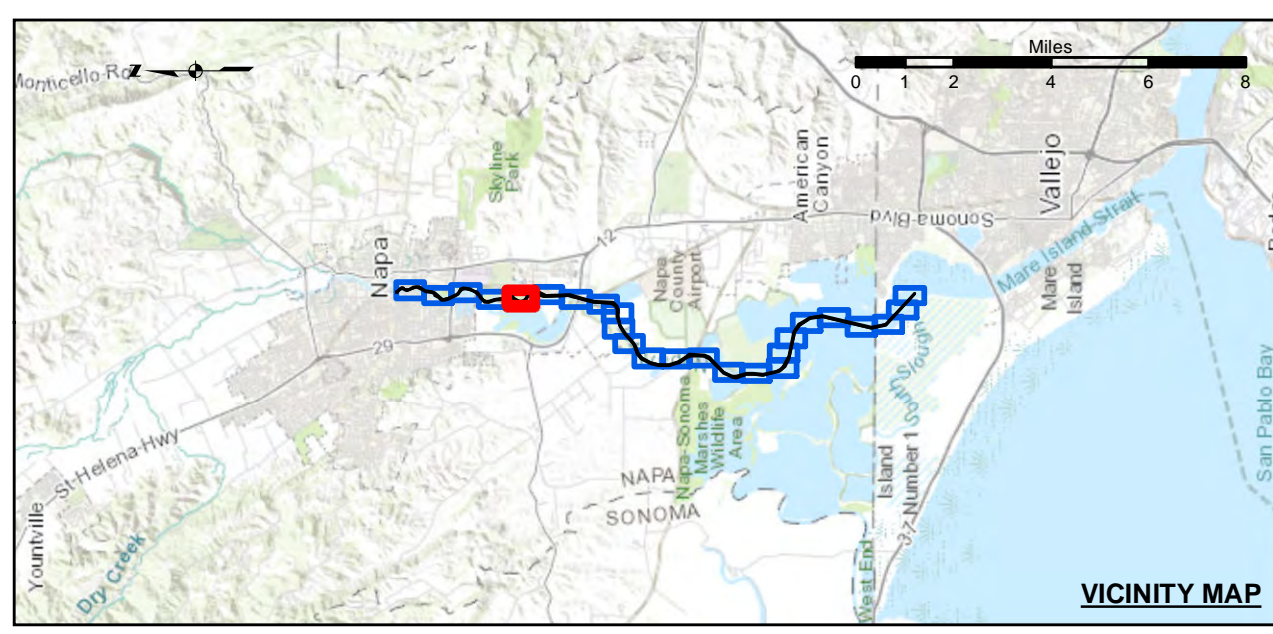

Federal Navigation Channel	Beacon, General	Contours
Shoaling Area	Obstruction Point	
Placement Area	Navigation Buoy	
Anchorage Area	Navigation Buoy	
Wreck Area	Shoalest Sounding*	
Submerged Wreck		-10
Angle Point		-9
		-8
		-7
		-6

NOTES:
 HORIZONTAL COORDINATE SYSTEM:
 NORTH AMERICAN DATUM OF 1983 (NAD83), PROJECTED TO THE STATE PLANE COORDINATE SYSTEM (SPCS), CALIFORNIA ZONE II. DISTANCE UNITS IN U.S. SURVEY FEET.
 VERTICAL DATUM:
 SOUNDINGS ARE SHOWN IN FEET AND INDICATE DEPTHS BELOW MEAN LOWER LOW WATER.
 THE INFORMATION DEPICTED ON THIS MAP REPRESENTS THE RESULTS OF A SURVEY CONDUCTED ON THE DATE INDICATED AND CAN ONLY BE CONSIDERED TO REPRESENT THE GENERAL CONDITION EXISTING AT THAT TIME.
 PLANE GRID, BEARING AND COORDINATES ARE BASED ON THE STATE OF CALIFORNIA COORDINATE SYSTEM, LAMBERT CONFORMAL PROJECTION, ZONE II NAD 83, CALIFORNIA, AS DESCRIBED IN SPECIAL PUBLICATION NO. 235, PUBLISHED BY NATIONAL OCEAN SURVEY. BASE MAPS ARE USDA NAIP 2010.
 *SHOALEST SOUNDING PER QUARTER PER REACH

DRAWING NOT TO BE USED FOR NAVIGATION. ONLY CHANNEL CONDITION AT DATE OF SURVEY.
 THE LOCATION OF ALL NAVIGATION AIDS ARE BASED ON INFORMATION PROVIDED BY THE U.S. COAST GUARD. BUOY LOCATIONS REPRESENT THE POSITION OF THE SINKER ONLY. SURVEYED BY THE CORPS OF ENGINEERS.
 SOUNDINGS FOR THE OUTSIDE CHANNEL (100FT. WIDE) TAKEN BY FATHOMETER. THE INSIDE CHANNEL (60 FT. WIDE) TAKEN BY LEADLINE, AND ARE SHOWN TO THE NEAREST FOOT AND TENTHS OF A FOOT. SOUNDINGS ARE BASED ON THE DATUM OF MEAN LOWER LOW WATER AT THE LOCALITY.
 THE PROJECT DEPTH IS 15 FEET FROM ENTRANCE AT THE MARE ISLAND CAUSEWAY TO ASYLUM SLOUGH, THENCE 10 FEET TO HEAD OF NAVIGATION.
 VERTICAL CONTROLS:
 0+00 TO 175+00 - NRFP4 - 30.54ft - USACE - RTK BASE STATION TRANSECT 11 - 6.593m MLLW - USACE - MLLW LEVELED FROM 20 AND TIDAL 5 FROM TIDE STATION 941 5623 ON 3/29/2012.
 176+00 TO 224+00 - NAPAN01 - 2.652m MLLW, -29.111m WGS-84 - USACE - RTK BASE STATION WGS-84 ELEVATION FROM OPUS SOLUTION MLLW ELEV. CALCULATED FROM TRANSECT 11 AND NRFP4 USING RTK OBSERVATIONS PID PENDING.
 225+00 TO 640+00 - NAPAN02 - 3.653m MLLW -28.241m WGS-84 - USACE - RTK BASE STATION WGS-84 ELEVATION FROM OPUS SOLUTION MLLW ELEV. CALCULATED BY INTERPOLATING ELEVATIONS BETWEEN NOAA TIDE STATIONS 941 5623 AND 941 5218 PID PENDING.
 641+00 TO 692+00 - NAPAN03 - 3.553m MLLW -28.416m WGS-84 - USACE - RTK BASE STATION WGS-84 ELEVATION FROM OPUS SOLUTION MLLW ELEV. TRANSFERRED FROM BM 5218 J 1976 VIA RTK ON 4/10/2012 PID PENDING.