

MATCHLINE - SHEET 4


POINT POTRERO

SAN FRANCISCO BAY

BROOKS ISLAND


N.A.D 1983 FEET COORDINATES		
CHANNEL	NORTH	EAST
08	2156972.67	6020299.00
09	2157665.40	6019811.96
10	2156366.16	6023187.69
11	2157068.34	6022179.34
12	2156295.20	6024797.51
13	2156871.43	6023175.20
14	2156630.06	6025133.87
15	2157243.59	6024071.67
16	2157620.81	6025096.39
17	2157571.89	6024244.59
18	2158699.14	6024794.29
19	2159896.43	6023863.10
20	2159700.46	6024623.96

SHEET INDEX

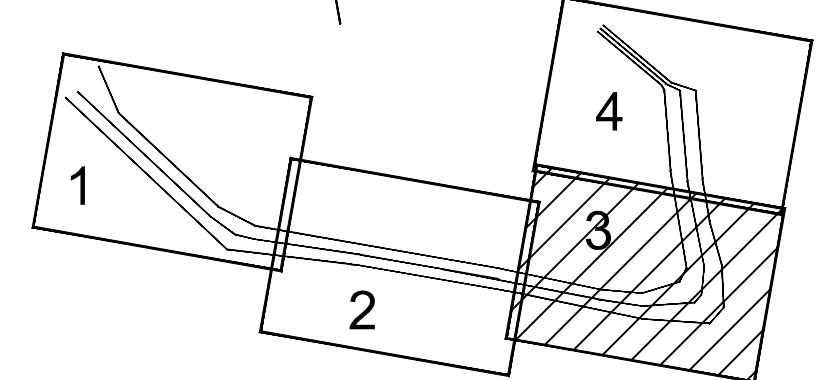

**LEGEND:**

Green line	-37'
Blue line	-36'
Cyan line	-35'
Light blue line	-34'
Red line	-33'

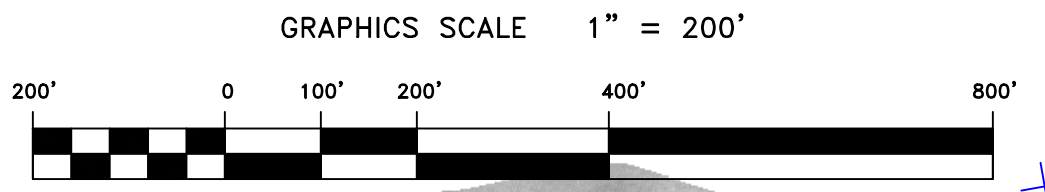

US Army Corps of Engineers  
San Francisco District  
1455 Market Street  
San Francisco, CA 94103


Mark	Description	Date	Appr.

DESIGNED BY:	Hydro Survey Team Leader	CHECKED BY:	PDT
			PDT
DATE:	3/11/2015	DRAWING NO.:	9
			2
APPROVED:	Chief Hydro Survey Section	PREPARED UNDER THE DIRECTION OF:	XXX
			JOHN C. MORROW
SUBMITTED:		Lt. Colonel, C.E., District Engineer	

CALIFORNIA  
ALAMEDA COUNTY  
RICHMOND INNER HARBOR  
POSTDREDGE SURVEY  
REACH 9  
09 MARCH 2015

Sheet reference number  
**C3**