


Mark	Description	Date	Appr.

SUBMITTED: <small>Survey Station Form Number</small> APPROVAL RECOMMENDED: CHIEF, Technical Support Section APPROVED:	DESIGNED BY:	LAURENCE M. FARRELL	LT. COLONEL, C.E., DISTRICT ENGINEER
	CHECKED BY:	PDI	
	DRAWN BY:	PDI	
	DATE:	6/20/2009	6/21/2009
	SHEET NO.:	5	6
	DRAWING NO.:	2	4
	XXX	91	08

CALIFORNIA
CONTRA COSTA COUNTY
SUISUN BAY CHANNEL
POSTEDGE SURVEY
& 10 DECEMBER 2009

Sheet reference number
C3

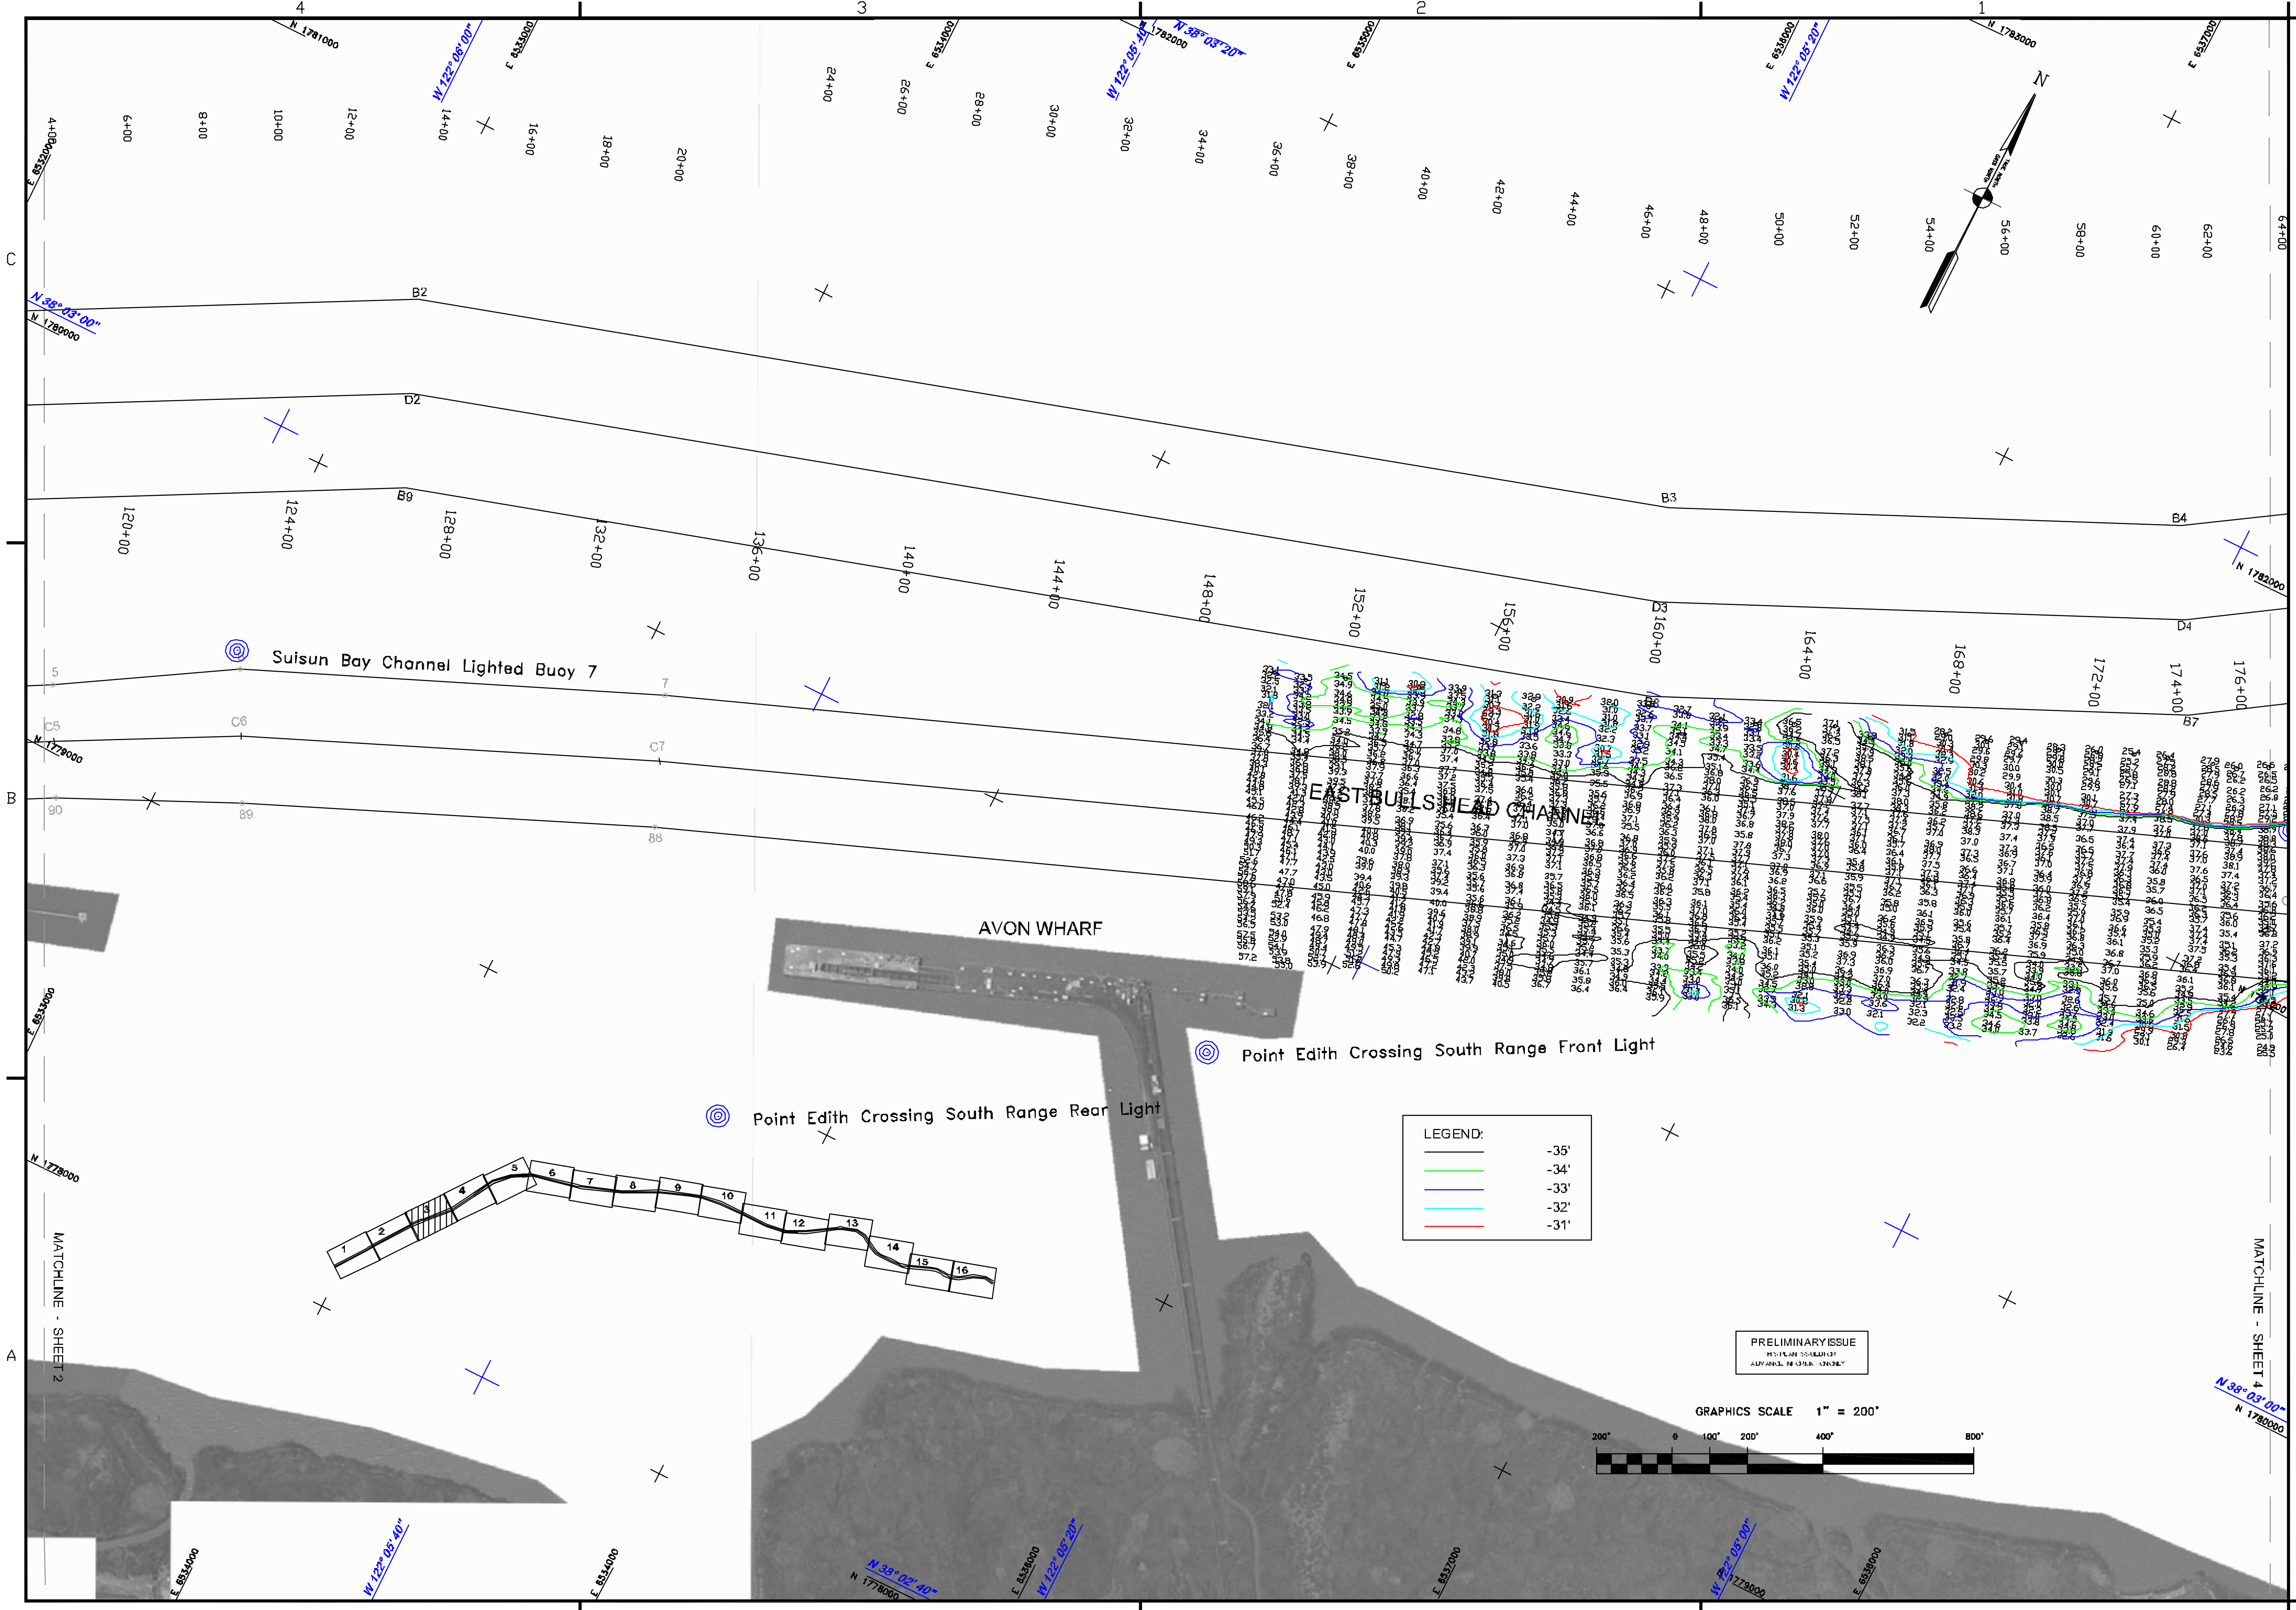

LEGEND:

[Black line]	-35'
[Green line]	-34'
[Blue line]	-33'
[Cyan line]	-32'
[Red line]	-31'

PRELIMINARY ISSUE
REVISED BY: [blank]
DATE: [blank]

