


Monk & Associates Environmental Consultants 1136 Saranap Avenue, Suite Q Walnut Creek, California 94595 (925) 947-4867

Figure 3. Aerial Photograph of the Kerry Ranch Project Site Santa Rosa, California

Aerial Photograph Source: ESRI Map Preparation Date: December 31, 2018

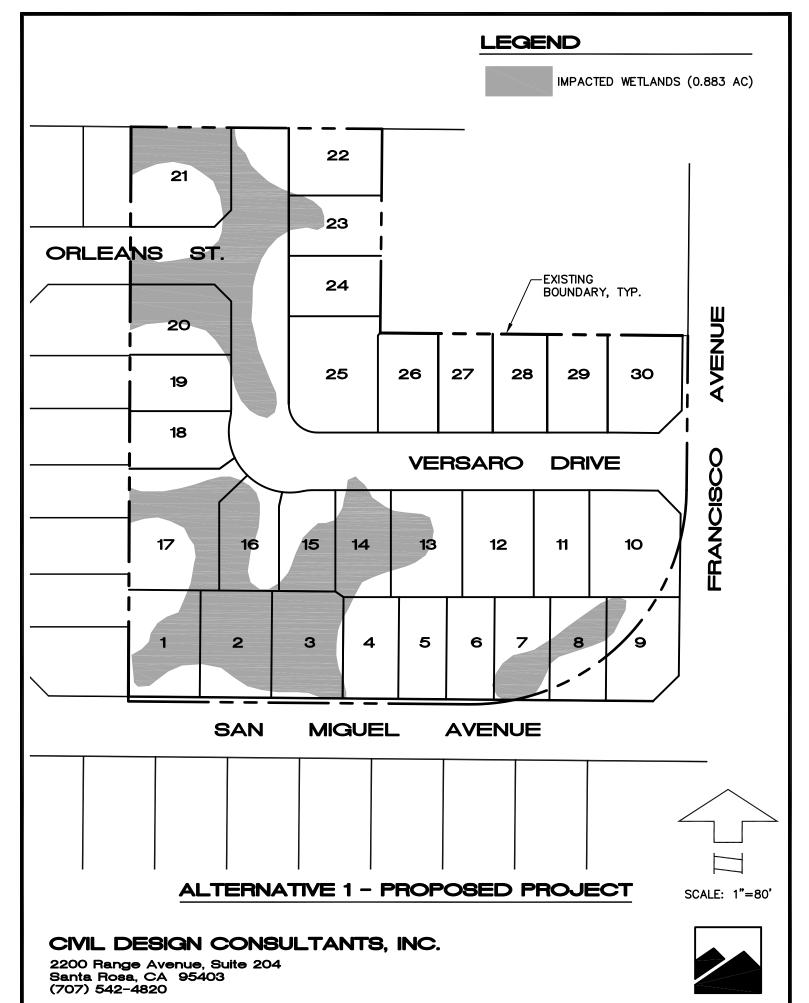

NOVEMBER 2017

SHEET 1 OF 5

CONTRACTOR SHALL OBTAIN AND PAY FOR ALL CONSTRUCTION PERMITS REQUIRED BY THE CITY F SANTA ROSA (SUCH AS ENCROACHMENT, GRADING, BUILDING, DEMOLITION ETC.) PRIOR TO NOMEKCHEMT OF WORK.

. RAIN WATER LEADERS AND ROOF DRAINS ARE TO BE CONNECTED BY DEVELOPER TO STORM RAIN SYSTEM OR SPLASH BLOCK. SEE ARCHITECTURAL PLANS FOR EXACT LOCATION AND SIZE. O OVERLAND DRAINAGE OF SIDEMALK SHEET DRAINAGE WILL BE ALLOWED.

5. CONTRACTOR SHALL SECURE A TRENCH PERMIT FROM THE CALIFORNIA DIVISION OF INDUSTRIAL SAFETY PRIOR TO EXCAVATION OF ANY TRENCH OVER FIVE FEET IN DEPTH.

. IF ANY CONTANINATED MATERIAL IS ENCOUNTERED DURING CONSTRUCTION, WORK MUST STOP NITIL A WORK PLAN HAS BEEN APPROVED IN WRITING BY THE CITY FIRE DEPARTMENT AND THE STATE REGIONAL WATER QUALITY CONTROL BOARD.

ALL TRENCH SPOILS SHALL BE REMOVED AS THEY ARE GENERATED AND DISPOSED OF ON SITE R THE GRADING PERMIT OR AT A SITE APPROVED BY A GRADING PERMIT FROM THE DEPARTMENT COMMUNITY DEVELOPMENT.

ALL UNDERGROUND IMPROVEMENTS INCLUDING SEWER LINES, WATER LINES, STORM DRAINS, BLIC UTILITY FACILITIES, AND SERVICES SHALL BE INSTALLED, TESTED, AND ACCEPTED HE PUBLIC WORKS DEPARTMENT PRIOR TO PAYING.

THE LOCATIONS OF UNDERGROUND OBSTRUCTIONS SHOWN ON THE PLANS ARE APPROXIMATE Y AND SHOULD NOT BE TAKEN AS FINAL OR ALL INCLUSIVE, THE CONTRACTOR IS CAUTIONED AT THE PLANS MAY NOT INCLUDE ALL EXISTING UTILITIES AND THAT THE OWNER, THE CITY SANTA ROSA AND DESIGN PROFESSIONAL ASSUME NO RESPONSIBILITY OF OBSTRUCTIONS WHICH

13. THE CONTRACTOR SHALL RECOGNIZE THAT UNDERGROUND FACILITIES NOT SHOWN AS CIVIL IMPROVEMENTS (PG&E, TELEPHONE, TV, IRRIGATION, ETC.) SHALL BE COORDINATED AND CONSTRUCTED PRIOR TO PLACEMENT OF BASE ROOK AND PAYING.

4. CONTRACTOR IS RESPONSIBLE FOR PRESERVATION AND/OR PERPETUATION OF ALL EXISTING NATIONAL TOWN IN MERSONSTRUCT FOR PRESENTATION AND/OR PERPETUATION OF ALL EXISTING SUMMEY MORMARIES (THOM PEPES ON LOT LIMES AND CORNER, CHITERINE WILL DISKS, ETC.), MICH COTTROL SUBDIVISIONS, TRACTS, BOURDMERTS, STREETS, HEDWAYS, OR OTHER REMOVED DET TO CONTRACTOR'S MORE CONTRACTOR SHARE PROVIDER ANISHMEN OF 1D (TEN) VORKING ON'S MOTICE TO THE ENCINEER/SURVEYOR PRIOR TO DISTURBANCE OR REMOVAL OF DISTITUTION OF THE PROVIDERS OF THE PROVIDER AND THE PROVIDE

5. CONSTRUCTION HOURS SHALL BE LIMITED TO 7 AM TO 7 PM MOMBAY THRU SATURDAY, XCLUDIAN HOLIDAYS. THIS RESTRICTION INCLUDES THE START UP OF ANY MOTOR VEHICLES ROTHER HEAVY EQUIPMENT. ALL CONTRACTORS' EQUIPMENT SHALL BE PROPERTY MUFFLED AND HALL BE SHUT DOWN WHEN MOT IN USE (HOURS ARE SUBJECT TO THE CONDITIONS OF

15. THE CONTRACTOR SMALL BE RESPONSIBLE FOR REPORTER ANY NAMES OR DITERIORATION COCCURRIENT OF DESIGNATION FUNDAMENDAMENTS AS A DESIGN TESSER OF CONTRACTOR AND ACCURATE FUNDAMENTS OF THE CORRESPONDED TO CONSTRUCTION OF THE CORRESPONDED THE CORRESPONDED TO CORRESPONDED TO CORRESPONDED TO CORRESPONDED TO CORRESPONDED ON CORRESPONDED TO RESPONDE TO CORRESPONDED TO RESPONDE TO CORRESPONDED TO RESPONDE TO CORRESPONDED TO RESPONDE TO CORRESPONDED TO STATE OF THE CORRESPONDED TO C

17. RECORD PLAN DRAWINGS SHALL BE PROVIDED UPON COMPLETION OF PROJECT PRIOR TO FINAL ACCEPTANCE.

19. CONSTRUCTION STITE WASTE WANGEMENT IS THE RESPONSIBILITY OF THE MORNEYCOMPRACTOR THE CONSTRUCTION STEP MUST BE EVENT OF CLEAN AND FREE FIOR MON-STORM WATER WA 9. CONSTRUCTION SITE WASTE MANAGEMENT IS THE RESPONSIBILITY OF THE

THE LOCATION OF ALL GANG MAIL BOXES SHALL ENSURE THAT ALL LINES OF SIGHT AND RAINAGE FLOWS ARE NOT OBSTRUCTED.

23. THE LOCATION AND INSTALLATION OF ALL MAIL BOXES SHALL BE COORDINATED BETWEEN THE DEVELOPER AND THE US POST OFFICE.

24. MAIL BOXES CONFORMING TO CITY STANDARD 271 MAY BE INSTALLED IN THE RIGHT-OF-WAY. 25. THE CHOICE TO USE A CITY STANDARD 271 OR A GANG MAIL BOX WILL BE AT THE DISCRETION OF THE DEVELOPER.

PROJECT SPECIFIC MOTES

1. PERMANENT MORNHENTS AS SHOWN ON THE PLANS SHALL BE FURNISHED AND INSTALLED BY
THE CONTRACTOR IN ACCORDANCE WITH THE STANDARD PLANS AFTER COMPLETION OF STREET
IMPROVEMENTS. THE MORNHENT LOCATION SHALL BE AS SHOWN AND STAKED IN THE FIELD BY
THE ENLINEER OR SURVEYOR.

THE DEVELOPER ASSUMES ALL RESPONSIBILITY FOR THE APPROVAL OF MAILBOX LOCATIONS BY THE LOCAL BRANCH OF THE UNITED STATES POST OFFICE.

ANY ONSITE DRAINAGE FOR PROPOSED CUSTOM LOTS SHALL FALL UNDER REVIEW WITH

## FRANCISCO AVENUE (2181 - 2365)

## FRANCISCO AVENUE - PEDESTRIAN PATH

KERRY RANCH OFFSITE IMPROVEMENT PLANS

#### STREET NOTES

ALL STREET TRENCHING IN PUBLIC R/W REQUIRES USE OF A.C. HOTMIX, UNDER DIRECTION OF CITY INSPECTOR AND PER STD. 215

2. STREET TREES ARE REQUIRED AND SHALL BE PLANTED BY THE DYSLOPED, SELECTION WILL BE MORE FROM THE CITY'S APPRICED MAKED SHEET THEE LIST AND APPRICED BY THE CITY OF APPRICED THE THE CITY OF THE CITY OF A COMMON WITH THE CITY OF A COMMON WITH THE CITY OF THE

PROJECT SPECIFIC NOTES

1. SOLIS EMELHER SHALL REVIEW THE EXISTING STRUCTURAL SECTION DURING CONSTRUCTION AND SHALL CLERR EXISTING SECTION WITH CITY OF SANTA ROSA PUBLIC WORKS DEPARTMENT MATERIALS LAB. IF STRUCTURAL SECTION IS NOT ADEQUATE THE ROADWAY SHALL BE RECONSTRUCTED TO CENTERLINE ALONG PROJECT FRONTAGE.

2. EXPANSION INDEX (EI) OF 22-50 IS LOW, AND 51-90 IS MEDIUM. SUBGRADE SHALL BE TESTED BY THE SOILS ENGINEER AND ALL AREAS WITH EI OF \$1.00 REGETER WILL BE PROTECTED BY A MONISTURE BANKER OR RECEIVE A USE MECANATION AND BACKFILL OF MATERIAL BELOW EI \$1.00 THAT CITY MATERIALS LAB PRIOR TO SAMPLING. PROVIDE SUBGRADE CENTRICATION FOR EI TO CITY MATERIAL LAB.

#### GRADING NOTES

1. CONTRACTOR SHALL OBTAIN A DE-WATERING PERMET FROM THE MORTH COAST REGIONAL WATER QUALITY CONTROL BOOMN OR ANY DE-AMERIKAN OPERATIONS THAT AREA USE OF CONTROL BOOMN OR ANY DE-AMERIKAN OPERATIONS THAT AREA USE OF CONTROL BOOMN OF COMMON OF COMMO

A NOTICE OF INTENT TO COMPLY WITH THE TERMS OF THE GENERAL PERMIT TO DISCHARGE STORM WATER ASSOCIATED WITH CONSTRUCTION ACTIVITY MUST BE FILED WITH THE NORTH COAST RECIONAL WATER QUALITY CONTROL BOARD PRIOR TO THE ISSUANCE OF ANY GRADING PERMIT (CALL 707-576-2220 FOR INFORMATION)

TEMPORARY STOCKPILE SHALL NOT BE WITHIN CREEK SETBACK AREAS, PROTECTED VEGETATION/TREE AREAS OR WITHIN 10 FEET OF AN ADJACENT RESIDENTIAL PROPERTY LINE. STOCKPILES HIGHER THAN 2.5 FEET SHALL NOT BE WITHIN 50 FEET OF AN ADJACENT RESIDENTIAL PROPERTY LINE.

4. TEMPORARY STOCKPILES MUST BE REMOVED BY COMPLETION OF GRADING ACTIVITIES. OTHERWISE A SEPARATE TEMPORARY USE PERMIT AND GRADING PERMIT IS REQUIRED FOR THE STOCKPILE.

5. NO GRADING, CLEARING OR GRUBBING SHALL BE PERFORMED PRIOR TO ISSUANCE OF A GRADING PERMIT FROM THE CITY OF SANTA ROSA.

DUST CONTROL SHALL BE PROVIDED BY CONTRACTOR DURING ALL PHASES OF CONSTRUCTION.

7. SUBDIVISION GRADING SHALL OCCUR OMLY BETWEEN APRIL 15 AND OCTOBER 15 UNLESS OTHERWISE APPROVED BY THE CITY ENGINEER OR CHIEF BUILDING OFFICIAL IN CONJUNCTION WITH AN APPROVED RESSION AND SEDIMENT CONTING, PLAN AND A GRADING SCIEDULE TO BE SUBMITTED TO COMMUNITY DEVELOPMENT ENGINEERING WITH THE GRADING PERMIT APPLICATION. WITHTERZIATION OF THE PROJECT SHALL BE THE FIRST ORDER OF MOST.

8. EXISTING NON-COMPLYING FILLS SHALL BE REHOVED OR BROUGHT INTO COMPLIANCE WITH CHAPTER 33 AND 18, AND APPENDIX 33, MOST RECENT EDITION OF THE CALIFORNIA BUILDING CODE, AND THE SATISFACTION OF THE SOLIS ENGINEER.

9. ANY EXCESS AND UNSUITABLE MATERIAL SHALL BE REMOVED FROM THE SITE TO AM AREA APPROVED BY THE CITY BUILDING DIVISION AND CITY FIRE DEPARTMENT. APPROVALS MUST BE IN WRITING PRIOR TO REMOVAL OF MATERIAL.

10. DRAINAGE FROM UPSTREAM PROPERTIES SHALL NOT BE BLOCKED BY GRADING OR CONSTRUCTION OF IMPROVEMENTS.

11. CONTRACTOR SHALL PROTECT EXISTING DRAINAGE FACILITIES FROM SEDIMENTATION

13. PRIOR TO ANY GRADING OPERATION, THE CONTRACTOR SHALL INSTALL PROTECTIVE FEBCING AROUND THE DRIP LINE OF TREES TO BE SAVED IN COMPLIANCE WITH THE CITY TREE GROUNDANCE, GOR TREFUTINE WITHIN MOST OWNES OF TREES TO BE SAVED MUST N CUPTING, FILLING, PAVING BE REVIEWED AND APPROVED BY A CITY APPROVED ARBORIST AND DONE UNDER THEIR OW SITE SUPPRIVISION.

14. DRIP-LINES OF TREES OVERHANGING THE PROPERTY LINE SHALL BE AFFORDED THE SAME LEVEL OF PROTECTION AS TREES ON SITE THAT ARE TO REMAIN.

17. PROPOSED DEVELOPMENT MUST CONFORM TO 40 CFR (CODE OF FEDERAL REGULATIONS) PARTS 122, 123 AND 124 NATIONAL POLLUTANT DISCHARGE ELIMINATION SYSTEM (MPDES) PERMIT APPLICATIONS FOR STORM WATER DISCHARGE. PROJECT MUST ALSO COMFORM WITH ANY DESIGN AND CONSTRUCTION POLICIES ADOPTED BY THE CITY TO COMFORM WITH THESE

FILLING IS RESTRICTED TO I FOOT MAXIMUM ABOVE EXISTING GROUND ADJACENT TO EXISTING RESIDENTIAL LOTS, UNLESS OTHERWISE APPROVED BY THE CITY ENGINEER.

20. BLASTING (IF REQUIRED) REQUIRES A PERMIT FROM THE CITY FIRE DEPARTMENT.

21. PRIOR TO ANY GRADING OPERATION THE GRADING CONTRACTOR AND THE PROJECT SOILS ENGINEER SHALL JOINTLY SEARCH THE SITE FOR EXISTING WELLS AND SEPTIC SYSTEMS.

22. REMOVAL OF ANY STRUCTURE 10' X 12' OR LARGER REQUIRES A DEMOLITION PERMIT FROM THE CITY BUILDING DIVISION.

23. PRIVATE DRIVEWAYS SHALL BE CONSTRUCTED UNDER CONTINUOUS OBSERVATION BY TH SOILS ENGINEER IN COMPLIANCE WITH THE CITY DESIGN AND CONSTRUCTION STANDARDS. PROGRESS AND FINAL REPORTS SHALL BE FUNDALED TO THE CITY IN COMPLIANCE WITH C.B.C. SPECIAL INSPECTION REQUIREMENTS, ALL COSTS RELATED TO SUCH SPECIAL INSPECTIONS SHALL BE BORNE BY THE OWNER/DEVELOPER.

#### STORM DRAIN NOTES

1. ALL STORM DRAIN SHOWN "S.D." SHALL BE R.C.P., H.D.P.E. OR CAST-IN PLACE CONCRETE UNLESS OTHERWISE NOTED. STORM DRAIN SHALL BE CLASS III UNLESS OTHERWISE SHOWN ON THE PLAN AND PROFILES. ANY USE OF CAST-IN-PLACE PIETR REQUIRES SPECIAL INSPECTION AS CALLED DUT IN CITY STANDARDS, SECTION 61. IF H.D.P.E. IS TO BE USED, DRAWNIN SEVENISONS FOR PLAN DESIGN MAY BE REQUIRED.

2. ALL STORM DRAIN PIPE LENGTHS SHOWN ARE MEASURED HORIZONTALLY FROM CENTER OF STRUCTURES.

3. STORM DRAIN SYSTEM SHALL BE KEPT FREE OF DIRT AND DEBRIS DURING ALL PHASES OF



#### LOCATION MAP

#### INDEX OF DRAWINGS

COVER SHEET DETAILS AND ABBREVIATIONS

#### SIGNING, LIGHTING AND STRIPING NOTES

PROPOSED STRIPING AND MARKING SHALL BE INSTALLED THE SAME DAY AS THE REMOVAL OF THE EXISTING STRIPING AND MARKINGS. IF NOT, CONTRACTOR SHALL PROVIDE TEMPORARY PAVEMENT MARKERS UNTIL PROPOSE STRIPING AND MARKING ARE INSTALLED.

4. THE CONTRACTOR SHALL NOTIFY THE CITY TRAFFIC ENGINEER A MINIMUM OF 48 HOURS PRIOR TO THE DAY OF LAYOUT OF THE PROPOSED SIGNING AND STRIPING. CONTACT TRAFFIC ENGINEERING AT 543-3814.

5. THE CONTRACTOR SHALL BE RESPONSIBLE FOR LAYOUT AND CAT TRACKING OF ALL PROPOSED STRIPING AND MARKING. CAT TRACKING SHALL BE DONE A MINIMUM OF 48 HOURS PRIOR TO PROPOSED STRIPING AND MARKING TO ALLOW THE CITY TIME FOR REVIEW AND APPROVAL.

6. EXISTING STRIPING AND MARKING TO BE REMOVED, SHALL BE REMOVED BY GRINDING BY THE CONTRACTOR.

8 STOP SIGNS AND STREET NAME SIGNS SHALL BE PROVIDED AND INSTALLED BY CONTRACTOR PER CITY STD. DWG. 701, 705A, 705B, 705D, & 240, AND COMPLY WITH M.U.T.C.D. AND STATE SUPPLEMENTAL GUIDELINES FOR OTHER SIGNAGE.

ALL SIGNING SHALL BE REFLECTORIZED HIGH INTENSITY SHEETING AND SHALL BE OF ALUMINUM ALLOY MATERIAL PER CITY STANDARD SERIES 700.

ALL WIRING AND EQUIPMENT CONSTRUCTION SHALL ALSO CONFORM TO THE NATIONAL ELECTRIC CODES (NEC), SECTION 86 OF THE CALIFORNIA STANDARD SPECIFICATIONS.

A RUN OF CONDUIT SHALL NOT CONTAIN MORE THAN THE EQUIVALENT OF FOUR % BENDS (360°TOTAL)
INCLUDING OFFSETS AND BENDS LOCATED AT PULL BOXES AND SERVICE POINTS IN ACCORDANCE WITH THE
MATIONAL ELECTRIC COOR 347–144.

A, PROVIDE 3 COPIES OF THE JOINT TRENCH PLAN TO THE PUBLIC WORKS INSPECTOR, AND

B. MEET WITH THE PUBLIC WORKS INSPECTOR AT THE SITE TO REVIEW STREET LIGHT. CONDUIT PLANS AND IDENTIFY ALL PULL BOX LOCATIONS AND CONDUIT STREET CROSSINGS.

4. ELECTRICAL INFORMATION SHOWN ON THIS PLAN IS FOR BIDDING ONLY. STREET LIGHT LOCATIONS ARE

6. A NO. 5 PULL BOX PER CITY STD. 601 SHALL BE USED AT ALL STREET LIGHT STANDARD AND STREET CROSSINGS AND AT FUTURE INTERCONNECTS.

7. CONTRACTOR SHALL VERIFY STREET LIGHT SERVICE POINT LOCATIONS WITH PG&E PRIOR TO COMMENCING WORK.

R ALL CONDUCT TO BE USED SHALL BE A MINIMUM OF 2" DIAMETER S ALL CONDOL! TO BE USED SHALL BY MINISH OF 2 DIAMETER, EX-FROM EACH STREET LIGHT TO THE ADJACENT PULL BOX, WHICH MAY BE 1 DIAMETER PVC OR METAL, AND SHALL HAVE THE FOLLOWING COVER FROM THE TOP OF CONDUIT.

A. WITHIN SIDEWALK OR PARKWAY AREAS 2'-0" MIN. SCHEDULE 40 PVC.

B. WITHIN ROADWAY AREAS - 2"-6" MIN. SCHEDULE 40 PVC. OR 2"-6" MIN. SCHEDULE 80 PVC.

#### PRIVATE FIRE PROTECTION NOTE:

FIRE DEPARTMENT APPROVAL OF PUBLIC IMPROVEMENT PLANE DECEMON APPLIA PROVATE REPORTECTION LINES. THE PUBLIC REPORT OF THE PUBLIC REPORT

STORM DRAIN, MANHOLE, CATCH BASIN & DRAINAGE INLET	=≼	SOMM ZATS		OPENINGS AS NOTED ON PLANS	SDMH Std. 400	
RIGHT OF WAY						
SWALE FLOWLINE				-		
DRAINAGE FLOW ARROW WITH GRADE					. 2%,	-
EXISTING CONTOURS (1' INTERVAL)			-135— — — — — —			
FENCE		× ×	×			
GAS	. — анг —		GAS —	_		
OVERHEAD UTILITIES	он		он —			
STREET LIGHT		ф-	*			
SEWER SERVICE & CLEANOUT · · · · ·						
SEWER MAIN, MANHOLE & CLEANOUT	o <u>ss</u>	000 e* SS -	—O <sub>SSMH</sub>			
WATER MAIN, GATE VALVE, FIRE HYDRANT, BLOWOFF & SERVICES		7\O+ 5\O+ 127#	во Пис			
TREE PROTECTION FENCE				<b>–</b>	··-·	-
EXIST. TREE			TREE TO BE REMOV	ED	▲ TRE	E REMA

EXISTING

#### RECORD PLANS

\_\_\_

**LEGEND** 

MILL NOT BE RESPONSIBLE FOR ANY ERRORS OR OMISSIONS WHICH HAVE BEEN INCORPORATED INTO IDE OUT.

A RESULT. FIELD VERIFICATION OF CRITICAL FACTS AND DATA SHOULD BE MADE IF THESE DOCUMENTS ARE TO BE USED. AS A BASIS FOR FUTURE WORK.

**BENCHMARK** CITY OF SANTA ROSA BENCHMARK E110, DISK IN MONUMENT WELL AT THE CENTERLINE INTERSECTION OF PETERSON LANE AND CHRISTY COURT, ELEV: 134.

	100000150 01	,
	APPROVED BY	<u>(</u>
DEPARTMENT	INITIALS	DATE
FIRE		
UTILITIES		
PROJECT ENGINEER		

	( , ,
	PROJECT START
	PROJECT NO.
9	CONTR
	SUPER
	UN. GR. CONT
	SUPER
	SEWER PIPE
	WATER PIPE
	WATER VALVES
	TEES, WYES, FTGS.
	1EE5,W1E5,1100.
	FIRE HYDRANT.
	INSPECTOR.
	PROJECT DATA BY
	OTHER
	OTTLER
	<u> </u>

PROJECT DATA

DATE

NO.	REVIS	IONS DATE R	EXP.	CITY ENG.	DATE	PUBLIC IMPROVEMENTS APPROVED FOR CONSTRUCTION CITY OF SANTA ROSA
						BYANTHONY A. CABRERA R.C.E. 41858 CITY ENGREER PROPERTY DIRECTOR OF ENGINEERING  DATE
						CITY OF SANTA ROSA FILE NO




CONSI DESIGN Avenue, CA 964 B20 Rose.

징


വ

COVER SISCO AVEN SISCO AVENUE - SISCO AVENUE - YANKH OFFSITE I

SHEET NO.

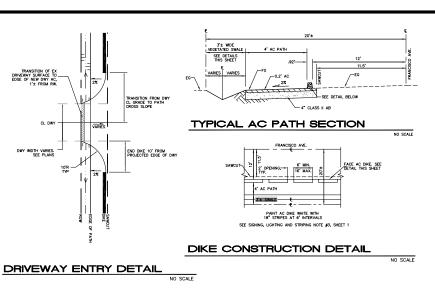

# EDGE OF AC PATH 3.4 SECTION AX WIDTH - 8" 2% DRAINAGE STRUCTURE — SIMILAR TO CITY STD. 408 SEE TABLE THIS SHEET Till sik <u>PLAN</u> INLET DETAIL

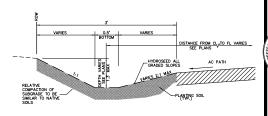


#### TYPE 1 SWALE DETAIL

NO SCALE

SEE PLANS -PLANTING SO

#### TYPE 2 SWALE DETAIL

NO SCALE

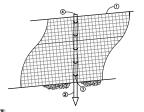


### NOTE: INSTALL TREE FENCE PRIOR TO CLEARING OR ANY GRADING OPERATION.

TENSOR LIGHTWEIGHT SAFETY GRID, ORANGE COLOR, BX226516. CUT OR FOLD GRID AT POSTS AS NEEDED TO CONFORM TO SLOPING TERRAIN. AVAILABLE THROUGH:

- LIGHTWEIGHT 5 1/2" HEIGHT STANDARD FARM QUALITY "T-POST" PLACED 8" O.C.
- METAL TIE WIRE, FLIP TIE OR EQUIVALENT, 5 PER POST.
- 1" X 1/4" X 4' WOOD LATH MEMBER, SANDWICH SAFETY GRID BETWEEN WOOD MEMBER AND "T-POST" FASTEN WITH METAL TIE WIRE, SEE NO. 3 ABOVE.

#### TREE PROTECTION FENCE

NO SCALE

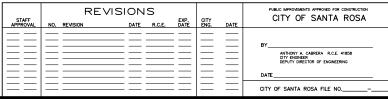

DRAINAGE STRUCTURES SHALL BE PRECAST CONCRETE AS MANUFACTURED BY CENTRAL PRECAST CONCRETE (CPC), NYLOPLAST (A DIVISION OF ADS) OR THEIR EQUIVALENT AS APPROVED BY THE ENGINEER AND THE CITY OF SANTA ROSA. TYPE AND MODEL AS SPECIFIED:

DI #1-4, 6-16 & 19

SIMILAR TO CITY STD. 408. CENTRAL PRECAST MODEL 2K WITH BOLT DOWN GRATE TOP OR EQUIVALENT AS APPROVED BY THE PROJECT ENGINEER AND/OR THE CITY OF SANTA ROSA, SIDE OPENING DEPTHS AND FACINGS AS INDICATED ON THESE PLANS.


DI #17 & 18


DRAINAGE STRUCTURES

CENTRAL PRECAST MODEL 2K WITH BOLT DOWN GRATE TOP OR EQUIVALENT AS APPROVED BY THE PROJECT ENGINEER AND/OR THE CITY OF SANTA ROSA.

SIMILAR TO CITY STD. 408. CENTRAL PRECAST MODEL 3L WITH BOLT DOWN GRATE TOP OR EQUIVALENT AS APPROVED BY THE PROJECT ENGINEER AND/OR THE CITY OF SANTA ROSA. SIDE OPENING DEPTHS AND FACINGS AS INDICATED ON THESE PLANS.

#### **ABBREVIATIONS**

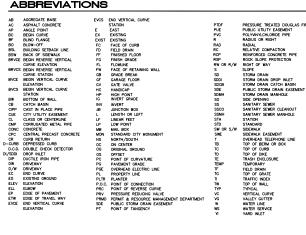

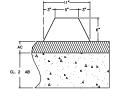

AC DIKE

NO SCALE


Š **ULTANTS**, CONSI


DESIGN Range Avenue, I Rosa, CA 9640 542-4820 S 2200 Berrie (707)


9 236/ PATH LANS PANCISCO AVENUE (2181 – FRANCISCO AVENUE - PEDESTRIAN I KERRY RANCH OFFSITE MANCHENER PANCHENER PANCHENER


JOR NO.

SHEET NO.

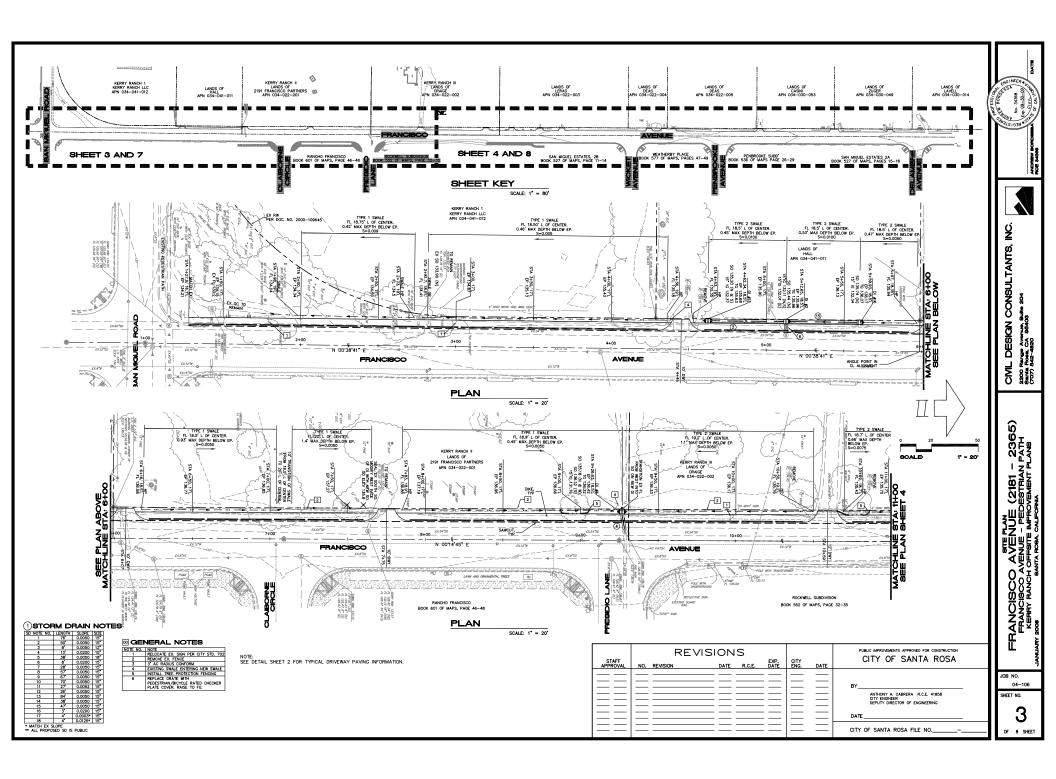

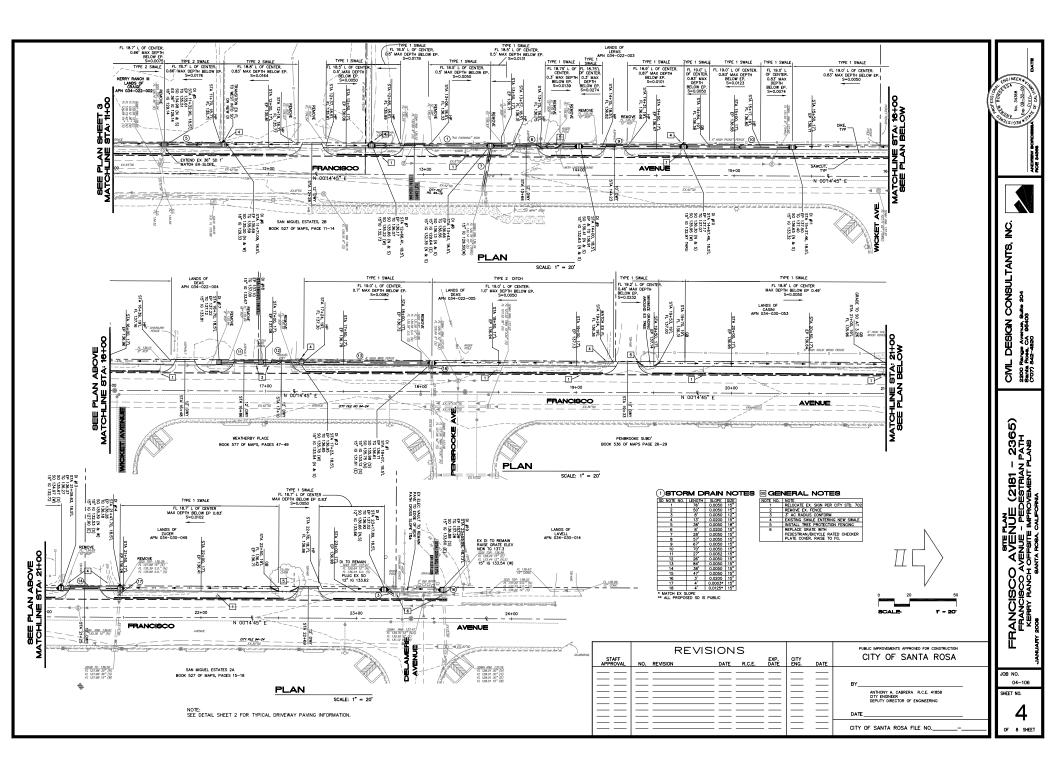

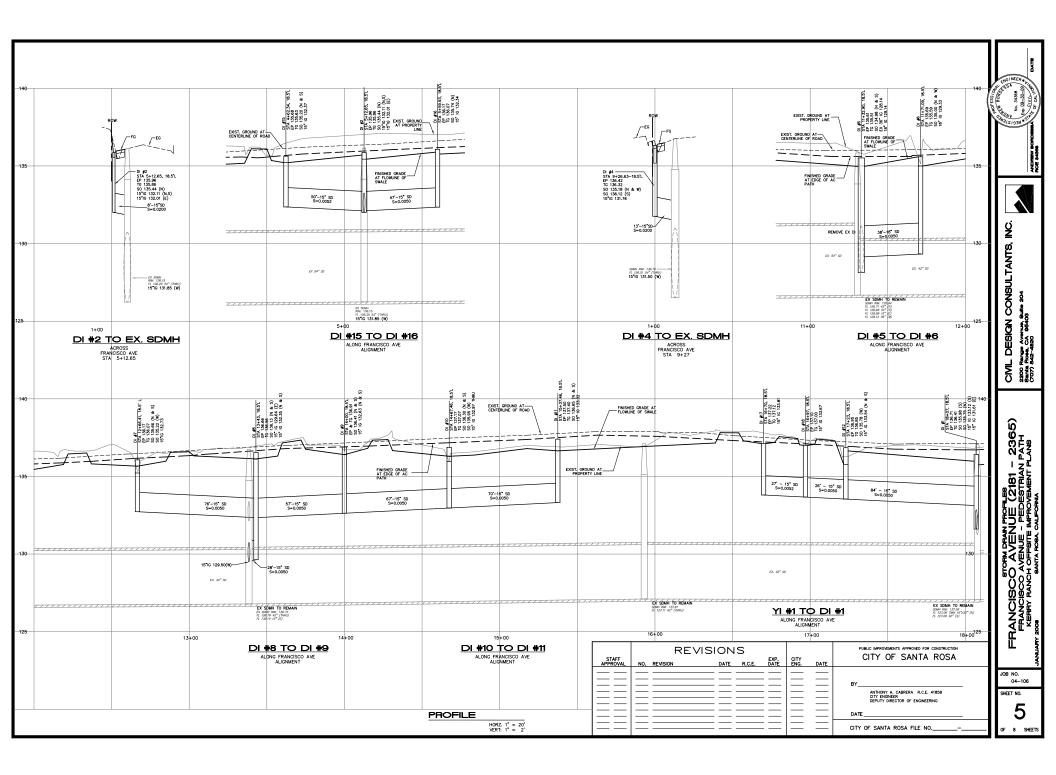

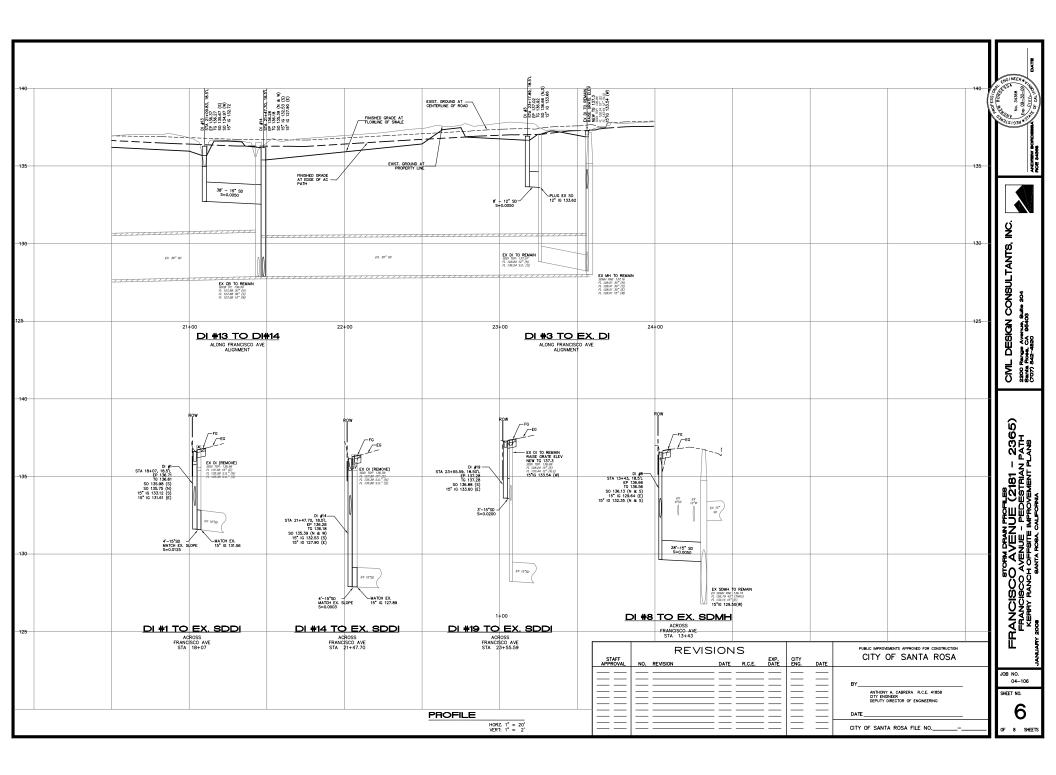

2. EROSION AND SEDIMENT CONTROL MEASURES SHALL BE USED TO ENSURE THAT WATER ENTERING THE STORM DRAIN SYSTEM BELOW THE CONSTRUCTION SITE IS EQUIVALENT QUALITY AND CHARACTER AS THE WATER ABOVE THE SITE.

3. EROSION AND SEDIMENT CONTROL MEASURES SHALL BE PLACED IN FRONT OF INCOMPLETE STORM DRAIN SYSTEMS TO PREVENT DEBRIS AND SEDIMENT-LADEN WATER FROM ENTERING INTO THE PUBLIC STORM DRAIN SYSTEM, BEST WANGEMENT PRACTICES SHALL BE USED WHEN DESIGNING AND INSTALLING SUCH DEWCES.

4. THE CONTRACTOR SHALL BE RESPONSIBLE FOR CONSTANT MAINTENANCE OF EROSION AND SEDIMENT CONTROL MEASURES AT ALL TIMES TO THE SATISFACTION OF THE ENGINEER AND CITY OF SANTA ROSA. EROSION AND SEMENT CONTROL MEASURES AND THEIR INSTALLATION SHALL BE ACCOMPLISHED USING BEST MANAGEMENT PRACTICES.

5. IF THE STORM DRAIN SYSTEM IS NOT IN PLACE BY OCTOBER 15, ADDITIONAL MEASURES SHALL BE TAKEN SUCH AS TEMPORARY SETTLING BASINS WHICH MEET THE SATISFACTION OF THE ENGINEER AND THE CITY OF SANTA ROCA. SLIT ANO/OR CATCH BASINS MUST BE CLEANED OUT ON A REGULAR BASIS AFTER STORMS TO MAINTAIN DESIGN CAPACITY.

6. STORM WATER RUNOFF FROM THE CONSTRUCTION SITE SHALL BE DIRECTED TOWARD AN INLET WITH A SEDIMENT OR FILTRATION INTERCEPTOR PRIOR TO ENTERING THE STORM DRAIN SYSTEM.

7. THE CONTRACTOR WILL BE RESPONSIBLE FOR CLEANING WATER THAT HAS BECOME POLLUTED DUE TO NOT TAKING NECESSARY EROSION AND SEDIMENT CONTROL ACTIONS.

8. THE CONTRACTOR SHALL BE RESPONSIBLE FOR CLEANUP OF MUD AND DEBRIS CARRIED ONTO SURROUNDING STREETS AND ROADS AS A RESULT OF CONSTRUCTION ACTIVITY ON THE SITE OT THE SATISFACTION OF THE CITY OF SANTA ROSA.

9. ANY DENUDED OR DISTURBED SOILS SHALL BE PROTECTED USING BEST MANAGEMENT PRACTICES.

10. BETWEEN OCTOBER 15 AND APRIL 15, ALL PAVED AREAS WILL BE KEPT CLEAR OF EARTH MATERIAL AND DEBRIS. THE SITE IS TO BE MAINTAINED BY THE DEVELOPER, CONTRACTOR OR OWNER SO THAT A MINIMUM OF SEDIMENT-LADEN RUNOFF LEAVES THE SITE.

12. DURING THE PAHLY SEASON (TYPODALLY OCTOBER 15 TO APRIL 15) ALL SEDIEST BARRIERS ARE TO BE RISPECTED AND REPARLIES AT THE RIN OF EACH MICRORIO DAY AND, IN ADDITION, AFTER EACH STORM. CONTRACTOR SHALL INSPECT EROSION AND SEDMENT CONTROL MEASURES AND INLEST AFTER EACH SOMPLICATION FRANKLI AND DAILY DURING PROLONGED STORM EVENTS. REMOVE SEDMENTS WHEN ACCUMULATIONS REACH 1/3 THE PROPER FUNCTION ARKRIER AND REPLACE FILET DEVICES OF MECESSARY TO ENDESSE OF THE PROPER FUNCTION ARKRIER AND REPLACE FILET DEVICES OF MECESSARY TO ENDESSE.

13. UNSTABILIZED AREAS WILL BE REPAIRED AS SOON AS POSSIBLE AFTER BEING DAMAGED.

14. ALL GRADED OR DISTURBED AREAS SHALL BE STABILIZED IMMEDIATELY AFTER GRADING IS COMPLETE.

15. ENTRANCE TO THE PROJECT SHALL BE MAINTAINED IN A CONDITION THAT WILL PREVENT TRACKING OR FLOWING OF SEDWENT INTO PUBLIC RIGHT—OF—WAY, WHEN NICCESSARY, WHES SHALL BE CLEARED TO REMOVE SEDWENT PRIGHT TO ENTRANCE OF PUBLIC RIGHTS—OF—WAY. WHEN WASHING IS REQUIRED IT SHALL BE DONE IN AN AREA STABILIZED WITH CRUSHED ROCK THAT DRAINS INTO A SEDWENT TRAP.

16. ALL SEDIMENT SPILLED, DROPPED, OR TRACKED ONTO PUBLIC RIGHTS-OF-WAY SHALL BE REMOVED IMMEDIATELY USING BEST MANAGEMENT PRACTICES.

17. ALL EROSION AND SEDIMENT CONTROL MEASURES SHALL BE REMOVED WHEN THEY HAVE SERVED THEIR PURPOSE SO AS NOT TO BLOCK OR IMPEDE STORM FLOW OR DRAINAGE.

18. ALL EROSION AND SEDIMENT CONTROL MEASURES SHALL BE REPAIRED OR REPLACED WHEN THEY ARE NO LONGER FUNCTIONING PER BEST MANAGEMENT PRACTICES.

19. THE CONTRACTOR SHALL HAVE EROSION AND SEDIMENT CONTROL MEASURES ON SITE ADEQUATE TO PROTECT THE ENTIRE SITE PRIOR TO THE OCTOBER 15 DATE SUCH THAT IT IS IMMEDIATELY AVAILABLE IN PREPARATION OF THE UPCOMING WINTER SEASON OR IN THE EVENT OF AN EARLY RAIN.

20. AFTER CONSTRUCTION IS COMPLETE ALL STORM DRAIN SYSTEMS ASSOCIATED WITH THIS PROJECT SHALL BE INSPECTED AND CLEARED OF ACCUMULATED SEDIMENTS AND DEBRIS.

21. ALL BARE AND/OR DISTURBED SOIL SURFACES ALONG PROJECT SHALL BE HAND SEEDED AND FERTILIZED PER APPLICATION RATE TABLE ABOVE. AFTER SEED APPLICATION, APPLY NORTH AMERICAN GREEN EROSION CONTROL BLANKET (TYPE SC150BN), OR EQUIVALENT INSTALLED PER MANUFACTURERS RECOMMENDATIONS.

APPLY - SEED

87 LBS./ACRE COVERAGE

HARD FESCUE RK STRAWBERRY CLOVER RK WHITE DUTCH CLOVER 9.99% 4.98% 4.90% ACHILLEA RUBRA 2.94% 0.60% 0.67% 0.00% BARY BLUE EYES ENGLISH LAWN DAISY INERT MATTER

ADDITIONAL SEED PER 1,000 SQ. FT.: ESCHSCHOLZIA CALIFORNICA (CALIFORNIA POPPY) 2.0 OZ. LUPINUS SUCCULENTUS (LUPINE)

NOTES:

1. THE SANDBAGS SHOULD BE OF WOVEN-TYPE GEOTEXTILE FABRIC.

2. SANDBAGS SHALL BE FILLED WITH 3/4" DRAIN ROCK OR 1/4" PEA GRAVEL.

3. INSPECT AND CLEAN THE BARRIER AFTER EACH SIGNIFICANT STORM (1" IN 24 HOURS) AND REMOVE SEDIMENT FROM BEHIND THE BAGS AFTER EVERY STORM.

4. ANY SEDIMENT AND GRAVEL SHALL BE IMMEDIATELY REMOVED FROM THE TRAVELED WAY OF ROADS.

5. THE REMOVED SEDIMENT SHALL BE PLACED WHERE IT CANNOT ENTER A STORM DRAIN, STREAM, OR BE TRANSPORTED OFF SITE. INLET PROTECTION

STAFF	REVISIONS EXP. GITY			CITY	PUBLIC IMPROVEMENTS APPROVED FOR CONSTRUCTION CITY OF SANTA ROSA
APPROVAL	NO. REVISION	DATE R.C.E.	DATE	ENG. DATE	0.11 0. 0. 0. 0. 0. 0. 0. 0. 0. 0. 0. 0. 0.
l — — I					
					BY
			—		ANTHONY A. CABRERA R.C.E. 41858
— —					CITY ENGINEER DEPUTY DIRECTOR OF ENGINEERING
			_		DATE
			_		
					CITY OF SANTA ROSA FILE NO

CONSULTANT Avenue, CA 964 B20 Rose. CM 2200 Berrie (707)

છ 236/ PATH LANS 181 FINAN 1 E CONTRACTOR AVENUE - PE

NO SCALE

SHEET NO.

