
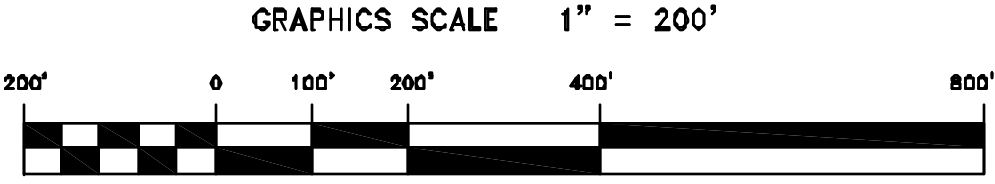


PRELIMINARY ISSUE
 HUMBOLDT COUNTY
 ADVANCED PUBLIC WORKS

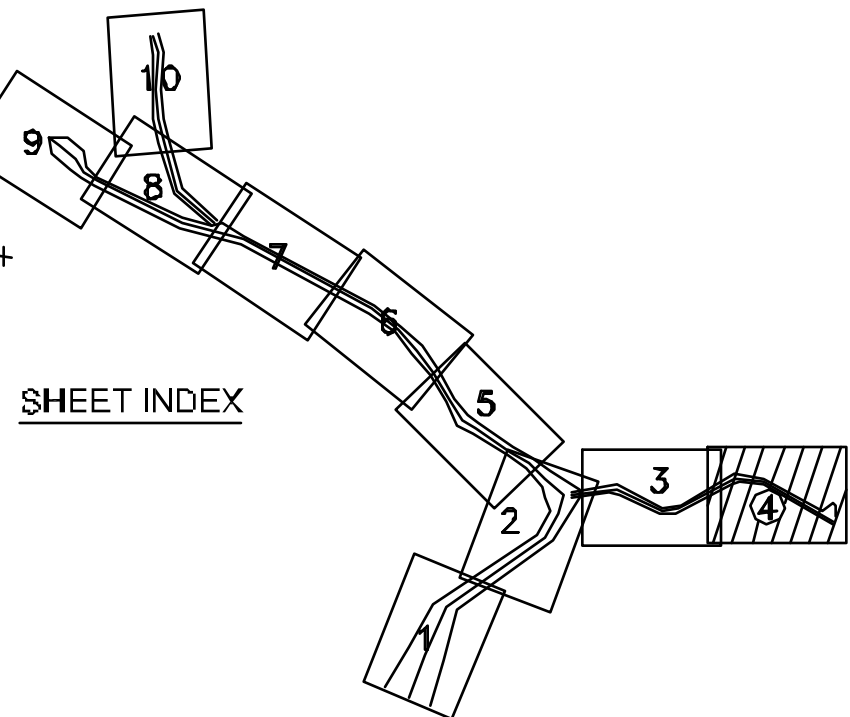

LEGEND:

— (Red line)	-26'
— (Green line)	-25'
— (Blue line)	-24'
— (Cyan line)	-23'
— (Magenta line)	-22'

US Army Corps of Engineers
 San Francisco District
 1455 Market Street
 San Francisco, CA 94103

Mark	Description	Date	Appr.

SUBMITTED BY:	PDT	DESIGNED BY:	DRIVEN BY:	DRAWN BY:	PDT
Hydra Survey Team Leader					
APPROVAL RECOMMENDED:		DATE:	SHEET NO.:	DRAWING NO.:	XXX
		3/8/2010	4 OF 10	X	X
APPROVED:		PREPARED UNDER THE DIRECTION OF:			
		TORREY A. DICIRO			
		Lt. Colonel, C.E., DISTRICT ENGINEER			
		CHM, Construction Standards			

HUMBOLDT COUNTY
 CALIFORNIA
**HUMBOLDT BAY
 FIELDSLANDING
 CONDITION SURVEY
 05 MARCH 2011**

Sheet reference number
C4