
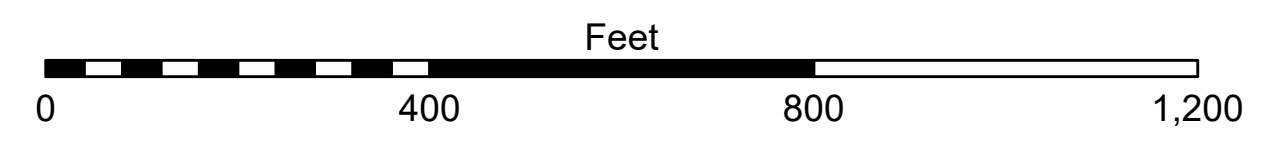




Prepared Under the Direction of TRAVIS J. RAYFIELD LT COLONEL, C.E., DISTRICT ENGINEER	Chart Date: Mar 12, 2018
Standard: Hydro Survey Team Leader	Designed by: PDT
Recommended: Chief, Hydro Survey Section	Drawn by: PDT
Approved: Chief, Construction Branch	

CALIFORNIA
SAN JOAQUIN COUNTY
SACRAMENTO RIVER
CONDITION SURVEY
21, 25, 27-28 FEBRUARY 2018

Sheet
Reference
Number
1 of 45

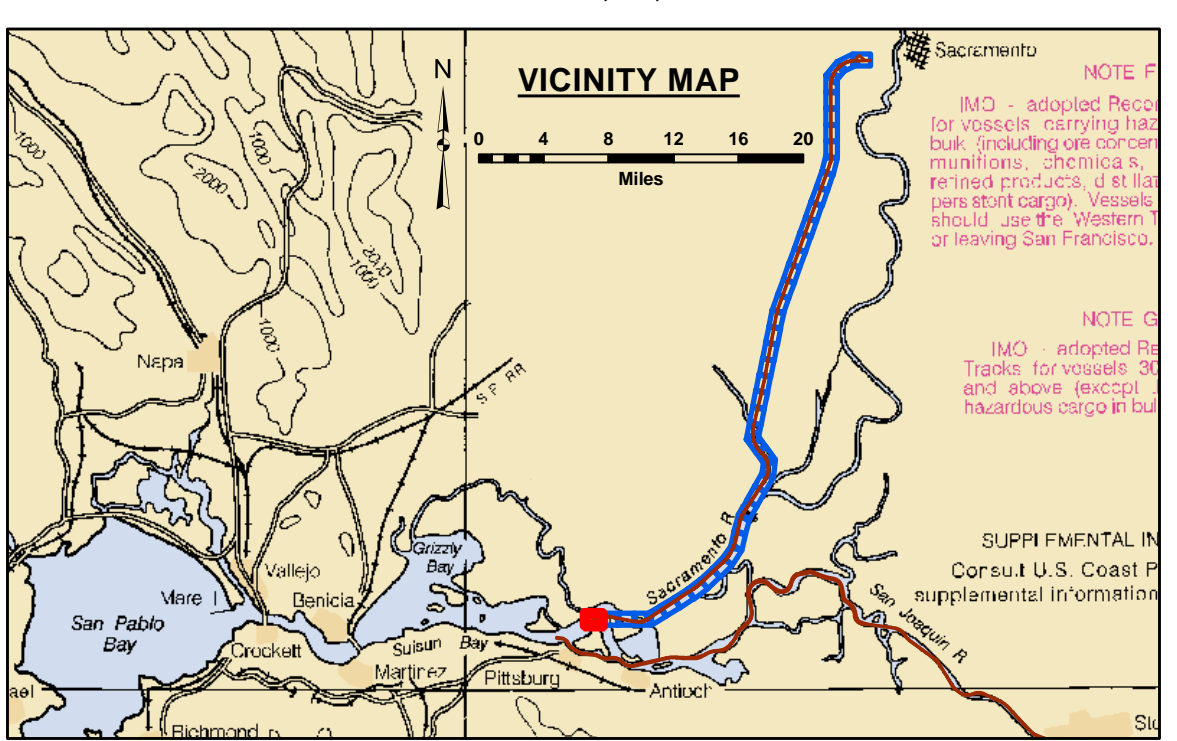

LEGEND		Contours	
--- Federal Navigation Channel	▨ Cable Area	— -30	
— Federal Navigation Center Line	□ Placement Area	— -29	
..... Cable Submarine	▨ Anchorage Area	— -28	
- - - Cable Overhead	⊗ Obstruction Point	— -27	
— Contour Line	✦ Wrecks-Submerged	— -26	
	● Shoaling Area		
	● Shoalest Sounding**		
	⊥ Beacon, General		
	◆ Red Navigation Buoy		
	◆ Green Navigation Buoy		

NOTES:
DRAWING NOT TO BE USED FOR NAVIGATION. ONLY CHANNEL CONDITION AT DATE OF SURVEY.
THE LOCATION OF ALL NAVIGATION AIDS ARE BASED ON INFORMATION PROVIDED BY THE U.S. COAST GUARD.
BUOY LOCATIONS REPRESENT THE POSITION OF THE SINKER ONLY.

SOUNDINGS WERE TAKEN BY FATHOMETER AND ARE SHOWN TO THE NEAREST TENTH OF A FOOT.
SOUNDINGS ARE BASED ON THE DATUM OF MEAN LOWER LOW WATER AT THE LOCALITY.

NORTH AMERICAN DATUM OF 1983 (NAD83), PROJECTED TO THE STATE PLANE COORDINATE SYSTEM (SPCS), CA ZONE II (0402). DISTANCE UNITS IN U.S. SURVEY FEET.

PLANE GRID AND COORDINATES ARE BASED ON LAMBERT PROJECTION, NAD 83, ZONE II CALIFORNIA AS DESCRIBED IN SPECIAL PUBLICATION NO. 235, PUBLISHED BY THE NATIONAL OCEAN SURVEY.


PROJECT DEPTH: -30'
VERTICAL DATUM: MLLW


THE LOCATION OF NAVIGATION AIDS ARE BASED ON AND PROVIDED BY THE U.S. COAST GUARD

CONTROLS:
LOCATION: RIO VISTA
NOAA STATION: 9415316
BENCHMARK: 5316 B 1996 (NO PID)
TIDE GAUGE: NAIL @ 8.2 FT MLLW
METADATA: NAIL SET BY USACE 31 MARCH, 2014

LOCATION: PORT OF WEST SACRAMENTO
NOAA STATION: 9416131
BENCHMARK: POWS1 (NO PID)
TIDE GAUGE: NAIL @ 10.0 FT MLLW
METADATA: NAIL SET BY USACE 8 APRIL, 2014

ALL HORIZONTAL POSITIONS AND MLLW ELEVATIONS WERE POST-PROCESSED USING PUBLIC GPS REFERENCE STATIONS IN THE AREA.


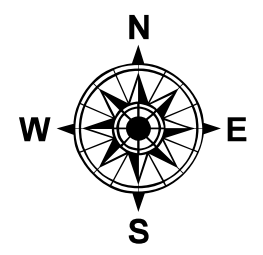


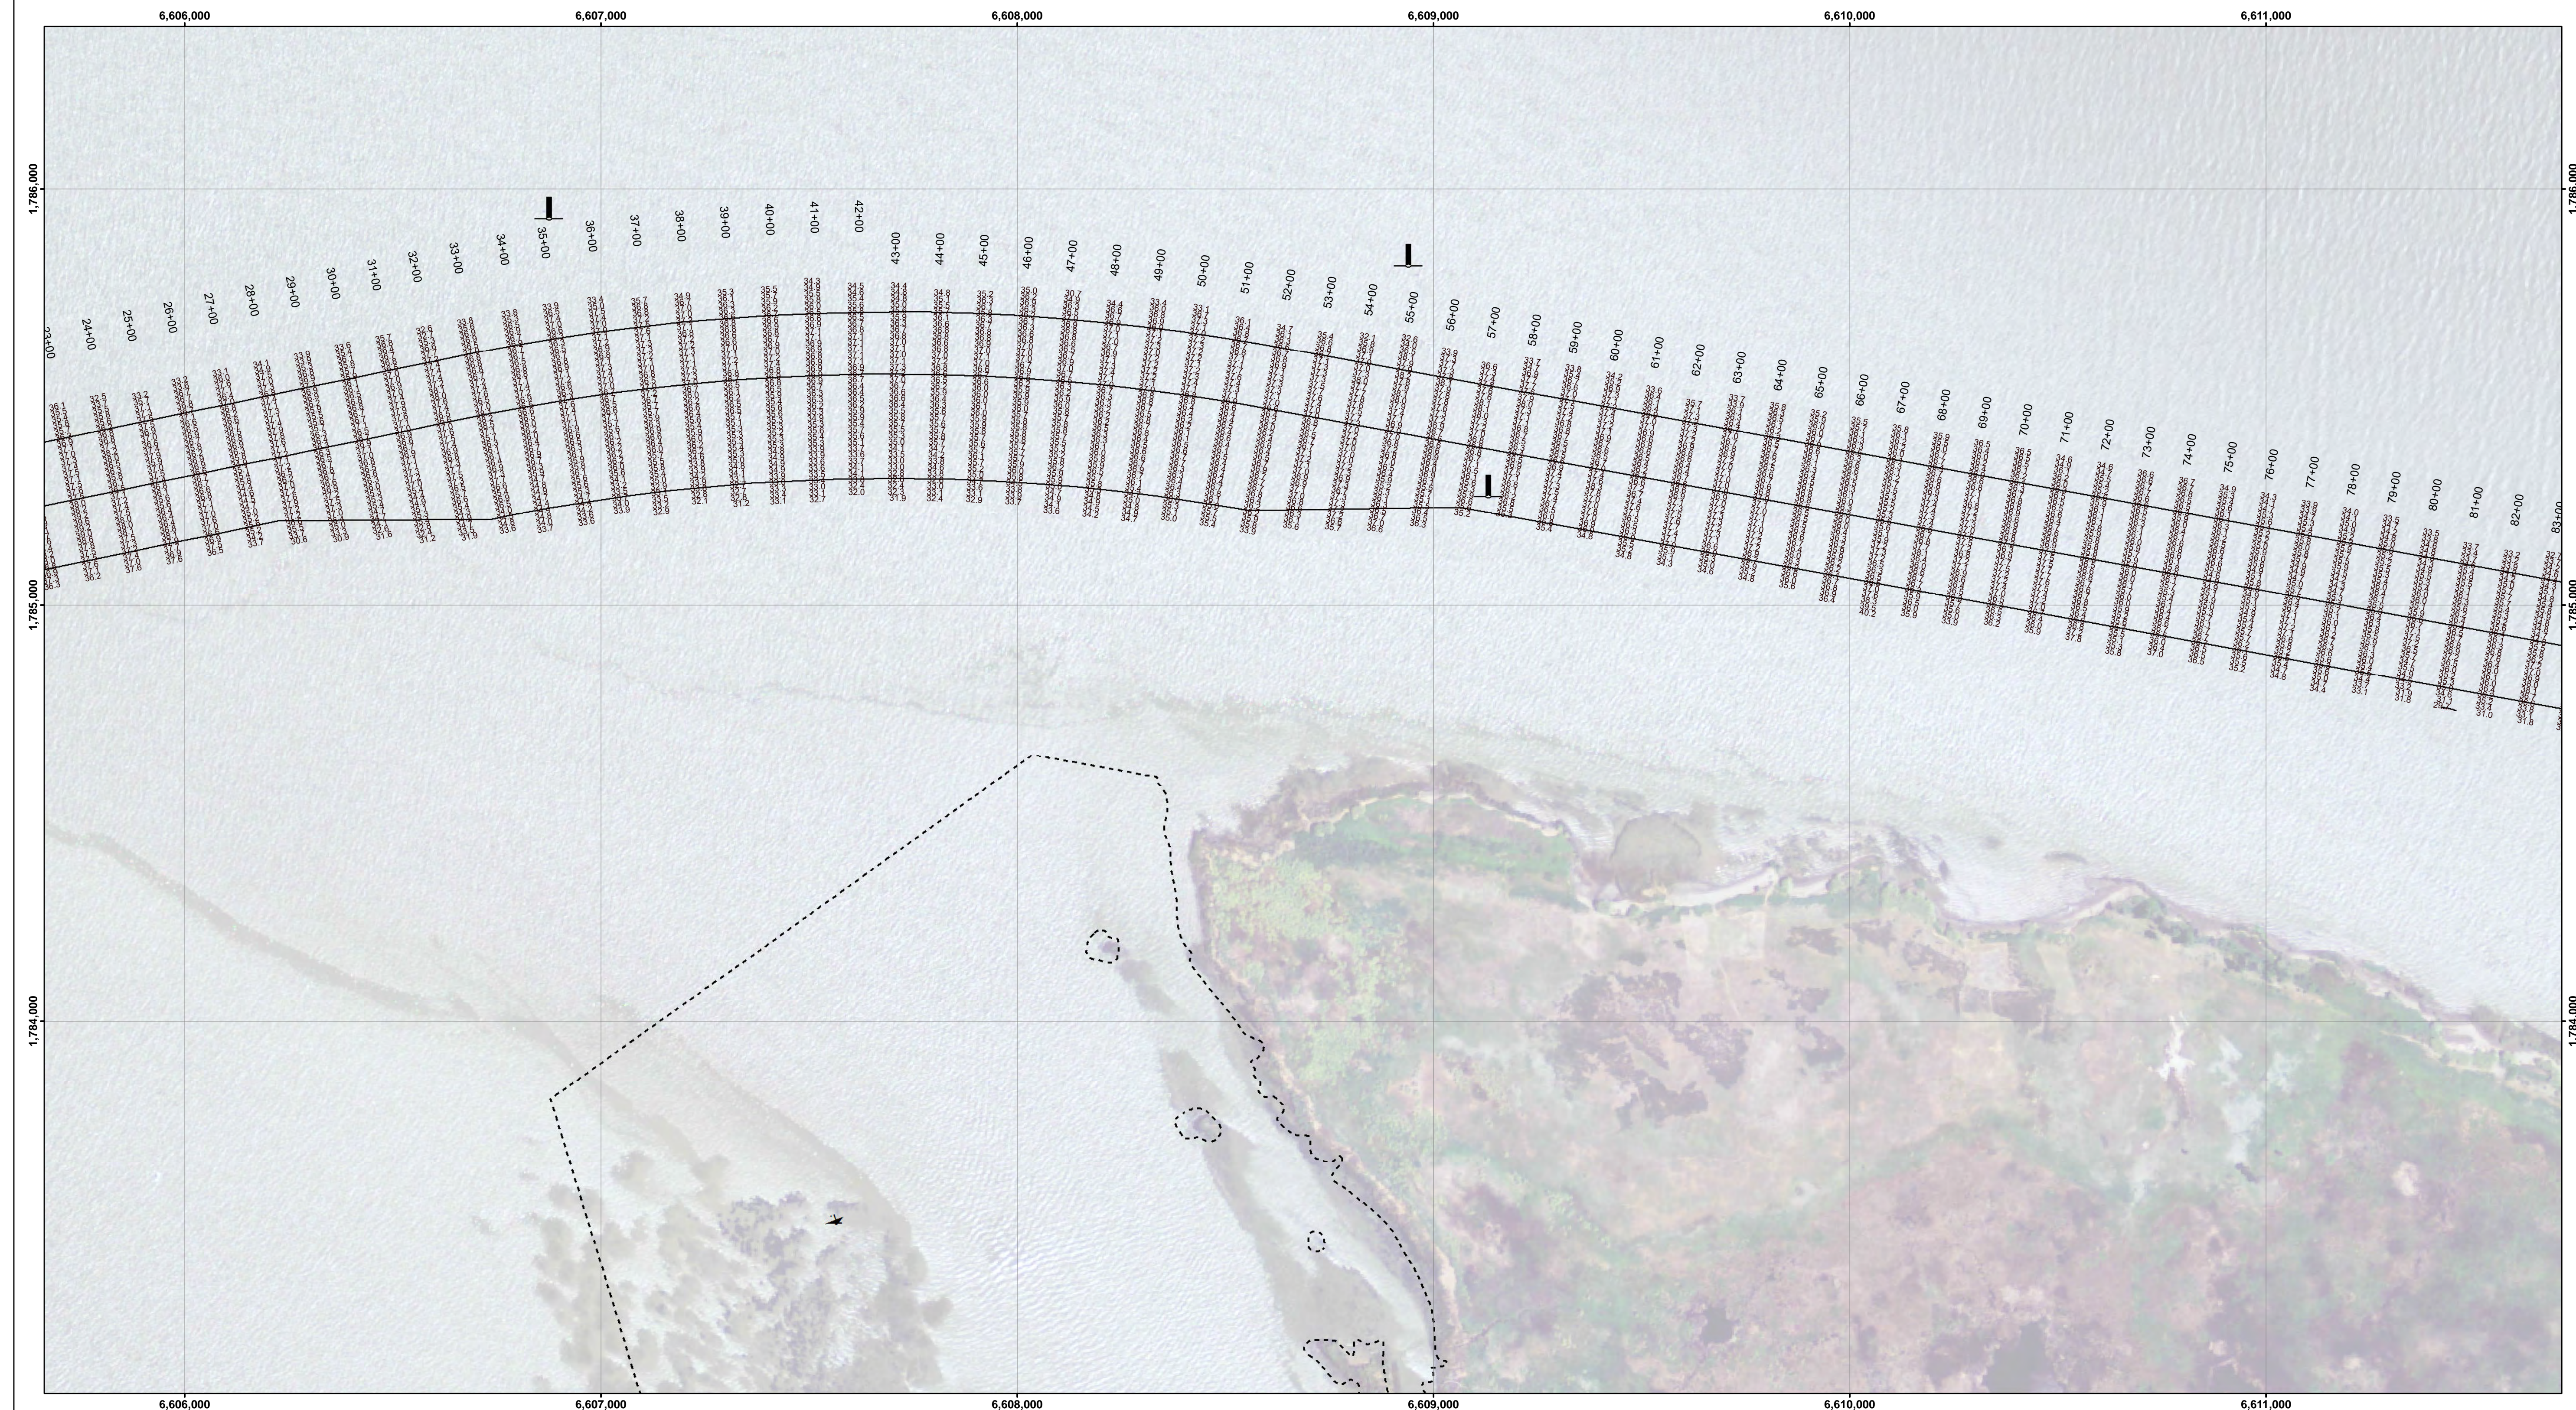

DISCLAIMER: The United States Government furnishes these data and the results of the survey for the use of the user. The user is responsible for the accuracy of the data and the results of the survey. 


Prepared Under the Direction of TRAVIS J. RAYFIELD LT COLONEL, C.E., DISTRICT ENGINEER	Chart Date: Mar 12, 2018
Standard: Hydro Survey Team Leader	Designed by: PDT
Recommended: Chief, Hydro Survey Section	Checked by: PDT
Approved: Chief, Construction Branch	Drawn by: PDT

CALIFORNIA
SAN JOAQUIN COUNTY
SACRAMENTO RIVER
CONDITION SURVEY
21, 25, 27-28 FEBRUARY 2018

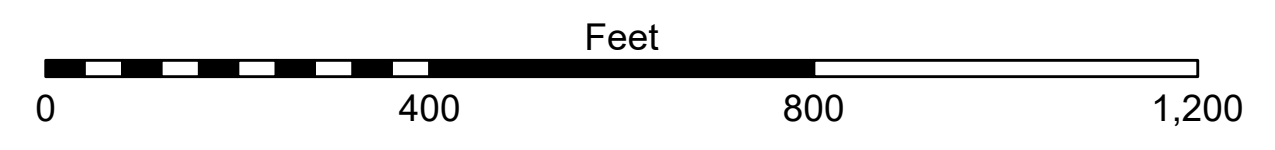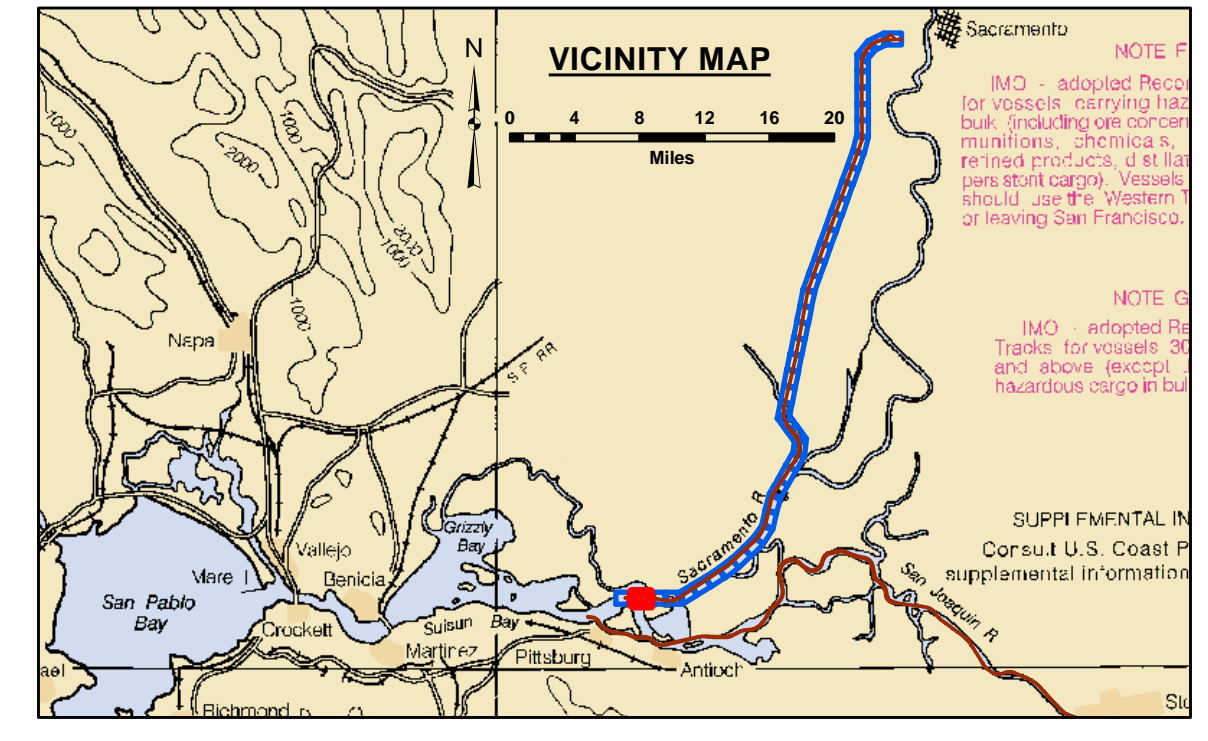


LEGEND		Contours	
--- Federal Navigation Channel	▨ Cable Area	— -30	
— Federal Navigation Center Line	□ Placement Area	— -29	
⋯ Cable Submarine	⊞ Anchorage Area	— -28	
- - - Cable Overhead	⊗ Obstruction Point	— -27	
— Contour Line	✦ Wrecks-Submerged	— -26	
	⊥ Beacon, General		
	◆ Red Navigation Buoy		
	◆ Green Navigation Buoy		

NOTES:
DRAWING NOT TO BE USED FOR NAVIGATION. ONLY CHANNEL CONDITION AT DATE OF SURVEY.
THE LOCATION OF ALL NAVIGATION AIDS ARE BASED ON INFORMATION PROVIDED BY THE U.S. COAST GUARD.
BUOY LOCATIONS REPRESENT THE POSITION OF THE SINKER ONLY.
SOUNDINGS WERE TAKEN BY FATHOMETER AND ARE SHOWN TO THE NEAREST TENTH OF A FOOT.
SOUNDINGS ARE BASED ON THE DATUM OF MEAN LOWER LOW WATER AT THE LOCALITY.
NORTH AMERICAN DATUM OF 1983 (NAD83), PROJECTED TO THE STATE PLANE COORDINATE SYSTEM (SPCS), CA ZONE II (0402), DISTANCE UNITS IN U.S. SURVEY FEET.
PLANE GRID AND COORDINATES ARE BASED ON LAMBERT PROJECTION, NAD 83, ZONE II CALIFORNIA AS DESCRIBED IN SPECIAL PUBLICATION NO. 235, PUBLISHED BY THE NATIONAL OCEAN SURVEY.
PROJECT DEPTH: -30'
VERTICAL DATUM: MLLW
THE LOCATION OF NAVIGATION AIDS ARE BASED ON AND PROVIDED BY THE U.S. COAST GUARD

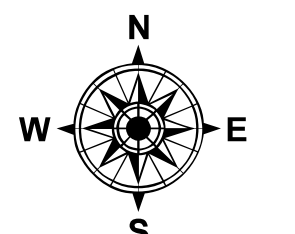


CONTROLS:
LOCATION: RIO VISTA
NOAA STATION: 9415316
BENCHMARK: 5316 B 1996 (NO PID)
TIDE GAUGE: NAIL @ 8.2 FT MLLW
METADATA: NAIL SET BY USACE 31 MARCH, 2014
LOCATION: PORT OF WEST SACRAMENTO
NOAA STATION: 9416131
BENCHMARK: POWS1 (NO PID)
TIDE GAUGE: NAIL @ 10.0 FT MLLW
METADATA: NAIL SET BY USACE 8 APRIL, 2014
ALL HORIZONTAL POSITIONS AND MLLW ELEVATIONS WERE POST-PROCESSED USING PUBLIC GPS REFERENCE STATIONS IN THE AREA.

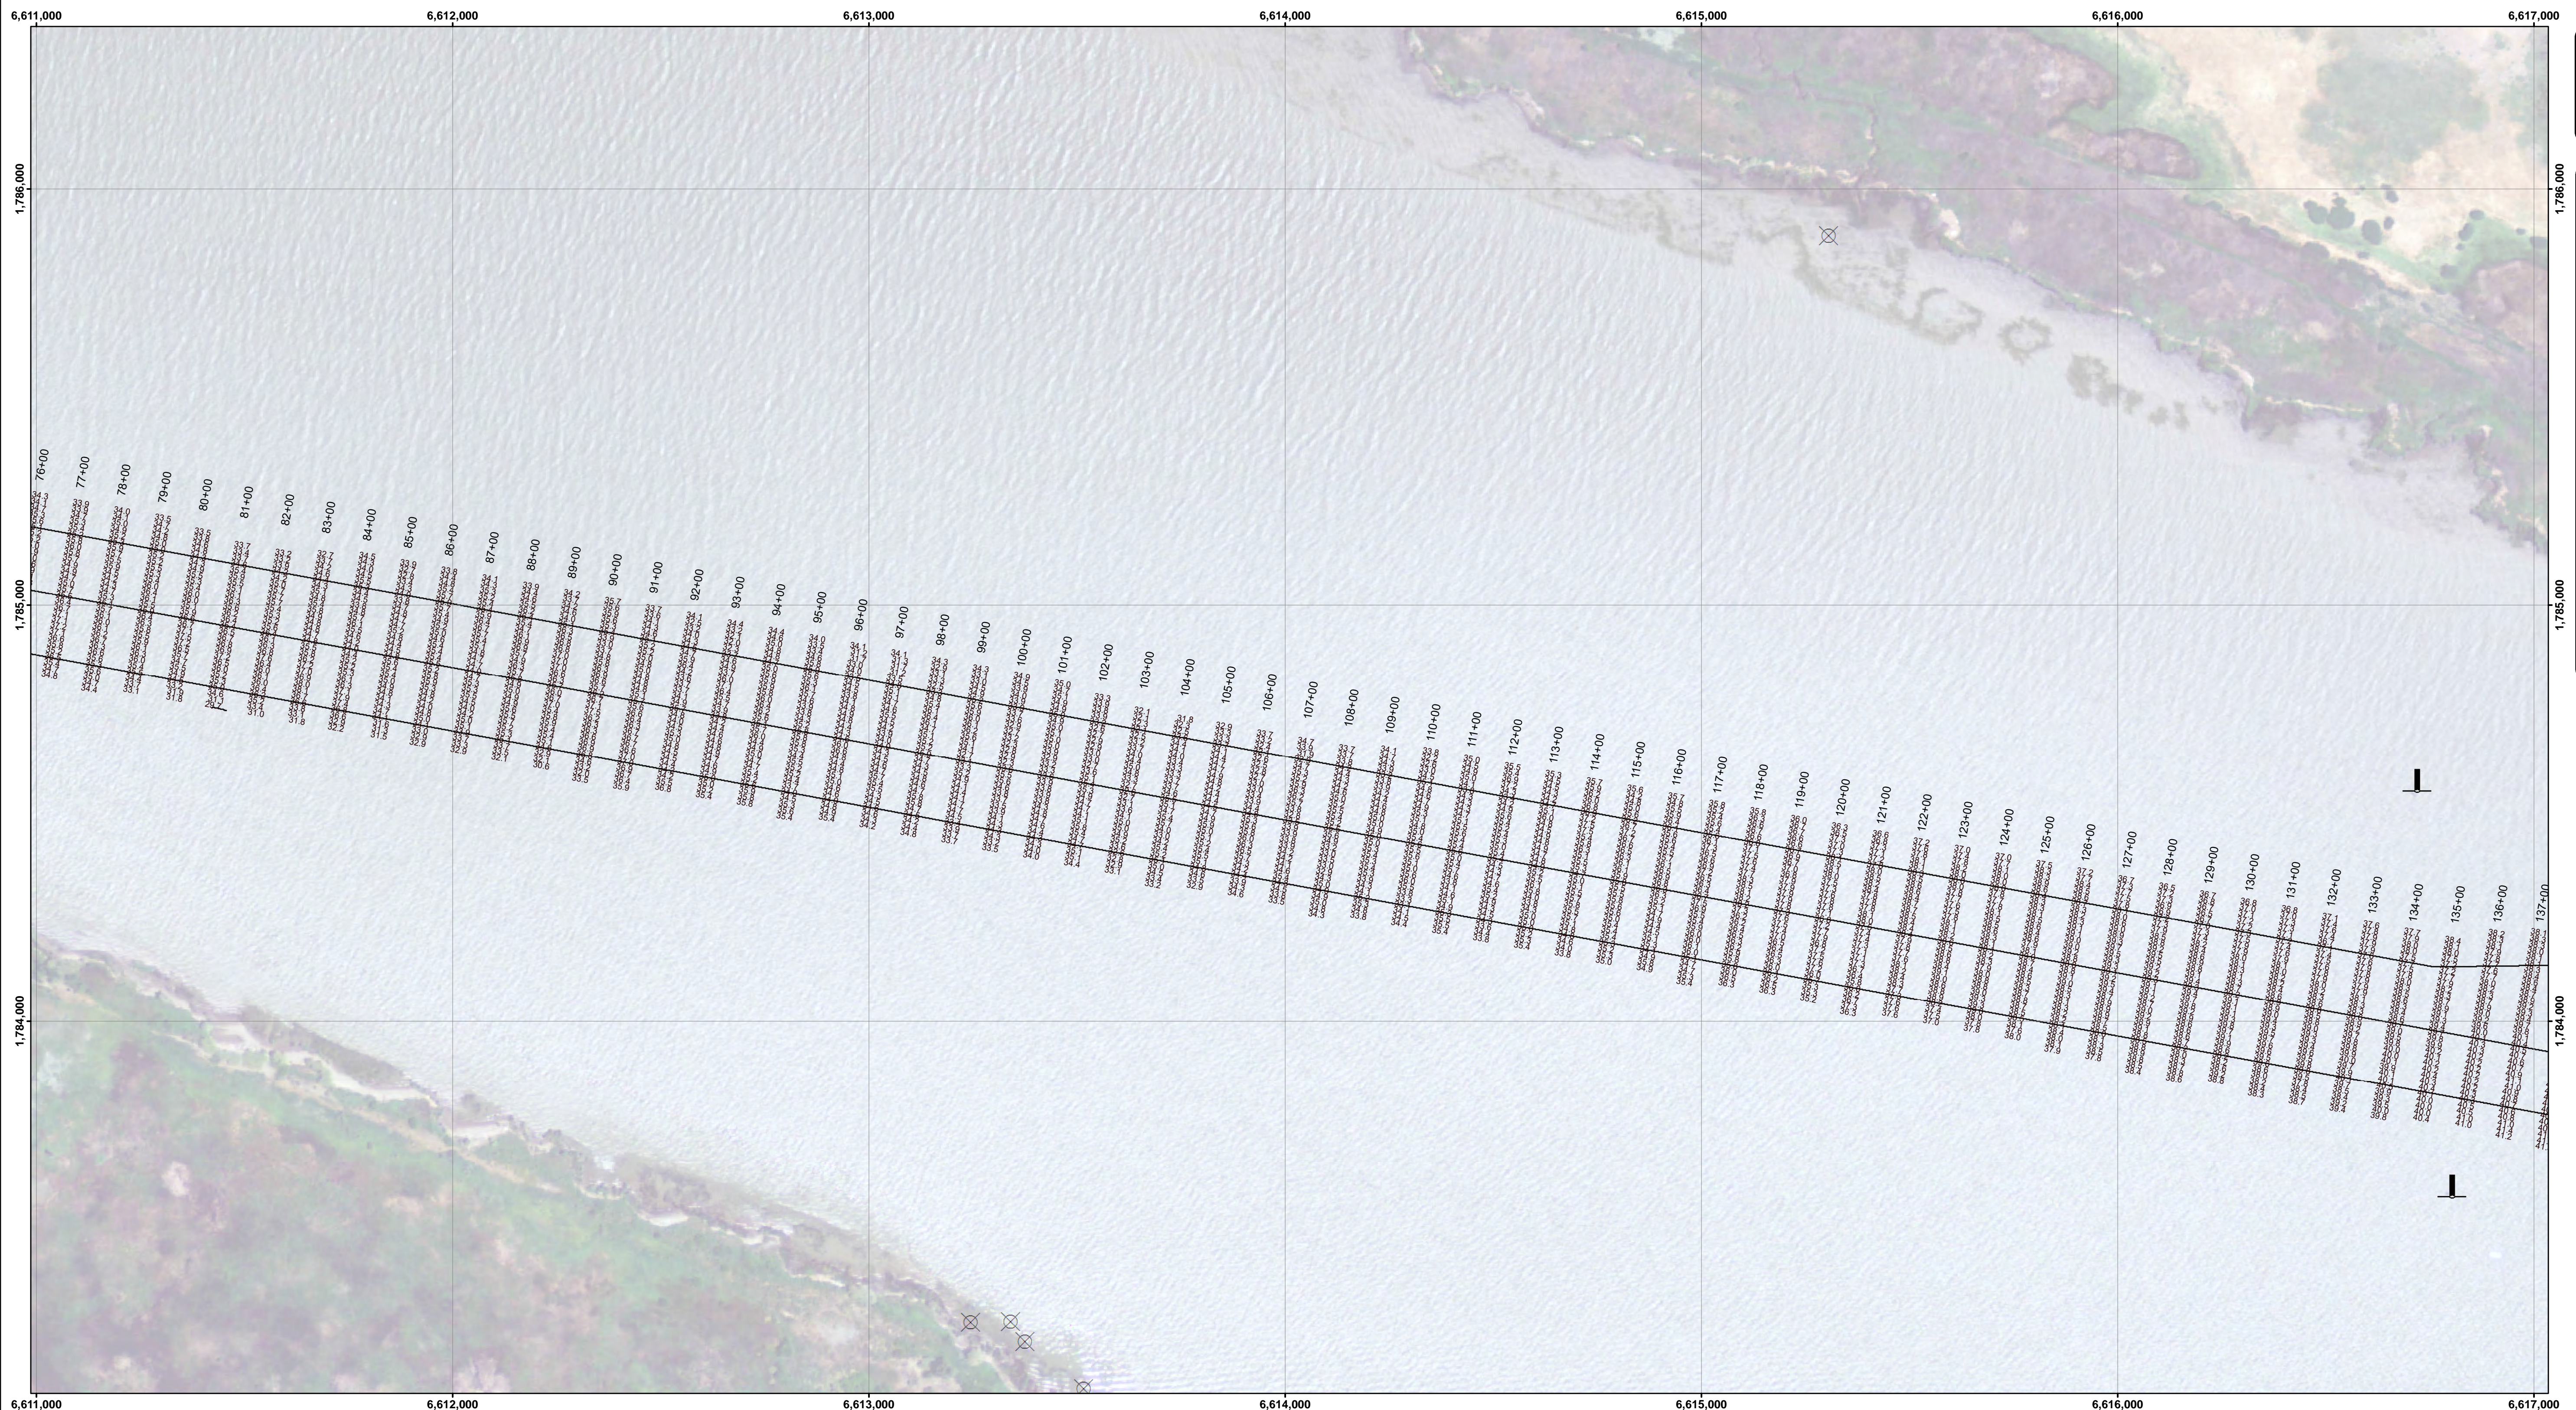

DISCLAIMER: The data represents the results of data collection/processing for a specific US Army Corps of Engineers project. It is not intended for use in any other project. As such, it is only valid for its intended use, content, time and accuracy specifications. The user is responsible for the results of any of the application of the data for other than its intended purposes.



Prepared Under the Direction of TRAVIS J. RAYFIELD LT COLONEL, C.E., DISTRICT ENGINEER	Chart Date: Mar 12, 2018
Surveyed By: Hydro Survey Team Leader	Designed by: PDT
Plotted By: PDT	Drawn by: PDT
Checked By: Chief, Hydro Survey Section	
Approved: Chief, Construction Branch	

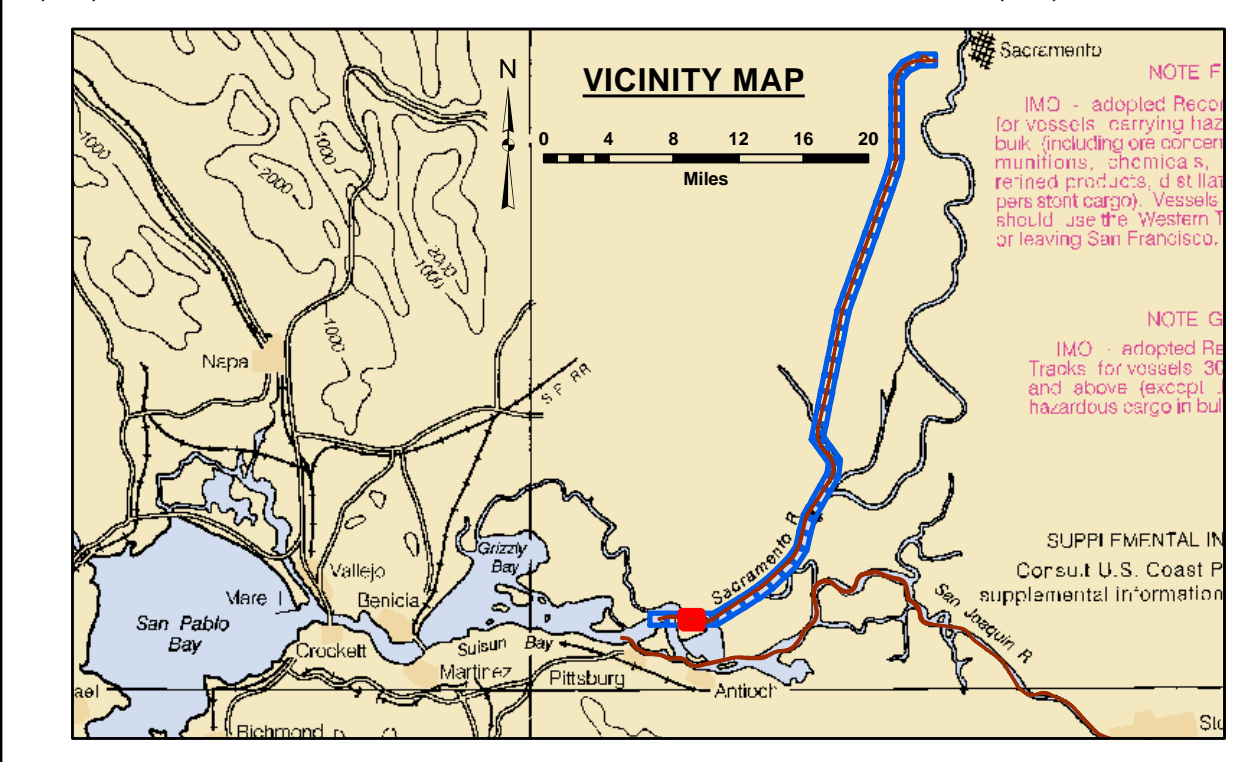

LEGEND

--- Federal Navigation Channel	▨ Cable Area	■ Shoaling Area
— Federal Navigation Center Line	□ Placement Area	● Shoalest Sounding**
..... Cable Submarine	▭ Anchorage Area	⊥ Beacon, General
- - - Cable Overhead	⊗ Obstruction Point	◆ Red Navigation Buoy
— Contour Line	✦ Wrecks-Submerged	◆ Green Navigation Buoy

Contours

- -30
- -29
- -28
- -27
- -26

NOTES:
DRAWING NOT TO BE USED FOR NAVIGATION. ONLY CHANNEL CONDITION AT DATE OF SURVEY.
THE LOCATION OF ALL NAVIGATION AIDS ARE BASED ON INFORMATION PROVIDED BY THE U.S. COAST GUARD.
BUOY LOCATIONS REPRESENT THE POSITION OF THE SINKER ONLY.

SOUNDINGS WERE TAKEN BY FATHOMETER AND ARE SHOWN TO THE NEAREST TENTH OF A FOOT.

SOUNDINGS ARE BASED ON THE DATUM OF MEAN LOWER LOW WATER AT THE LOCALITY.

NORTH AMERICAN DATUM OF 1983 (NAD83), PROJECTED TO THE STATE PLANE COORDINATE SYSTEM (SPCS), CA ZONE II (0402). DISTANCE UNITS IN U.S. SURVEY FEET.

PLANE GRID AND COORDINATES ARE BASED ON LAMBERT PROJECTION, NAD 83, ZONE II CALIFORNIA AS DESCRIBED IN SPECIAL PUBLICATION NO. 235, PUBLISHED BY THE NATIONAL OCEAN SURVEY.

PROJECT DEPTH: -30'


VERTICAL DATUM: MLLW

THE LOCATION OF NAVIGATION AIDS ARE BASED ON AND PROVIDED BY THE U.S. COAST GUARD

CONTROLS:
LOCATION: RIO VISTA
NOAA STATION: 9415316
BENCHMARK: 5316 B 1996 (NO PID)
TIDE GAUGE: NAIL @ 8.2 FT MLLW
METADATA: NAIL SET BY USACE 31 MARCH, 2014


LOCATION: PORT OF WEST SACRAMENTO
NOAA STATION: 9416131
BENCHMARK: POWS1 (NO PID)
TIDE GAUGE: NAIL @ 10.0 FT MLLW
METADATA: NAIL SET BY USACE 8 APRIL, 2014

ALL HORIZONTAL POSITIONS AND MLLW ELEVATIONS WERE POST-PROCESSED USING PUBLIC GPS REFERENCE STATIONS IN THE AREA.

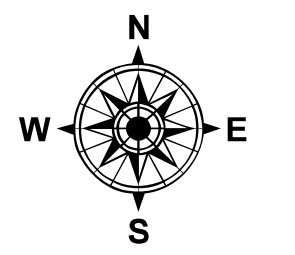

CALIFORNIA
SAN JOAQUIN COUNTY
SACRAMENTO RIVER
CONDITION SURVEY
21, 25, 27-28 FEBRUARY 2018



Sheet Reference Number
3 of 45

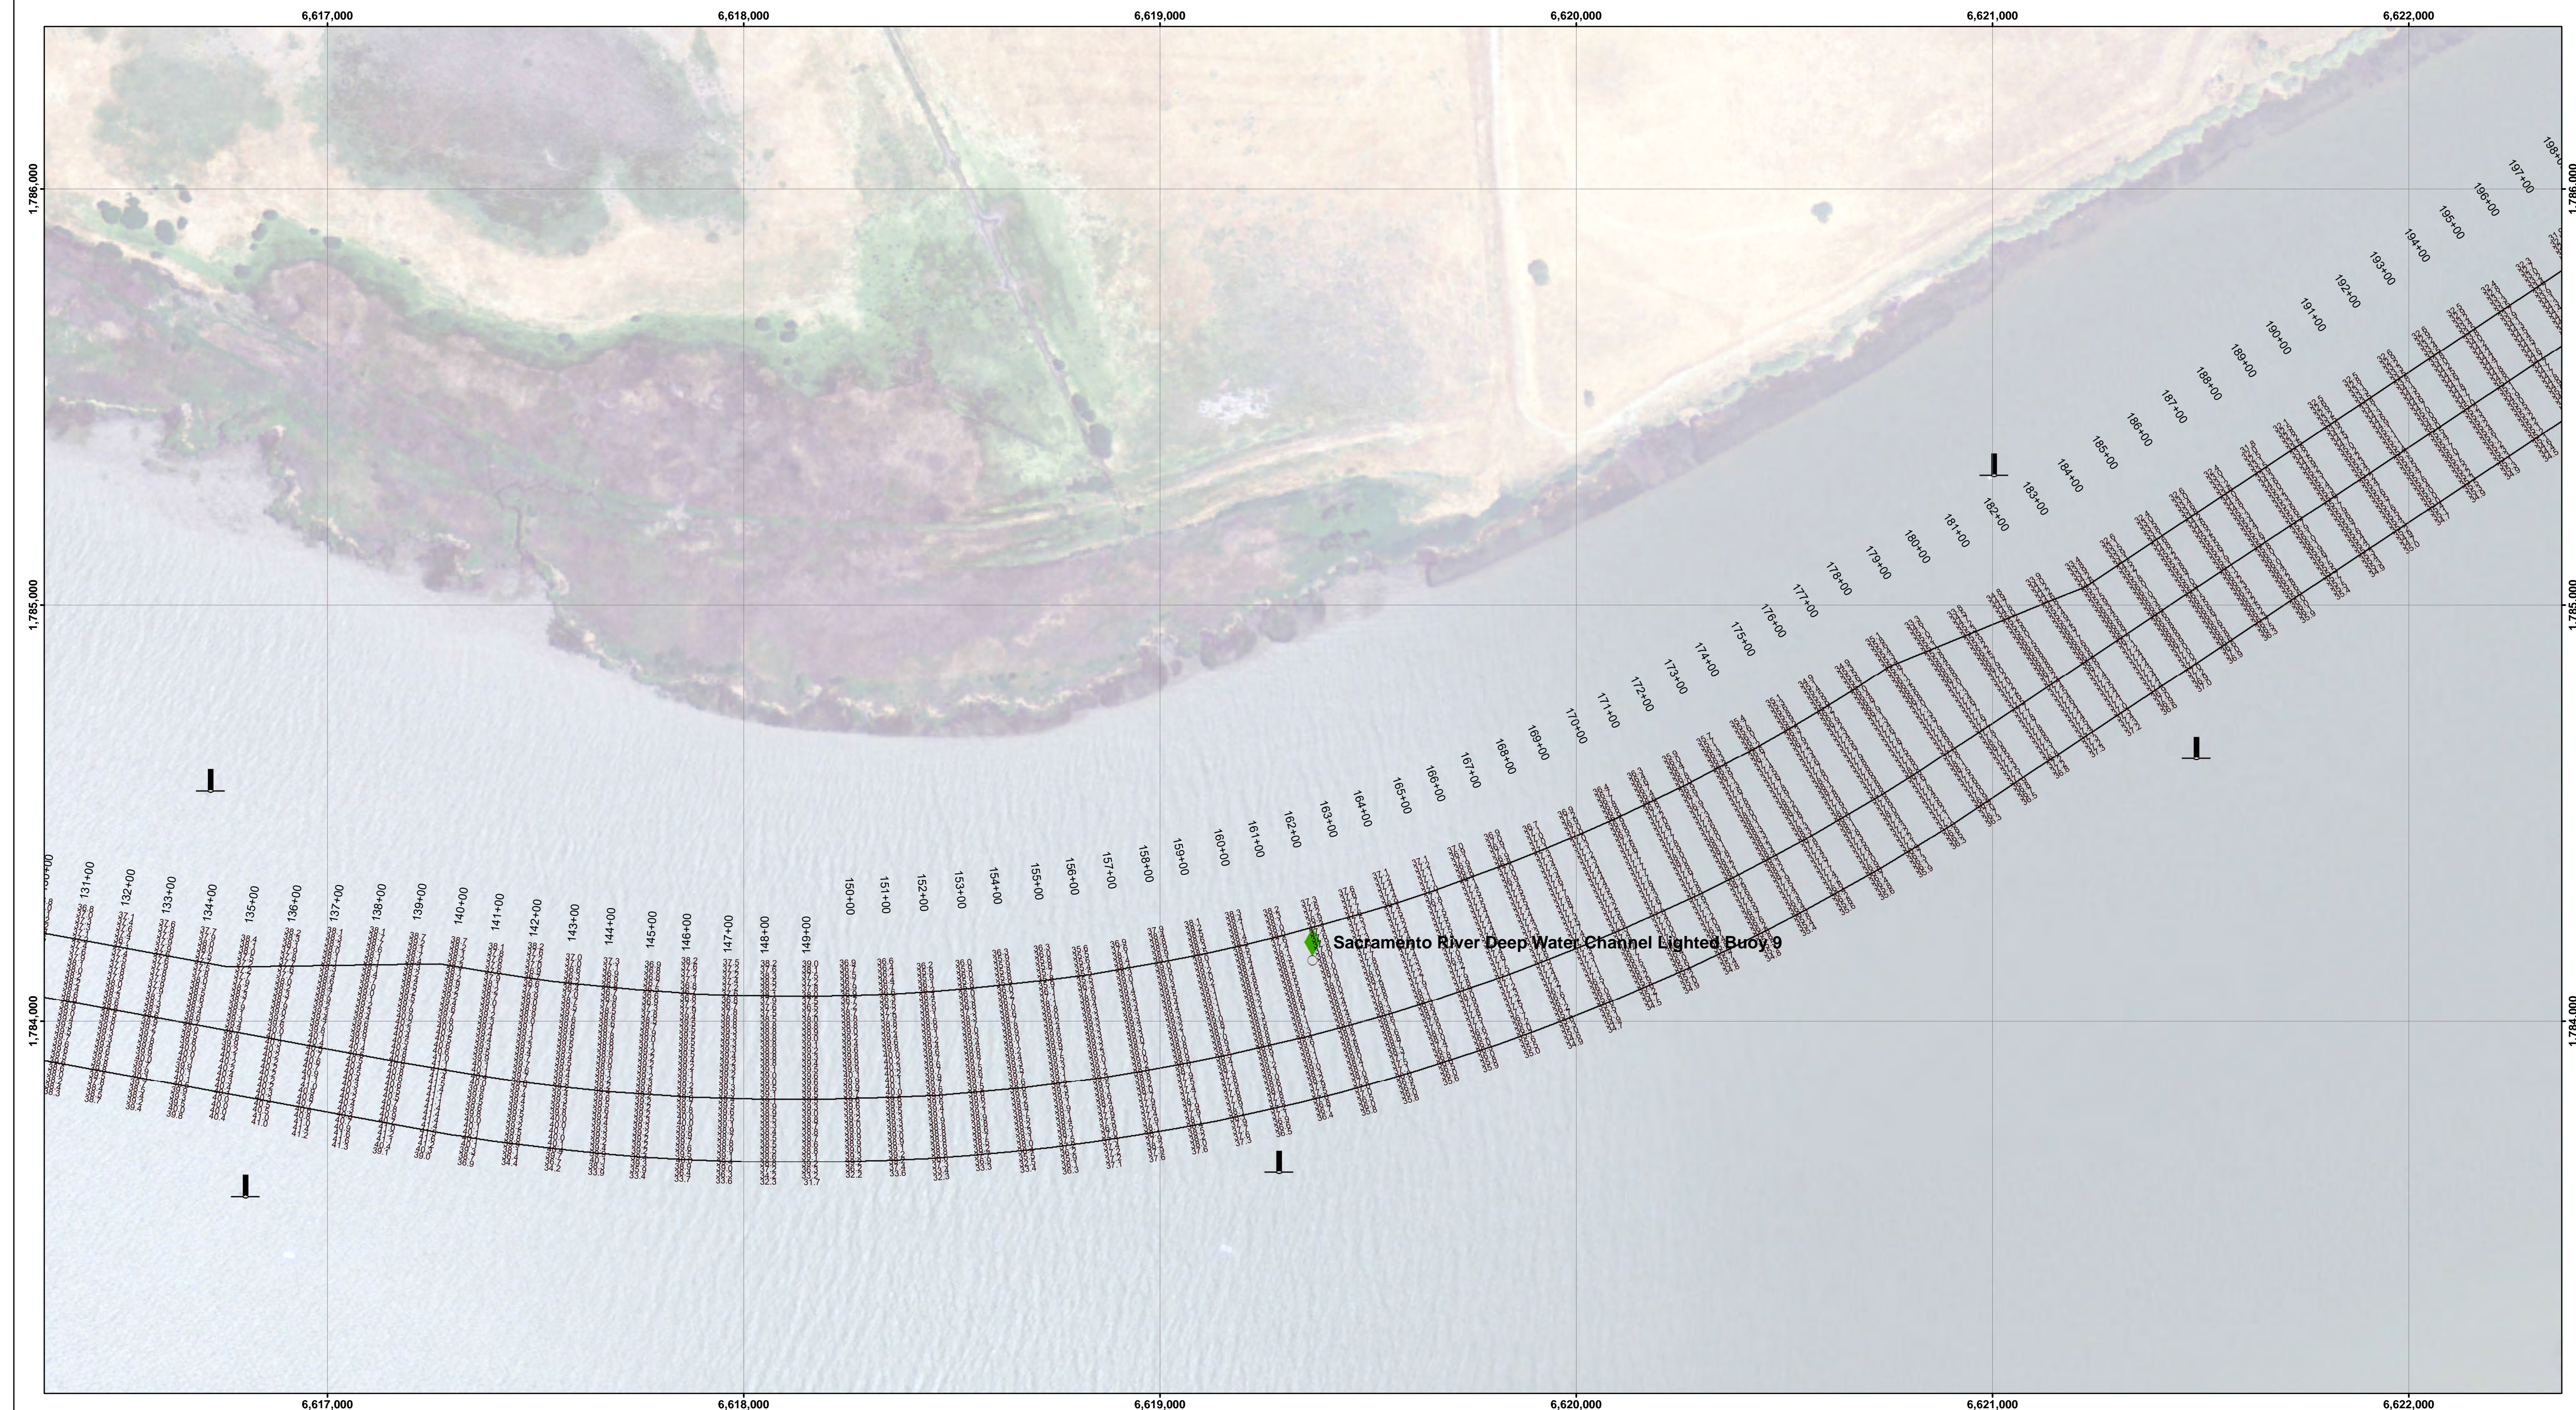

DISCLAIMER: The United States Government furnishes these data and the results of the processing of these data for the use of the user. The user is responsible for the accuracy of the data and the results of the processing of these data. 

Chart Date:	Mar 12, 2018
Designed by:	PDT
Drawn by:	PDT
Surveyed By:	TRAVIS J. RAYFIELD
Plotted By:	PDT
Checked By:	PDT
Approved:	Chief, Hydro Survey Section
Approved:	Chief, Construction Branch


CALIFORNIA
 SAN JOAQUIN COUNTY
SACRAMENTO RIVER
 CONDITION SURVEY
 21, 25, 27-28 FEBRUARY 2018

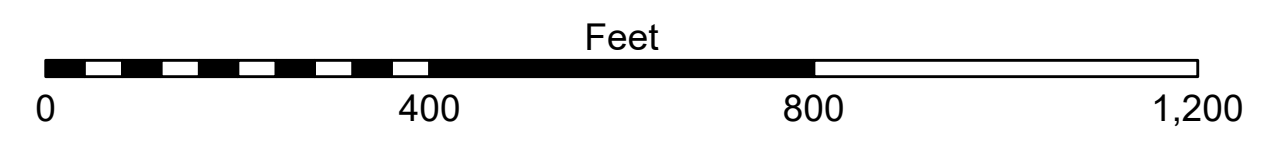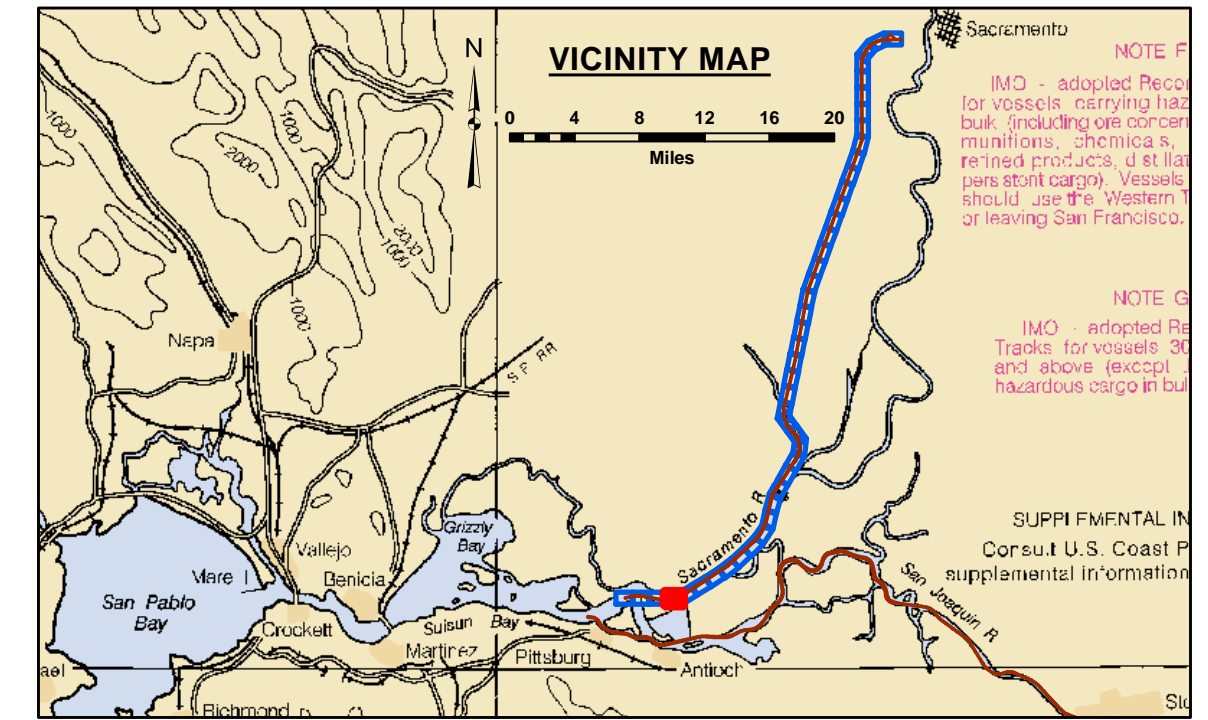


LEGEND			
--- Federal Navigation Channel	▨ Cable Area	■ Shoaling Area	— Contours
— Federal Navigation Center Line	□ Placement Area	● Shoalest Sounding**	— -30
..... Cable Submarine	▤ Anchorage Area	⊥ Beacon, General	— -29
- - - Cable Overhead	⊗ Obstruction Point	◆ Red Navigation Buoy	— -28
— Contour Line	✦ Wrecks-Submerged	◆ Green Navigation Buoy	— -27
			— -26

NOTES:
 DRAWING NOT TO BE USED FOR NAVIGATION. ONLY CHANNEL CONDITION AT DATE OF SURVEY.
 THE LOCATION OF ALL NAVIGATION AIDS ARE BASED ON INFORMATION PROVIDED BY THE U.S. COAST GUARD.
 BUOY LOCATIONS REPRESENT THE POSITION OF THE SINKER ONLY.
 SOUNDINGS WERE TAKEN BY FATHOMETER AND ARE SHOWN TO THE NEAREST TENTH OF A FOOT.
 SOUNDINGS ARE BASED ON THE DATUM OF MEAN LOWER LOW WATER AT THE LOCALITY.
 NORTH AMERICAN DATUM OF 1983 (NAD83), PROJECTED TO THE STATE PLANE COORDINATE SYSTEM (SPCS),
 CA ZONE II (0402). DISTANCE UNITS IN U.S. SURVEY FEET.
 PLANE GRID AND COORDINATES ARE BASED ON LAMBERT PROJECTION, NAD 83,
 ZONE II CALIFORNIA AS DESCRIBED IN SPECIAL PUBLICATION NO. 235,
 PUBLISHED BY THE NATIONAL OCEAN SURVEY.
 PROJECT DEPTH: -30'
 VERTICAL DATUM: MLLW
 THE LOCATION OF NAVIGATION AIDS ARE BASED ON AND PROVIDED BY THE U.S. COAST GUARD

CONTROLS:
 LOCATION: RIO VISTA
 NOAA STATION: 9415316
 BENCHMARK: 5316 B 1996 (NO PID)
 TIDE GAUGE: NAIL @ 8.2 FT MLLW
 METADATA: NAIL SET BY USACE 31 MARCH, 2014
 LOCATION: PORT OF WEST SACRAMENTO
 NOAA STATION: 9416131
 BENCHMARK: POWS1 (NO PID)
 TIDE GAUGE: NAIL @ 10.0 FT MLLW
 METADATA: NAIL SET BY USACE 8 APRIL, 2014
 ALL HORIZONTAL POSITIONS AND MLLW ELEVATIONS WERE
 POST-PROCESSED USING PUBLIC GPS
 REFERENCE STATIONS IN THE AREA.

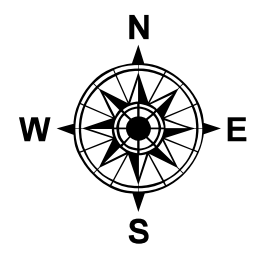


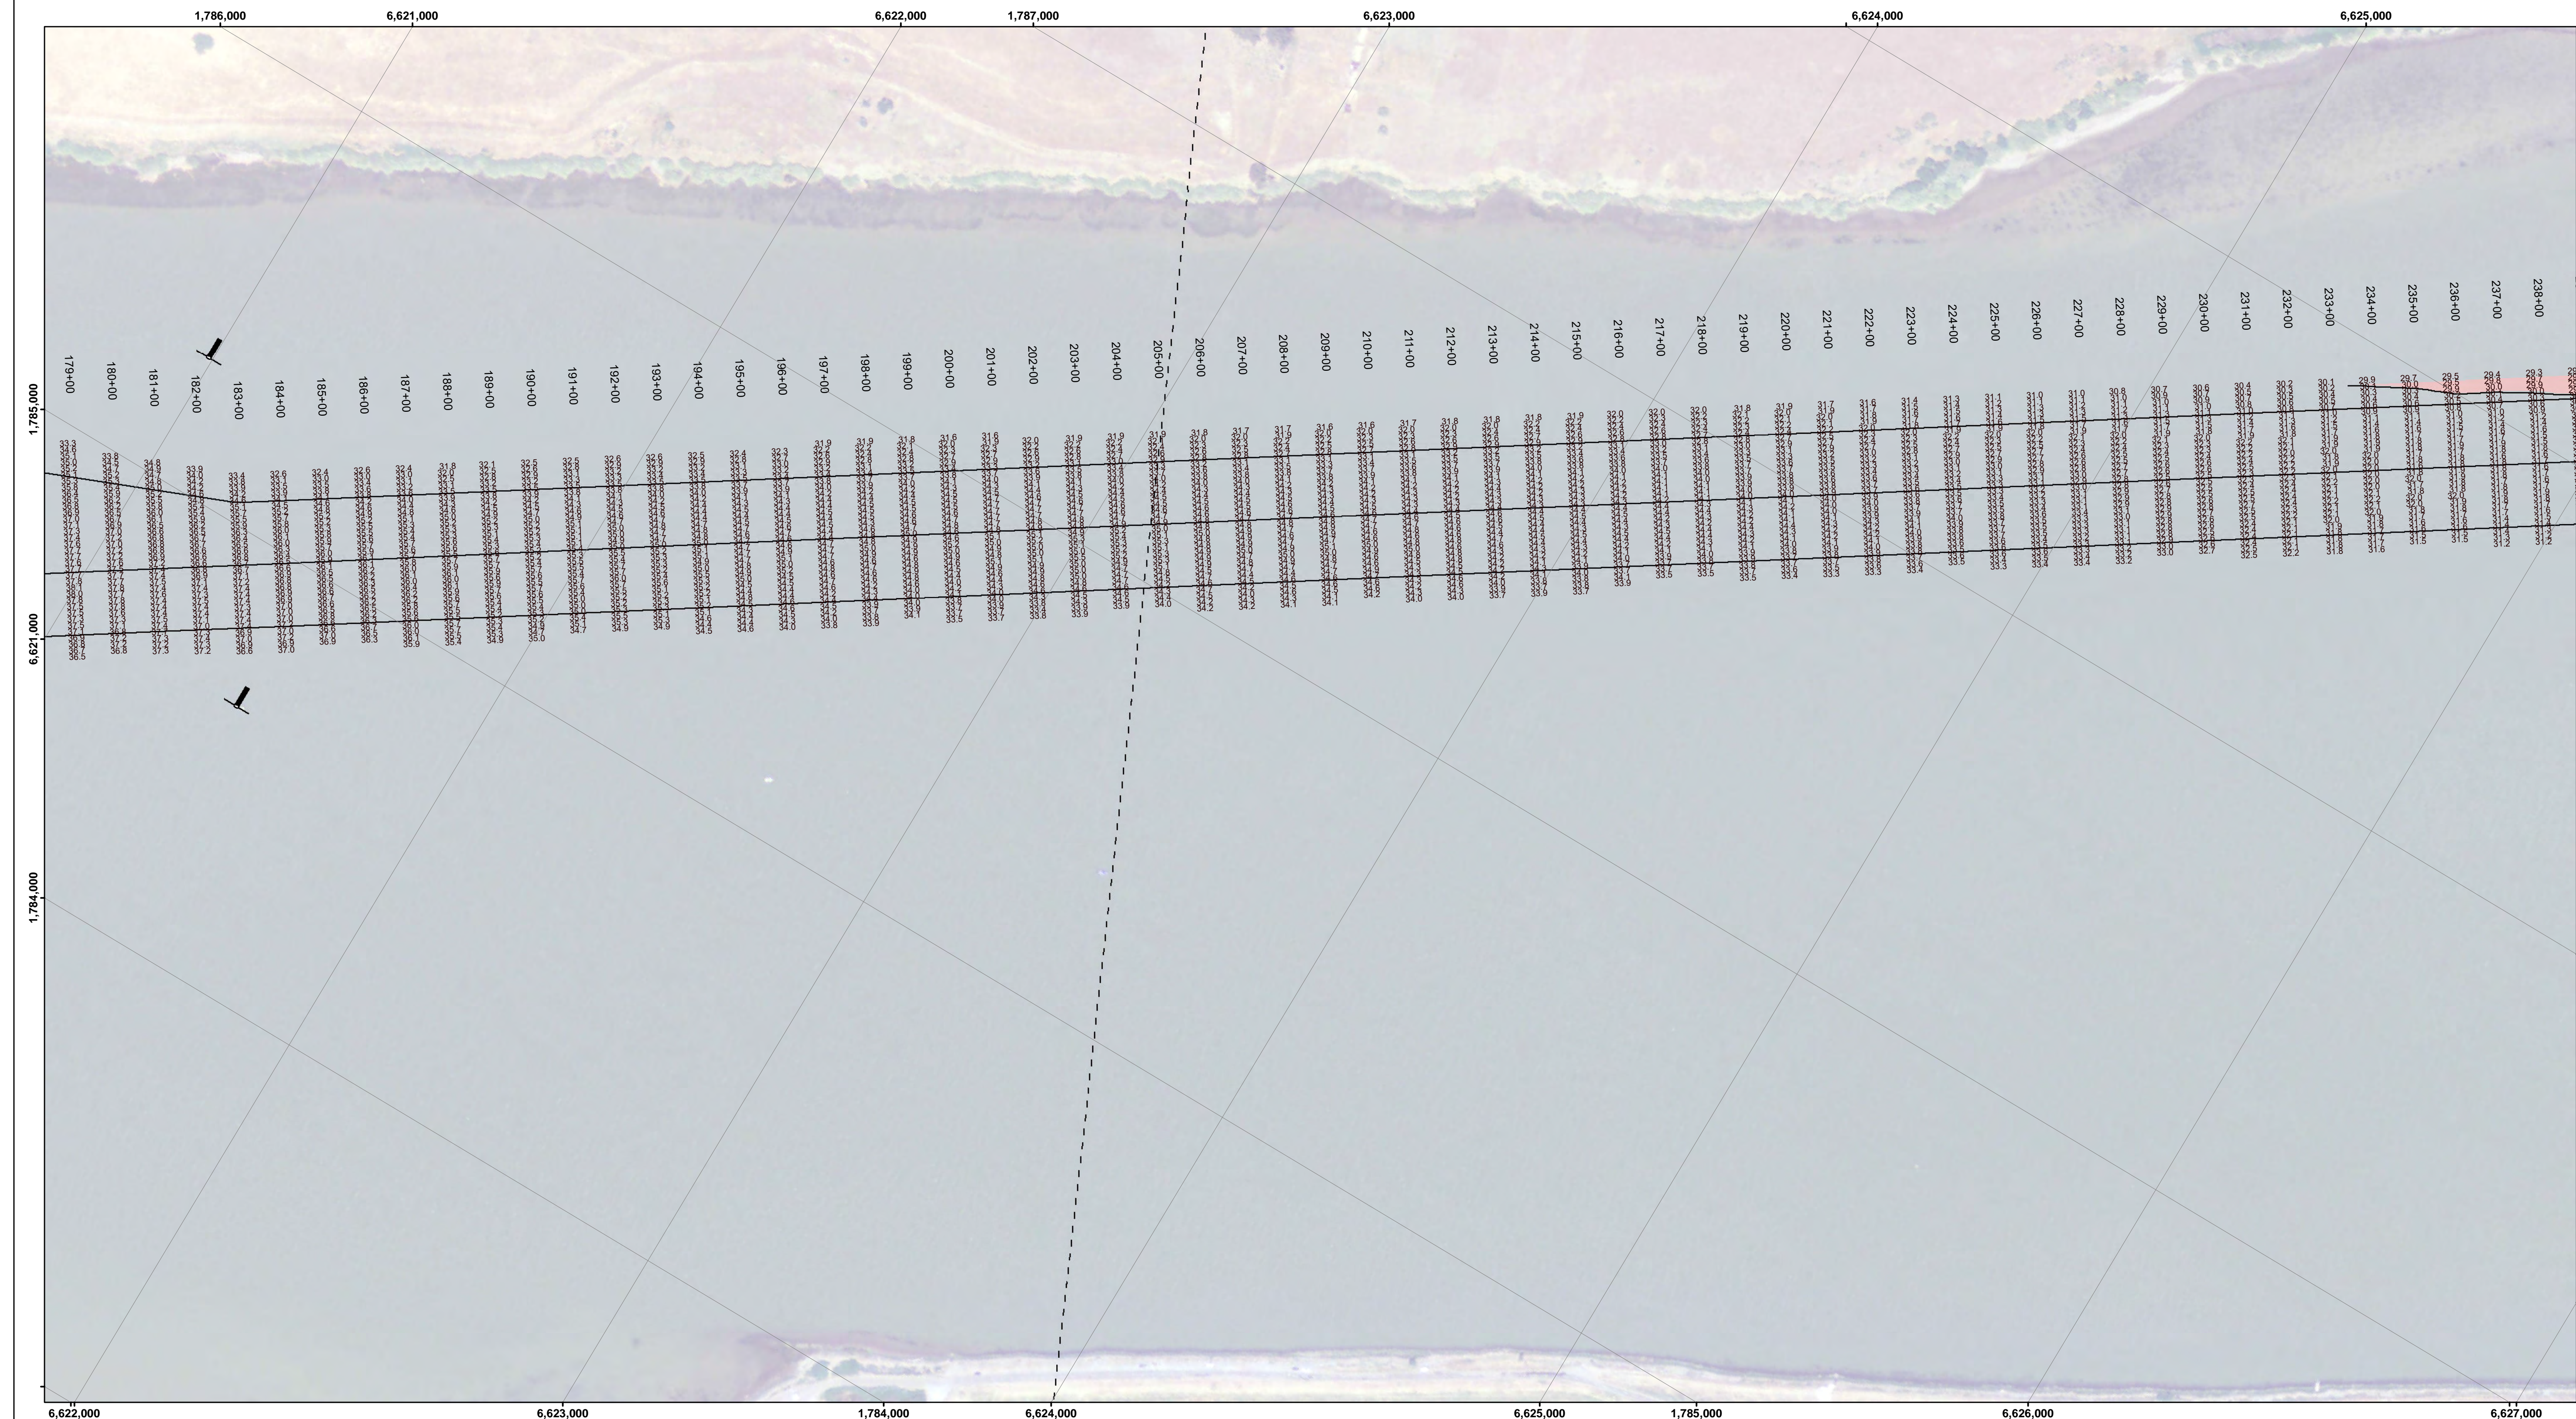



Chart Date:	Mar 12, 2018
Designed by:	PDT
Drawn by:	PDT
Surveyed By:	LT COLONEL J. RAYFIELD
Plotted By:	Hydro Survey Team Leader
Checked By:	Chief Hydro Survey Section
Approved:	Chief Construction Branch

CALIFORNIA
SACRAMENTO RIVER
 CONDITION SURVEY
 21, 25, 27-28 FEBRUARY 2018

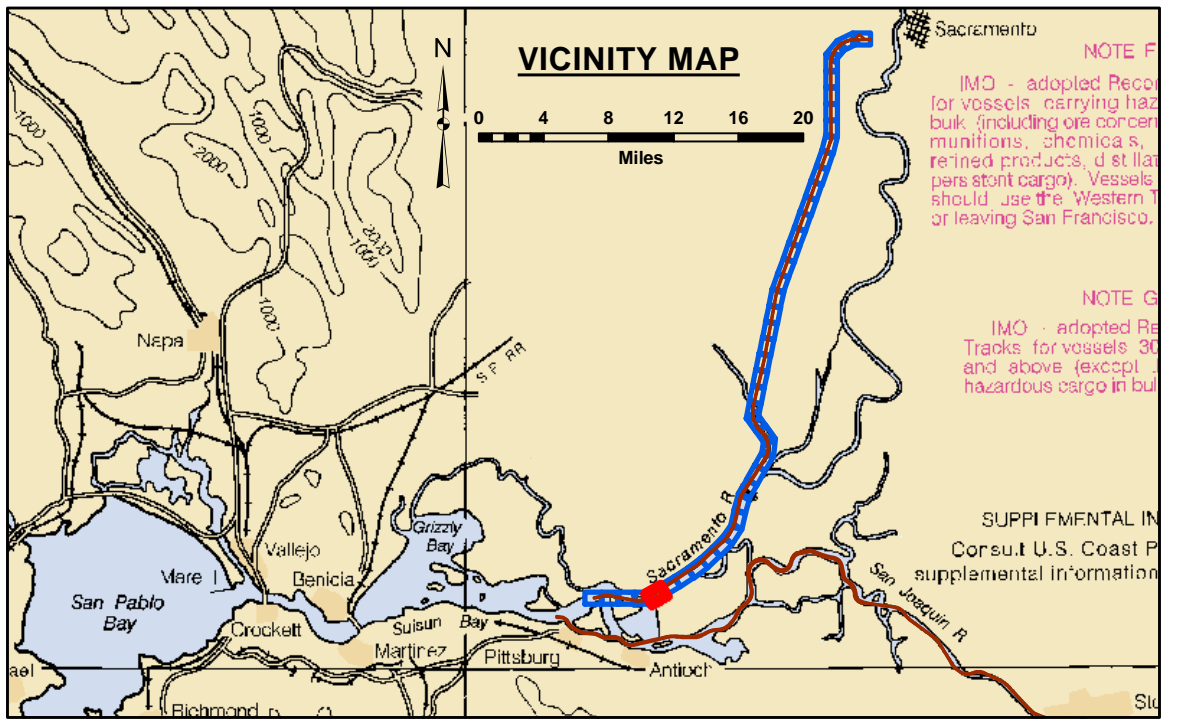

LEGEND

--- Federal Navigation Channel	Cable Area	Shoaling Area	Contours -30
— Federal Navigation Center Line	Placement Area	Shoalest Sounding**	Contours -29
..... Cable Submarine	Anchorage Area	Beacon, General	Contours -28
- - - Cable Overhead	Obstruction Point	Red Navigation Buoy	Contours -27
— Contour Line	Wrecks-Submerged	Green Navigation Buoy	Contours -26

NOTES:
 DRAWING NOT TO BE USED FOR NAVIGATION. ONLY CHANNEL CONDITION AT DATE OF SURVEY.
 THE LOCATION OF ALL NAVIGATION AIDS ARE BASED ON INFORMATION PROVIDED BY THE U.S. COAST GUARD.
 BUOY LOCATIONS REPRESENT THE POSITION OF THE SINKER ONLY.

SOUNDINGS WERE TAKEN BY FATHOMETER AND ARE SHOWN TO THE NEAREST TENTH OF A FOOT.

SOUNDINGS ARE BASED ON THE DATUM OF MEAN LOWER LOW WATER AT THE LOCALITY.

NORTH AMERICAN DATUM OF 1983 (NAD83), PROJECTED TO THE STATE PLANE COORDINATE SYSTEM (SPCS), CA ZONE II (0402). DISTANCE UNITS IN U.S. SURVEY FEET.

PLANE GRID AND COORDINATES ARE BASED ON LAMBERT PROJECTION, NAD 83, ZONE II CALIFORNIA AS DESCRIBED IN SPECIAL PUBLICATION NO. 235, PUBLISHED BY THE NATIONAL OCEAN SURVEY.

PROJECT DEPTH: -30'


VERTICAL DATUM: MLLW

THE LOCATION OF NAVIGATION AIDS ARE BASED ON AND PROVIDED BY THE U.S. COAST GUARD

CONTROLS:
 LOCATION: RIO VISTA
 NOAA STATION: 9415316
 BENCHMARK: 5316 B 1996 (NO PID)
 TIDE GAUGE: NAIL @ 8.2 FT MLLW
 METADATA: NAIL SET BY USACE 31 MARCH, 2014

LOCATION: PORT OF WEST SACRAMENTO
 NOAA STATION: 9416131
 BENCHMARK: POWS1 (NO PID)
 TIDE GAUGE: NAIL @ 10.0 FT MLLW
 METADATA: NAIL SET BY USACE 8 APRIL, 2014



ALL HORIZONTAL POSITIONS AND MLLW ELEVATIONS WERE POST-PROCESSED USING PUBLIC GPS REFERENCE STATIONS IN THE AREA.

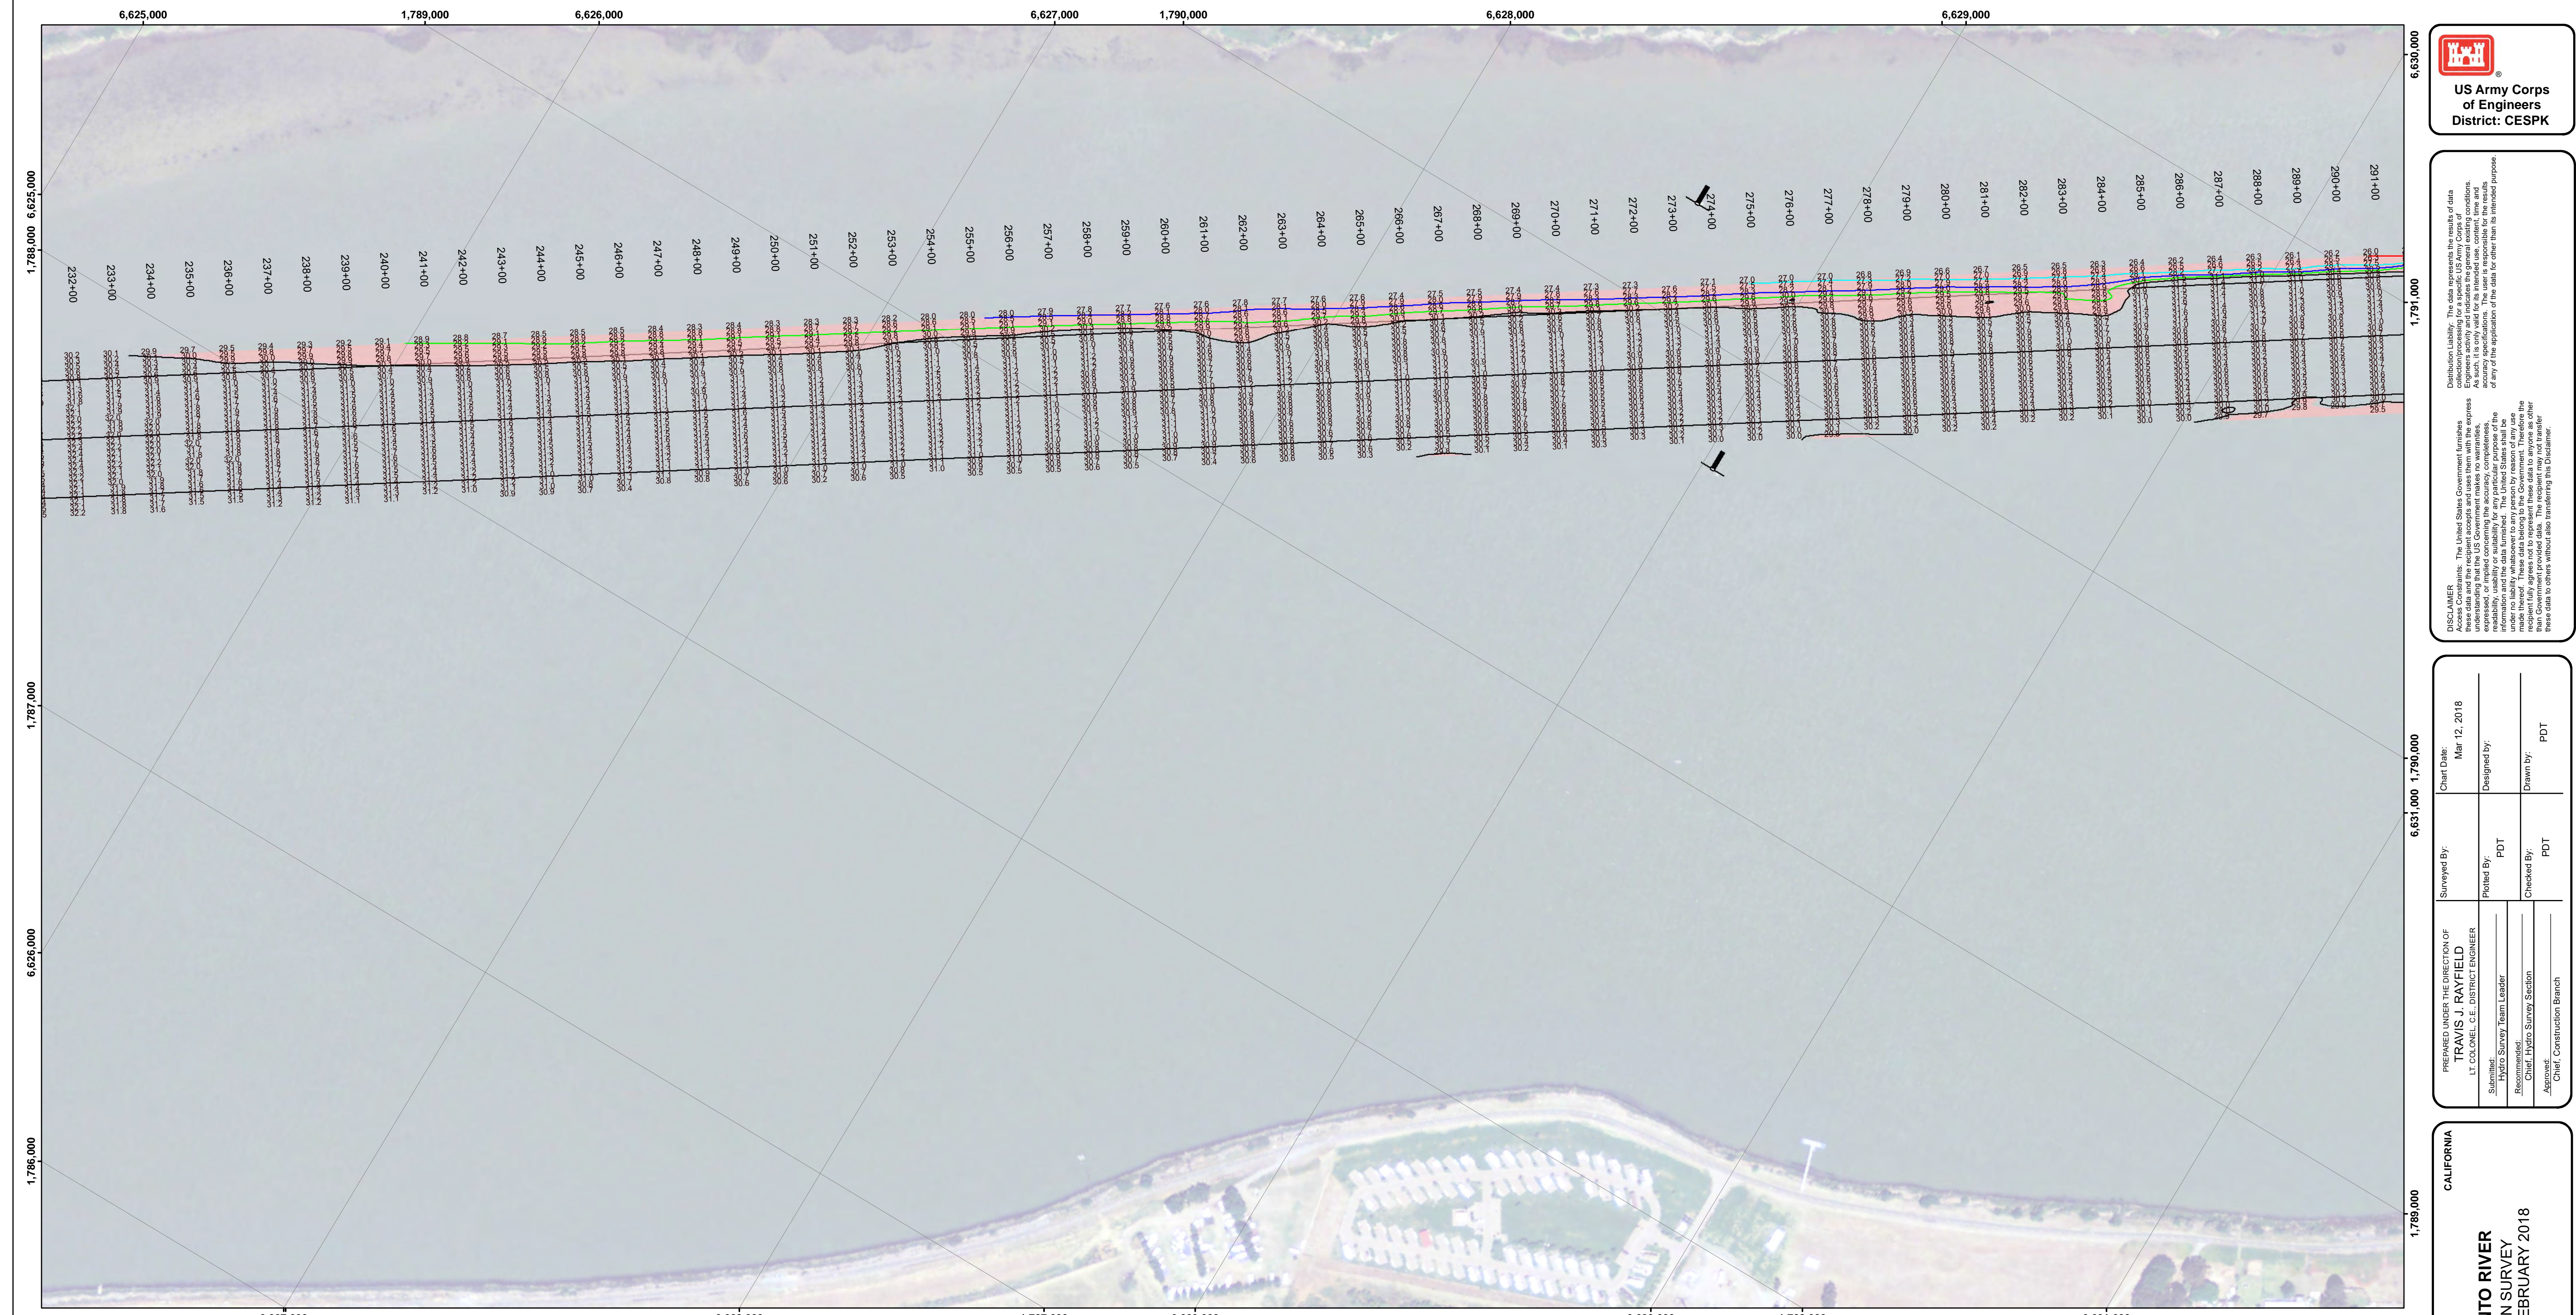

DISCLAIMER: The United States Government furnishes these data and the results of the survey and uses them with the express understanding that the user is responsible for the results of any application of the data for other than its intended purpose. 

Chart Date:	Mar 12, 2018
Designed by:	PDT
Drawn by:	PDT
Surveyed By:	PDT
Plotted By:	PDT
Checked By:	PDT
Approved:	Chief, Hydro Survey Section
Approved:	Chief, Construction Branch


SACRAMENTO RIVER
CONDITION SURVEY
21, 25, 27-28 FEBRUARY 2018

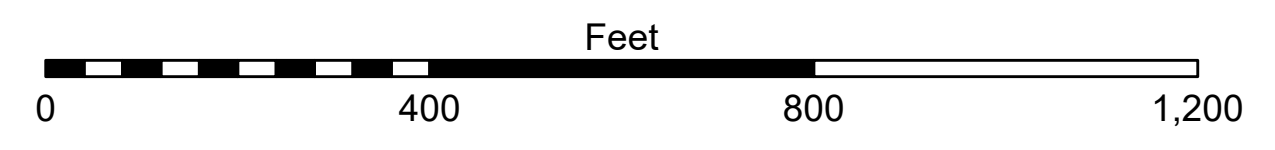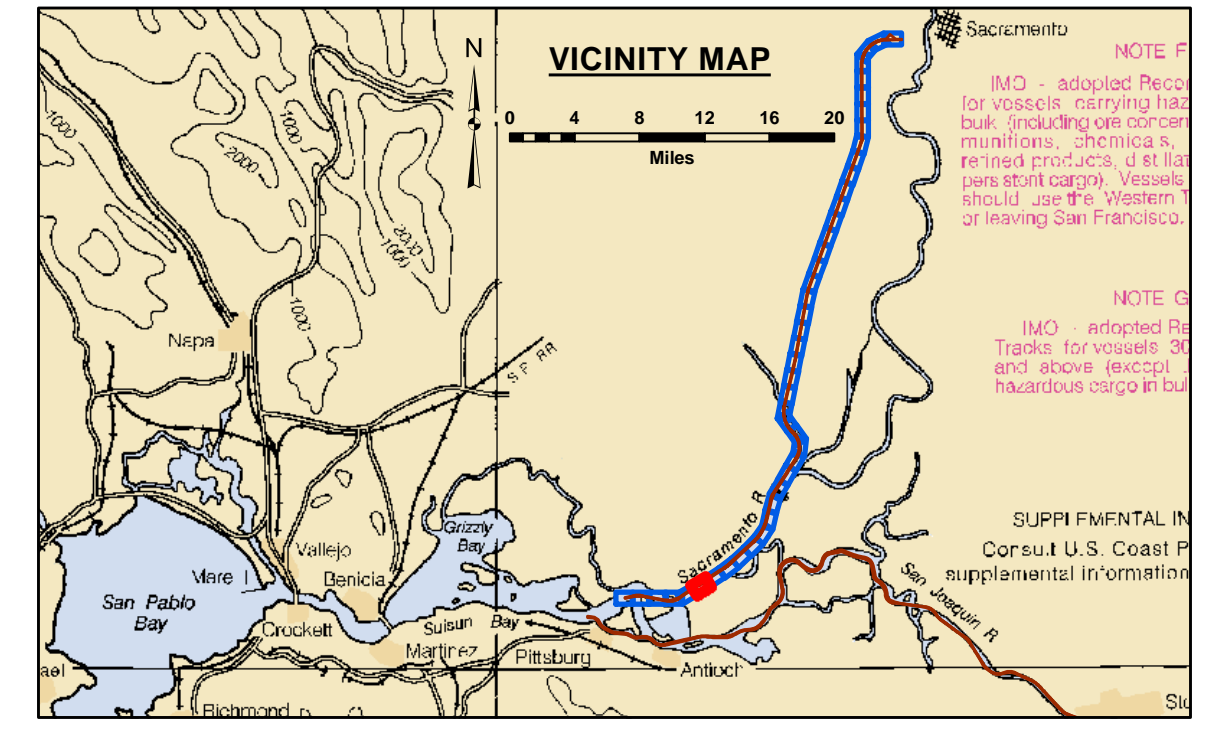


LEGEND

--- Federal Navigation Channel	▨ Cable Area	■ Shoaling Area	— Contours
— Federal Navigation Center Line	□ Placement Area	● Shoalest Sounding**	— -30
⋯ Cable Submarine	⊠ Anchorage Area	⊥ Beacon, General	— -29
- - - Cable Overhead	⊗ Obstruction Point	◆ Red Navigation Buoy	— -28
— Contour Line	✈ Wrecks-Submerged	◆ Green Navigation Buoy	— -27
			— -26

NOTES:
DRAWING NOT TO BE USED FOR NAVIGATION. ONLY CHANNEL CONDITION AT DATE OF SURVEY.
THE LOCATION OF ALL NAVIGATION AIDS ARE BASED ON INFORMATION PROVIDED BY THE U.S. COAST GUARD.
BUOY LOCATIONS REPRESENT THE POSITION OF THE SINKER ONLY.
SOUNDINGS WERE TAKEN BY FATHOMETER AND ARE SHOWN TO THE NEAREST TENTH OF A FOOT.
SOUNDINGS ARE BASED ON THE DATUM OF MEAN LOWER LOW WATER AT THE LOCALITY.
NORTH AMERICAN DATUM OF 1983 (NAD83), PROJECTED TO THE STATE PLANE COORDINATE SYSTEM (SPCS), ZONE II (0402). DISTANCE UNITS IN U.S. SURVEY FEET.
PLANE GRID AND COORDINATES ARE BASED ON LAMBERT PROJECTION, NAD 83, ZONE II CALIFORNIA AS DESCRIBED IN SPECIAL PUBLICATION NO. 235, PUBLISHED BY THE NATIONAL OCEAN SURVEY.
PROJECT DEPTH: -30'
VERTICAL DATUM: MLLW
THE LOCATION OF NAVIGATION AIDS ARE BASED ON AND PROVIDED BY THE U.S. COAST GUARD

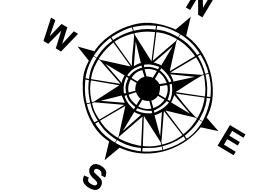

CONTROLS:
LOCATION: RIO VISTA
NOAA STATION: 9415316
BENCHMARK: 5316 B 1996 (NO PID)
TIDE GAUGE: NAIL @ 8.2 FT MLLW
METADATA: NAIL SET BY USACE 31 MARCH, 2014
LOCATION: PORT OF WEST SACRAMENTO
NOAA STATION: 9416131
BENCHMARK: POWS1 (NO PID)
TIDE GAUGE: NAIL @ 10.0 FT MLLW
METADATA: NAIL SET BY USACE 8 APRIL, 2014
ALL HORIZONTAL POSITIONS AND MLLW ELEVATIONS WERE POST-PROCESSED USING PUBLIC GPS REFERENCE STATIONS IN THE AREA.



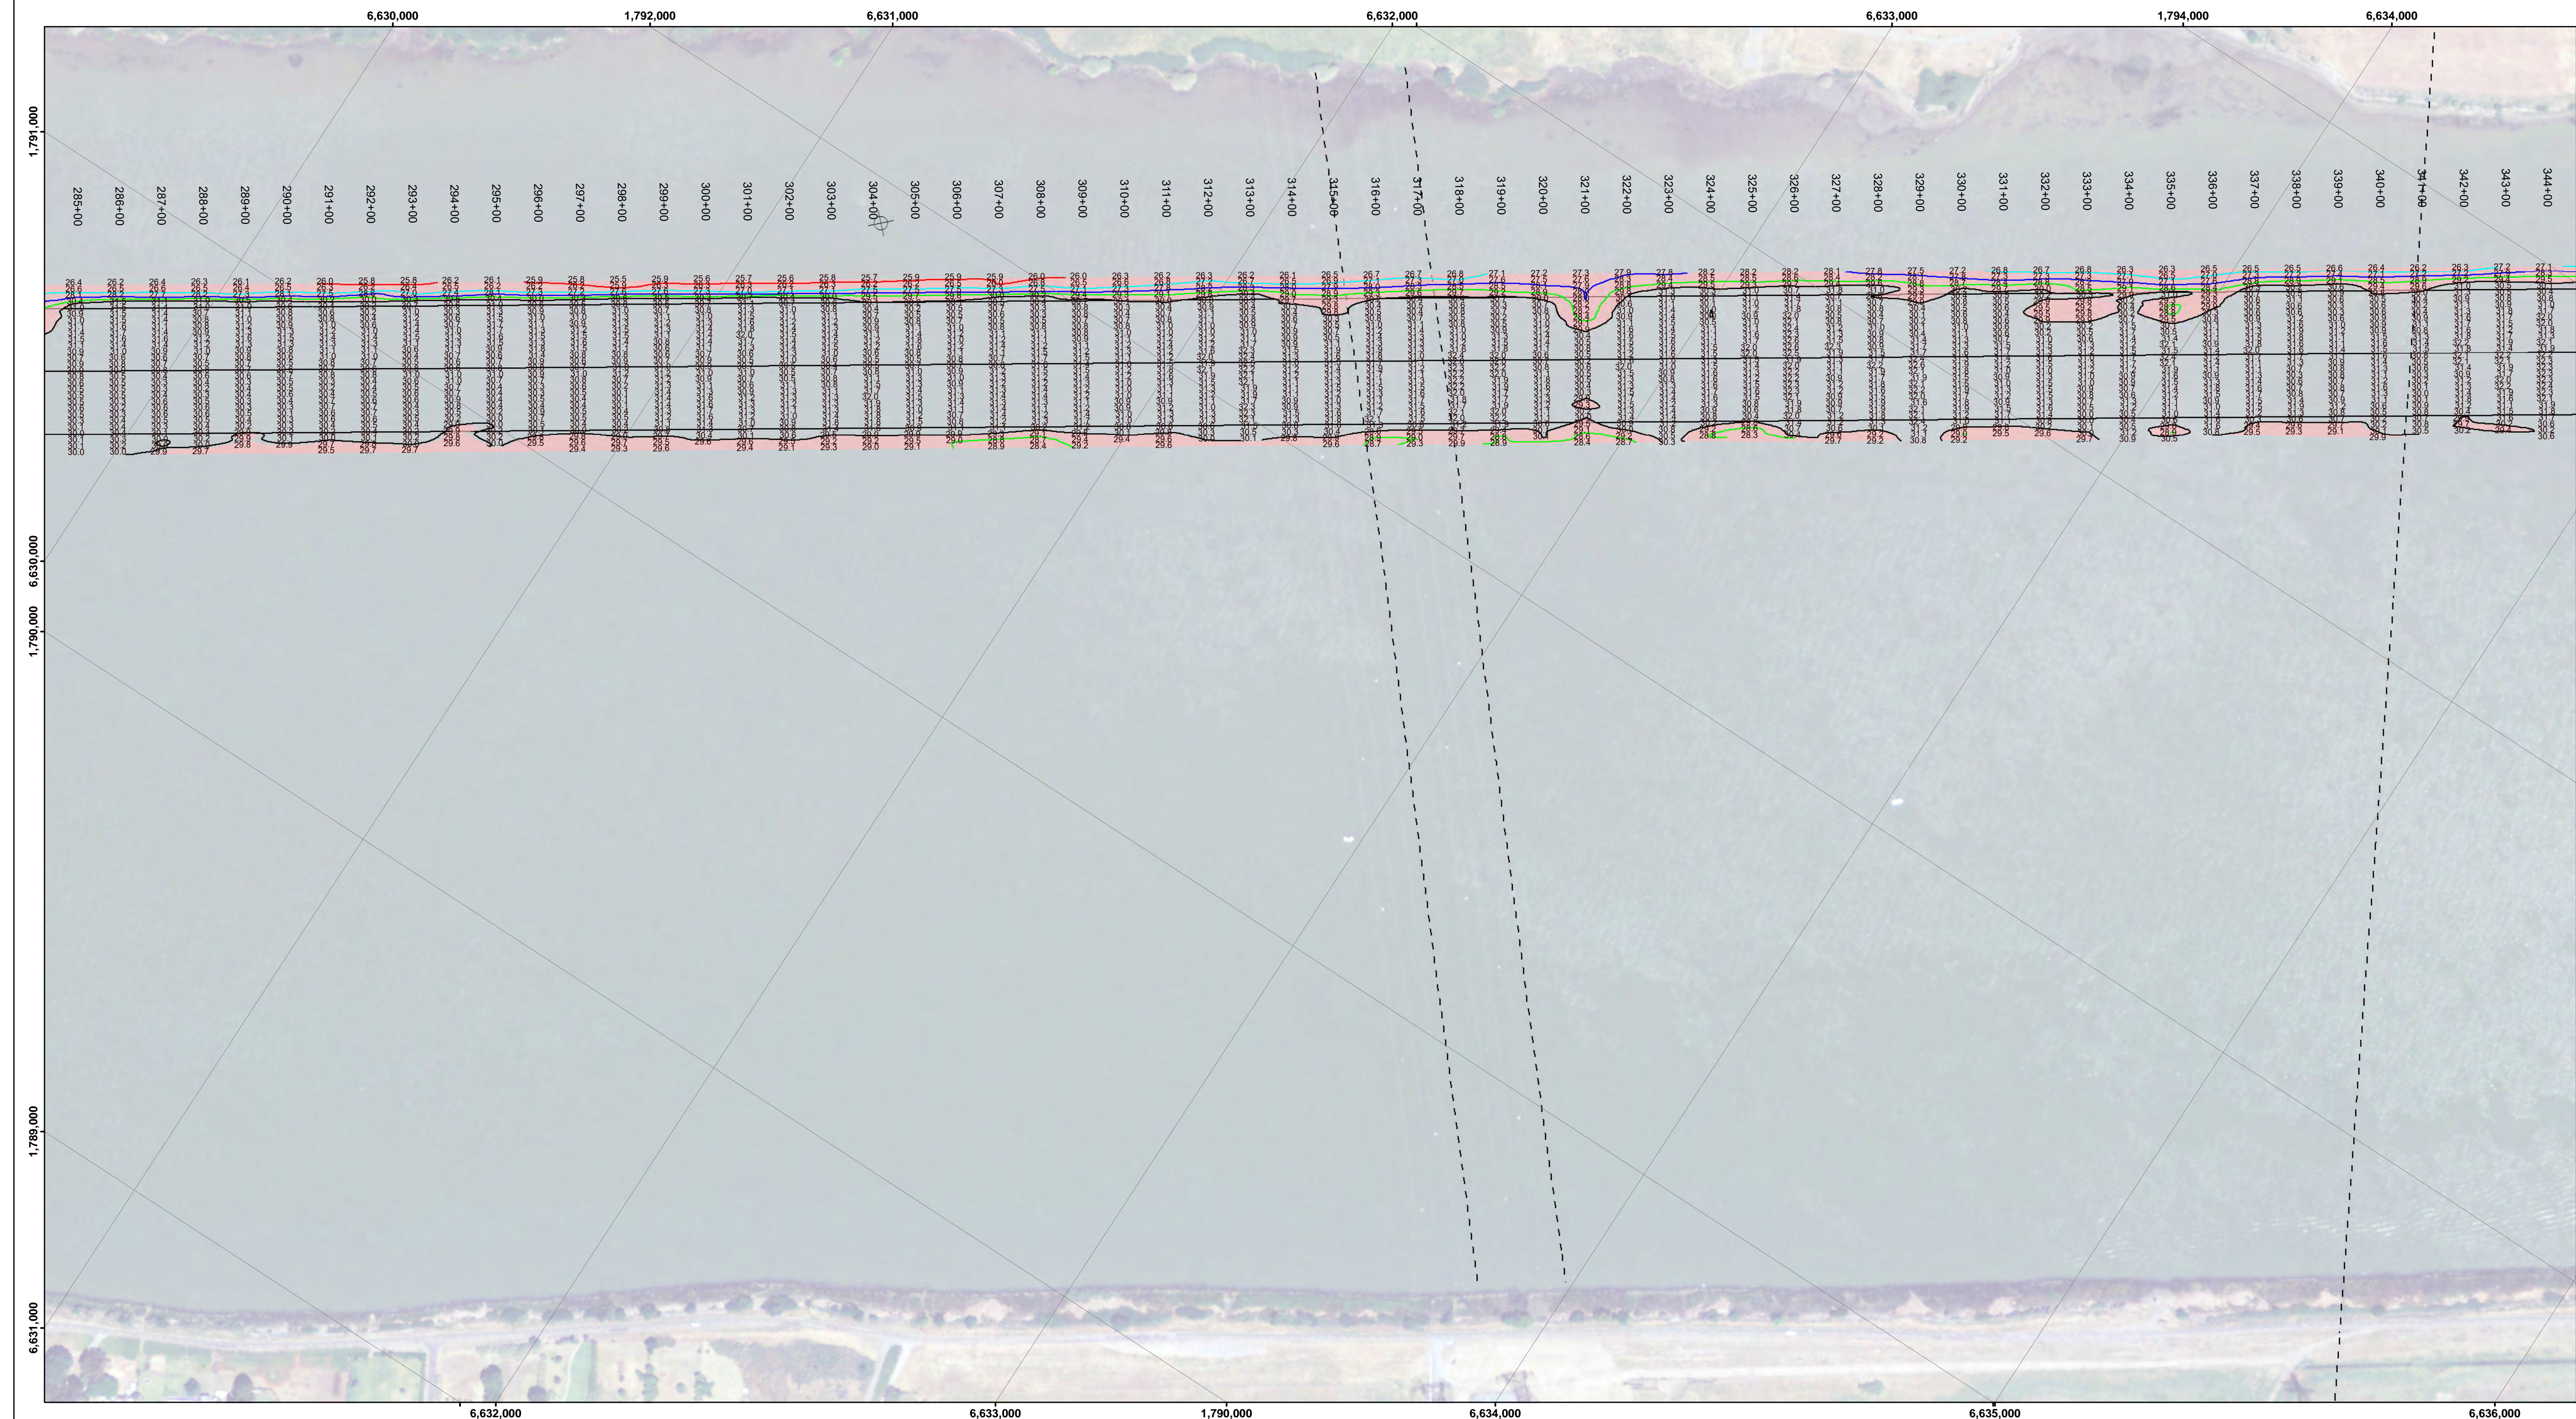


DISCLAIMER: The data shown on this chart represents the results of data collection/processing for a specific project. The user is responsible for the results of any application of the data for other than its intended purpose. Accuracy of the data is not guaranteed. The user is responsible for the results of any application of the data for other than its intended purpose.

ACCESS CONTROLS: The United States Government furnishes this data and the recipient agrees to use it with the express understanding that it is not to be distributed, copied, or otherwise used for any purpose other than that for which it was provided. The recipient may not transfer this data to others without also transferring this Disclaimer.

Chart Date:	Mar 12, 2018
Designed by:	PDT
Drawn by:	PDT
Surveyed By:	TRAVIS J. RAYFIELD LT COLONEL, C.E., DISTRICT ENGINEER
Plotted By:	Chief, Hydro Survey Section
Checked By:	Chief, Construction Branch

CALIFORNIA
SAN JOAQUIN COUNTY
SACRAMENTO RIVER
CONDITION SURVEY
21, 25, 27-28 FEBRUARY 2018

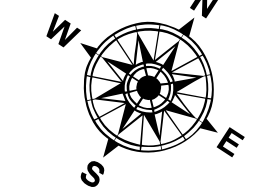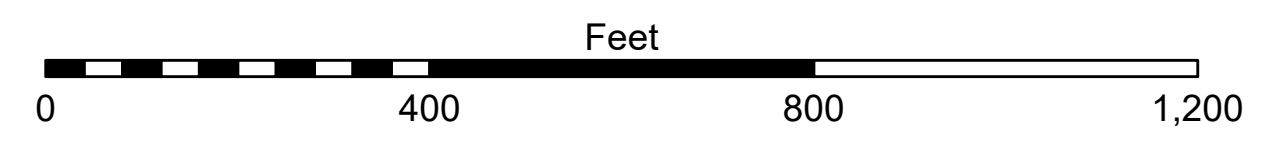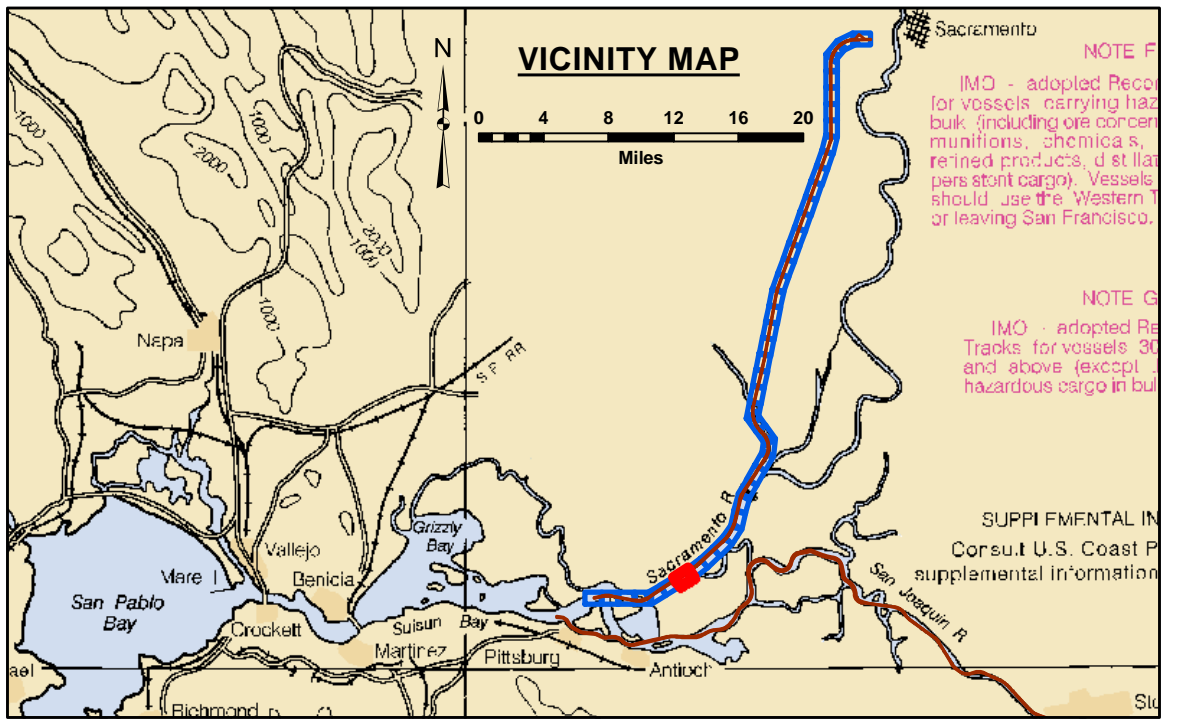

LEGEND			
--- Federal Navigation Channel	▨ Cable Area	■ Shoaling Area	— Contours
— Federal Navigation Center Line	□ Placement Area	● Shoalest Sounding**	— -30
⋯ Cable Submarine	⊠ Anchorage Area	⊥ Beacon, General	— -29
- - - Cable Overhead	⊗ Obstruction Point	◆ Red Navigation Buoy	— -28
— Contour Line	✈ Wrecks-Submerged	◆ Green Navigation Buoy	— -27
			— -26

NOTES:
DRAWING NOT TO BE USED FOR NAVIGATION. ONLY CHANNEL CONDITION AT DATE OF SURVEY.
THE LOCATION OF ALL NAVIGATION AIDS ARE BASED ON INFORMATION PROVIDED BY THE U.S. COAST GUARD.
BUOY LOCATIONS REPRESENT THE POSITION OF THE SINKER ONLY.

SOUNDINGS WERE TAKEN BY FATHOMETER AND ARE SHOWN TO THE NEAREST TENTH OF A FOOT.

SOUNDINGS ARE BASED ON THE DATUM OF MEAN LOWER LOW WATER AT THE LOCALITY.

NORTH AMERICAN DATUM OF 1983 (NAD83), PROJECTED TO THE STATE PLANE COORDINATE SYSTEM (SPCS), ZONE II (0402). DISTANCE UNITS IN U.S. SURVEY FEET.

PLANE GRID AND COORDINATES ARE BASED ON LAMBERT PROJECTION, NAD 83, ZONE II CALIFORNIA AS DESCRIBED IN SPECIAL PUBLICATION NO. 235, PUBLISHED BY THE NATIONAL OCEAN SURVEY.

PROJECT DEPTH: -30'


VERTICAL DATUM: MLLW

THE LOCATION OF NAVIGATION AIDS ARE BASED ON AND PROVIDED BY THE U.S. COAST GUARD

CONTROLS:
LOCATION: RIO VISTA
NOAA STATION: 9415316
BENCHMARK: 5316 B 1996 (NO PID)
TIDE GAUGE: NAIL @ 8.2 FT MLLW
METADATA: NAIL SET BY USACE 31 MARCH, 2014

LOCATION: PORT OF WEST SACRAMENTO
NOAA STATION: 9416131
BENCHMARK: POWS1 (NO PID)
TIDE GAUGE: NAIL @ 10.0 FT MLLW
METADATA: NAIL SET BY USACE 8 APRIL, 2014

ALL HORIZONTAL POSITIONS AND MLLW ELEVATIONS WERE POST-PROCESSED USING PUBLIC GPS REFERENCE STATIONS IN THE AREA.



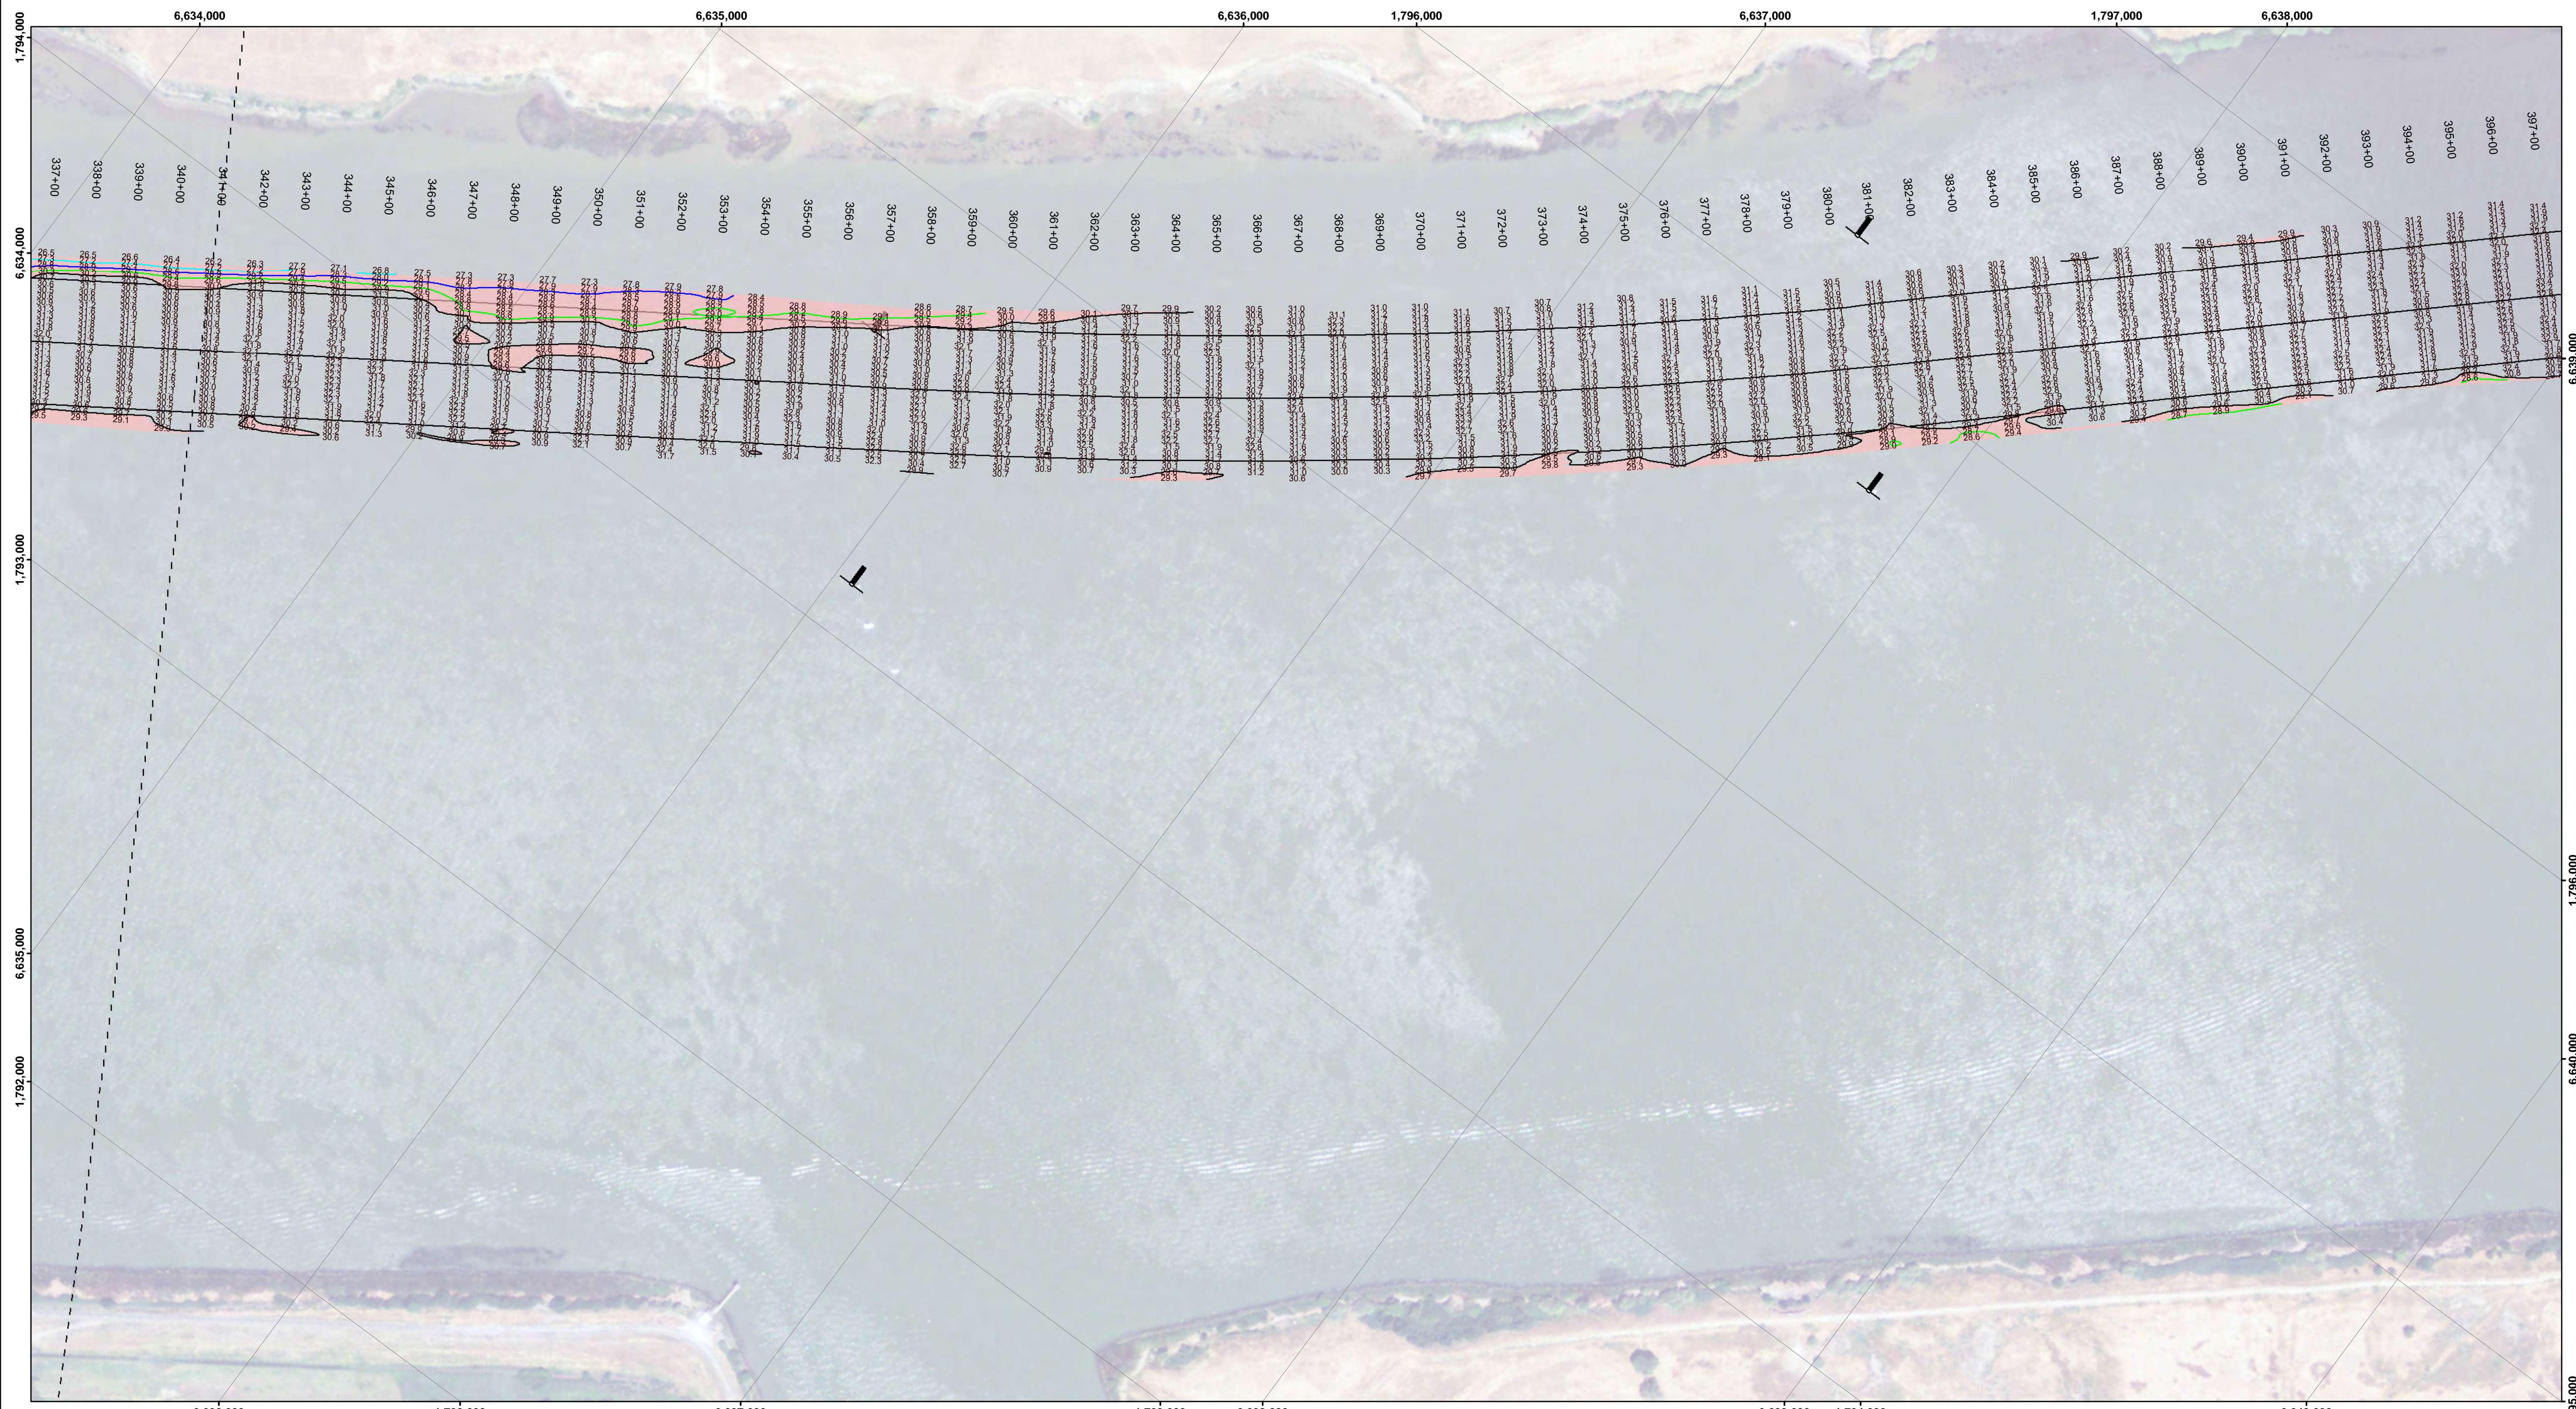


DISCLAIMER: The United States Government furnishes these data and the results of the survey for the purpose of providing information and does not warrant the accuracy, completeness, or implied liability of the data. The user is responsible for the results of any application of the data for other than its intended purpose.

ACCESS CONTROLS: The United States Government furnishes these data and the results of the survey for the purpose of providing information and does not warrant the accuracy, completeness, or implied liability of the data. The user is responsible for the results of any application of the data for other than its intended purpose.

Chart Date:	Mar 12, 2018
Surveyed By:	Travis J. Rayfield
Plotted By:	PDT
Checked By:	PDT
Drawn By:	PDT

SACRAMENTO RIVER
CONDITION SURVEY
21, 25, 27-28 FEBRUARY 2018

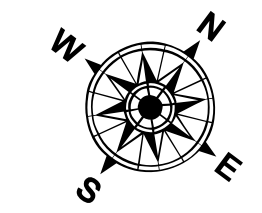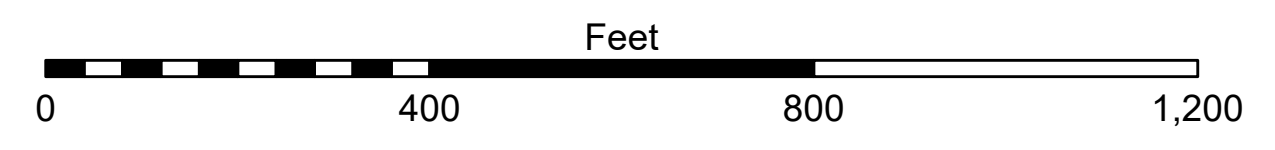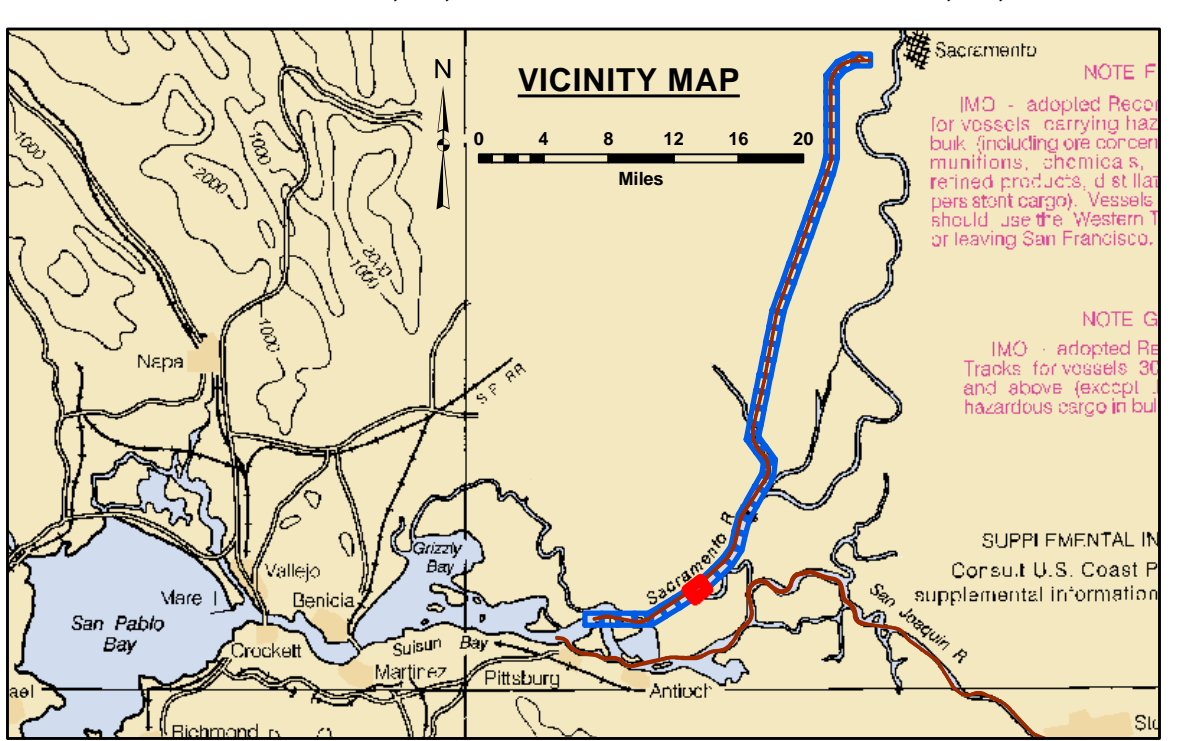

LEGEND		Contours	
--- Federal Navigation Channel	▨ Cable Area	— -30	
— Federal Navigation Center Line	□ Placement Area	— -29	
..... Cable Submarine	▨ Anchorage Area	— -28	
- - - Cable Overhead	⊗ Obstruction Point	— -27	
— Contour Line	⚓ Wrecks-Submerged	— -26	
	● Shoalest Sounding**		
	⚓ Beacon, General		
	◆ Red Navigation Buoy		
	◆ Green Navigation Buoy		

NOTES:
DRAWING NOT TO BE USED FOR NAVIGATION. ONLY CHANNEL CONDITION AT DATE OF SURVEY.
THE LOCATION OF ALL NAVIGATION AIDS ARE BASED ON INFORMATION PROVIDED BY THE U.S. COAST GUARD.
BUOY LOCATIONS REPRESENT THE POSITION OF THE SINKER ONLY.

SOUNDINGS WERE TAKEN BY FATHOMETER AND ARE SHOWN TO THE NEAREST TENTH OF A FOOT.

SOUNDINGS ARE BASED ON THE DATUM OF MEAN LOWER LOW WATER AT THE LOCALITY.

NORTH AMERICAN DATUM OF 1983 (NAD83), PROJECTED TO THE STATE PLANE COORDINATE SYSTEM (SPCS), CA ZONE II (0402), DISTANCE UNITS IN U.S. SURVEY FEET.

PLANE GRID AND COORDINATES ARE BASED ON LAMBERT PROJECTION, NAD 83, ZONE II CALIFORNIA AS DESCRIBED IN SPECIAL PUBLICATION NO. 235, PUBLISHED BY THE NATIONAL OCEAN SURVEY.

PROJECT DEPTH: -30'

VERTICAL DATUM: MLLW

THE LOCATION OF NAVIGATION AIDS ARE BASED ON AND PROVIDED BY THE U.S. COAST GUARD

CONTROLS:
LOCATION: RIO VISTA
NOAA STATION: 9415316
BENCHMARK: 5316 B 1996 (NO PID)
TIDE GAUGE: NAIL @ 8.2 FT MLLW
METADATA: NAIL SET BY USACE 31 MARCH, 2014

LOCATION: PORT OF WEST SACRAMENTO
NOAA STATION: 9416131
BENCHMARK: POWS1 (NO PID)
TIDE GAUGE: NAIL @ 10.0 FT MLLW
METADATA: NAIL SET BY USACE 8 APRIL, 2014

ALL HORIZONTAL POSITIONS AND MLLW ELEVATIONS WERE POST-PROCESSED USING PUBLIC GPS REFERENCE STATIONS IN THE AREA.




DISCLAIMER
 The United States Government furnishes these data and the results of the survey as they are received and does not warrant the accuracy, completeness, or reliability of the information. The user is responsible for the results of any application of the data for other than its intended purpose.
 Distribution Liability: The user represents the results of data collection/processing/analysis for a specific project. The user is responsible for the results of any application of the data for other than its intended purpose.
 The recipient may not transfer these data to others without also transferring this Disclaimer.

Chart Date:	Mar 12, 2018
Designed by:	
Drawn by:	PDT
Surveyed By:	
Plotted By:	PDT
Checked By:	PDT
Approved:	
Chief, Construction Branch	

CALIFORNIA
 SAN JOAQUIN COUNTY
SACRAMENTO RIVER
 CONDITION SURVEY
 21, 25, 27-28 FEBRUARY 2018

Sheet Reference Number
9 of 45

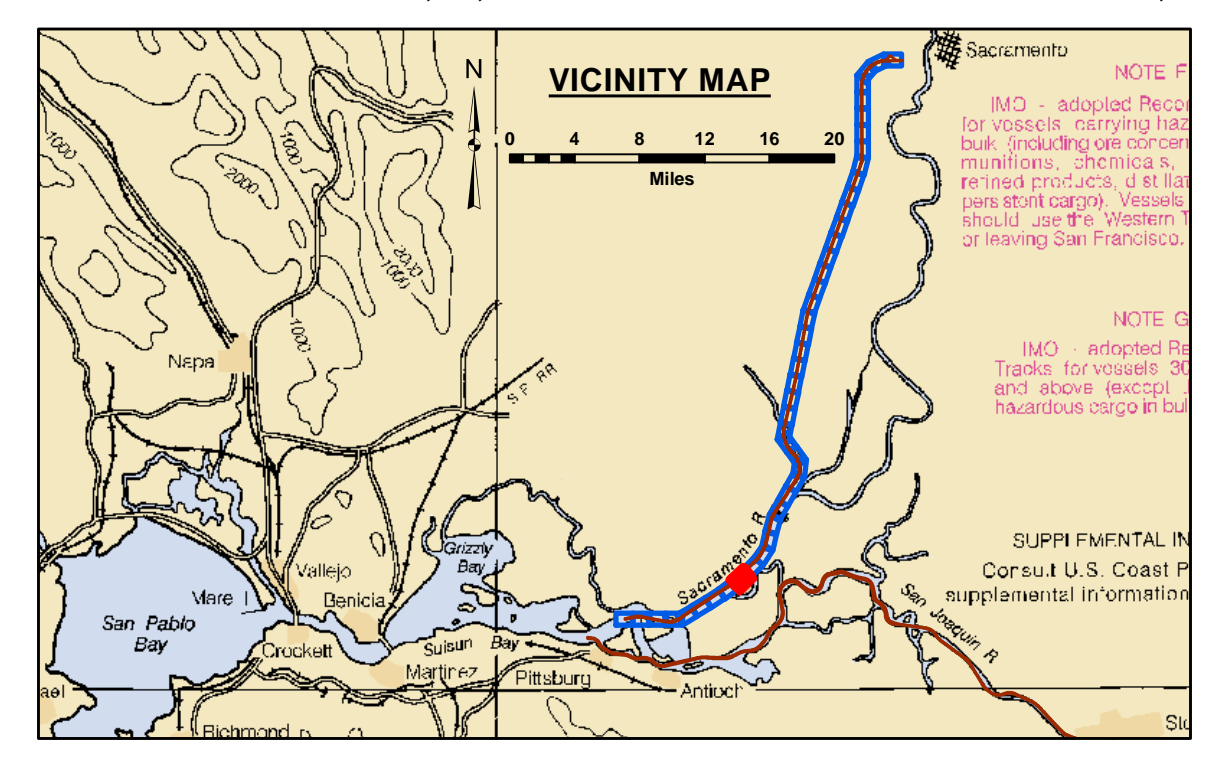


LEGEND

--- Federal Navigation Channel	▨ Cable Area	■ Shoaling Area	— Contours
— Federal Navigation Center Line	□ Placement Area	● Shoalest Sounding**	— -30
..... Cable Submarine	▭ Anchorage Area	⊥ Beacon, General	— -29
- - - Cable Overhead	⊗ Obstruction Point	◆ Red Navigation Buoy	— -28
— Contour Line	✈ Wrecks-Submerged	◆ Green Navigation Buoy	— -27
			— -26

NOTES:
 DRAWING NOT TO BE USED FOR NAVIGATION. ONLY CHANNEL CONDITION AT DATE OF SURVEY.
 THE LOCATION OF ALL NAVIGATION AIDS ARE BASED ON INFORMATION PROVIDED BY THE U.S. COAST GUARD.
 BUOY LOCATIONS REPRESENT THE POSITION OF THE SINKER ONLY.
 SOUNDINGS WERE TAKEN BY FATHOMETER AND ARE SHOWN TO THE NEAREST TENTH OF A FOOT.
 SOUNDINGS ARE BASED ON THE DATUM OF MEAN LOWER LOW WATER AT THE LOCALITY.
 NORTH AMERICAN DATUM OF 1983 (NAD83), PROJECTED TO THE STATE PLANE COORDINATE SYSTEM (SPCS), CA ZONE II (0402). DISTANCE UNITS IN U.S. SURVEY FEET.
 PLANE GRID AND COORDINATES ARE BASED ON LAMBERT PROJECTION, NAD 83, ZONE II CALIFORNIA AS DESCRIBED IN SPECIAL PUBLICATION NO. 235, PUBLISHED BY THE NATIONAL OCEAN SURVEY.
 PROJECT DEPTH: -30'
 VERTICAL DATUM: MLLW
 THE LOCATION OF NAVIGATION AIDS ARE BASED ON AND PROVIDED BY THE U.S. COAST GUARD
CONTROLS:
 LOCATION: RIO VISTA
 NOAA STATION: 9415316
 BENCHMARK: 5316 B 1996 (NO PID)
 TIDE GAUGE: NAIL @ 8.2 FT MLLW
 METADATA: NAIL SET BY USACE 31 MARCH, 2014
 LOCATION: PORT OF WEST SACRAMENTO
 NOAA STATION: 9416131
 BENCHMARK: POWS1 (NO PID)
 TIDE GAUGE: NAIL @ 10.0 FT MLLW
 METADATA: NAIL SET BY USACE 8 APRIL, 2014
 ALL HORIZONTAL POSITIONS AND MLLW ELEVATIONS WERE POST-PROCESSED USING PUBLIC GPS REFERENCE STATIONS IN THE AREA.



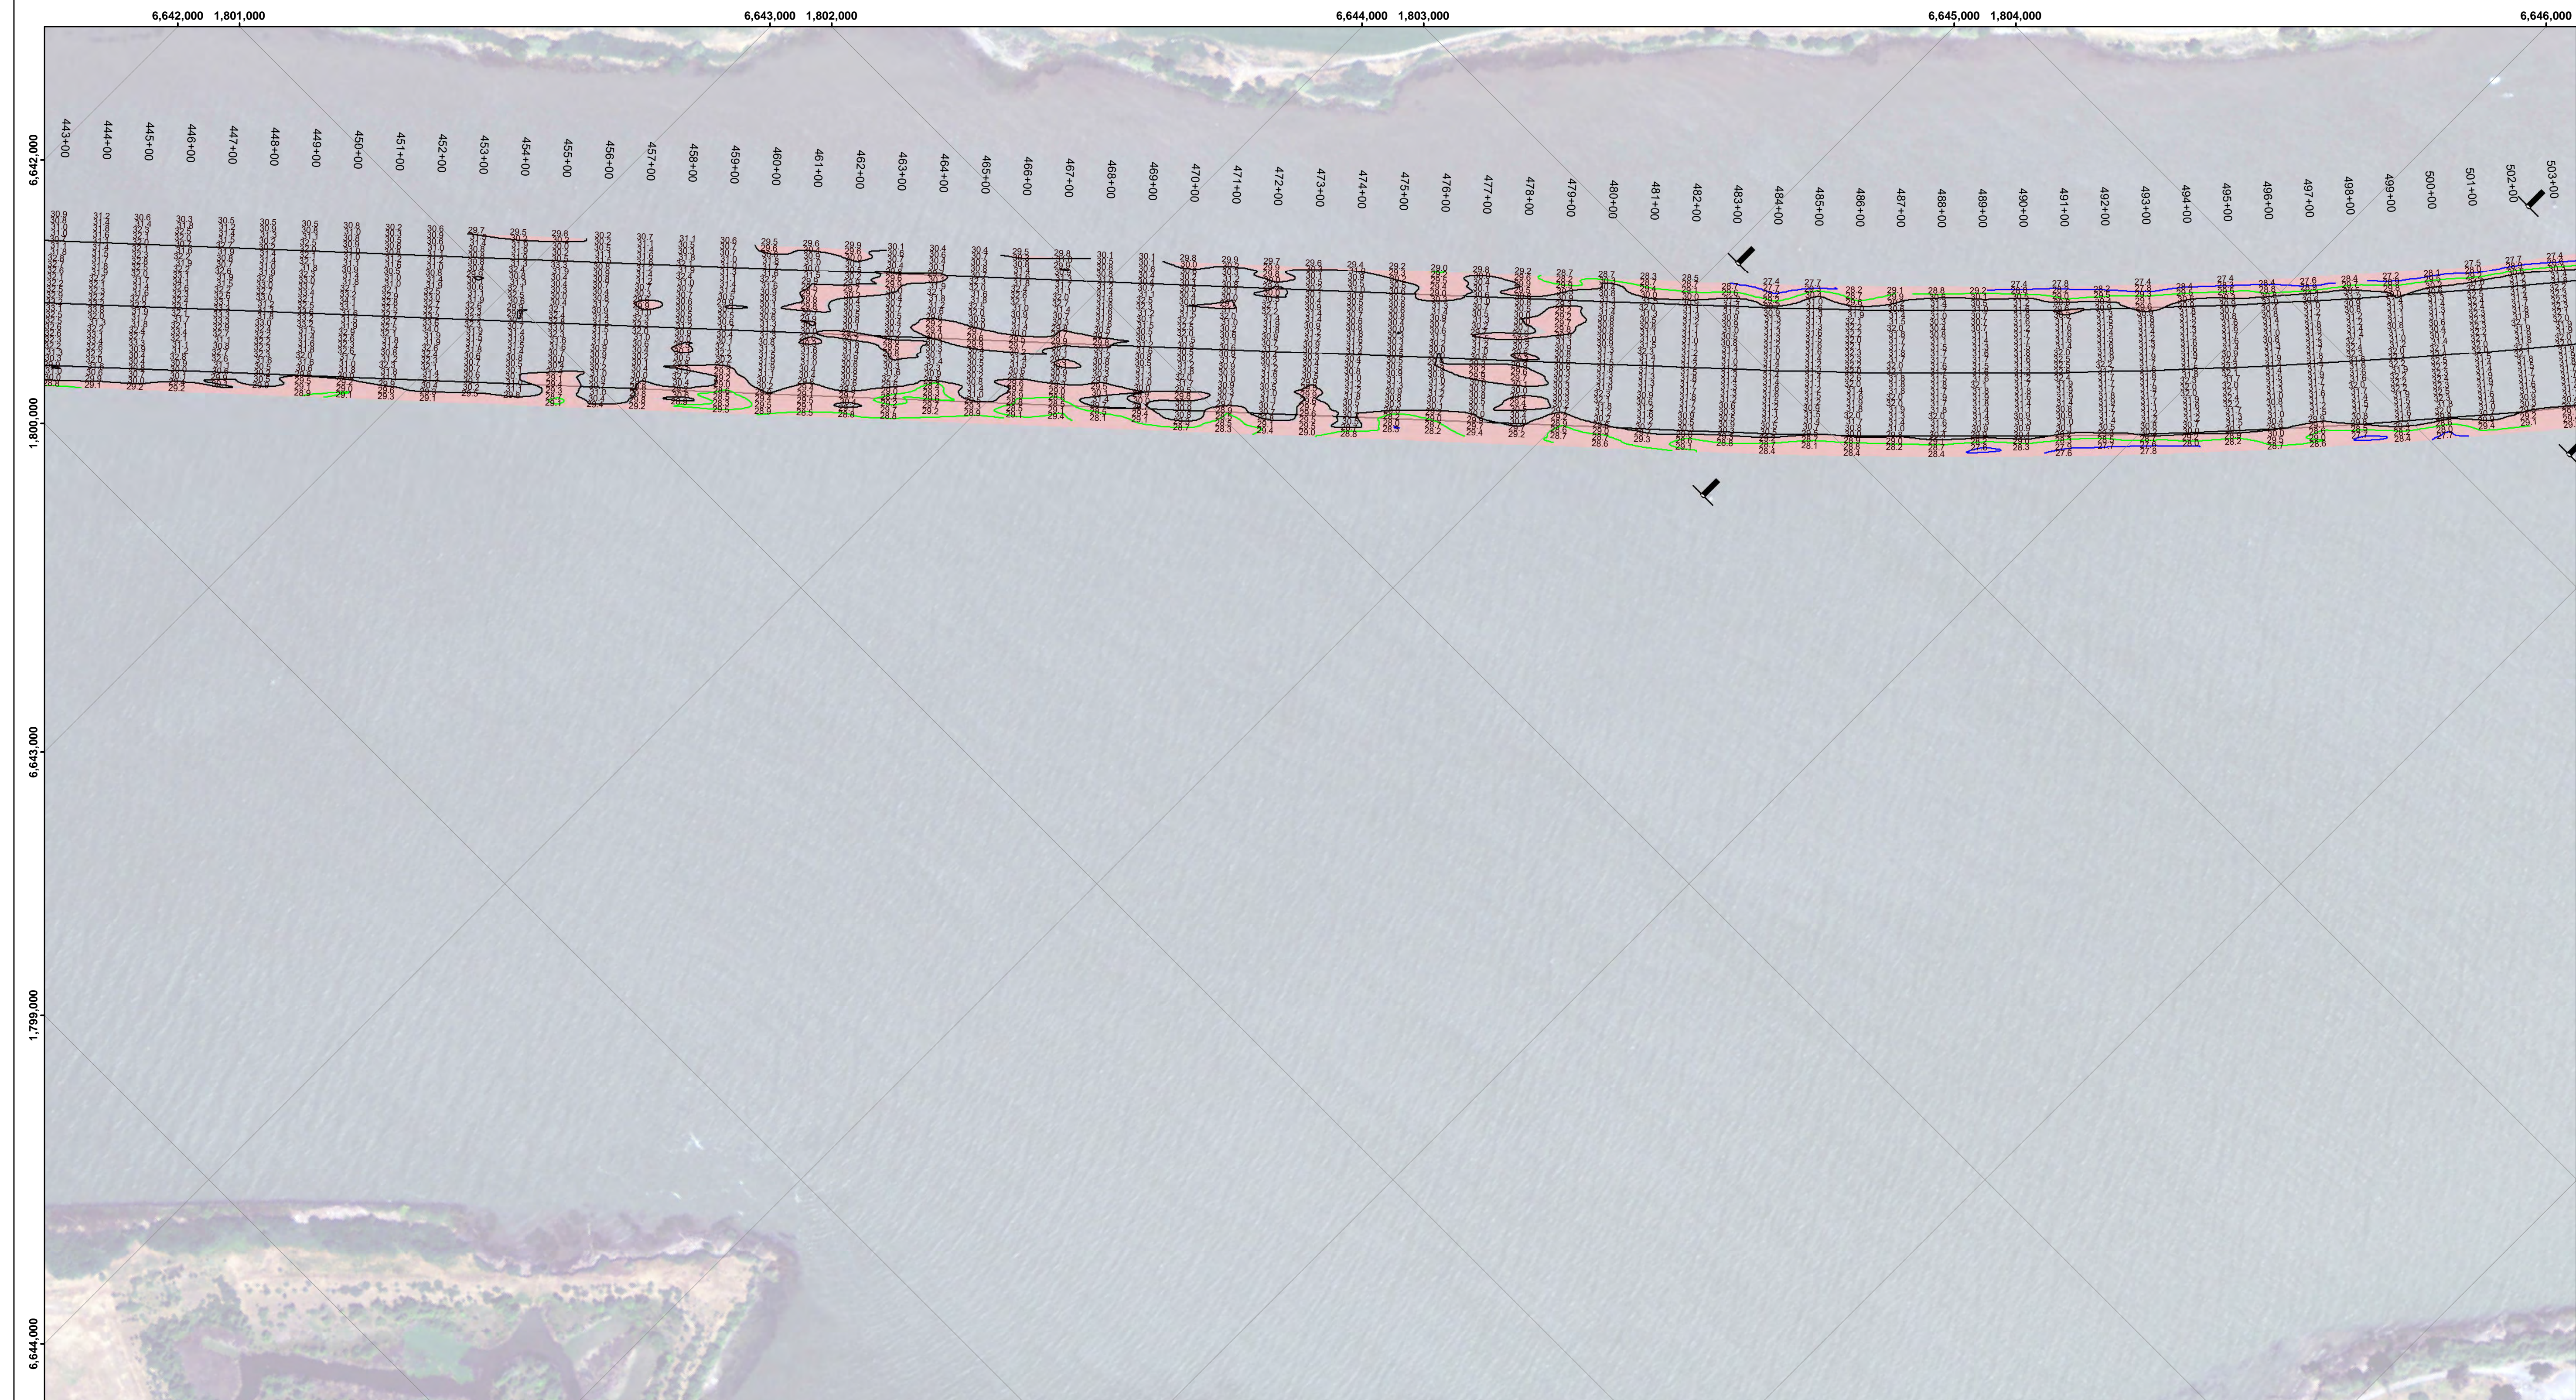


DISCLAIMER: The United States Government furnishes these data and the results of the survey and uses them with the express understanding that the user is responsible for the results of any application of the data for other than its intended purpose. The user is responsible for the results of any application of the data for other than its intended purpose.

Access Constraints: The United States Government furnishes these data and the results of the survey and uses them with the express understanding that the user is responsible for the results of any application of the data for other than its intended purpose. The user is responsible for the results of any application of the data for other than its intended purpose.

Chart Date:	Mar 12, 2018
Surveyed By:	_____
Plotted By:	PDT
Checked By:	PDT
Drawn By:	PDT


SACRAMENTO RIVER
CONDITION SURVEY
21, 25, 27-28 FEBRUARY 2018

Sheet Reference Number
10 of 45

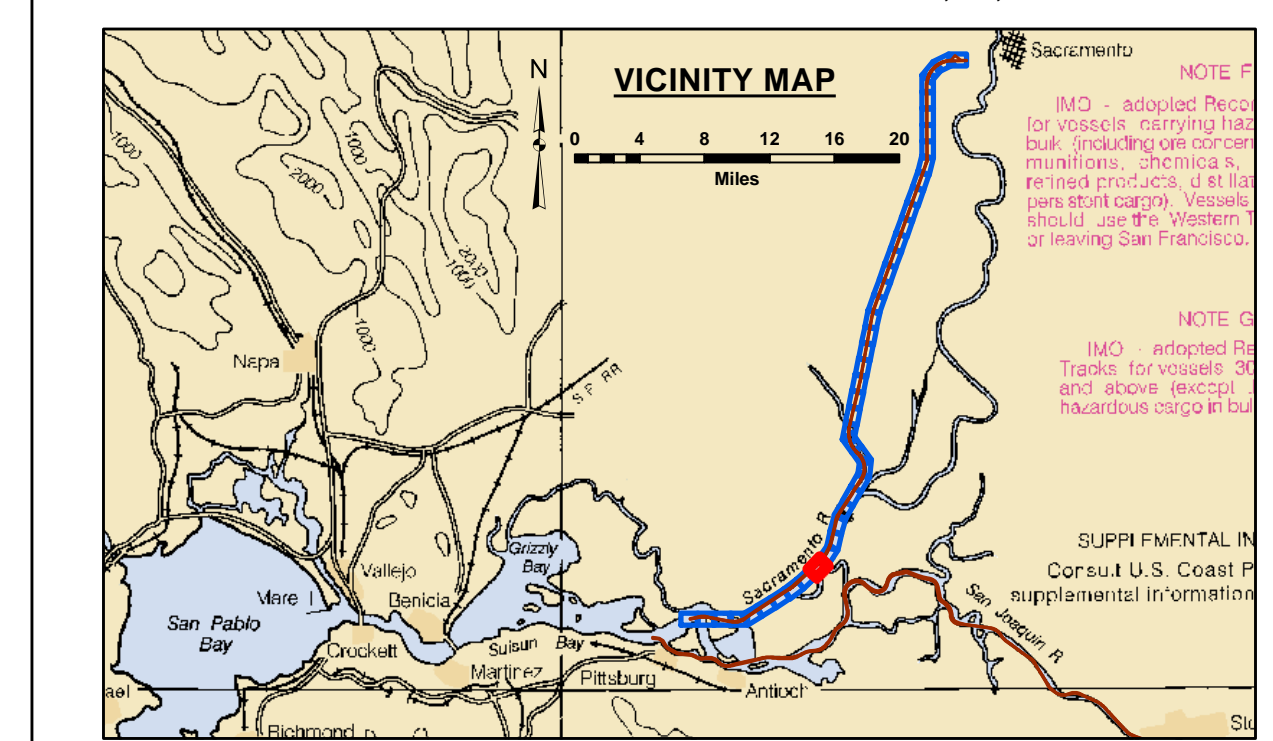

LEGEND

--- Federal Navigation Channel	▨ Cable Area	■ Shoaling Area	— Contours
— Federal Navigation Center Line	□ Placement Area	● Shoalest Sounding**	— -30
⋯ Cable Submarine	⊠ Anchorage Area	⊥ Beacon, General	— -29
- - - Cable Overhead	⊗ Obstruction Point	◆ Red Navigation Buoy	— -28
— Contour Line	✦ Wrecks-Submerged	◆ Green Navigation Buoy	— -27
			— -26

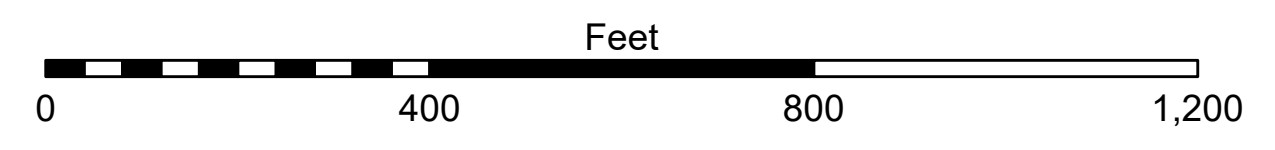

NOTES:
DRAWING NOT TO BE USED FOR NAVIGATION. ONLY CHANNEL CONDITION AT DATE OF SURVEY.
THE LOCATION OF ALL NAVIGATION AIDS ARE BASED ON INFORMATION PROVIDED BY THE U.S. COAST GUARD.
BUOY LOCATIONS REPRESENT THE POSITION OF THE SINKER ONLY.

SOUNDINGS WERE TAKEN BY FATHOMETER AND ARE SHOWN TO THE NEAREST TENTH OF A FOOT.

SOUNDINGS ARE BASED ON THE DATUM OF MEAN LOWER LOW WATER AT THE LOCALITY.

NORTH AMERICAN DATUM OF 1983 (NAD83), PROJECTED TO THE STATE PLANE COORDINATE SYSTEM (SPCS), ZONE II (0402). DISTANCE UNITS IN U.S. SURVEY FEET.

PLANE GRID AND COORDINATES ARE BASED ON LAMBERT PROJECTION, NAD 83, ZONE II CALIFORNIA AS DESCRIBED IN SPECIAL PUBLICATION NO. 235, PUBLISHED BY THE NATIONAL OCEAN SURVEY.

PROJECT DEPTH: -30'
VERTICAL DATUM: MLLW


THE LOCATION OF NAVIGATION AIDS ARE BASED ON AND PROVIDED BY THE U.S. COAST GUARD

CONTROLS:
LOCATION: RIO VISTA
NOAA STATION: 9415316
BENCHMARK: 5316 B 1996 (NO PID)
TIDE GAUGE: NAIL @ 8.2 FT MLLW
METADATA: NAIL SET BY USACE 31 MARCH, 2014

LOCATION: PORT OF WEST SACRAMENTO
NOAA STATION: 9416131
BENCHMARK: POWS1 (NO PID)
TIDE GAUGE: NAIL @ 10.0 FT MLLW
METADATA: NAIL SET BY USACE 8 APRIL, 2014

ALL HORIZONTAL POSITIONS AND MLLW ELEVATIONS WERE POST-PROCESSED USING PUBLIC GPS REFERENCE STATIONS IN THE AREA.



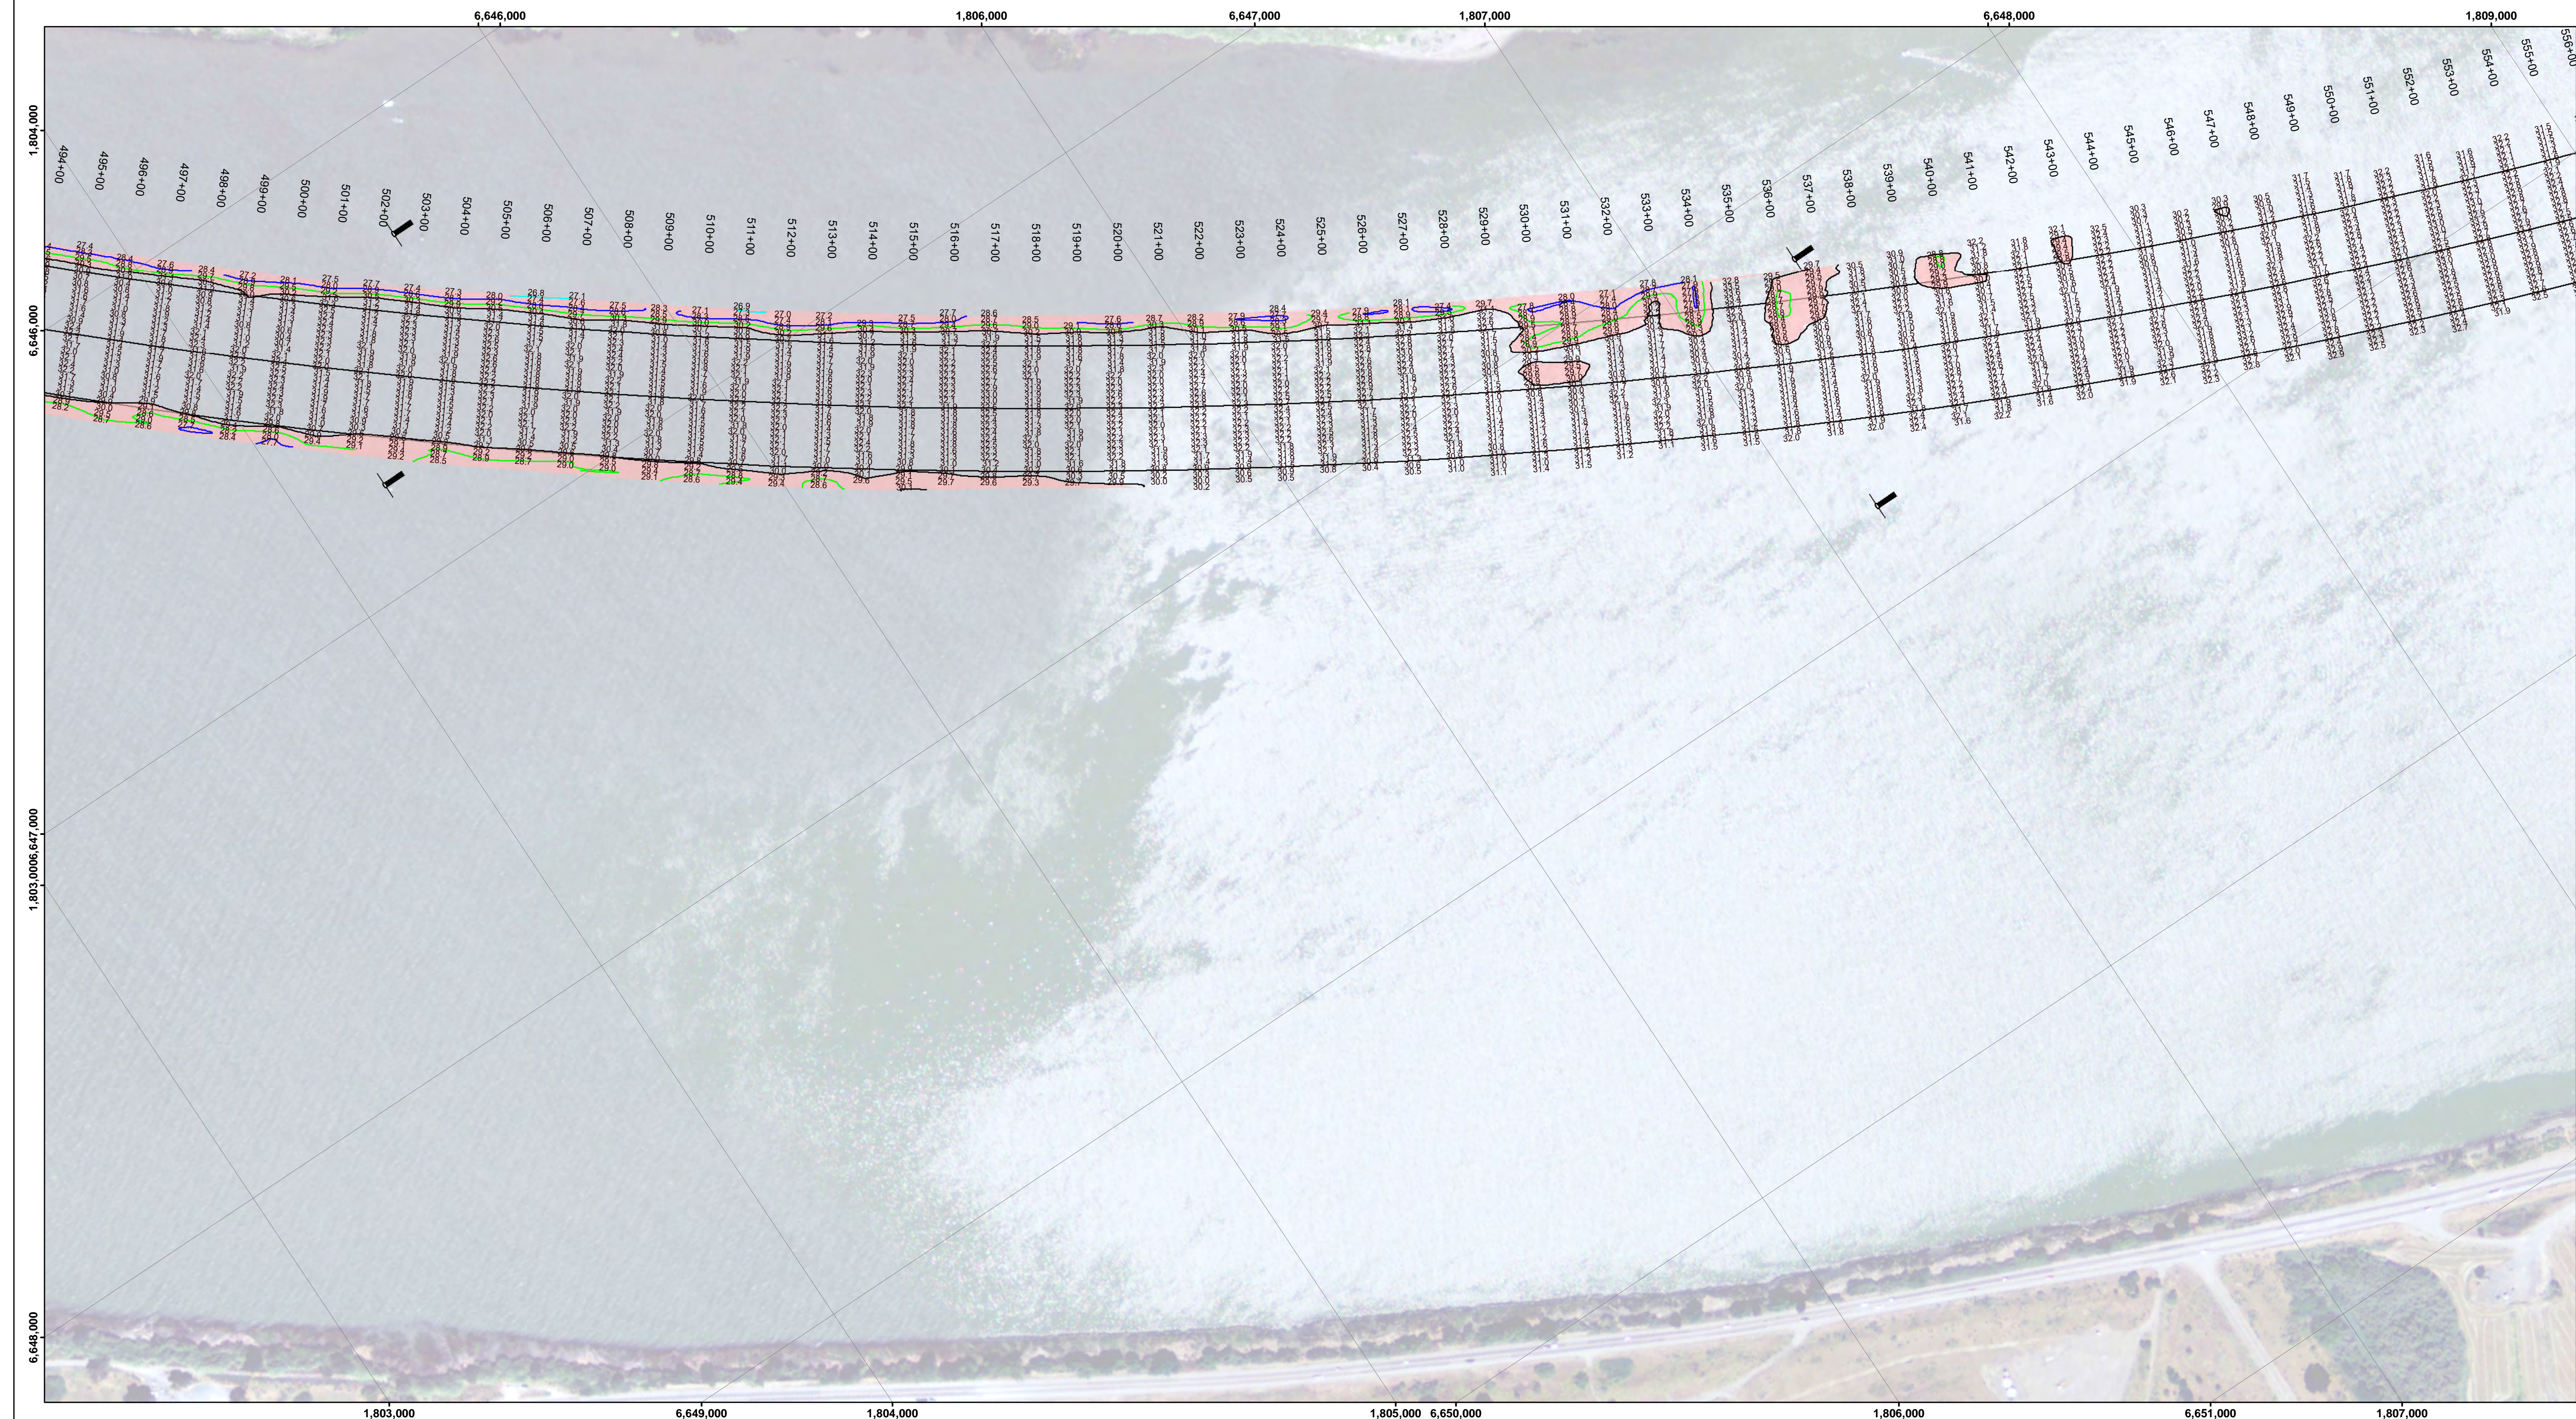



DISCLAIMER: The United States Government furnishes these data and the results of the survey and uses them with the express understanding that the user is responsible for the results of any application of the data for other than its intended purposes. 



PREPARED UNDER THE DIRECTION OF TRAVIS J. RAYFIELD LT COLONEL, C.E., DISTRICT ENGINEER Standard: Hydro Survey Team Leader Recommended: Chief, Hydro Survey Section Approved: Chief, Construction Branch	Surveyed By:	Chart Date:
	Plotted By:	Mar 12, 2018
	Checked By:	Designed by:
	PDT	PDT

CALIFORNIA
SACRAMENTO RIVER
 CONDITION SURVEY
 21, 25, 27-28 FEBRUARY 2018

SAN JOAQUIN COUNTY
Sheet Reference Number
 11 of 45

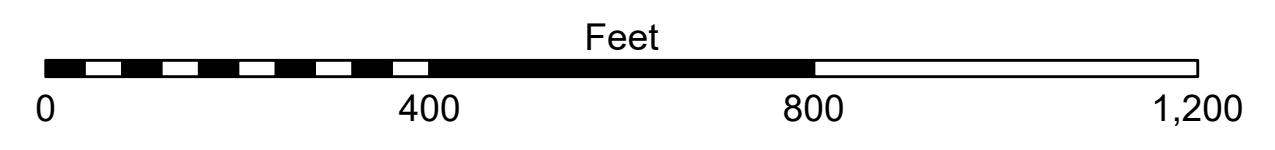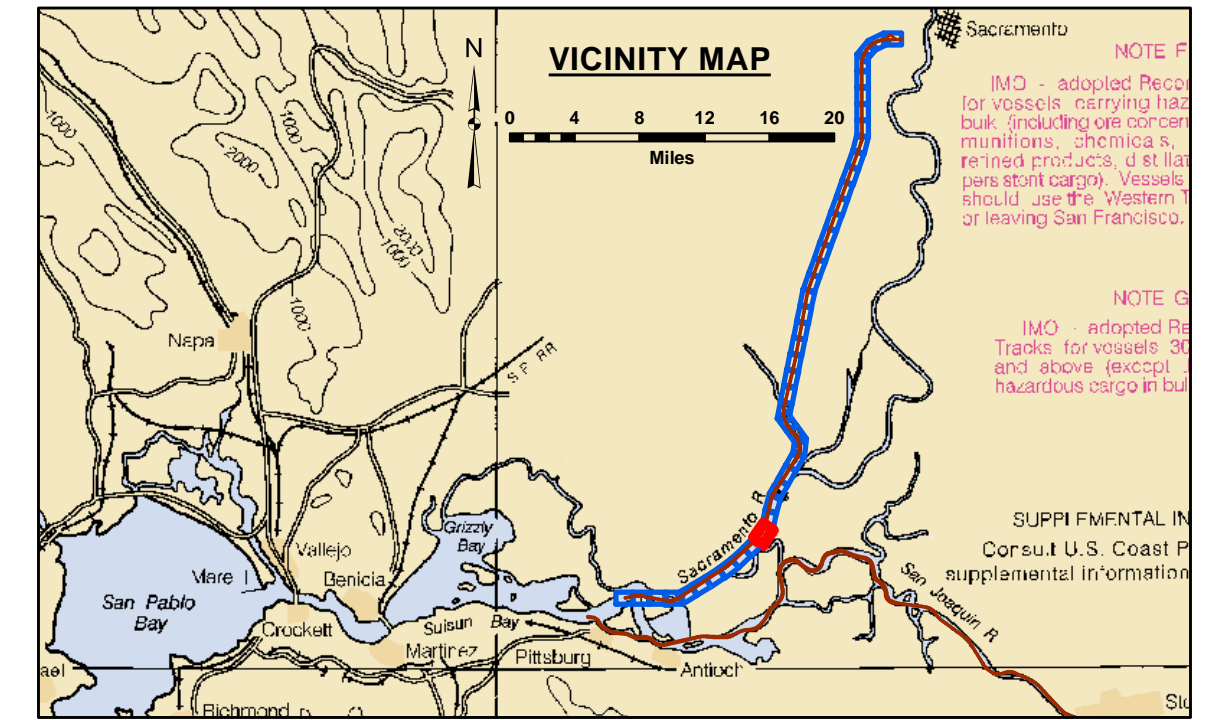

LEGEND			
--- Federal Navigation Channel	▨ Cable Area	■ Shoaling Area	— Contours
— Federal Navigation Center Line	□ Placement Area	● Shoalest Sounding**	— -30
⋯ Cable Submarine	⊠ Anchorage Area	⊥ Beacon, General	— -29
- - - Cable Overhead	⊗ Obstruction Point	◆ Red Navigation Buoy	— -28
— Contour Line	✦ Wrecks-Submerged	◆ Green Navigation Buoy	— -27
			— -26

NOTES:
 DRAWING NOT TO BE USED FOR NAVIGATION. ONLY CHANNEL CONDITION AT DATE OF SURVEY.
 THE LOCATION OF ALL NAVIGATION AIDS ARE BASED ON INFORMATION PROVIDED BY THE U.S. COAST GUARD.
 BUOY LOCATIONS REPRESENT THE POSITION OF THE SINKER ONLY.

SOUNDINGS WERE TAKEN BY FATHOMETER AND ARE SHOWN TO THE NEAREST TENTH OF A FOOT.

SOUNDINGS ARE BASED ON THE DATUM OF MEAN LOWER LOW WATER AT THE LOCALITY.

NORTH AMERICAN DATUM OF 1983 (NAD83), PROJECTED TO THE STATE PLANE COORDINATE SYSTEM (SPCS), CA ZONE II (0402). DISTANCE UNITS IN U.S. SURVEY FEET.

PLANE GRID AND COORDINATES ARE BASED ON LAMBERT PROJECTION, NAD 83, ZONE II CALIFORNIA AS DESCRIBED IN SPECIAL PUBLICATION NO. 235, PUBLISHED BY THE NATIONAL OCEAN SURVEY.


PROJECT DEPTH: -30'
 VERTICAL DATUM: MLLW



THE LOCATION OF NAVIGATION AIDS ARE BASED ON AND PROVIDED BY THE U.S. COAST GUARD

CONTROLS:
 LOCATION: RIO VISTA
 NOAA STATION: 9415316
 BENCHMARK: 5316 B 1996 (NO PID)
 TIDE GAUGE: NAIL @ 8.2 FT MLLW
 METADATA: NAIL SET BY USACE 31 MARCH, 2014

LOCATION: PORT OF WEST SACRAMENTO
 NOAA STATION: 9416131
 BENCHMARK: POWS1 (NO PID)
 TIDE GAUGE: NAIL @ 10.0 FT MLLW
 METADATA: NAIL SET BY USACE 8 APRIL, 2014



ALL HORIZONTAL POSITIONS AND MLLW ELEVATIONS WERE POST-PROCESSED USING PUBLIC GPS REFERENCE STATIONS IN THE AREA.

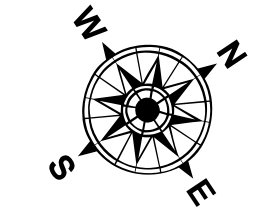

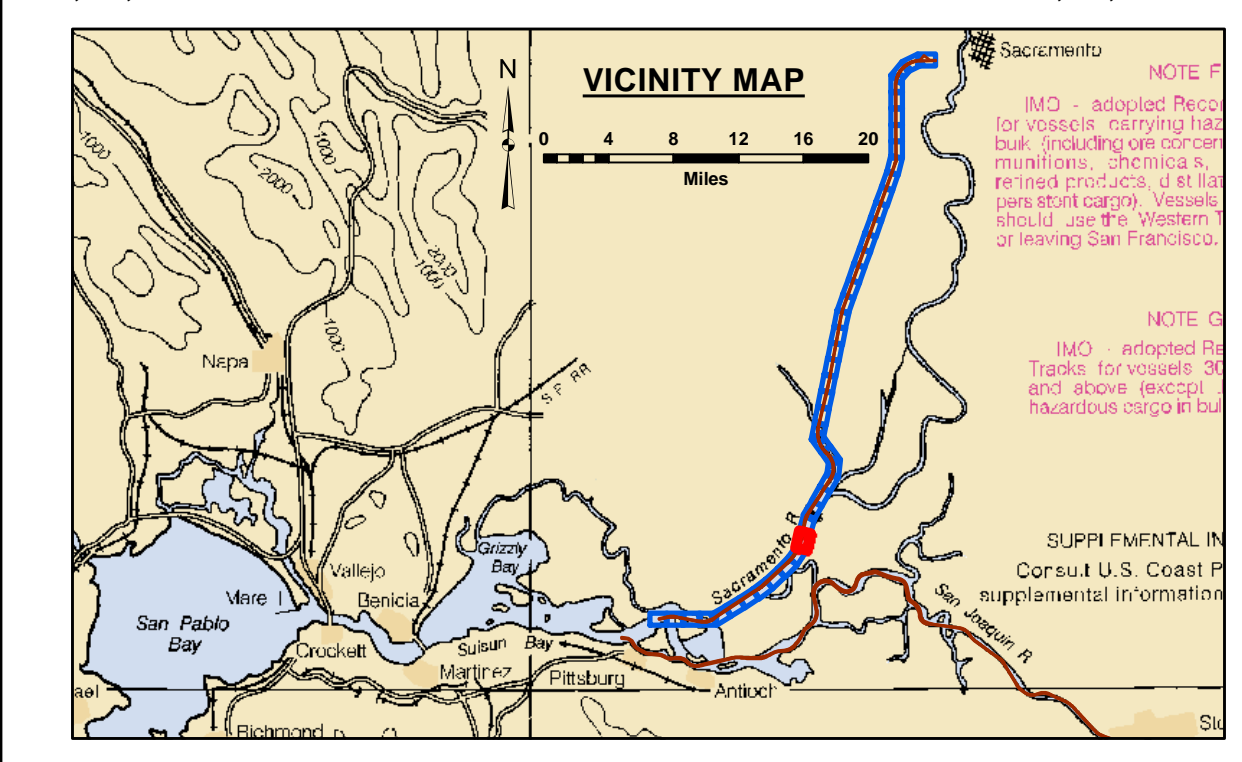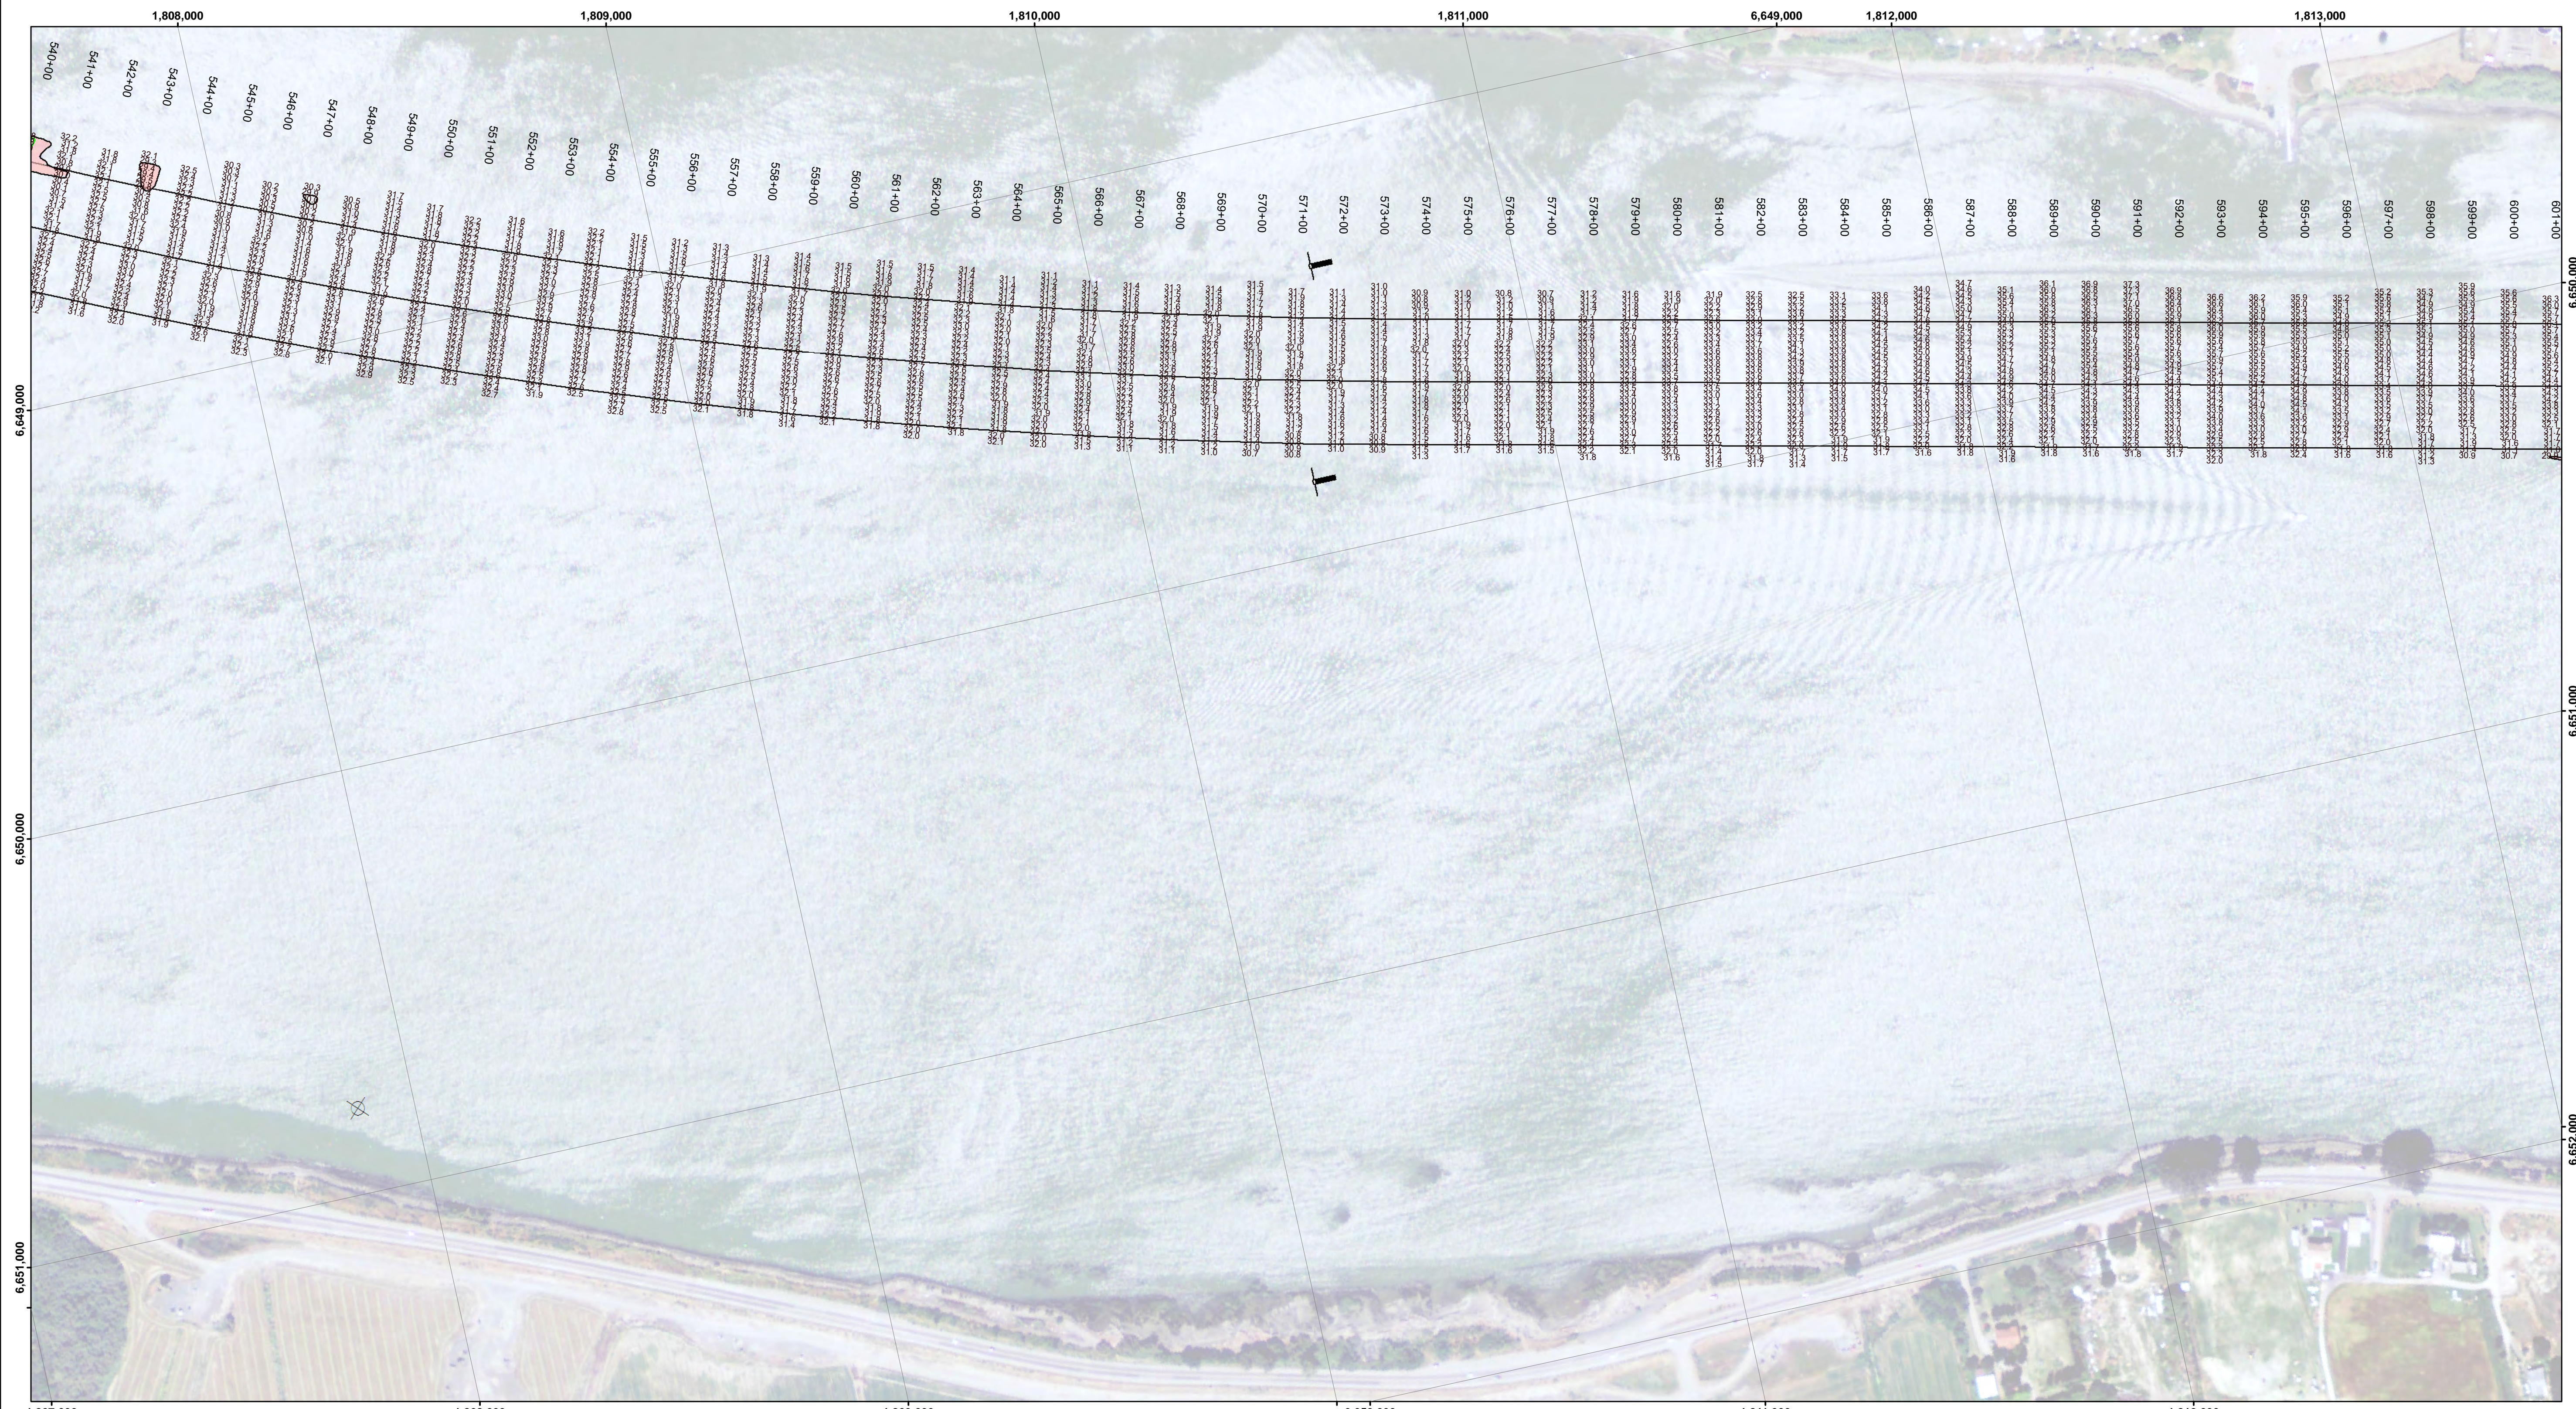

LEGEND

--- Federal Navigation Channel	▨ Cable Area	■ Shoaling Area	— Contours
— Federal Navigation Center Line	□ Placement Area	● Shoalest Sounding**	— -30
⋯ Cable Submarine	▭ Anchorage Area	⊥ Beacon, General	— -29
- - - Cable Overhead	⊗ Obstruction Point	◆ Red Navigation Buoy	— -28
— Contour Line	✦ Wrecks-Submerged	◆ Green Navigation Buoy	— -27
			— -26

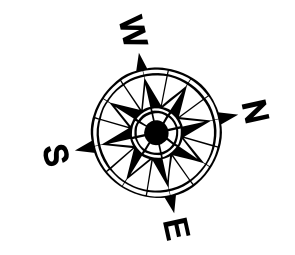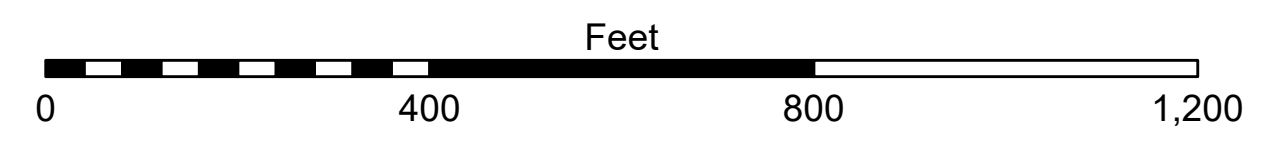

NOTES:
 DRAWING NOT TO BE USED FOR NAVIGATION. ONLY CHANNEL CONDITION AT DATE OF SURVEY.
 THE LOCATION OF ALL NAVIGATION AIDS ARE BASED ON INFORMATION PROVIDED BY THE U.S. COAST GUARD.
 BUOY LOCATIONS REPRESENT THE POSITION OF THE SINKER ONLY.

SOUNDINGS WERE TAKEN BY FATHOMETER AND ARE SHOWN TO THE NEAREST TENTH OF A FOOT.

SOUNDINGS ARE BASED ON THE DATUM OF MEAN LOWER LOW WATER AT THE LOCALITY.

NORTH AMERICAN DATUM OF 1983 (NAD83), PROJECTED TO THE STATE PLANE COORDINATE SYSTEM (SPCS),
 CA ZONE II (0402). DISTANCE UNITS IN U.S. SURVEY FEET.

PLANE GRID AND COORDINATES ARE BASED ON LAMBERT PROJECTION, NAD 83,
 ZONE II CALIFORNIA AS DESCRIBED IN SPECIAL PUBLICATION NO. 235,
 PUBLISHED BY THE NATIONAL OCEAN SURVEY.

PROJECT DEPTH: -30'
 VERTICAL DATUM: MLLW

THE LOCATION OF NAVIGATION AIDS ARE BASED ON AND PROVIDED BY THE U.S. COAST GUARD

CONTROLS:
 LOCATION: RIO VISTA
 NOAA STATION: 9415316
 BENCHMARK: 5316 B 1996 (NO PID)
 TIDE GAUGE: NAIL @ 8.2 FT MLLW
 METADATA: NAIL SET BY USACE 31 MARCH, 2014

LOCATION: PORT OF WEST SACRAMENTO
 NOAA STATION: 9416131
 BENCHMARK: POWS1 (NO PID)
 TIDE GAUGE: NAIL @ 10.0 FT MLLW
 METADATA: NAIL SET BY USACE 8 APRIL, 2014

ALL HORIZONTAL POSITIONS AND MLLW ELEVATIONS WERE
 POST-PROCESSED USING PUBLIC GPS
 REFERENCE STATIONS IN THE AREA.




DISCLAIMER: The United States Government furnishes these data and the results of the processing of these data and the use of these data for any purpose, expressed or implied, concerning the accuracy, completeness, or reliability of the data furnished. The United States shall be under no liability whatsoever to any person by reason of any use of these data, in whole or in part, for any purpose other than that for which they were prepared. The recipient may not transfer these data to others without also transferring this Disclaimer.

Prepared Under the Direction of TRAVIS J. RAYFIELD LT COLONEL, C.E., DISTRICT ENGINEER	Chart Date: Mar 12, 2018
Survised By: Hydro Survey Team Leader	Designed by: PDT
Plotted By: PDT	Drawn by: PDT
Recommended: Chief, Hydro Survey Section	Checked by: PDT
Approved: Chief, Construction Branch	

CALIFORNIA
SACRAMENTO RIVER
 CONDITION SURVEY
 21, 25, 27-28 FEBRUARY 2018

Sheet
 Reference
 Number
12 of 45

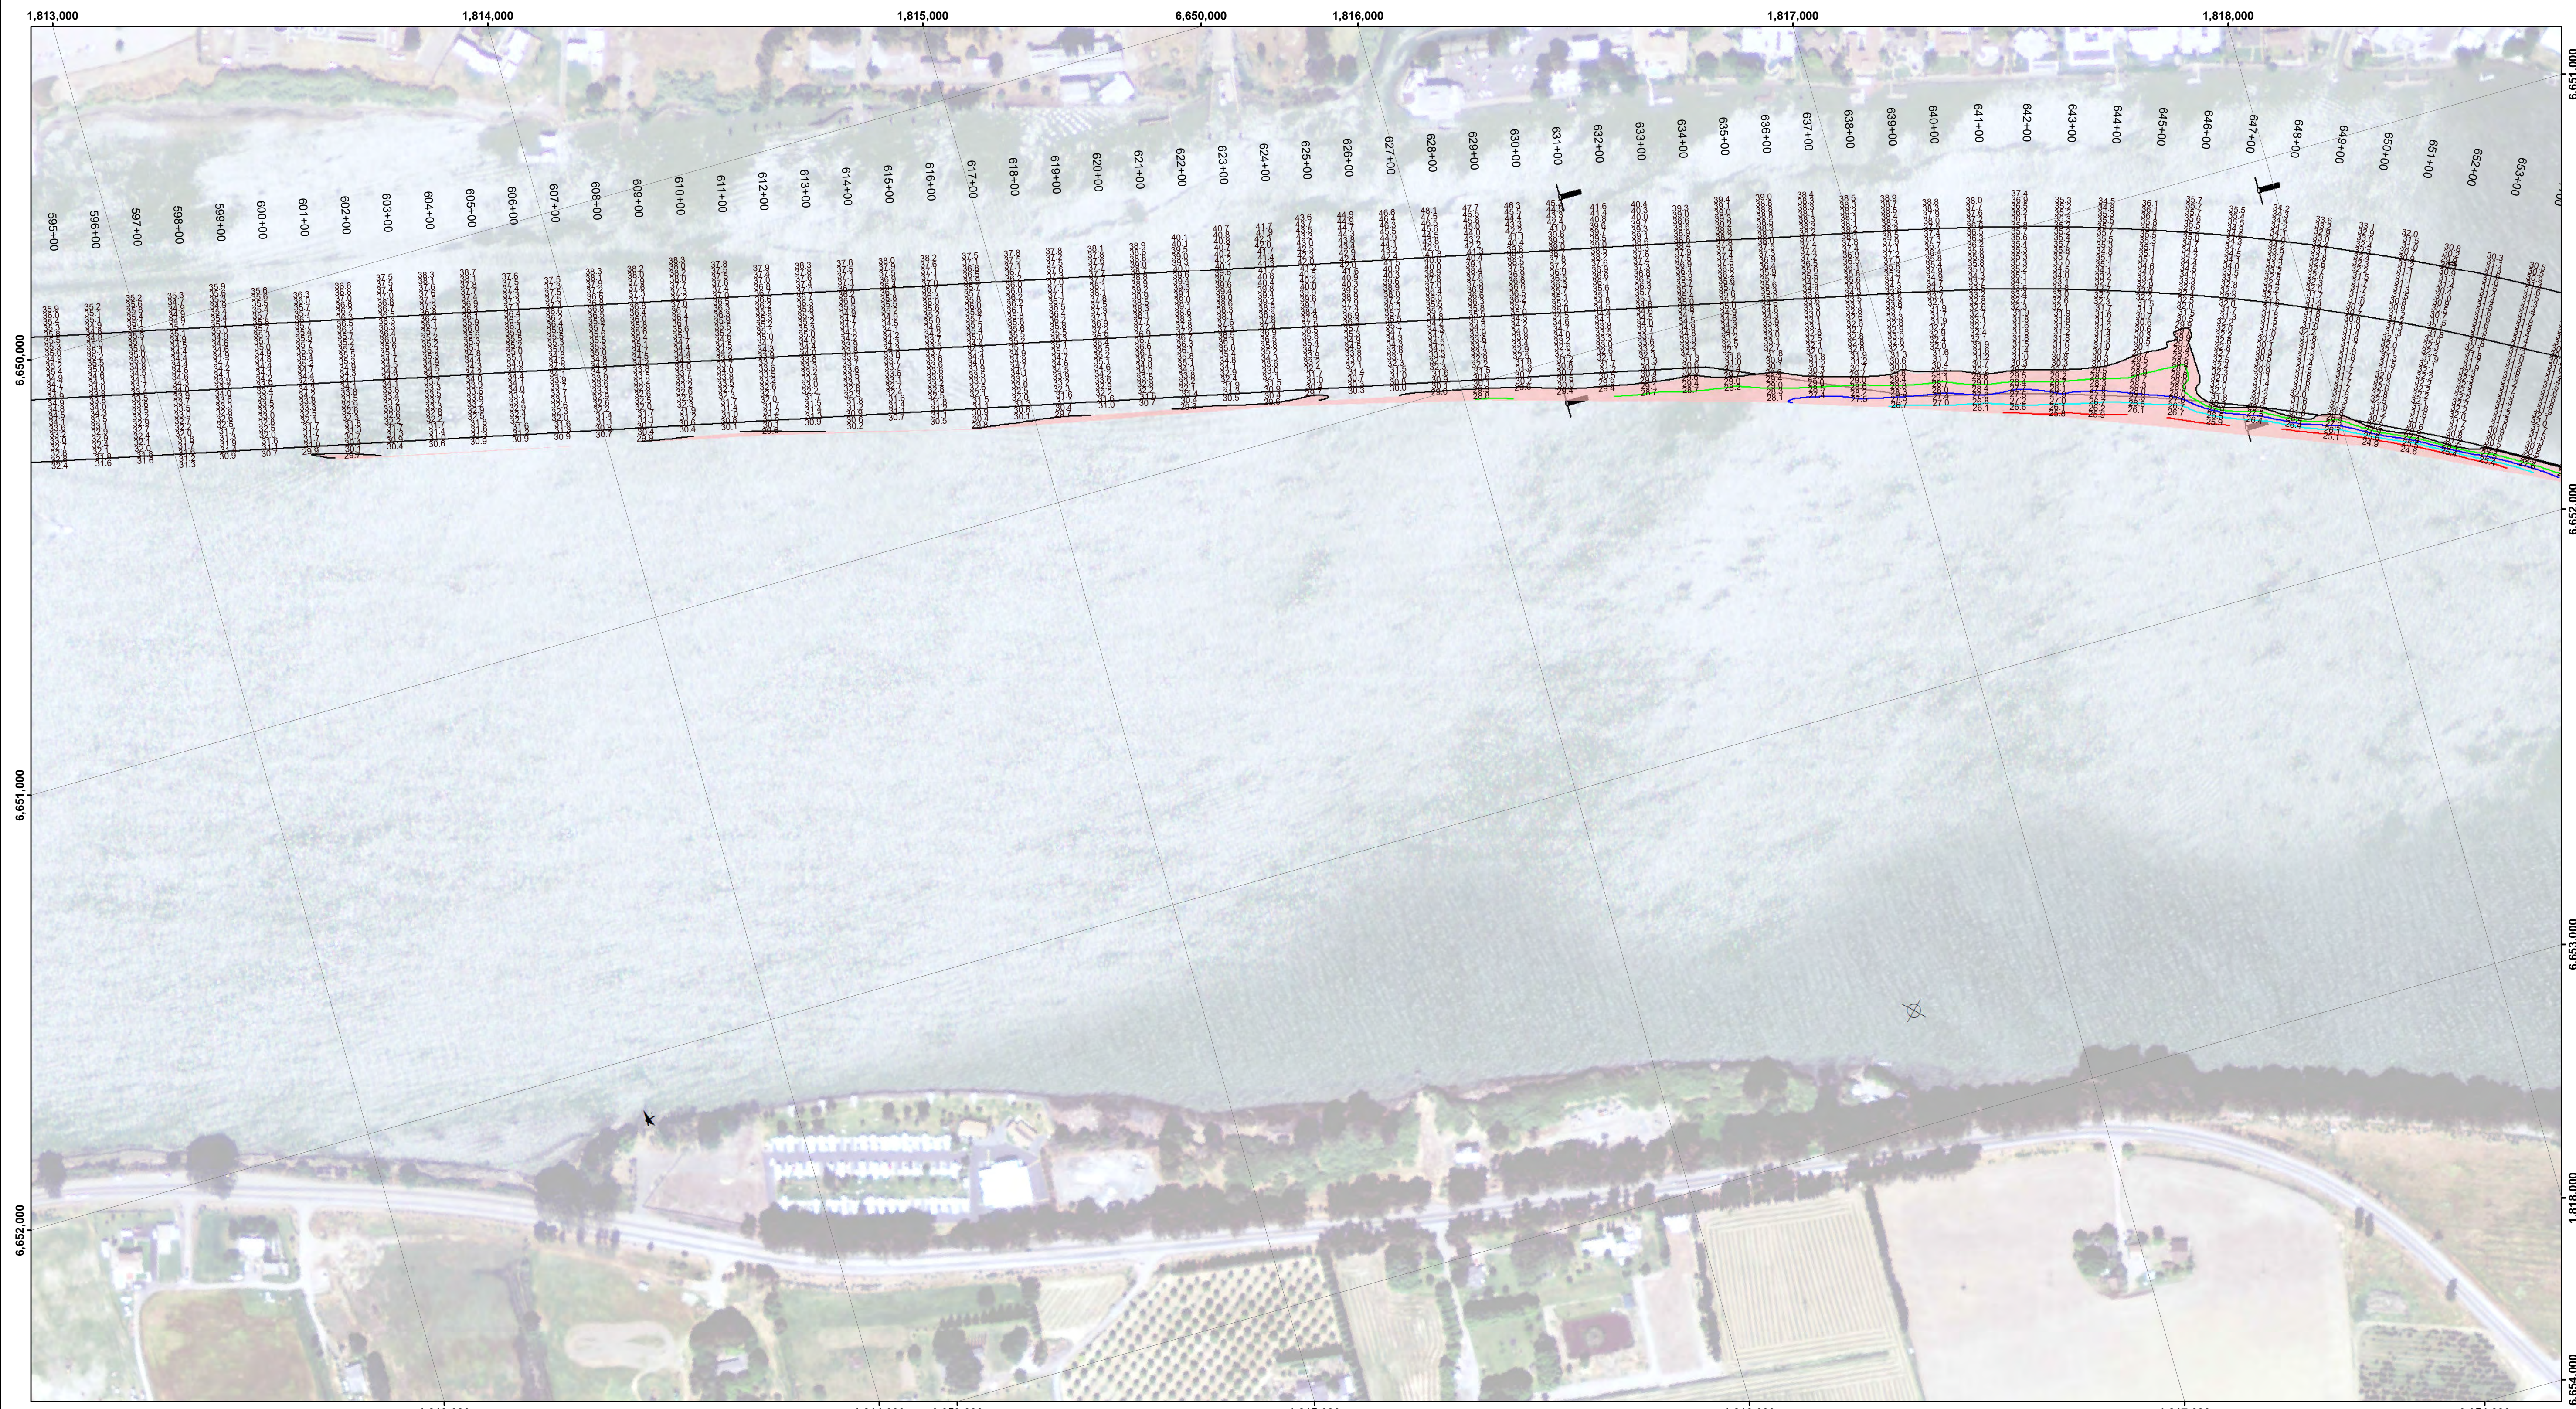


DISCLAIMER: The United States Government furnishes these data and the results of the processing of these data and does not warrant the accuracy, completeness, or implied consequences of the information and the data furnished. The United States shall be under no liability whatsoever to any person by reason of any use of these data or the results of the processing of these data, other than Government provided data. The recipient may not transfer these data to others without also transferring this Disclaimer.

Prepared Under the Direction of TRAVIS J. RAYFIELD LT Colonel, C.E., District Engineer	Chart Date: Mar 12, 2018
Submitted: Hydro Survey Team Leader	Designed by: PDT
Recommended: Chief, Hydro Survey Section	Drawn by: PDT
Approved: Chief, Construction Branch	

CALIFORNIA
SACRAMENTO RIVER
CONDITION SURVEY
21, 25, 27-28 FEBRUARY 2018

SAN JOAQUIN COUNTY
Sheet Reference Number
13 of 45

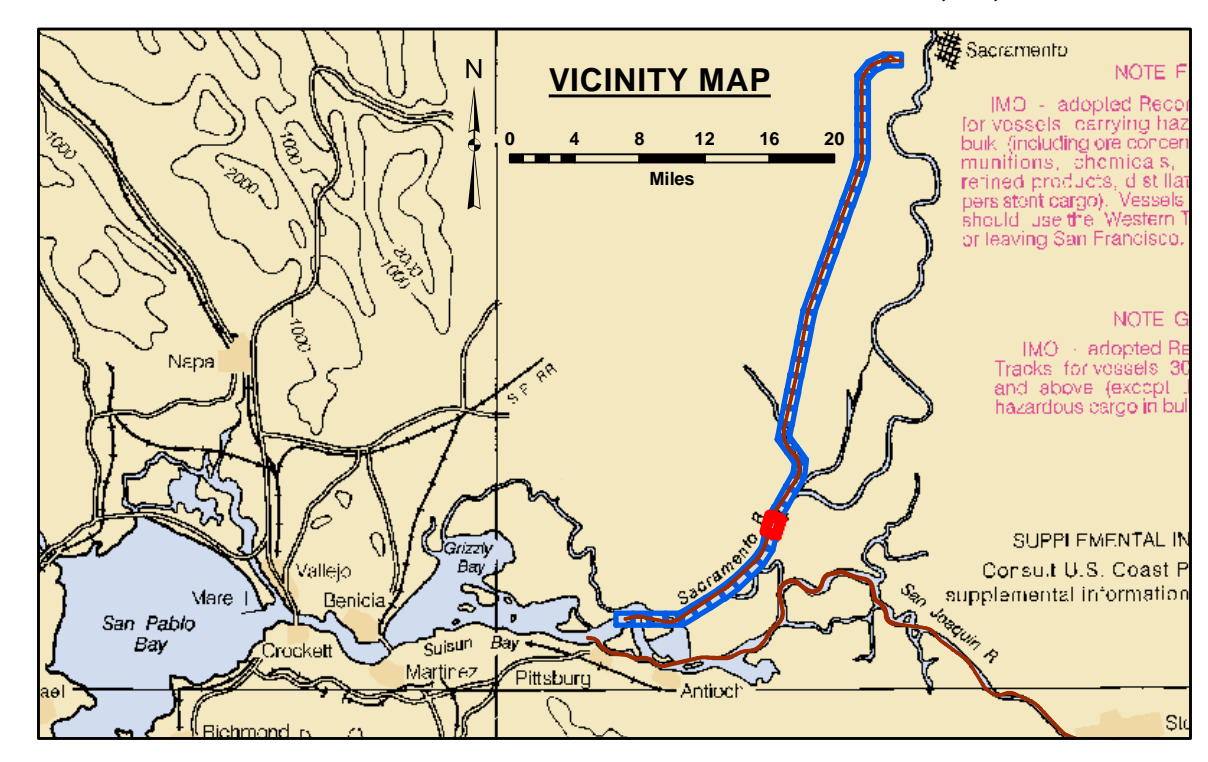

Feet
0 400 800 1,200

--- Federal Navigation Channel	Cable Area	Shoaling Area	-30
— Federal Navigation Center Line	Placement Area	Shoalest Sounding**	-29
..... Cable Submarine	Anchorage Area	Beacon, General	-28
- - - Cable Overhead	Obstruction Point	Red Navigation Buoy	-27
— Contour Line	Wrecks-Submerged	Green Navigation Buoy	-26

NOTES:
DRAWING NOT TO BE USED FOR NAVIGATION. ONLY CHANNEL CONDITION AT DATE OF SURVEY.
THE LOCATION OF ALL NAVIGATION AIDS ARE BASED ON INFORMATION PROVIDED BY THE U.S. COAST GUARD.
BUOY LOCATIONS REPRESENT THE POSITION OF THE SINKER ONLY.

SOUNDINGS WERE TAKEN BY FATHOMETER AND ARE SHOWN TO THE NEAREST TENTH OF A FOOT.

SOUNDINGS ARE BASED ON THE DATUM OF MEAN LOWER LOW WATER AT THE LOCALITY.

NORTH AMERICAN DATUM OF 1983 (NAD83), PROJECTED TO THE STATE PLANE COORDINATE SYSTEM (SPCS), CA ZONE II (0402). DISTANCE UNITS IN U.S. SURVEY FEET.

PLANE GRID AND COORDINATES ARE BASED ON LAMBERT PROJECTION, NAD 83, ZONE II CALIFORNIA AS DESCRIBED IN SPECIAL PUBLICATION NO. 235, PUBLISHED BY THE NATIONAL OCEAN SURVEY.


PROJECT DEPTH: -30'
VERTICAL DATUM: MLLW


THE LOCATION OF NAVIGATION AIDS ARE BASED ON AND PROVIDED BY THE U.S. COAST GUARD

CONTROLS:
LOCATION: RIO VISTA
NOAA STATION: 9415316
BENCHMARK: 5316 B 1996 (NO PID)
TIDE GAUGE: NAIL @ 8.2 FT MLLW
METADATA: NAIL SET BY USACE 31 MARCH, 2014

LOCATION: PORT OF WEST SACRAMENTO
NOAA STATION: 9416131
BENCHMARK: POWS1 (NO PID)
TIDE GAUGE: NAIL @ 10.0 FT MLLW
METADATA: NAIL SET BY USACE 8 APRIL, 2014

ALL HORIZONTAL POSITIONS AND MLLW ELEVATIONS WERE POST-PROCESSED USING PUBLIC GPS REFERENCE STATIONS IN THE AREA.

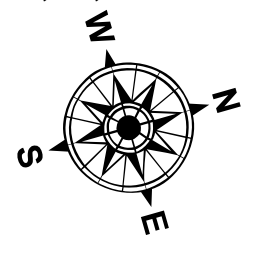

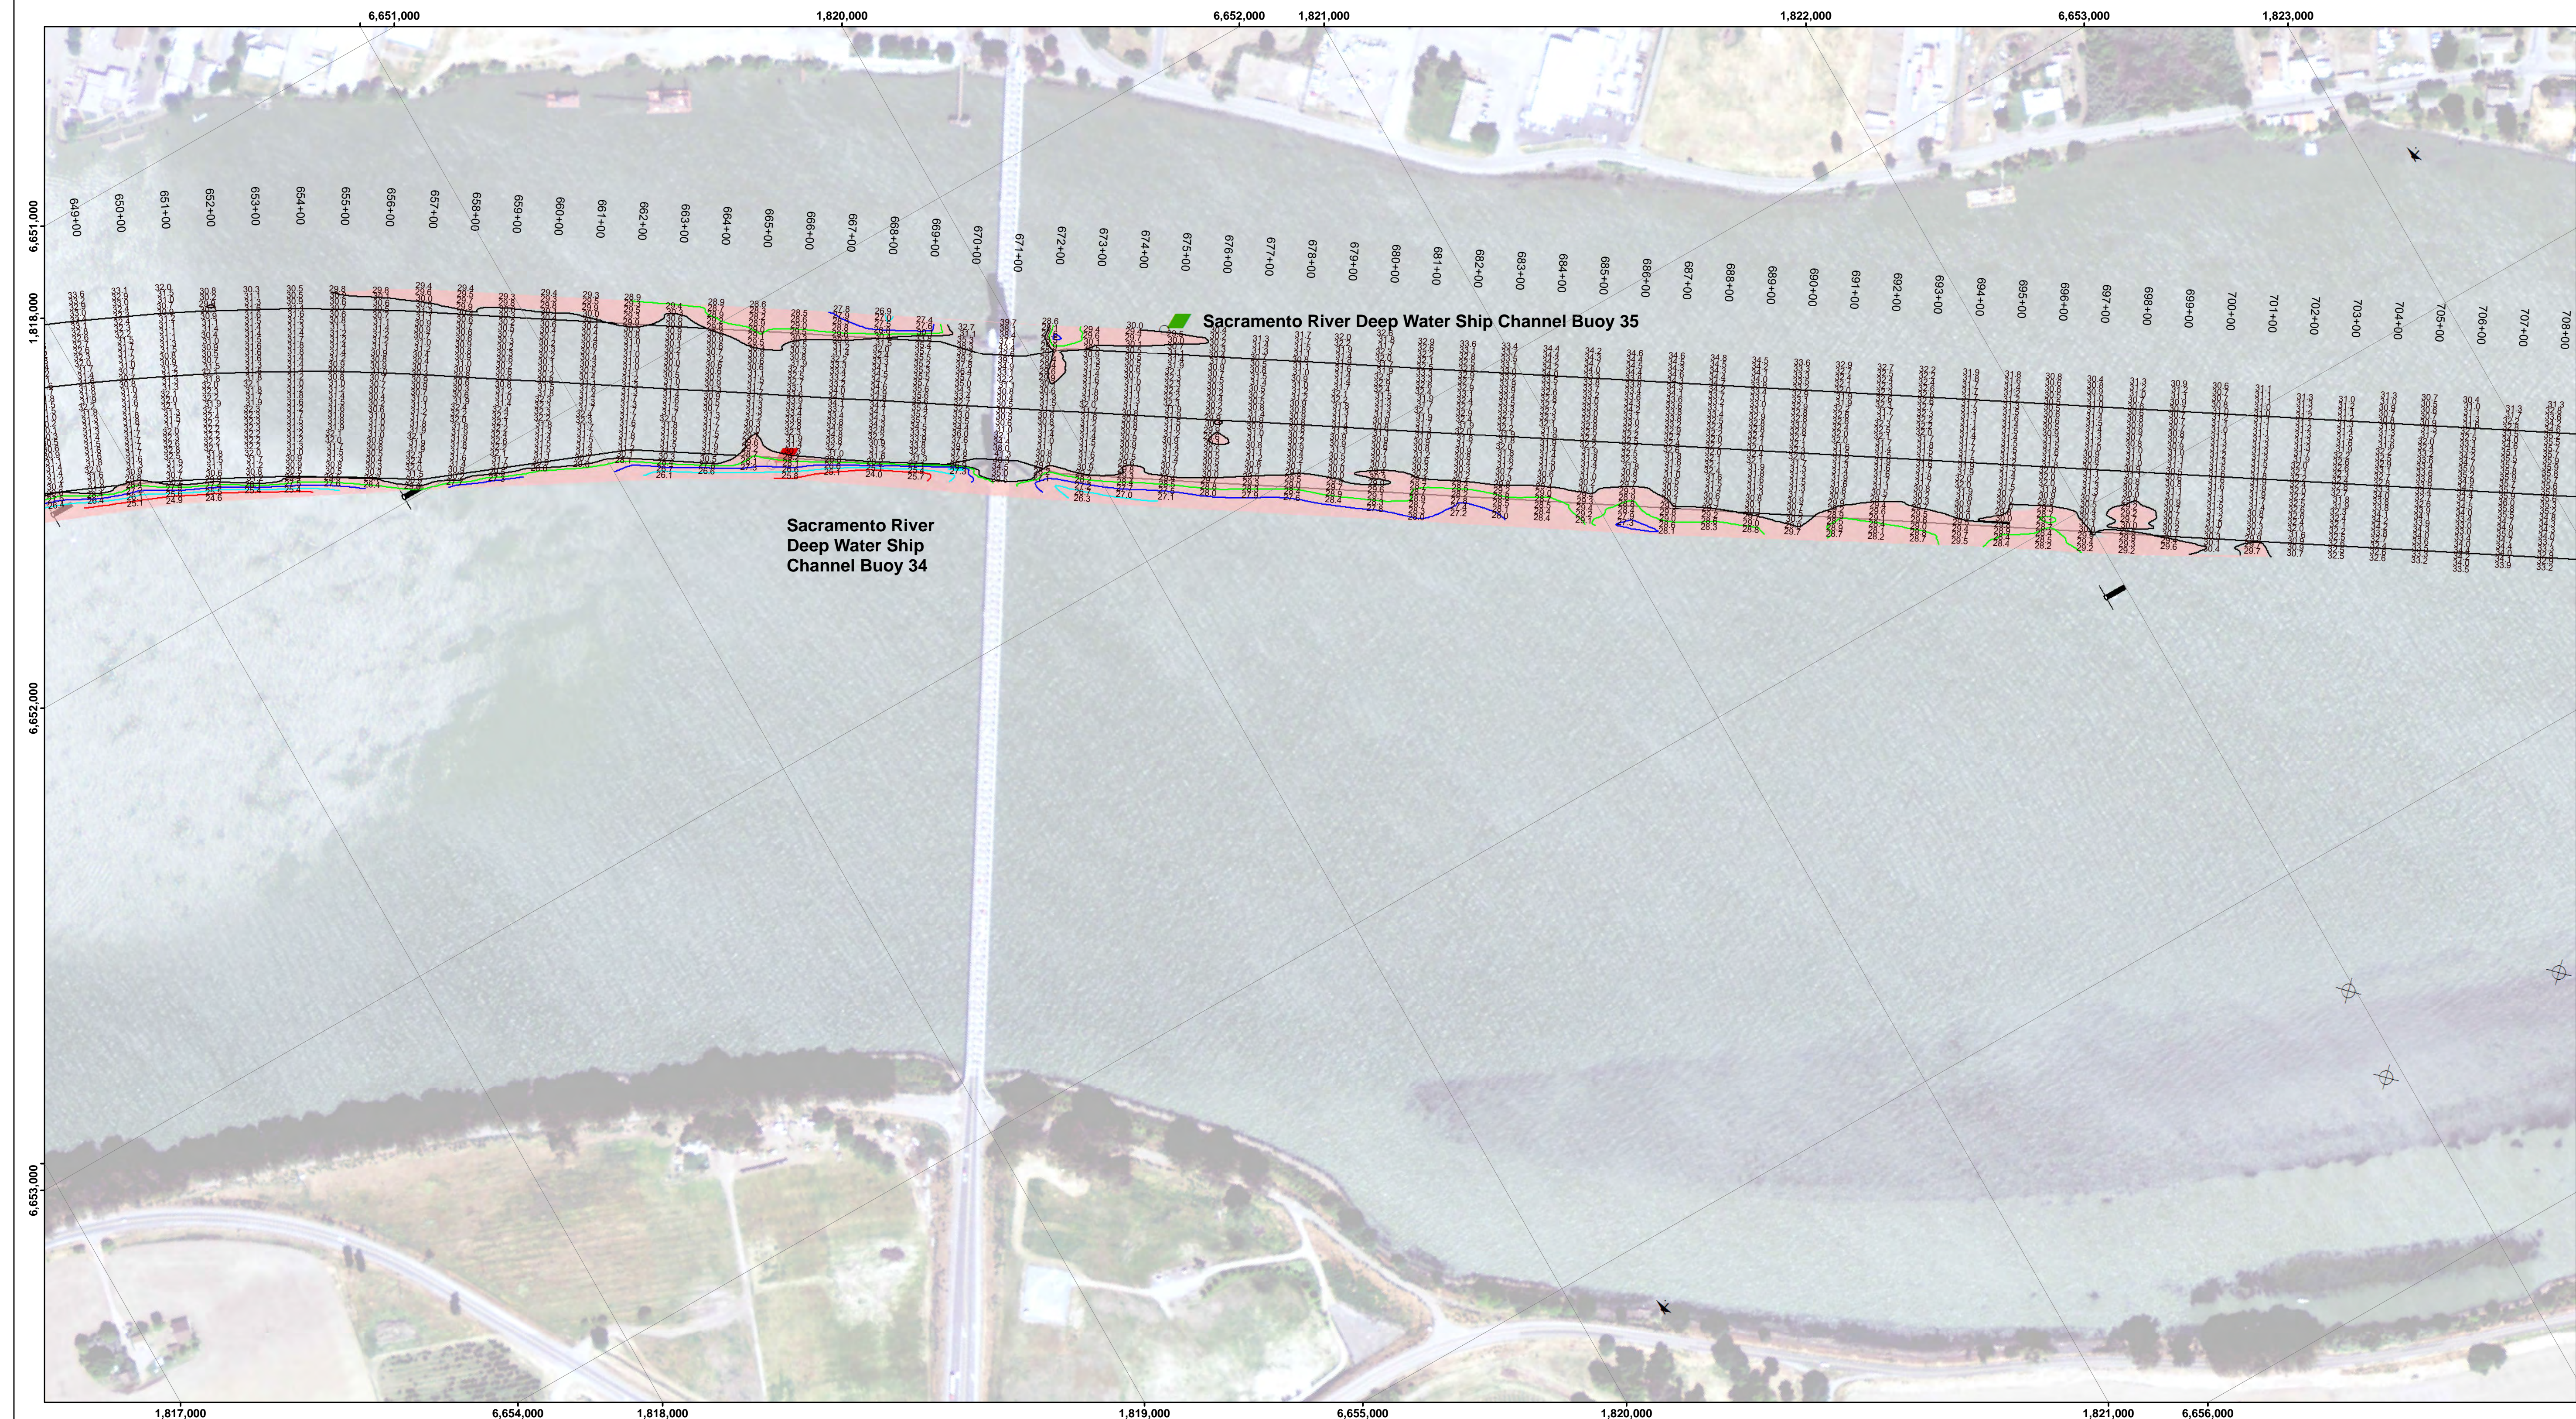


DISCLAIMER: The United States Government furnishes these data and the use thereof is for the specific purposes expressed or implied concerning the accuracy, completeness, information and the data furnished. The United States shall be under no liability whatsoever to any person by reason of any use of these data in any manner other than that for which they were prepared. The recipient may not transfer these data to others without also transferring this Disclaimer.

DISTRIBUTION STATEMENT: This data represents the results of data collection/processing for a specific US Army Corps of Engineers project. It is not to be used for any other project, time and accuracy applications. The user is responsible for the results of any of the application of the data for other than its intended purposes.

Chart Date:	Mar 12, 2018
Designed by:	PDT
Drawn by:	PDT
Surveyed By:	PDT
Plotted By:	PDT
Checked By:	PDT
Approved:	Chief, Hydro Survey Section
Approved:	Chief, Construction Branch

CALIFORNIA
 SAN JOAQUIN COUNTY
SACRAMENTO RIVER
 CONDITION SURVEY
 21, 25, 27-28 FEBRUARY 2018

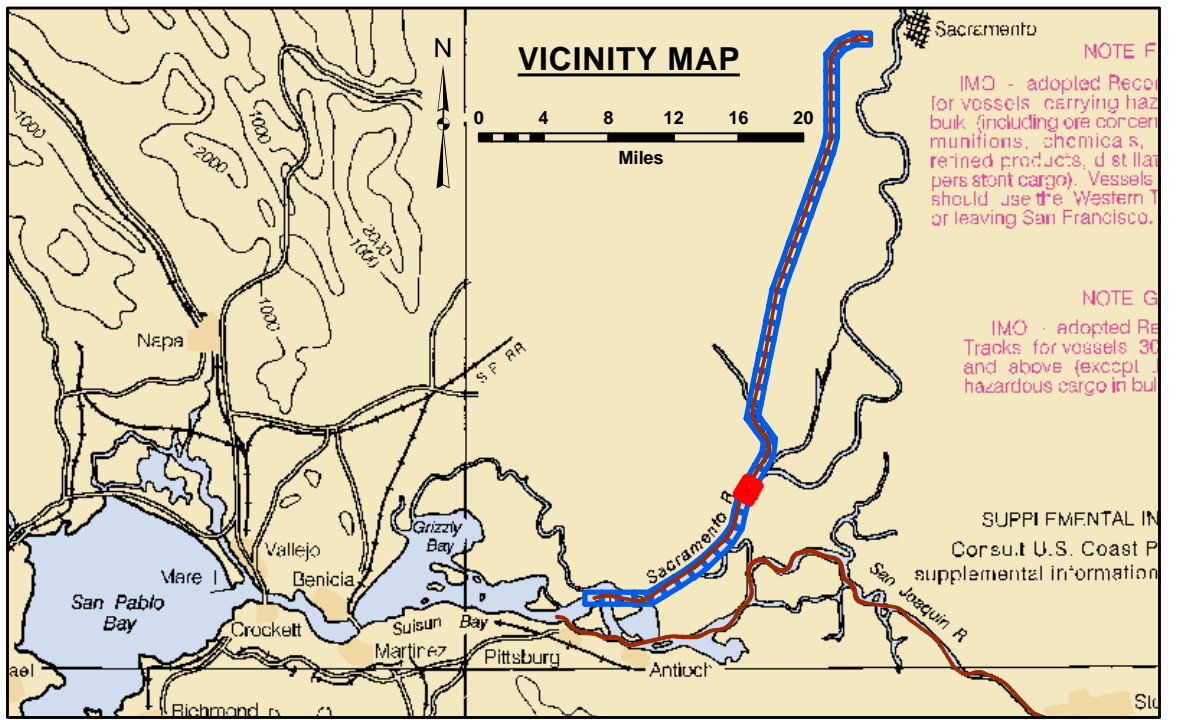

Feet
0 400 800 1,200

--- Federal Navigation Channel	▨ Cable Area	■ Shoaling Area	— Contours
— Federal Navigation Center Line	□ Placement Area	● Shoalest Sounding**	— -30
..... Cable Submarine	▨ Anchorage Area	⊥ Beacon, General	— -29
- - - Cable Overhead	⊗ Obstruction Point	◆ Red Navigation Buoy	— -28
— Contour Line	✦ Wrecks-Submerged	◆ Green Navigation Buoy	— -27
			— -26

NOTES:
 DRAWING NOT TO BE USED FOR NAVIGATION. ONLY CHANNEL CONDITION AT DATE OF SURVEY.
 THE LOCATION OF ALL NAVIGATION AIDS ARE BASED ON INFORMATION PROVIDED BY THE U.S. COAST GUARD.
 BUOY LOCATIONS REPRESENT THE POSITION OF THE SINKER ONLY.

SOUNDINGS WERE TAKEN BY FATHOMETER AND ARE SHOWN TO THE NEAREST TENTH OF A FOOT.

SOUNDINGS ARE BASED ON THE DATUM OF MEAN LOWER LOW WATER AT THE LOCALITY.

NORTH AMERICAN DATUM OF 1983 (NAD83), PROJECTED TO THE STATE PLANE COORDINATE SYSTEM (SPCS), CA ZONE II (0402). DISTANCE UNITS IN U.S. SURVEY FEET.

PLANE GRID AND COORDINATES ARE BASED ON LAMBERT PROJECTION, NAD 83, ZONE II CALIFORNIA AS DESCRIBED IN SPECIAL PUBLICATION NO. 235, PUBLISHED BY THE NATIONAL OCEAN SURVEY.

PROJECT DEPTH: -30'
 VERTICAL DATUM: MLLW

THE LOCATION OF NAVIGATION AIDS ARE BASED ON AND PROVIDED BY THE U.S. COAST GUARD

CONTROLS:
 LOCATION: RIO VISTA
 NOAA STATION: 9415316
 BENCHMARK: 5316 B 1996 (NO PID)
 TIDE GAUGE: NAIL @ 8.2 FT MLLW
 METADATA: NAIL SET BY USACE 31 MARCH, 2014

LOCATION: PORT OF WEST SACRAMENTO
 NOAA STATION: 9416131
 BENCHMARK: POWS1 (NO PID)
 TIDE GAUGE: NAIL @ 10.0 FT MLLW
 METADATA: NAIL SET BY USACE 8 APRIL, 2014

ALL HORIZONTAL POSITIONS AND MLLW ELEVATIONS WERE POST-PROCESSED USING PUBLIC GPS REFERENCE STATIONS IN THE AREA.








Chart Date:	Mar 12, 2018
Plotted By:	PDT
Checked By:	PDT
Designed By:	PDT
Drawn By:	PDT

SACRAMENTO RIVER
CONDITION SURVEY
21, 25, 27-28 FEBRUARY 2018

Sheet Reference Number
15 of 45

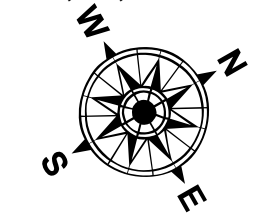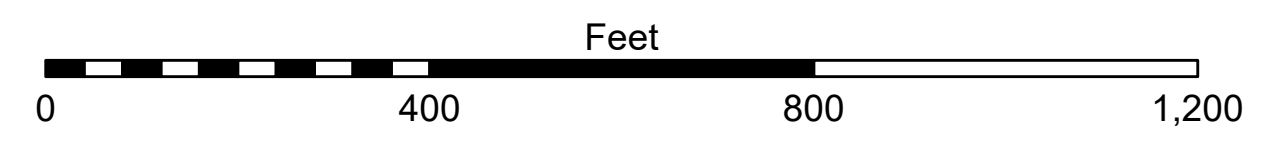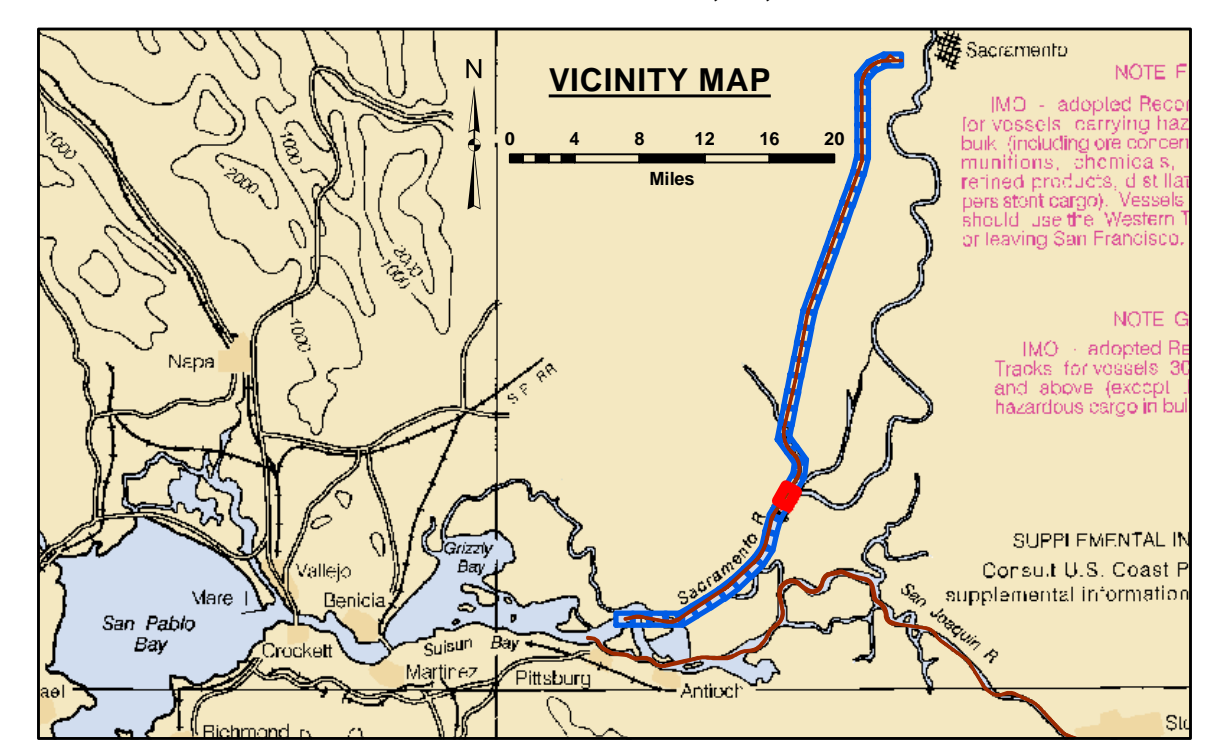

LEGEND		Contours	
--- Federal Navigation Channel	▨ Cable Area	— -30	
— Federal Navigation Center Line	□ Placement Area	— -29	
⋯ Cable Submarine	⊠ Anchorage Area	— -28	
- - - Cable Overhead	⊗ Obstruction Point	— -27	
— Contour Line	✦ Wrecks-Submerged	— -26	
	● Shoaling Area		
	⬇ Beacon, General		
	◆ Red Navigation Buoy		
	◆ Green Navigation Buoy		

NOTES:
DRAWING NOT TO BE USED FOR NAVIGATION. ONLY CHANNEL CONDITION AT DATE OF SURVEY.
THE LOCATION OF ALL NAVIGATION AIDS ARE BASED ON INFORMATION PROVIDED BY THE U.S. COAST GUARD.
BUOY LOCATIONS REPRESENT THE POSITION OF THE SINKER ONLY.

SOUNDINGS WERE TAKEN BY FATHOMETER AND ARE SHOWN TO THE NEAREST TENTH OF A FOOT.

SOUNDINGS ARE BASED ON THE DATUM OF MEAN LOWER LOW WATER AT THE LOCALITY.

NORTH AMERICAN DATUM OF 1983 (NAD83), PROJECTED TO THE STATE PLANE COORDINATE SYSTEM (SPCS), CA ZONE II (0402). DISTANCE UNITS IN U.S. SURVEY FEET.

PLANE GRID AND COORDINATES ARE BASED ON LAMBERT PROJECTION, NAD 83, ZONE II CALIFORNIA AS DESCRIBED IN SPECIAL PUBLICATION NO. 235, PUBLISHED BY THE NATIONAL OCEAN SURVEY.


PROJECT DEPTH: -30'
VERTICAL DATUM: MLLW

THE LOCATION OF NAVIGATION AIDS ARE BASED ON AND PROVIDED BY THE U.S. COAST GUARD

CONTROLS:
LOCATION: RIO VISTA
NOAA STATION: 9415316
BENCHMARK: 5316 B 1996 (NO PID)
TIDE GAUGE: NAIL @ 8.2 FT MLLW
METADATA: NAIL SET BY USACE 31 MARCH, 2014

LOCATION: PORT OF WEST SACRAMENTO
NOAA STATION: 9416131
BENCHMARK: POWS1 (NO PID)
TIDE GAUGE: NAIL @ 10.0 FT MLLW
METADATA: NAIL SET BY USACE 8 APRIL, 2014

ALL HORIZONTAL POSITIONS AND MLLW ELEVATIONS WERE POST-PROCESSED USING PUBLIC GPS REFERENCE STATIONS IN THE AREA.



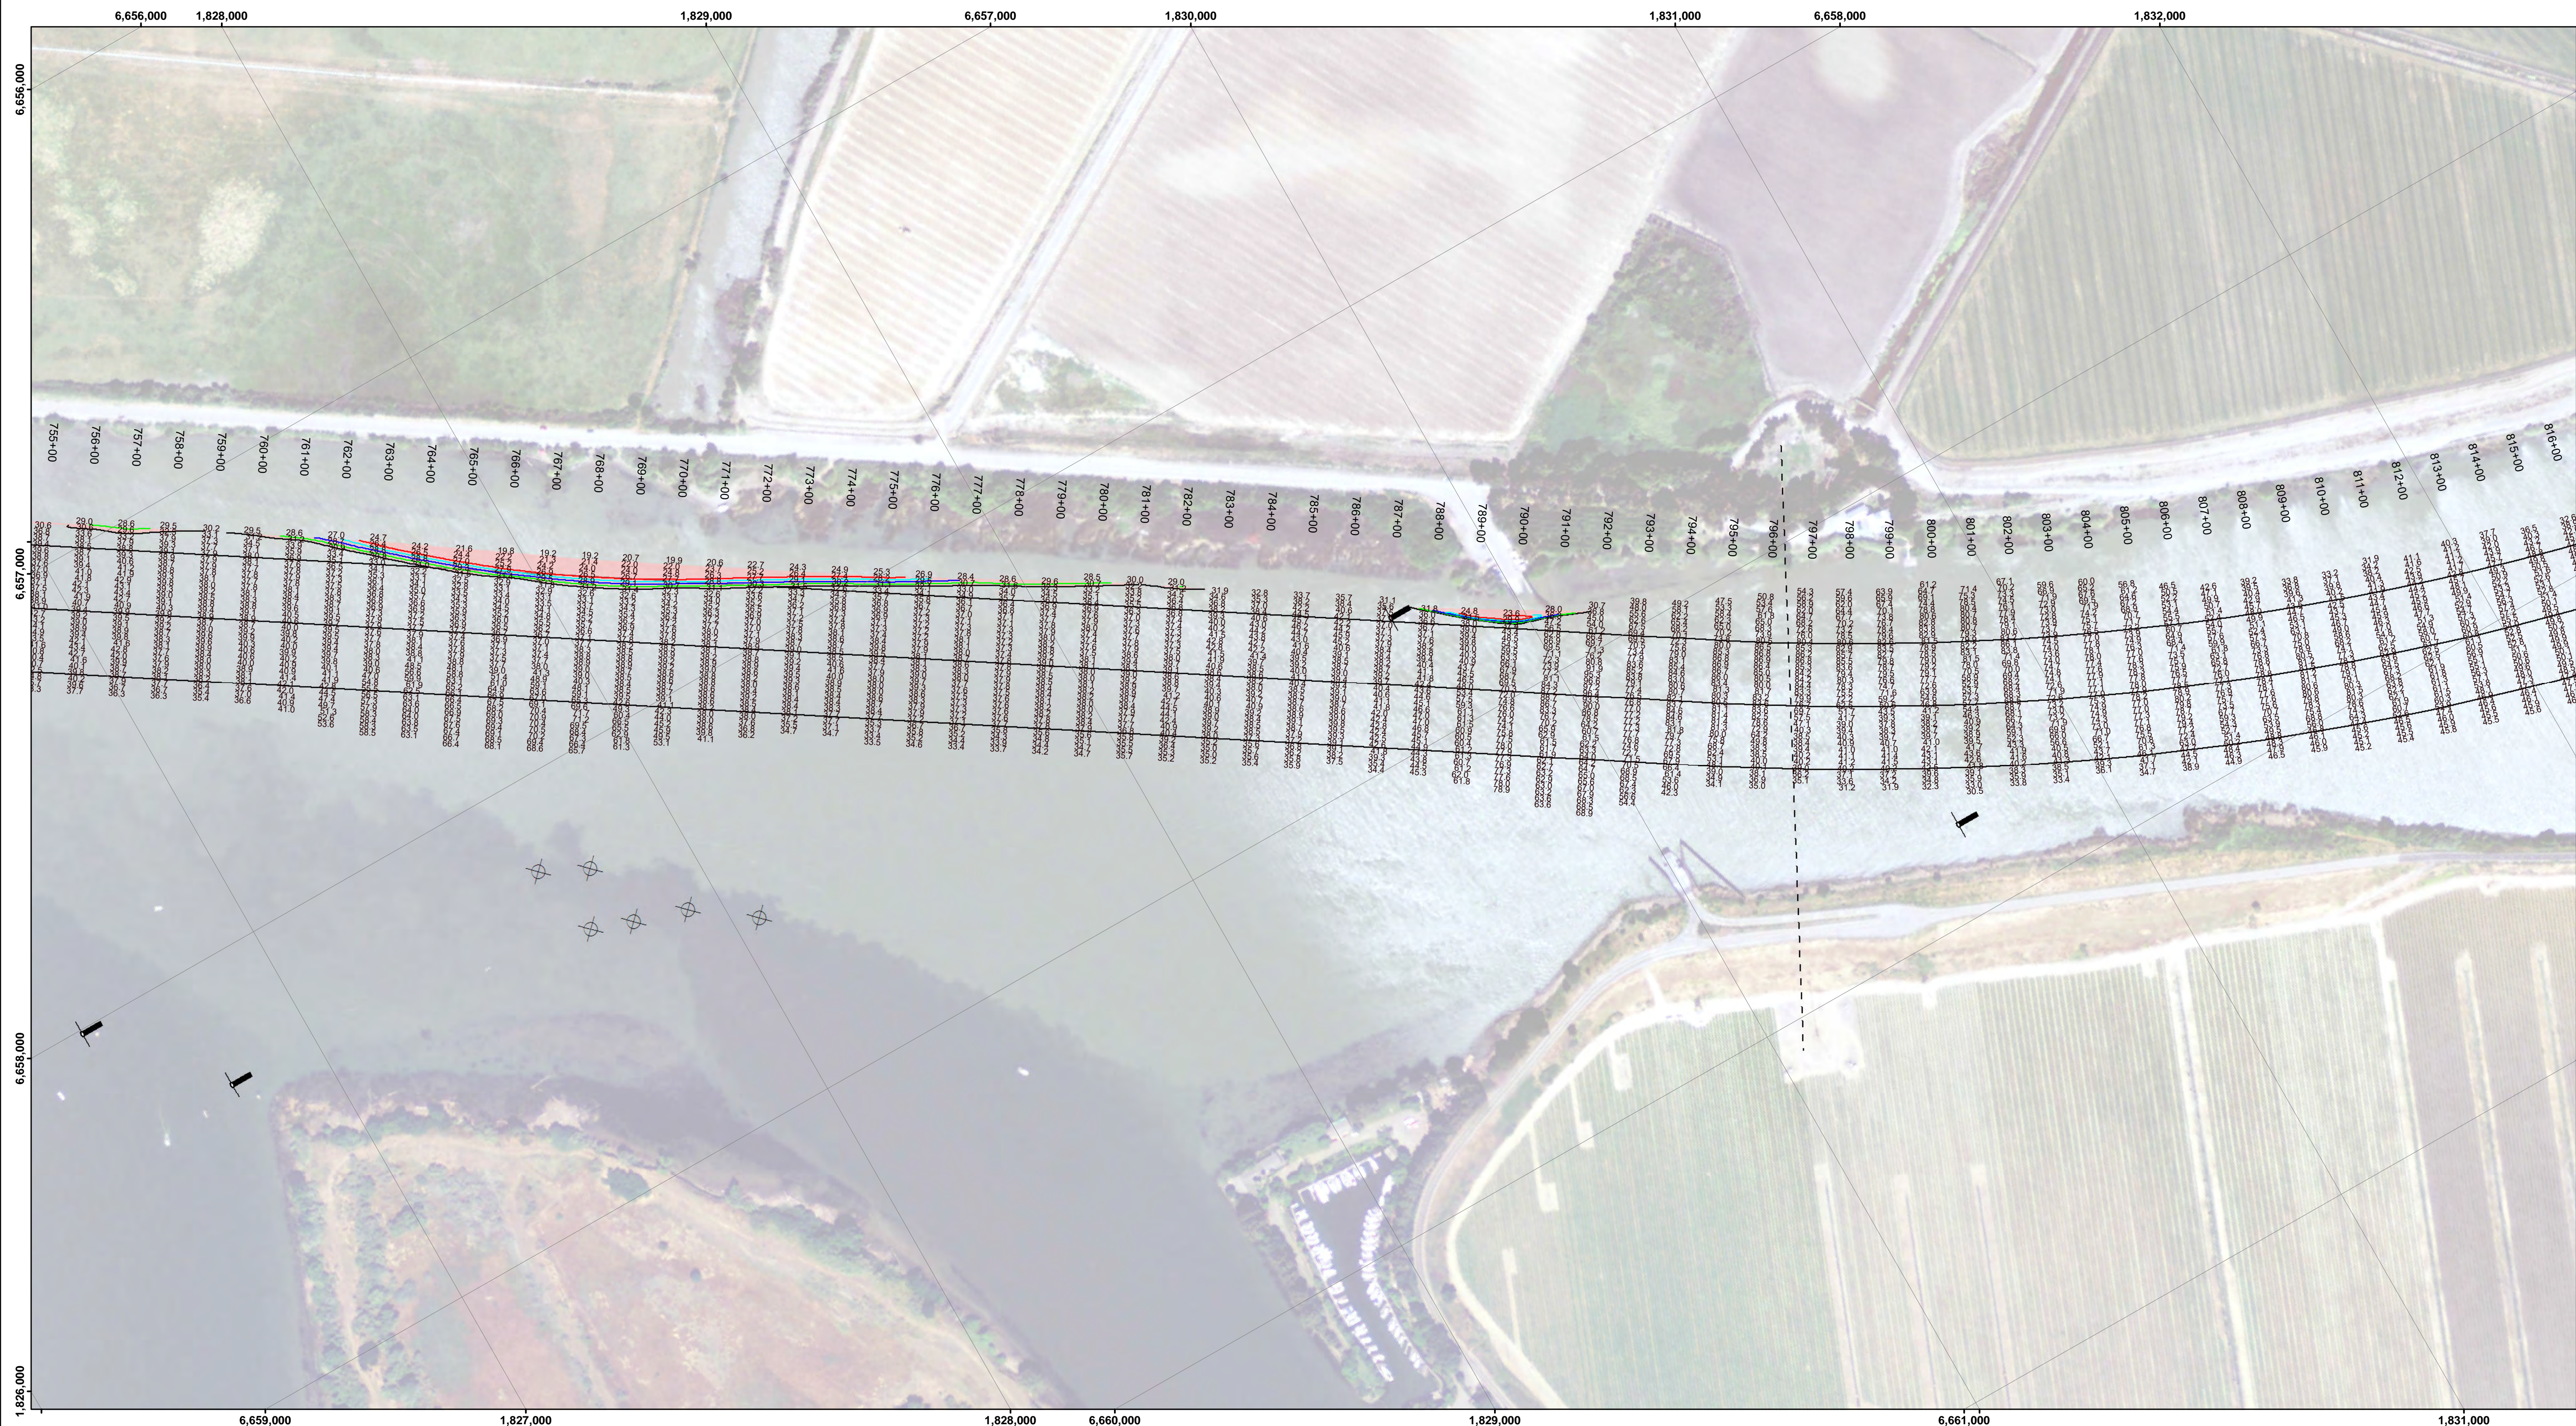


DISCLAIMER: The data represents the results of data collection/processing for a specific US Army Corps of Engineers project. It is not intended for use in any other project. Accuracy of the data is not guaranteed. The user is responsible for the results of any application of the data for other than its intended purpose.

ACCESS CONSTRAINTS: The United States Government furnishes this data and the results of its use to the recipient on a non-exclusive, non-transferable, and non-guaranteed basis. The recipient agrees not to reproduce, disseminate, or use the data for any purpose other than that for which it was provided. The recipient may not transfer this data to others without also transferring this Disclaimer.

Prepared Under the Direction of TRAVIS J. RAYFIELD LT Colonel, C.E., District Engineer	Chart Date: Mar 12, 2018
Standard: Hydro Survey Team Leader	Designed by: PDT
Recommended: Chief, Hydro Survey Section	Checked by: PDT
Approved: Chief, Construction Branch	Drawn by: PDT

CALIFORNIA
SAN JOAQUIN COUNTY
SACRAMENTO RIVER
CONDITION SURVEY
21, 25, 27-28 FEBRUARY 2018

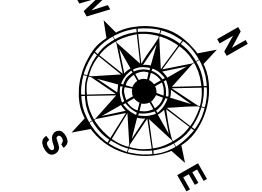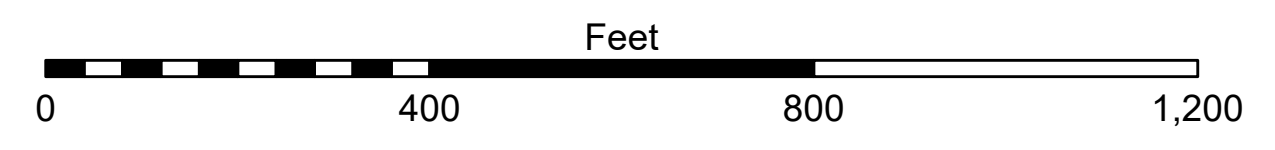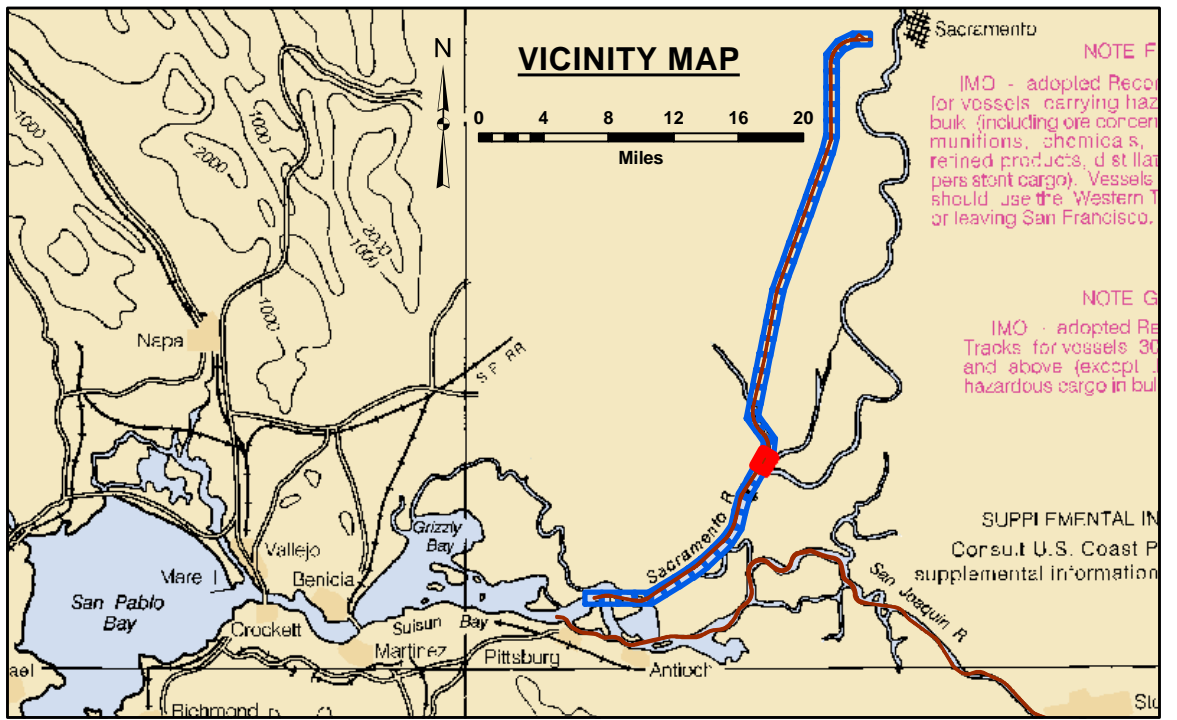

LEGEND		Contours	
--- Federal Navigation Channel	▨ Cable Area	— -30	
— Federal Navigation Center Line	□ Placement Area	— -29	
⋯ Cable Submarine	⊠ Anchorage Area	— -28	
- - - Cable Overhead	⊗ Obstruction Point	— -27	
— Contour Line	⚓ Wrecks-Submerged	— -26	
		● Shoalest Sounding**	
		⚓ Beacon, General	
		♦ Red Navigation Buoy	
		♦ Green Navigation Buoy	

NOTES:
DRAWING NOT TO BE USED FOR NAVIGATION. ONLY CHANNEL CONDITION AT DATE OF SURVEY.
THE LOCATION OF ALL NAVIGATION AIDS ARE BASED ON INFORMATION PROVIDED BY THE U.S. COAST GUARD.
BUOY LOCATIONS REPRESENT THE POSITION OF THE SINKER ONLY.

SOUNDINGS WERE TAKEN BY FATHOMETER AND ARE SHOWN TO THE NEAREST TENTH OF A FOOT.

SOUNDINGS ARE BASED ON THE DATUM OF MEAN LOWER LOW WATER AT THE LOCALITY.

NORTH AMERICAN DATUM OF 1983 (NAD83), PROJECTED TO THE STATE PLANE COORDINATE SYSTEM (SPCS), CA ZONE II (0402), DISTANCE UNITS IN U.S. SURVEY FEET.

PLANE GRID AND COORDINATES ARE BASED ON LAMBERT PROJECTION, NAD 83, ZONE II CALIFORNIA AS DESCRIBED IN SPECIAL PUBLICATION NO. 235, PUBLISHED BY THE NATIONAL OCEAN SURVEY.

PROJECT DEPTH: -30'


VERTICAL DATUM: MLLW

THE LOCATION OF NAVIGATION AIDS ARE BASED ON AND PROVIDED BY THE U.S. COAST GUARD

CONTROLS:
LOCATION: RIO VISTA
NOAA STATION: 9415316
BENCHMARK: 5316 B 1996 (NO PID)
TIDE GAUGE: NAIL @ 8.2 FT MLLW
METADATA: NAIL SET BY USACE 31 MARCH, 2014

LOCATION: PORT OF WEST SACRAMENTO
NOAA STATION: 9416131
BENCHMARK: POWS1 (NO PID)
TIDE GAUGE: NAIL @ 10.0 FT MLLW
METADATA: NAIL SET BY USACE 8 APRIL, 2014

ALL HORIZONTAL POSITIONS AND MLLW ELEVATIONS WERE POST-PROCESSED USING PUBLIC GPS REFERENCE STATIONS IN THE AREA.



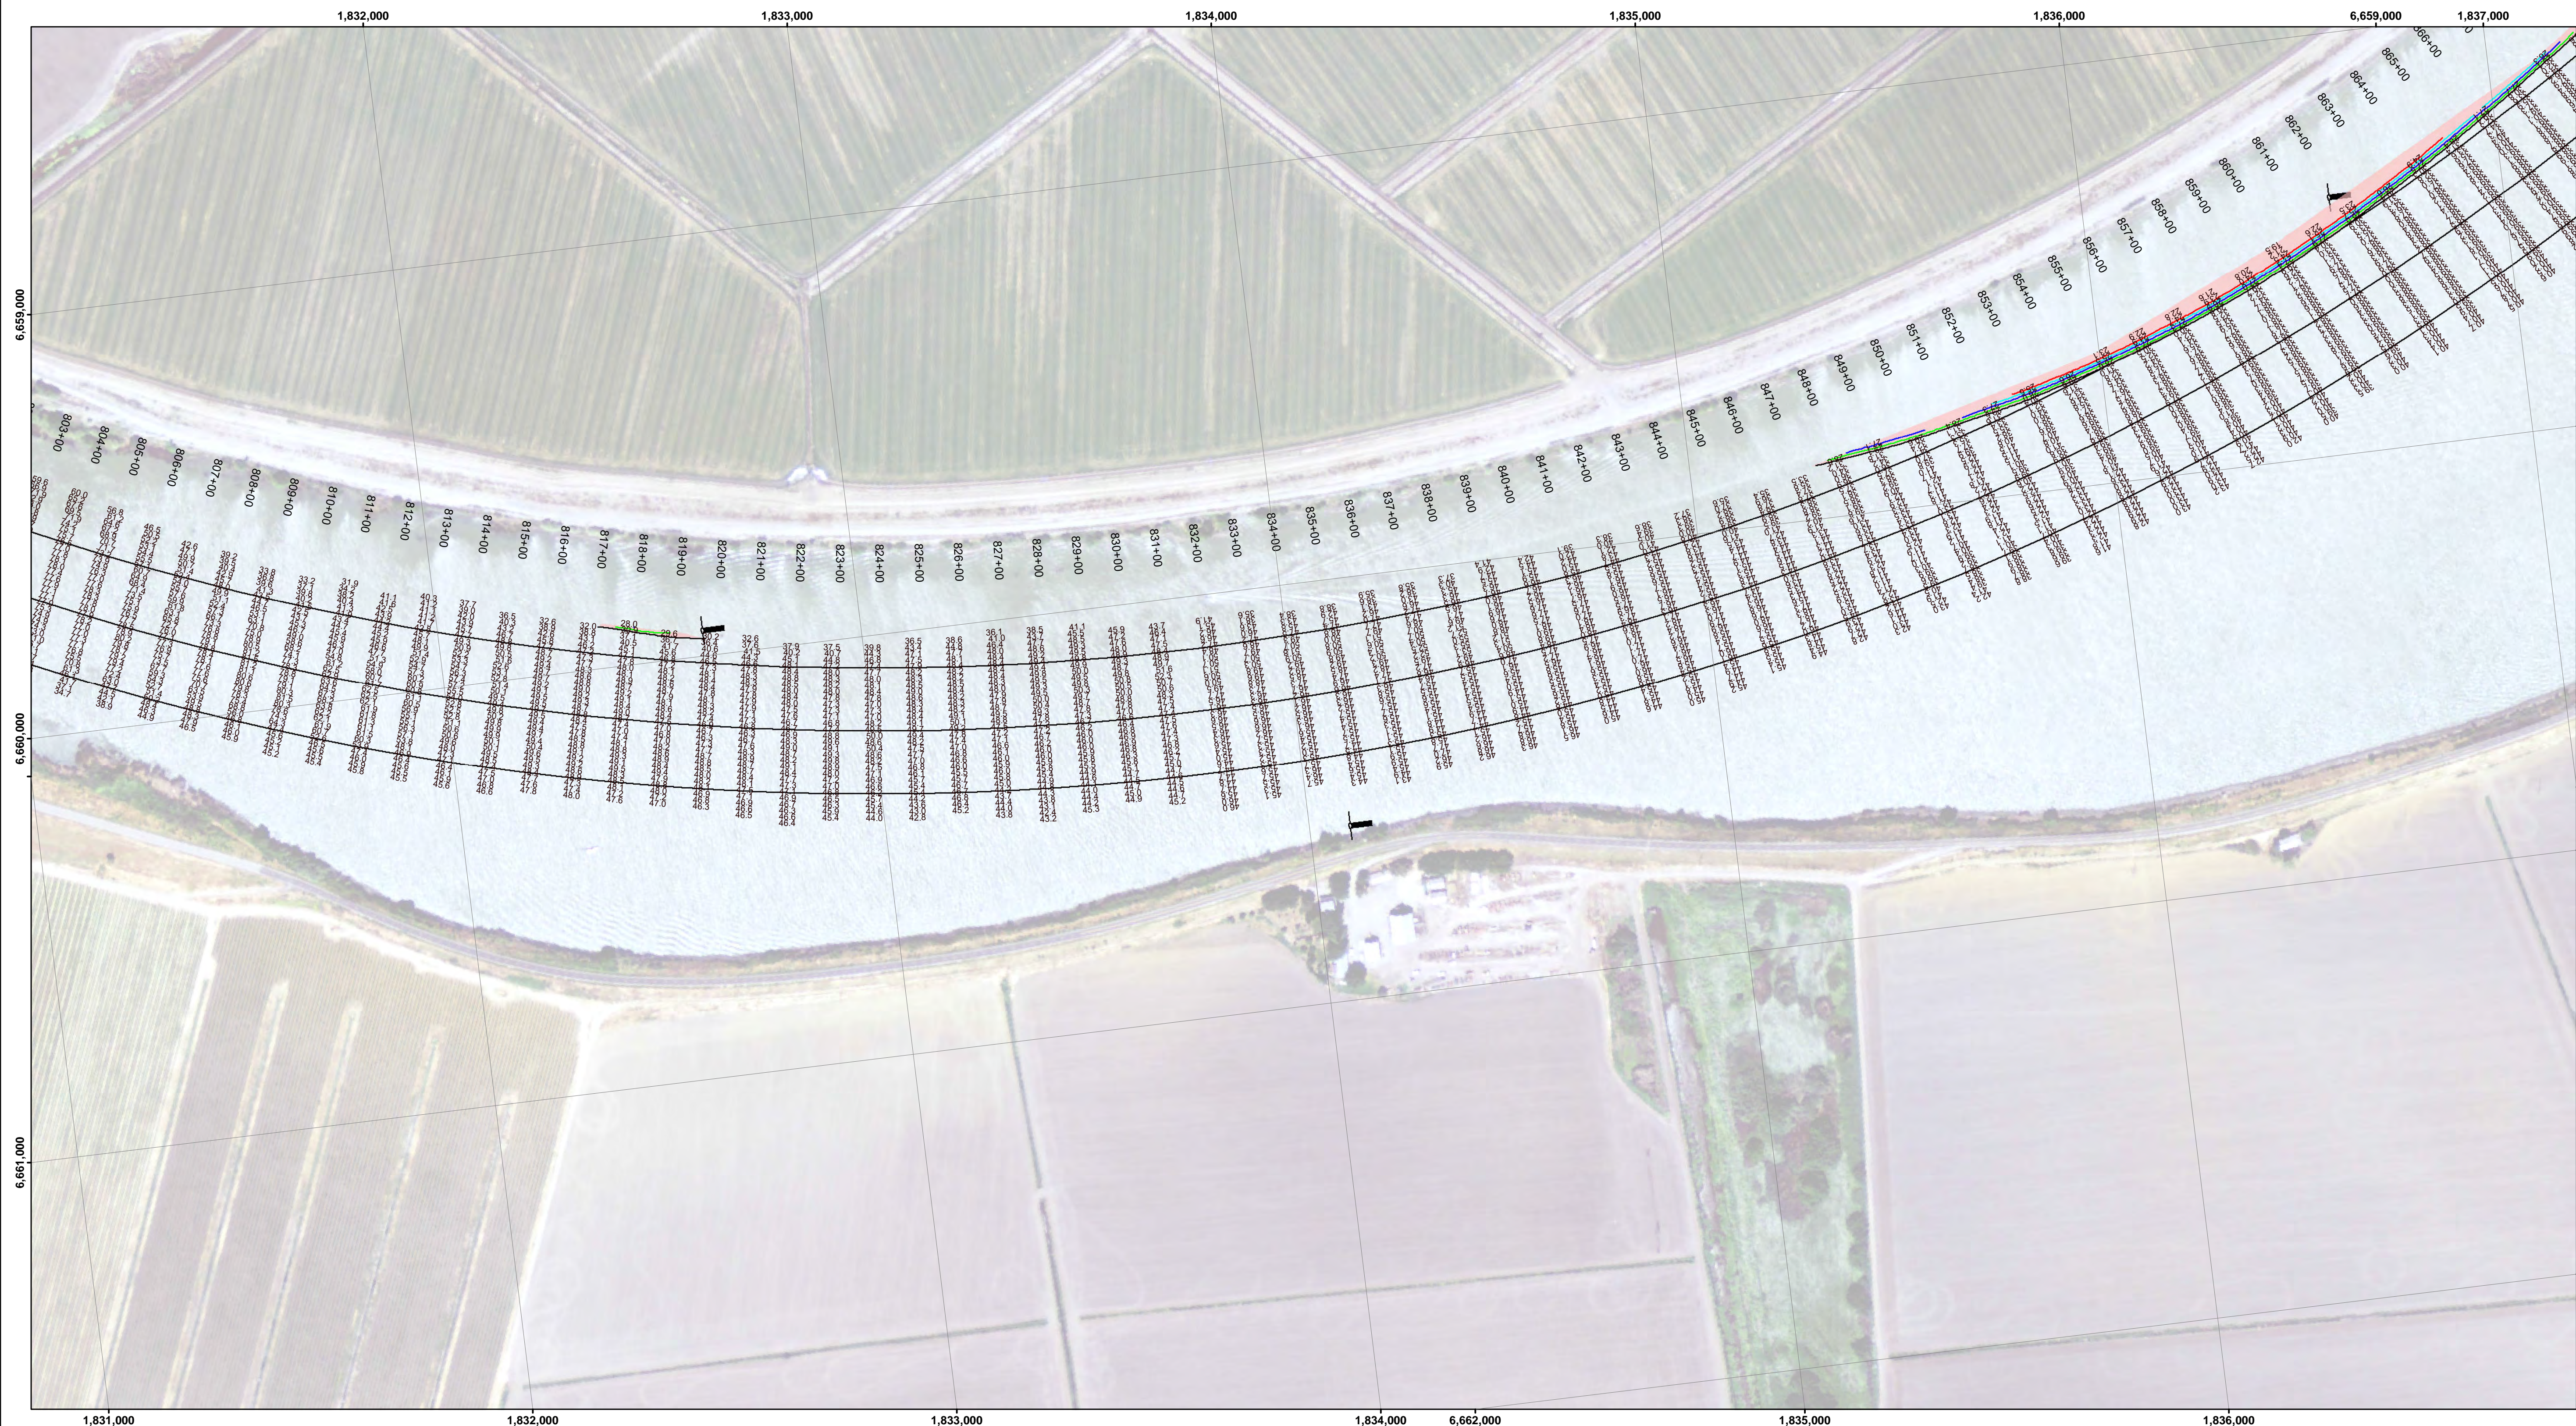


DISCLAIMER: The United States Government furnishes these data and the results of the survey and does not warrant, express or implied, concerning the accuracy, completeness, or reliability of the data furnished. The user is responsible for the results of any application of the data for other than its intended purpose.

Access Constraints: The United States Government furnishes these data and the results of the survey and does not warrant, express or implied, concerning the accuracy, completeness, or reliability of the data furnished. The user is responsible for the results of any application of the data for other than its intended purpose.

Prepared Under the Direction of TRAVIS J. RAYFIELD LT Colonel, C.E., District Engineer	Chart Date: Mar 12, 2018
Surveyed By: Hydro Survey Team Leader	Designed by: PDT
Plotted By: Chief, Hydro Survey Section	Checked by: PDT
Approved: Chief, Construction Branch	Drawn by: PDT

CALIFORNIA
SACRAMENTO RIVER
CONDITION SURVEY
21, 25, 27-28 FEBRUARY 2018

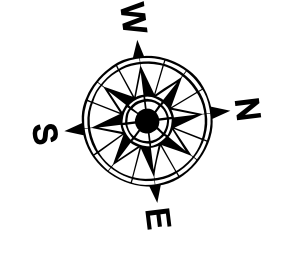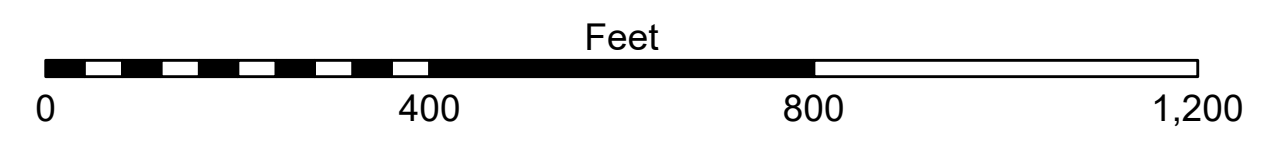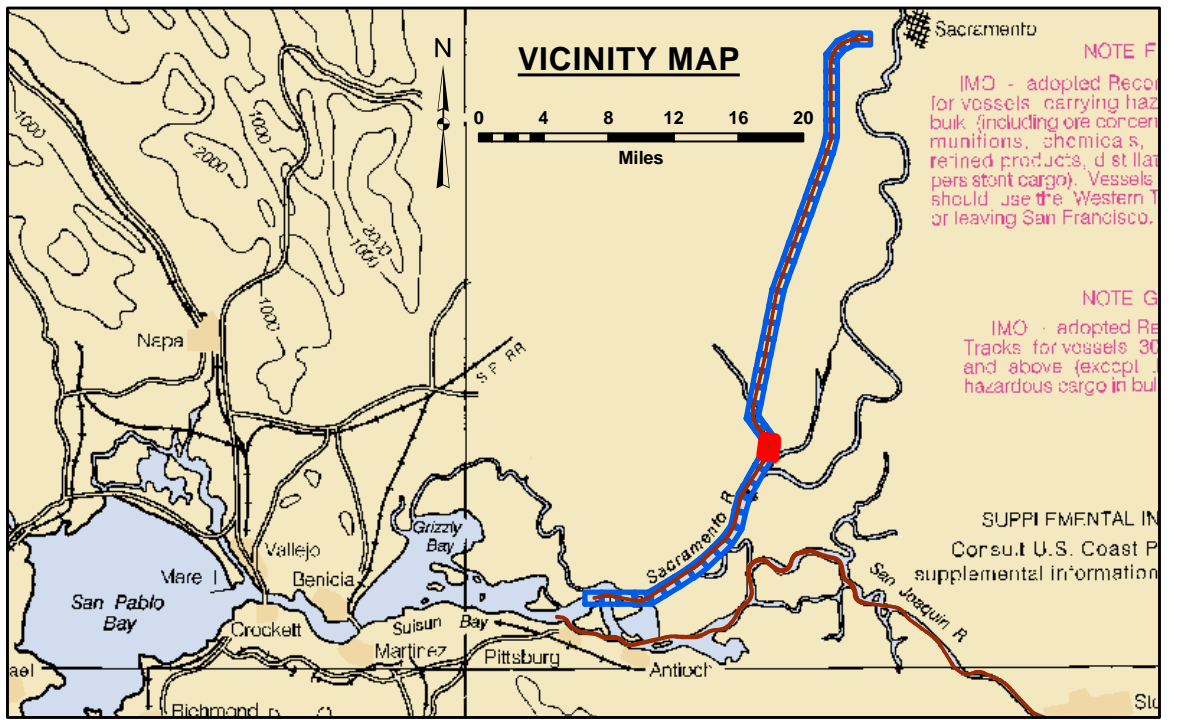

LEGEND			
--- Federal Navigation Channel	[Hatched Box] Cable Area	[Pink Box] Shoaling Area	[Black Line] Contours -30
— Federal Navigation Center Line	[White Box] Placement Area	[Yellow Dot] Shoalest Sounding**	[Green Line] Contours -29
..... Cable Submarine	[Dashed Box] Anchorage Area	[Tall Black Post] Beacon, General	[Blue Line] Contours -28
- - - Cable Overhead	[X in Box] Obstruction Point	[Red Diamond] Red Navigation Buoy	[Cyan Line] Contours -27
— Contour Line	[Star in Box] Wrecks-Submerged	[Green Diamond] Green Navigation Buoy	[Red Line] Contours -26

NOTES:
DRAWING NOT TO BE USED FOR NAVIGATION. ONLY CHANNEL CONDITION AT DATE OF SURVEY.
THE LOCATION OF ALL NAVIGATION AIDS ARE BASED ON INFORMATION PROVIDED BY THE U.S. COAST GUARD.
BUOY LOCATIONS REPRESENT THE POSITION OF THE SINKER ONLY.

SOUNDINGS WERE TAKEN BY FATHOMETER AND ARE SHOWN TO THE NEAREST TENTH OF A FOOT.

SOUNDINGS ARE BASED ON THE DATUM OF MEAN LOWER LOW WATER AT THE LOCALITY.

NORTH AMERICAN DATUM OF 1983 (NAD83), PROJECTED TO THE STATE PLANE COORDINATE SYSTEM (SPCS), CA ZONE II (0402). DISTANCE UNITS IN U.S. SURVEY FEET.

PLANE GRID AND COORDINATES ARE BASED ON LAMBERT PROJECTION, NAD 83, ZONE II CALIFORNIA AS DESCRIBED IN SPECIAL PUBLICATION NO. 235, PUBLISHED BY THE NATIONAL OCEAN SURVEY.


PROJECT DEPTH: -30'
VERTICAL DATUM: MLLW

THE LOCATION OF NAVIGATION AIDS ARE BASED ON AND PROVIDED BY THE U.S. COAST GUARD

CONTROLS:
LOCATION: RIO VISTA
NOAA STATION: 9415316
BENCHMARK: 5316 B 1996 (NO PID)
TIDE GAUGE: NAIL @ 8.2 FT MLLW
METADATA: NAIL SET BY USACE 31 MARCH, 2014

LOCATION: PORT OF WEST SACRAMENTO
NOAA STATION: 9416131
BENCHMARK: POWS1 (NO PID)
TIDE GAUGE: NAIL @ 10.0 FT MLLW
METADATA: NAIL SET BY USACE 8 APRIL, 2014

ALL HORIZONTAL POSITIONS AND MLLW ELEVATIONS WERE POST-PROCESSED USING PUBLIC GPS REFERENCE STATIONS IN THE AREA.

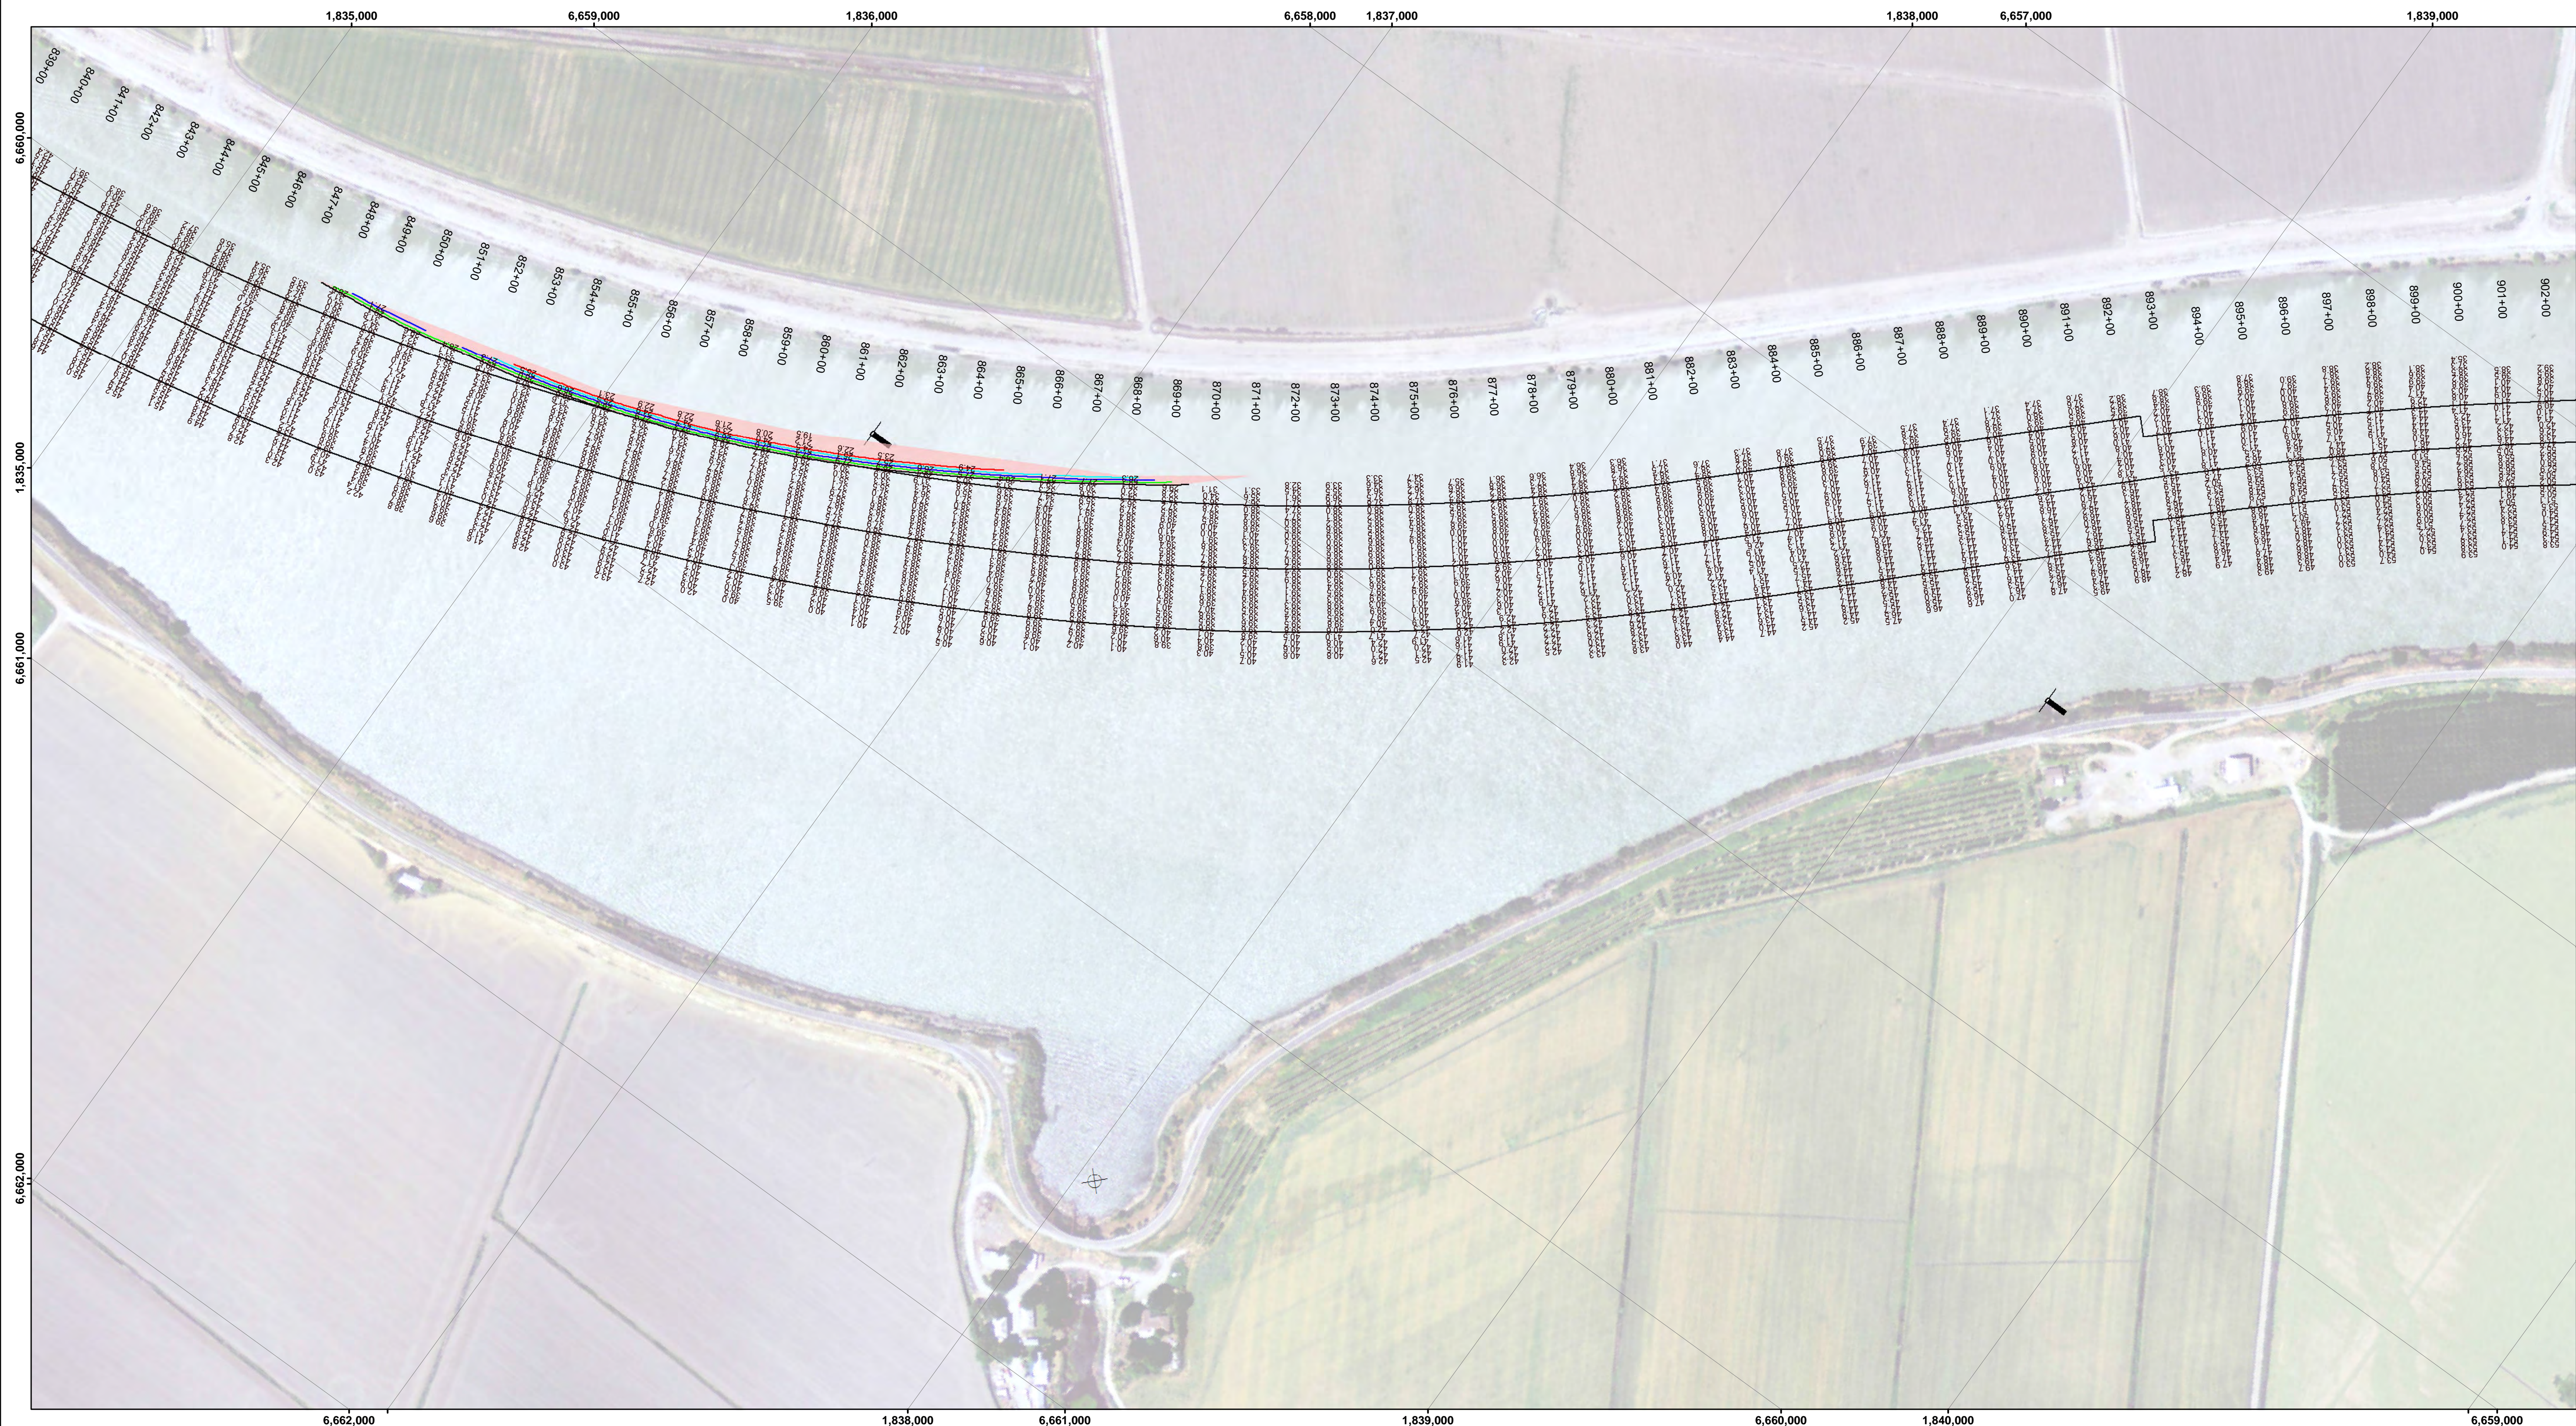




DISCLAIMER: The United States Government furnishes these data and the results of the processing of these data as they are received from the contractor. The contractor is not responsible for the results of any application of the data for other than the intended purpose. The user is responsible for the results of any application of the data for other than the intended purpose.

Access Constraints: The United States Government furnishes these data and the results of the processing of these data as they are received from the contractor. The contractor is not responsible for the results of any application of the data for other than the intended purpose. The user is responsible for the results of any application of the data for other than the intended purpose.

Prepared Under the Direction of TRAVIS J. RAYFIELD LT COLONEL, C.E., DISTRICT ENGINEER	Chart Date: Mar 12, 2018
Submitted: Hydro Survey Team Leader	Designed by: PDT
Recommended: Chief, Hydro Survey Section	Drawn by: PDT
Approved: Chief, Construction Branch	

CALIFORNIA
SACRAMENTO RIVER
CONDITION SURVEY
21, 25, 27-28 FEBRUARY 2018

Sheet
Reference
Number
18 of 45

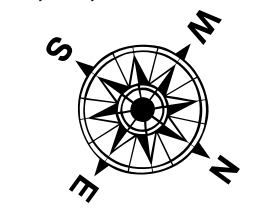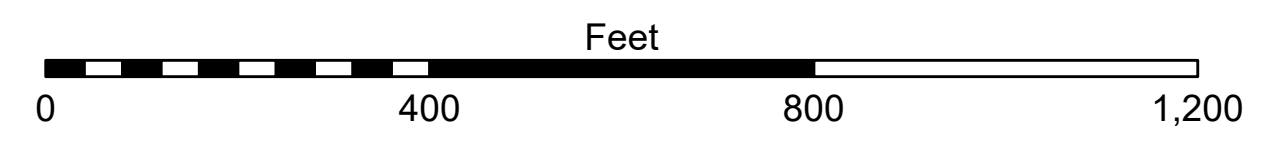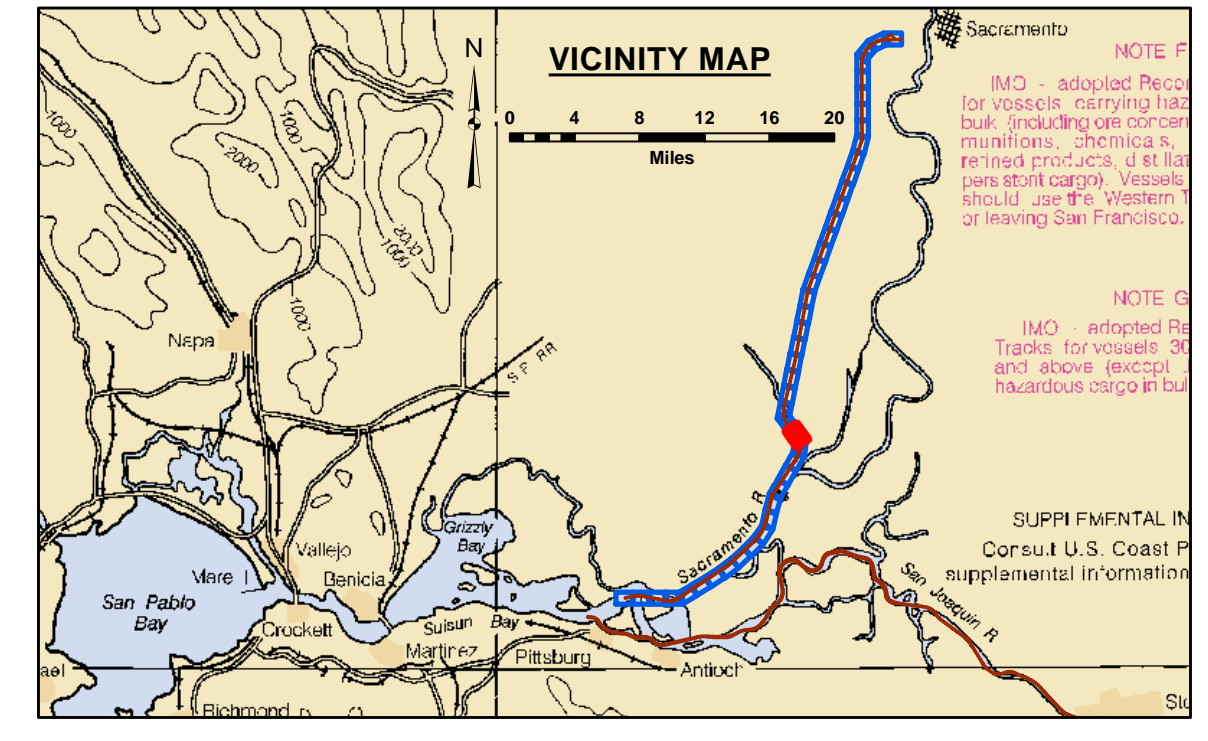

LEGEND		Contours	
--- Federal Navigation Channel	▨ Cable Area	— -30	
— Federal Navigation Center Line	□ Placement Area	— -29	
..... Cable Submarine	⊠ Anchorage Area	— -28	
- - - Cable Overhead	⊗ Obstruction Point	— -27	
— Contour Line	✦ Wrecks-Submerged	— -26	
	● Shoaling Area		
	⬇ Beacon, General		
	◆ Red Navigation Buoy		
	◆ Green Navigation Buoy		

NOTES:
DRAWING NOT TO BE USED FOR NAVIGATION. ONLY CHANNEL CONDITION AT DATE OF SURVEY.
THE LOCATION OF ALL NAVIGATION AIDS ARE BASED ON INFORMATION PROVIDED BY THE U.S. COAST GUARD.
BUOY LOCATIONS REPRESENT THE POSITION OF THE SINKER ONLY.

SOUNDINGS WERE TAKEN BY FATHOMETER AND ARE SHOWN TO THE NEAREST TENTH OF A FOOT.

SOUNDINGS ARE BASED ON THE DATUM OF MEAN LOWER LOW WATER AT THE LOCALITY.

NORTH AMERICAN DATUM OF 1983 (NAD83), PROJECTED TO THE STATE PLANE COORDINATE SYSTEM (SPCS), CA ZONE II (0402). DISTANCE UNITS IN U.S. SURVEY FEET.

PLANE GRID AND COORDINATES ARE BASED ON LAMBERT PROJECTION, NAD 83, ZONE II CALIFORNIA AS DESCRIBED IN SPECIAL PUBLICATION NO. 235, PUBLISHED BY THE NATIONAL OCEAN SURVEY.

PROJECT DEPTH: -30'


VERTICAL DATUM: MLLW

THE LOCATION OF NAVIGATION AIDS ARE BASED ON AND PROVIDED BY THE U.S. COAST GUARD

CONTROLS:
LOCATION: RIO VISTA
NOAA STATION: 9415316
BENCHMARK: 5316 B 1996 (NO PID)
TIDE GAUGE: NAIL @ 8.2 FT MLLW
METADATA: NAIL SET BY USACE 31 MARCH, 2014

LOCATION: PORT OF WEST SACRAMENTO
NOAA STATION: 9416131
BENCHMARK: POWS1 (NO PID)
TIDE GAUGE: NAIL @ 10.0 FT MLLW
METADATA: NAIL SET BY USACE 8 APRIL, 2014

ALL HORIZONTAL POSITIONS AND MLLW ELEVATIONS WERE POST-PROCESSED USING PUBLIC GPS REFERENCE STATIONS IN THE AREA.

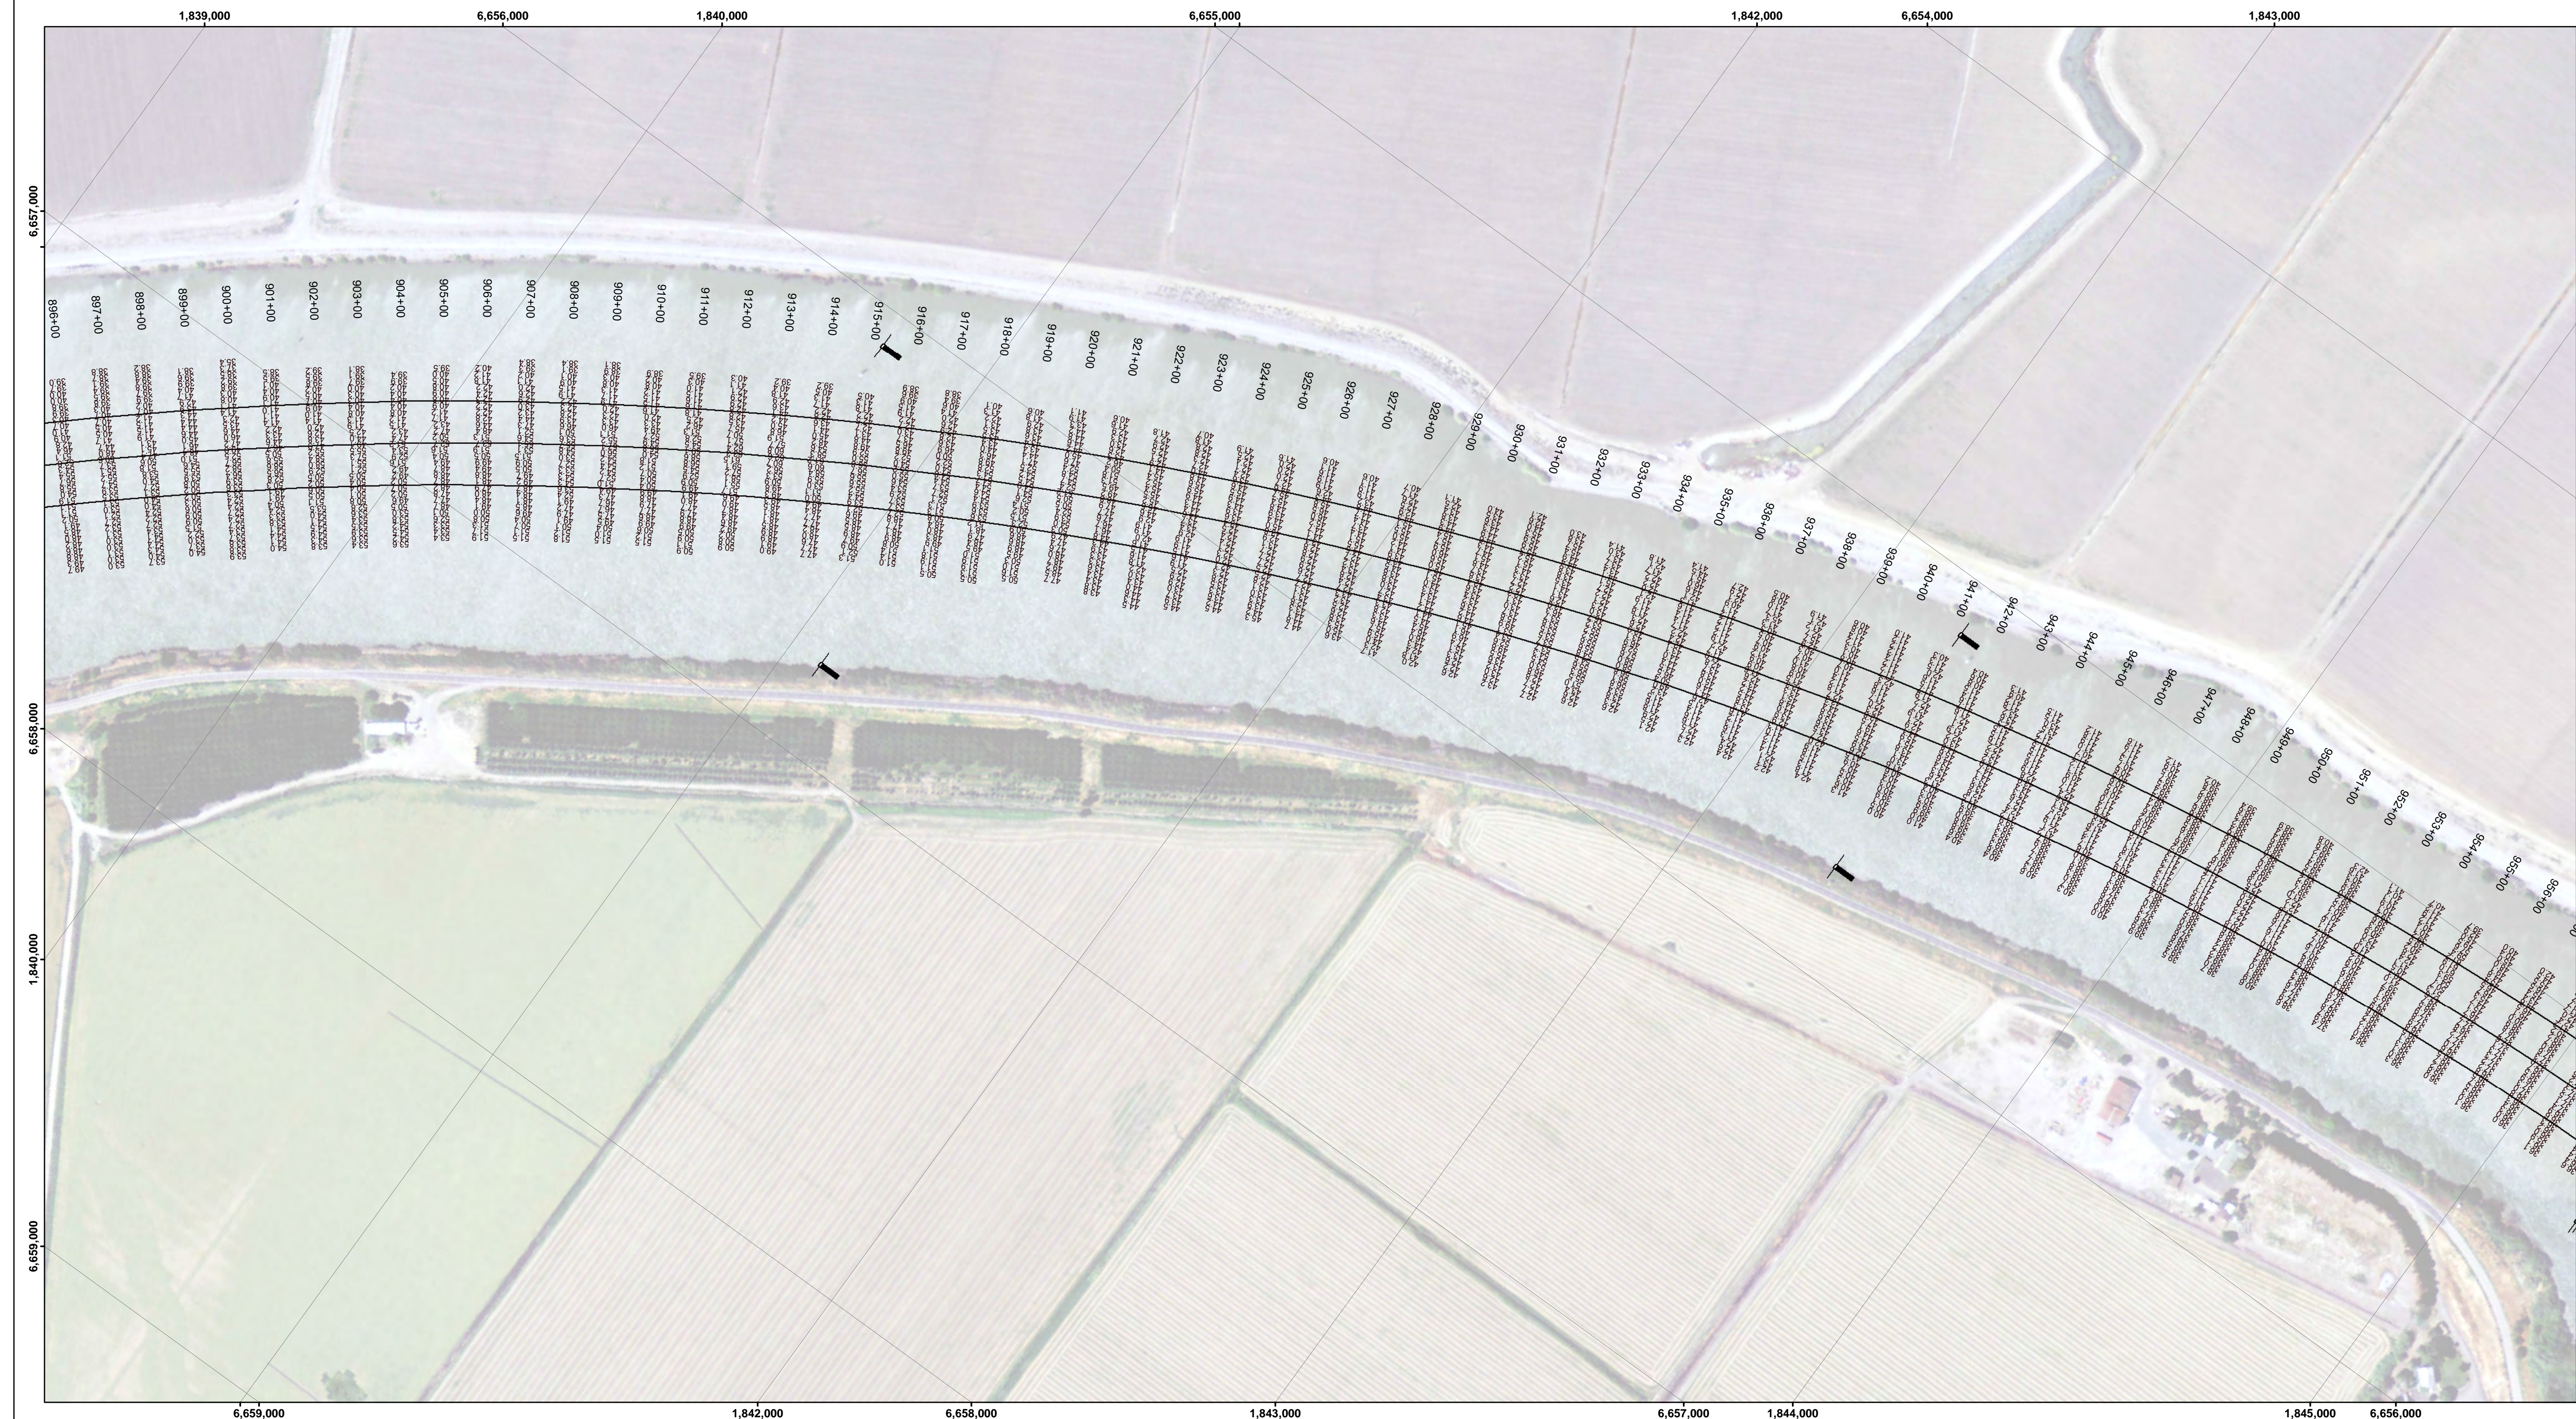

DISCLAIMER: The United States Government furnishes these data and the results of the survey for the use of the recipient. The recipient agrees not to represent these data to anyone as other than Government provided data. The recipient may not transfer these data to others without also transferring this Disclaimer.




Access Constraints: The United States Government furnishes these data and the results of the survey for the use of the recipient. The recipient agrees not to represent these data to anyone as other than Government provided data. The recipient may not transfer these data to others without also transferring this Disclaimer.

Distribution Liability: The data represents the results of data collection/processing for a specific US Army Corps of Engineers project. It is not intended for use in any other project. Accuracy of the data is not guaranteed. The user is responsible for the results of any application of the data for other than its intended purpose.

Chart Date:	Mar 12, 2018
Designed by:	PDT
Drawn by:	PDT
Surveyed By:	PDT
Plotted By:	PDT
Checked By:	PDT
Approved:	Chief, Construction Branch

PREPARED UNDER THE DIRECTION OF
TRAVIS J. RAYFIELD
LT COLONEL, C.E., DISTRICT ENGINEER

San Joaquin County
SACRAMENTO RIVER
CONDITION SURVEY
21, 25, 27-28 FEBRUARY 2018

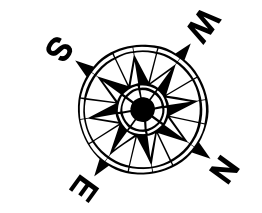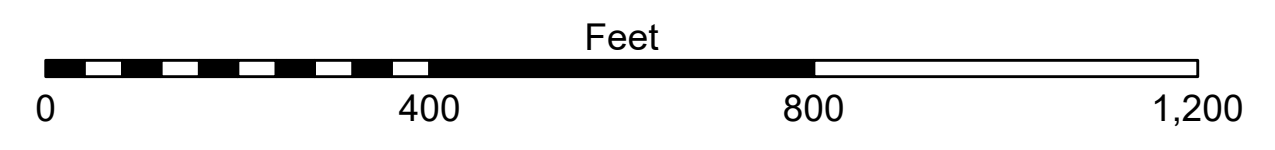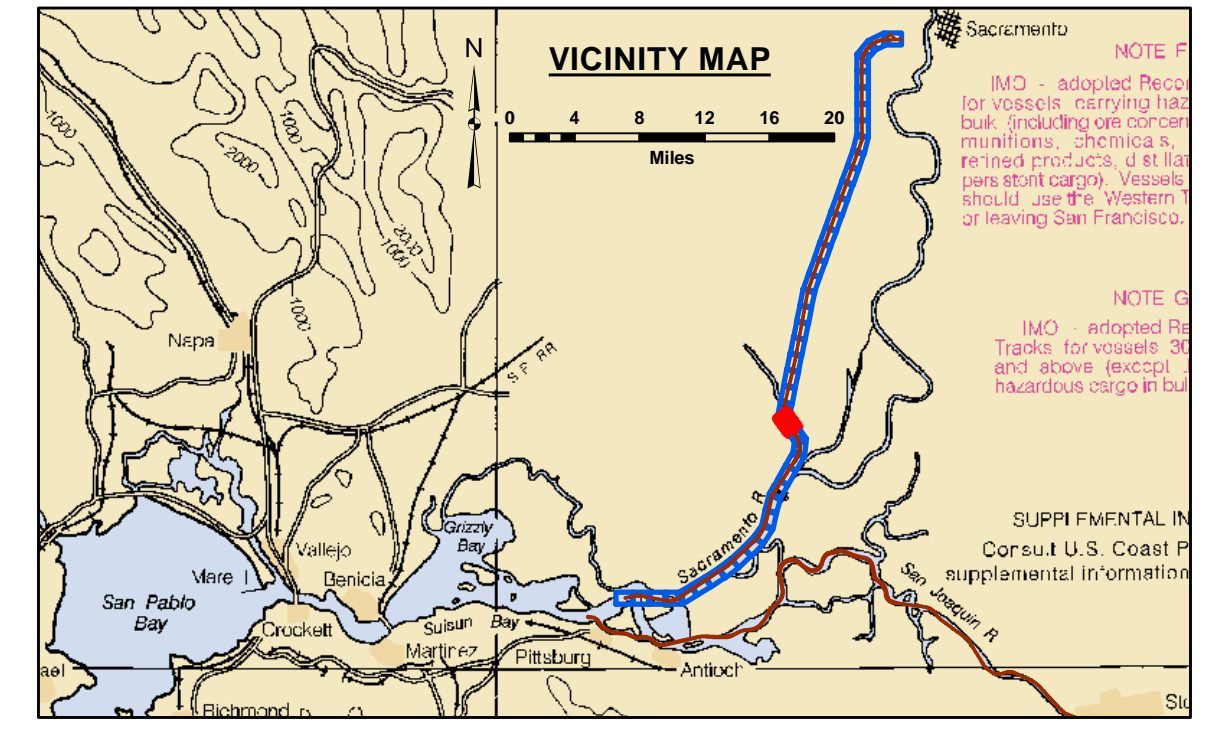

LEGEND

--- Federal Navigation Channel	▨ Cable Area	■ Shoaling Area	— Contours
— Federal Navigation Center Line	□ Placement Area	● Shoalest Sounding**	— -30
..... Cable Submarine	▭ Anchorage Area	⊥ Beacon, General	— -29
- - - Cable Overhead	⊗ Obstruction Point	◆ Red Navigation Buoy	— -28
— Contour Line	✦ Wrecks-Submerged	◆ Green Navigation Buoy	— -27
			— -26

NOTES:
DRAWING NOT TO BE USED FOR NAVIGATION. ONLY CHANNEL CONDITION AT DATE OF SURVEY.
THE LOCATION OF ALL NAVIGATION AIDS ARE BASED ON INFORMATION PROVIDED BY THE U.S. COAST GUARD.
BUOY LOCATIONS REPRESENT THE POSITION OF THE SINKER ONLY.

SOUNDINGS WERE TAKEN BY FATHOMETER AND ARE SHOWN TO THE NEAREST TENTH OF A FOOT.

SOUNDINGS ARE BASED ON THE DATUM OF MEAN LOWER LOW WATER AT THE LOCALITY.

NORTH AMERICAN DATUM OF 1983 (NAD83), PROJECTED TO THE STATE PLANE COORDINATE SYSTEM (SPCS), CA ZONE II (0402). DISTANCE UNITS IN U.S. SURVEY FEET.

PLANE GRID AND COORDINATES ARE BASED ON LAMBERT PROJECTION, NAD 83, ZONE II CALIFORNIA AS DESCRIBED IN SPECIAL PUBLICATION NO. 235, PUBLISHED BY THE NATIONAL OCEAN SURVEY.

PROJECT DEPTH: -30'
VERTICAL DATUM: MLLW

THE LOCATION OF NAVIGATION AIDS ARE BASED ON AND PROVIDED BY THE U.S. COAST GUARD

CONTROLS:
LOCATION: RIO VISTA
NOAA STATION: 9415316
BENCHMARK: 5316 B 1996 (NO PID)
TIDE GAUGE: NAIL @ 8.2 FT MLLW
METADATA: NAIL SET BY USACE 31 MARCH, 2014

LOCATION: PORT OF WEST SACRAMENTO
NOAA STATION: 9416131
BENCHMARK: POWS1 (NO PID)
TIDE GAUGE: NAIL @ 10.0 FT MLLW
METADATA: NAIL SET BY USACE 8 APRIL, 2014




ALL HORIZONTAL POSITIONS AND MLLW ELEVATIONS WERE POST-PROCESSED USING PUBLIC GPS REFERENCE STATIONS IN THE AREA.



DISCLAIMER: The United States Government furnishes these data and the results therefrom for the use of the recipient in connection with the recipient's operations. The user is responsible for the results of any application of the data for other than its intended purpose. The recipient may not transfer these data to others without also transferring this Disclaimer.

Prepared Under the Direction of TRAVIS J. RAYFIELD LT Colonel, C.E., District Engineer	Chart Date: Mar 12, 2018
Submitted: Hydro Survey Team Leader	Designed by: PDT
Recommended: Chief, Hydro Survey Section	Checked by: PDT
Approved: Chief, Construction Branch	Drawn by: PDT

CALIFORNIA
SAN JOAQUIN COUNTY
SACRAMENTO RIVER
CONDITION SURVEY
21, 25, 27-28 FEBRUARY 2018

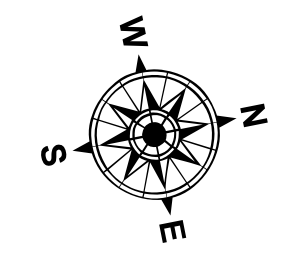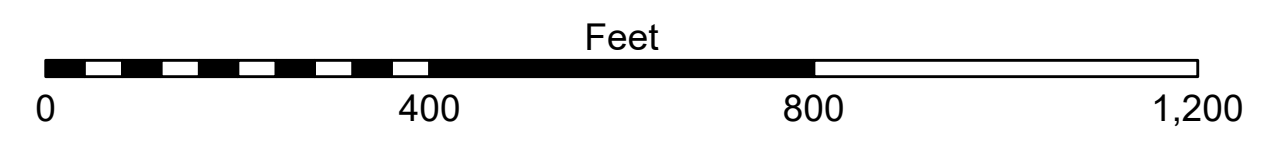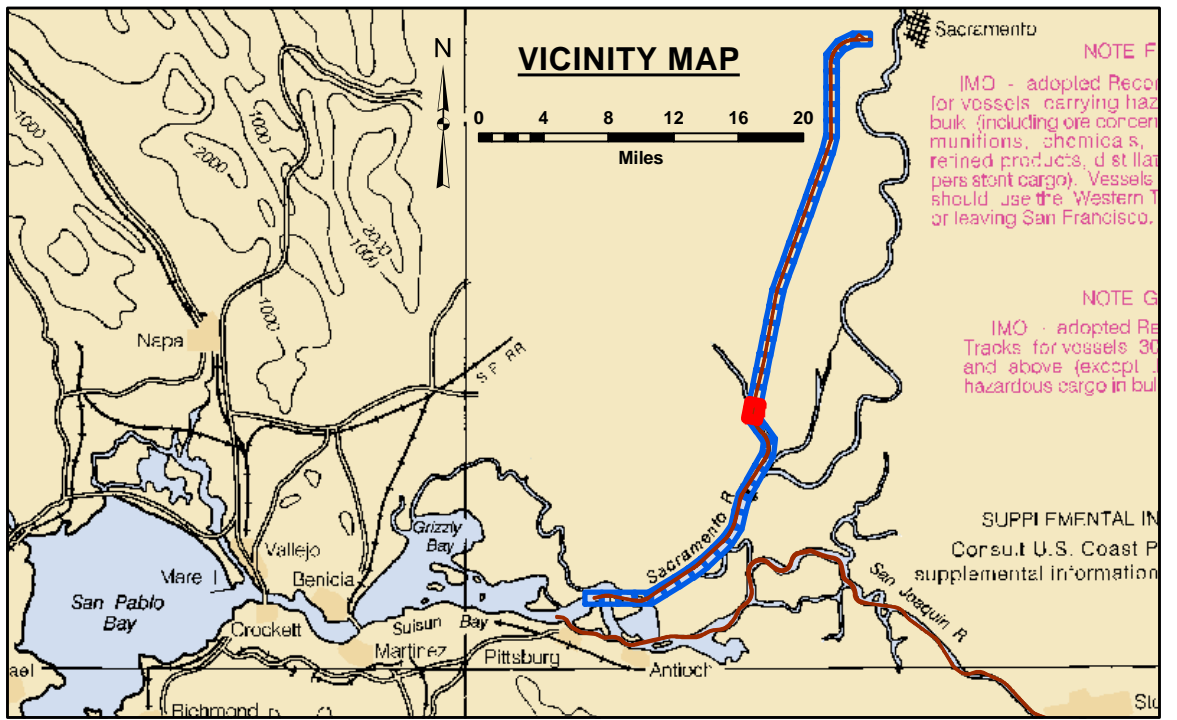

LEGEND		Contours	
--- Federal Navigation Channel	▨ Cable Area	— -30	
— Federal Navigation Center Line	□ Placement Area	— -29	
..... Cable Submarine	▨ Anchorage Area	— -28	
- - - Cable Overhead	⊗ Obstruction Point	— -27	
— Contour Line	✦ Wrecks-Submerged	— -26	
	● Shoalest Sounding**		
	⊥ Beacon, General		
	◆ Red Navigation Buoy		
	◆ Green Navigation Buoy		

NOTES:
DRAWING NOT TO BE USED FOR NAVIGATION. ONLY CHANNEL CONDITION AT DATE OF SURVEY.
THE LOCATION OF ALL NAVIGATION AIDS ARE BASED ON INFORMATION PROVIDED BY THE U.S. COAST GUARD.
BUOY LOCATIONS REPRESENT THE POSITION OF THE SINKER ONLY.

SOUNDINGS WERE TAKEN BY FATHOMETER AND ARE SHOWN TO THE NEAREST TENTH OF A FOOT.
SOUNDINGS ARE BASED ON THE DATUM OF MEAN LOWER LOW WATER AT THE LOCALITY.

NORTH AMERICAN DATUM OF 1983 (NAD83), PROJECTED TO THE STATE PLANE COORDINATE SYSTEM (SPCS), CA ZONE II (0402). DISTANCE UNITS IN U.S. SURVEY FEET.

PLANE GRID AND COORDINATES ARE BASED ON LAMBERT PROJECTION, NAD 83, ZONE II CALIFORNIA AS DESCRIBED IN SPECIAL PUBLICATION NO. 235, PUBLISHED BY THE NATIONAL OCEAN SURVEY.


PROJECT DEPTH: -30'
VERTICAL DATUM: MLLW

THE LOCATION OF NAVIGATION AIDS ARE BASED ON AND PROVIDED BY THE U.S. COAST GUARD

CONTROLS:
LOCATION: RIO VISTA
NOAA STATION: 9415316
BENCHMARK: 5316 B 1996 (NO PID)
TIDE GAUGE: NAIL @ 8.2 FT MLLW
METADATA: NAIL SET BY USACE 31 MARCH, 2014

LOCATION: PORT OF WEST SACRAMENTO
NOAA STATION: 9416131
BENCHMARK: POWS1 (NO PID)
TIDE GAUGE: NAIL @ 10.0 FT MLLW
METADATA: NAIL SET BY USACE 8 APRIL, 2014

ALL HORIZONTAL POSITIONS AND MLLW ELEVATIONS WERE POST-PROCESSED USING PUBLIC GPS REFERENCE STATIONS IN THE AREA.



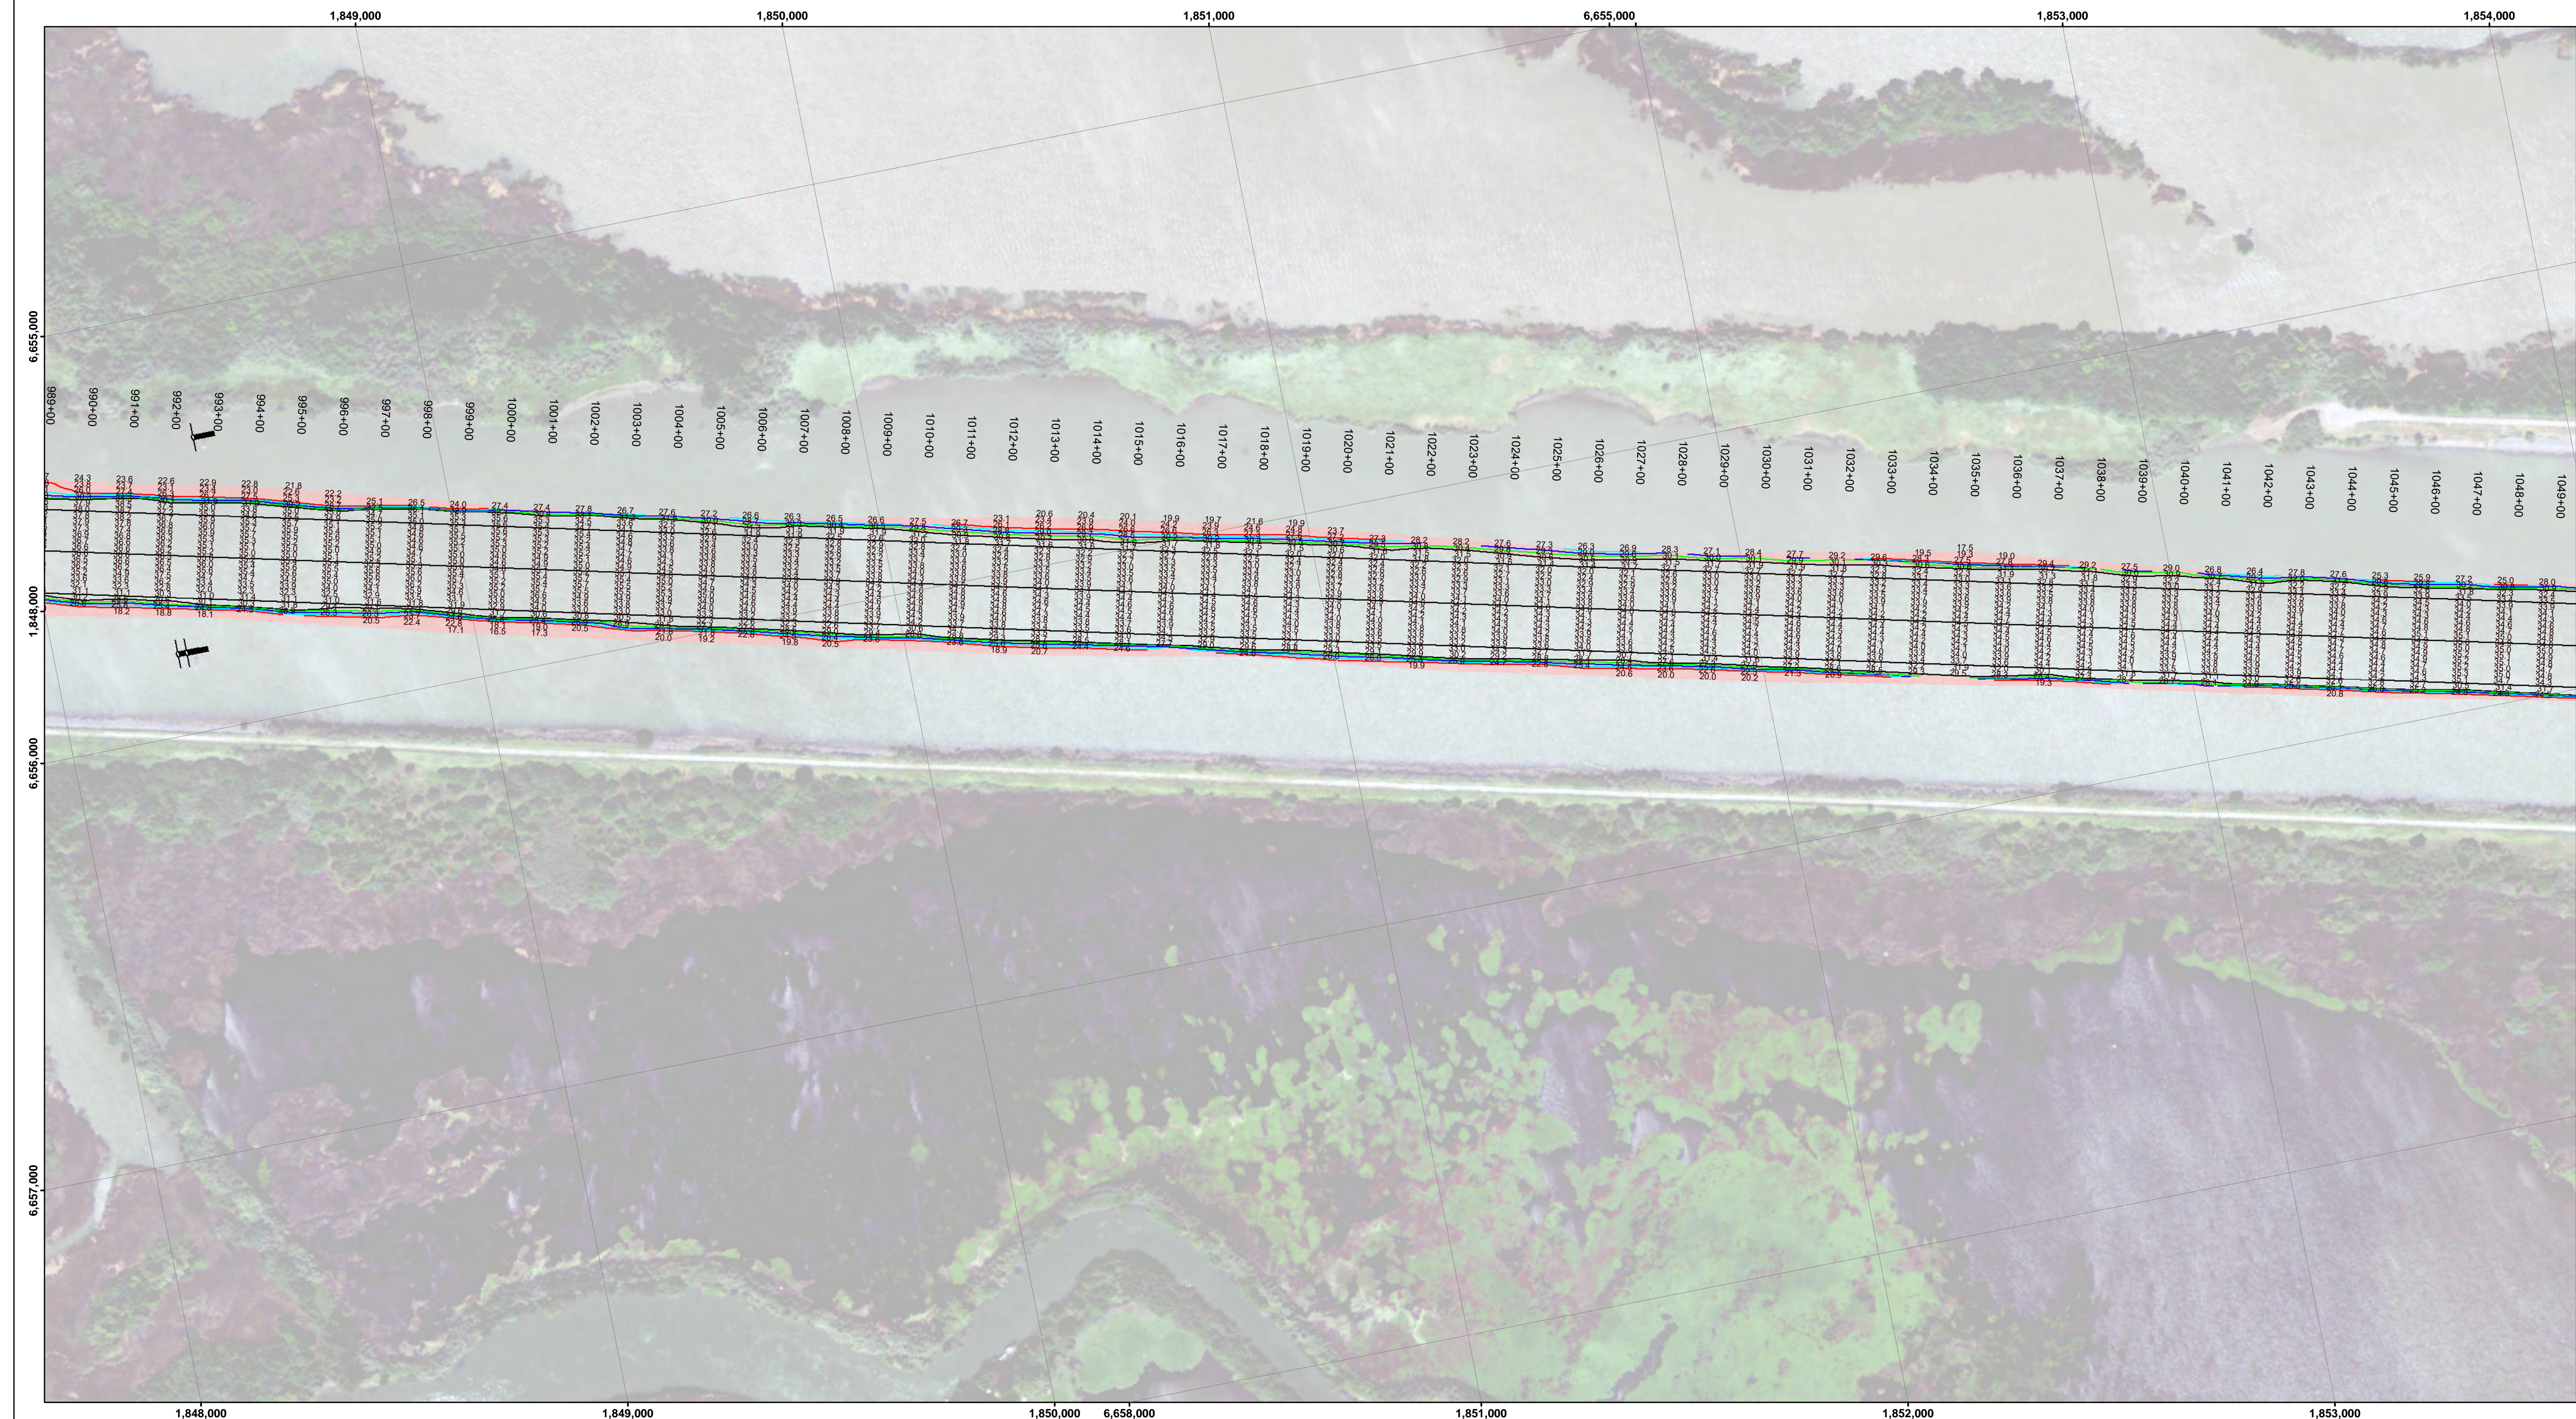


DISCLAIMER: The United States Government furnishes these data and the results of the processing of these data as they are received from the contractor. The contractor is not responsible for the accuracy of the data furnished. 

Prepared Under the Direction of TRAVIS J. RAYFIELD LT Colonel, C.E., District Engineer	Chart Date: Mar 12, 2018
Submitted: Hydro Survey Team Leader	Designed by: PDT
Recommended: Chief, Hydro Survey Section	Checked by: PDT
Approved: Chief, Construction Branch	Drawn by: PDT

CALIFORNIA
SACRAMENTO RIVER
CONDITION SURVEY
21, 25, 27-28 FEBRUARY 2018

Sheet
Reference
Number
21 of 45

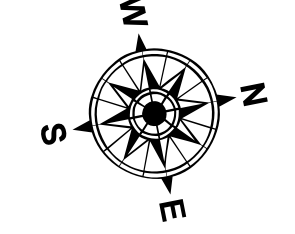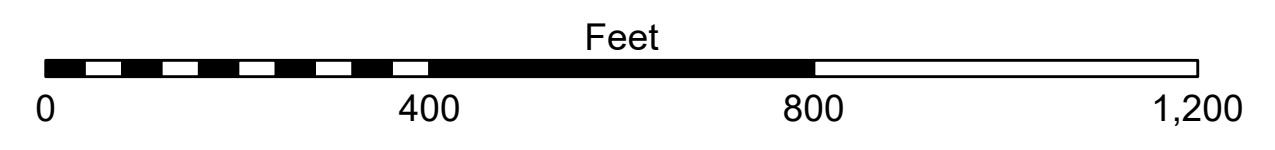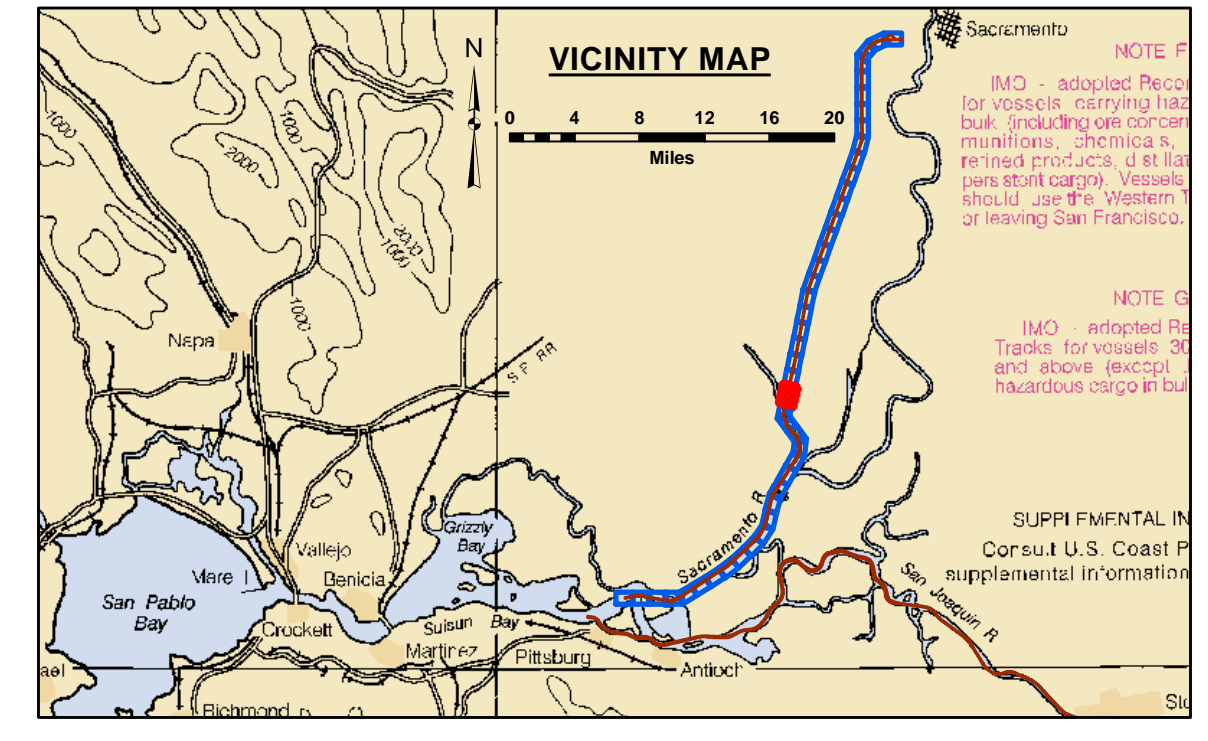

LEGEND			
--- Federal Navigation Channel	▨ Cable Area	■ Shoaling Area	— Contours -30
— Federal Navigation Center Line	□ Placement Area	● Shoalest Sounding**	— Contours -29
..... Cable Submarine	▨ Anchorage Area	⊥ Beacon, General	— Contours -28
- - - Cable Overhead	⊗ Obstruction Point	◆ Red Navigation Buoy	— Contours -27
— Contour Line	✦ Wrecks-Submerged	◆ Green Navigation Buoy	— Contours -26

NOTES:
DRAWING NOT TO BE USED FOR NAVIGATION. ONLY CHANNEL CONDITION AT DATE OF SURVEY.
THE LOCATION OF ALL NAVIGATION AIDS ARE BASED ON INFORMATION PROVIDED BY THE U.S. COAST GUARD.
BUOY LOCATIONS REPRESENT THE POSITION OF THE SINKER ONLY.

SOUNDINGS WERE TAKEN BY FATHOMETER AND ARE SHOWN TO THE NEAREST TENTH OF A FOOT.

SOUNDINGS ARE BASED ON THE DATUM OF MEAN LOWER LOW WATER AT THE LOCALITY.

NORTH AMERICAN DATUM OF 1983 (NAD83), PROJECTED TO THE STATE PLANE COORDINATE SYSTEM (SPCS), ZONE II (0402), DISTANCE UNITS IN U.S. SURVEY FEET.

PLANE GRID AND COORDINATES ARE BASED ON LAMBERT PROJECTION, NAD 83, ZONE II CALIFORNIA AS DESCRIBED IN SPECIAL PUBLICATION NO. 235, PUBLISHED BY THE NATIONAL OCEAN SURVEY.

PROJECT DEPTH: -30'
VERTICAL DATUM: MLLW

THE LOCATION OF NAVIGATION AIDS ARE BASED ON AND PROVIDED BY THE U.S. COAST GUARD

CONTROLS:
LOCATION: RIO VISTA
NOAA STATION: 9415316
BENCHMARK: 5316 B 1996 (NO PID)
TIDE GAUGE: NAIL @ 8.2 FT MLLW
METADATA: NAIL SET BY USACE 8 MARCH, 2014

LOCATION: PORT OF WEST SACRAMENTO
NOAA STATION: 9416131
BENCHMARK: POWS1 (NO PID)
TIDE GAUGE: NAIL @ 10.0 FT MLLW
METADATA: NAIL SET BY USACE 8 APRIL, 2014

ALL HORIZONTAL POSITIONS AND MLLW ELEVATIONS WERE POST-PROCESSED USING PUBLIC GPS REFERENCE STATIONS IN THE AREA.






DISCLAIMER: The data represents the results of data collection/processing for a specific US Army Corps of Engineers project. It is not intended for use in any other project. Accuracy of the data is not guaranteed. The user is responsible for the results of any application of the data for other than its intended purpose.

Access Constraints: The United States Government furnishes this data and the results of its use to the recipient on an "as is" basis. The US Government does not warrant the accuracy, completeness, or reliability of the data. The recipient shall be responsible for any liability whatsoever by reason of any use of the data for other than its intended purpose. The recipient may not transfer this data to others without obtaining the permission of the US Army Corps of Engineers.

Prepared Under the Direction of TRAVIS J. RAYFIELD LT Colonel, C.E., District Engineer	Chart Date: Mar 12, 2018
Submitted: Hydro Survey Team Leader	Designed by: PDT
Recommended: Chief, Hydro Survey Section	Checked by: PDT
Approved: Chief, Construction Branch	Drawn by: PDT

CALIFORNIA
SAN JOAQUIN COUNTY
SACRAMENTO RIVER
CONDITION SURVEY
21, 25, 27-28 FEBRUARY 2018

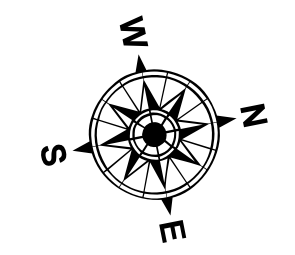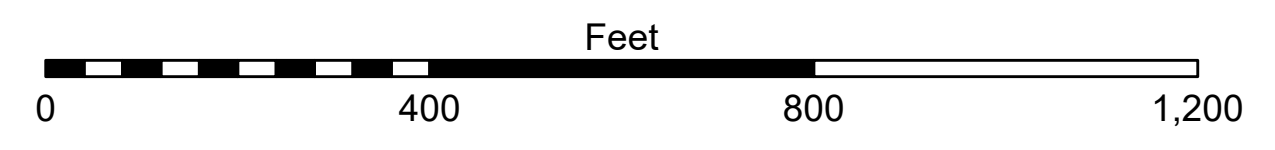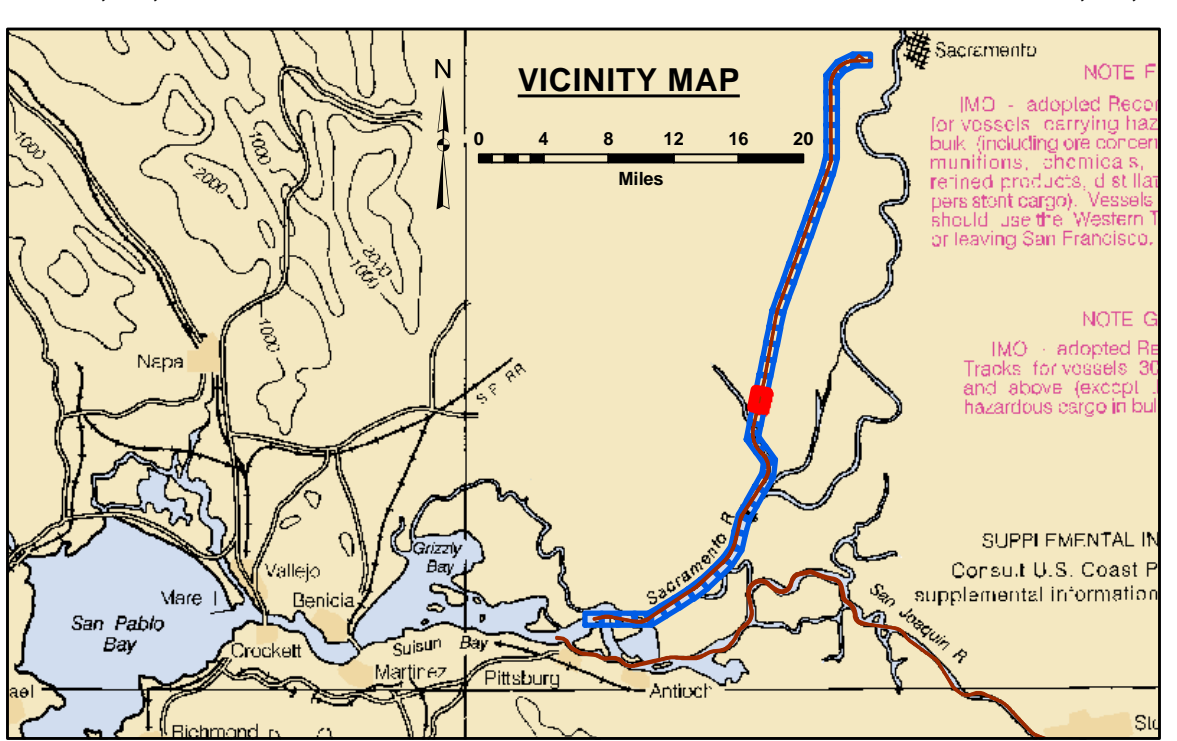

LEGEND			
--- Federal Navigation Channel	Cable Area	Shoaling Area	-30
— Federal Navigation Center Line	Placement Area	Shoalest Sounding**	-29
..... Cable Submarine	Anchorage Area	Beacon, General	-28
- - - Cable Overhead	Obstruction Point	Red Navigation Buoy	-27
— Contour Line	Wrecks-Submerged	Green Navigation Buoy	-26

NOTES:
DRAWING NOT TO BE USED FOR NAVIGATION. ONLY CHANNEL CONDITION AT DATE OF SURVEY.
THE LOCATION OF ALL NAVIGATION AIDS ARE BASED ON INFORMATION PROVIDED BY THE U.S. COAST GUARD.
BUOY LOCATIONS REPRESENT THE POSITION OF THE SINKER ONLY.

SOUNDINGS WERE TAKEN BY FATHOMETER AND ARE SHOWN TO THE NEAREST TENTH OF A FOOT.

SOUNDINGS ARE BASED ON THE DATUM OF MEAN LOWER LOW WATER AT THE LOCALITY.

NORTH AMERICAN DATUM OF 1983 (NAD83), PROJECTED TO THE STATE PLANE COORDINATE SYSTEM (SPCS), CA ZONE II (0402). DISTANCE UNITS IN U.S. SURVEY FEET.

PLANE GRID AND COORDINATES ARE BASED ON LAMBERT PROJECTION, NAD 83, ZONE II CALIFORNIA AS DESCRIBED IN SPECIAL PUBLICATION NO. 235, PUBLISHED BY THE NATIONAL OCEAN SURVEY.

PROJECT DEPTH: -30'


VERTICAL DATUM: MLLW

THE LOCATION OF NAVIGATION AIDS ARE BASED ON AND PROVIDED BY THE U.S. COAST GUARD

CONTROLS:
LOCATION: RIO VISTA
NOAA STATION: 9415316
BENCHMARK: 5316 B 1996 (NO PID)
TIDE GAUGE: NAIL @ 8.2 FT MLLW
METADATA: NAIL SET BY USACE 31 MARCH, 2014

LOCATION: PORT OF WEST SACRAMENTO
NOAA STATION: 9416131
BENCHMARK: POWS1 (NO PID)
TIDE GAUGE: NAIL @ 10.0 FT MLLW
METADATA: NAIL SET BY USACE 8 APRIL, 2014

ALL HORIZONTAL POSITIONS AND MLLW ELEVATIONS WERE POST-PROCESSED USING PUBLIC GPS REFERENCE STATIONS IN THE AREA.

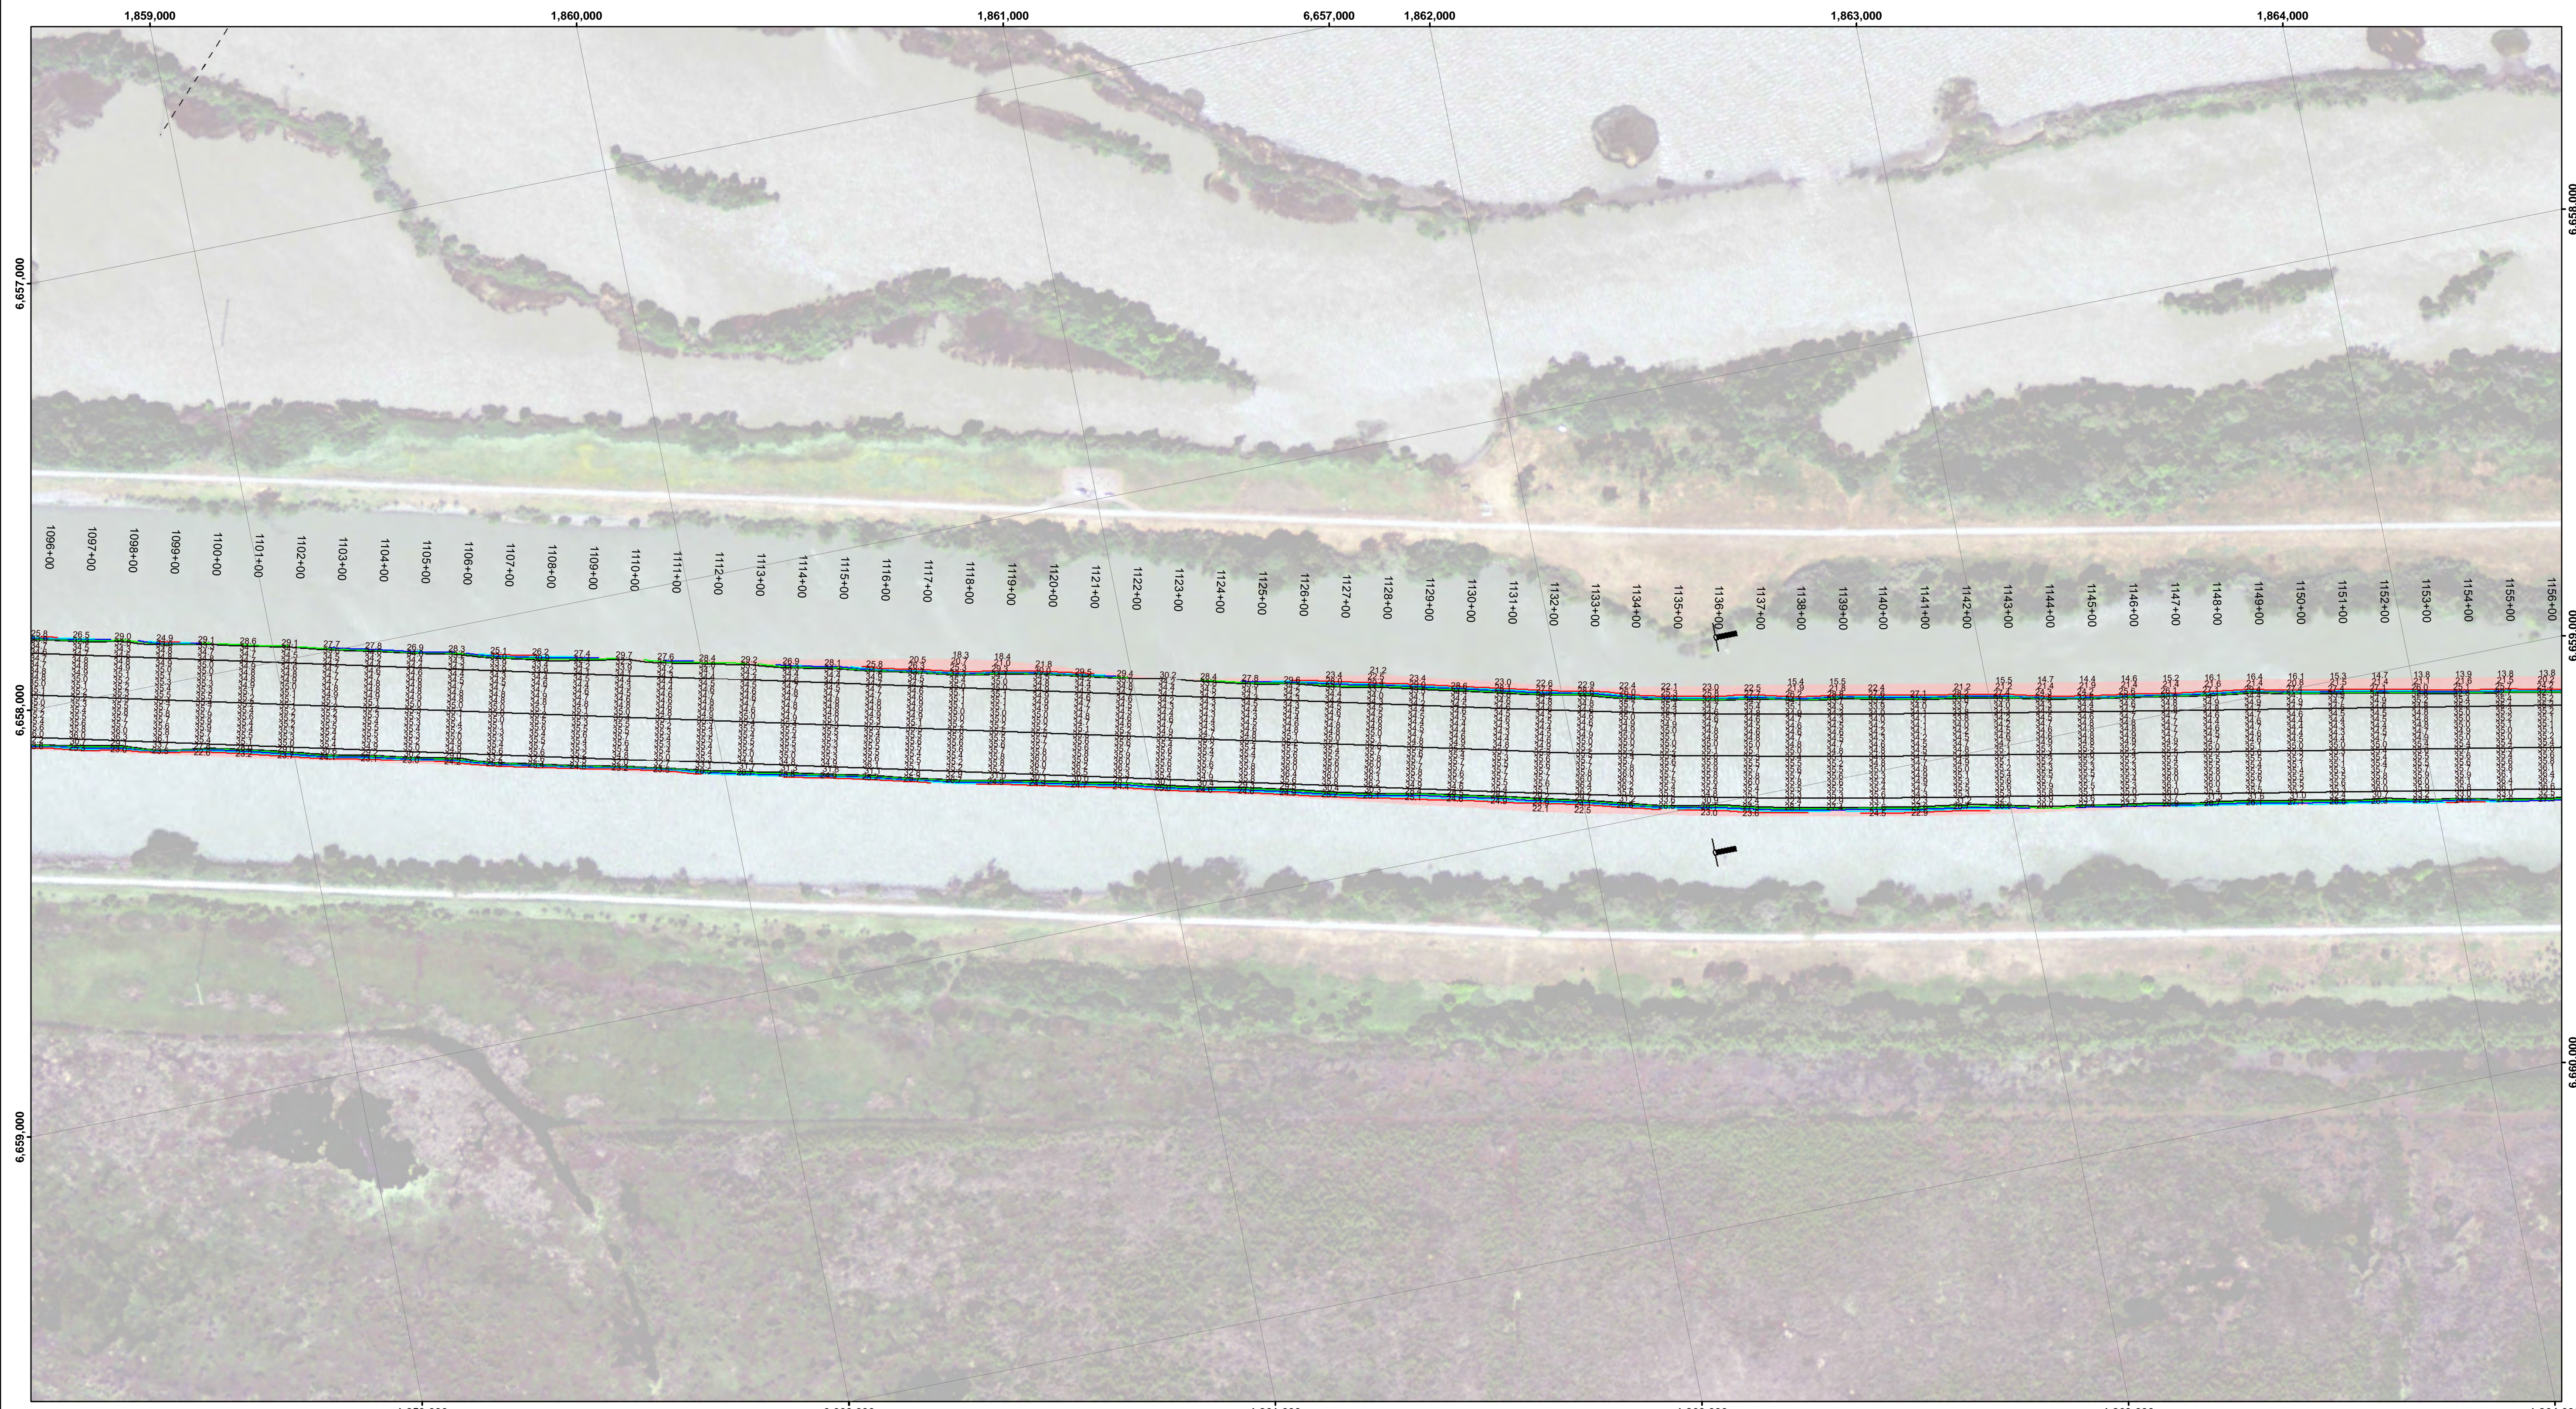

DISCLAIMER: The data represents the results of data collection/processing for a specific US Army Corps of Engineers project. It is not intended for use in any other project. Accuracy of the data is not guaranteed. The user is responsible for the results of any application of the data for other than its intended purpose.


DISCLAIMER: The United States Government furnishes this data and the results of any processing of this data for the use of the recipient. The recipient is responsible for the accuracy, completeness, and timeliness of the data. The recipient agrees not to represent these data to anyone as other than Government provided data. The recipient may not transfer these data to others without also transferring this Disclaimer.

Chart Date:	Mar 12, 2018
Designed by:	PDT
Drawn by:	PDT
Surveyed By:	PDT
Plotted By:	PDT
Checked By:	PDT
Approved:	Chief, Construction Branch

PREPARED UNDER THE DIRECTION OF
TRAVIS J. RAYFIELD
 LT COLONEL, C.E., DISTRICT ENGINEER

Standard: Hydro Survey Team Leader
 Recommended: Chief, Hydro Survey Section
 Approved: Chief, Construction Branch

CALIFORNIA
SACRAMENTO RIVER
 CONDITION SURVEY
 21, 25, 27-28 FEBRUARY 2018

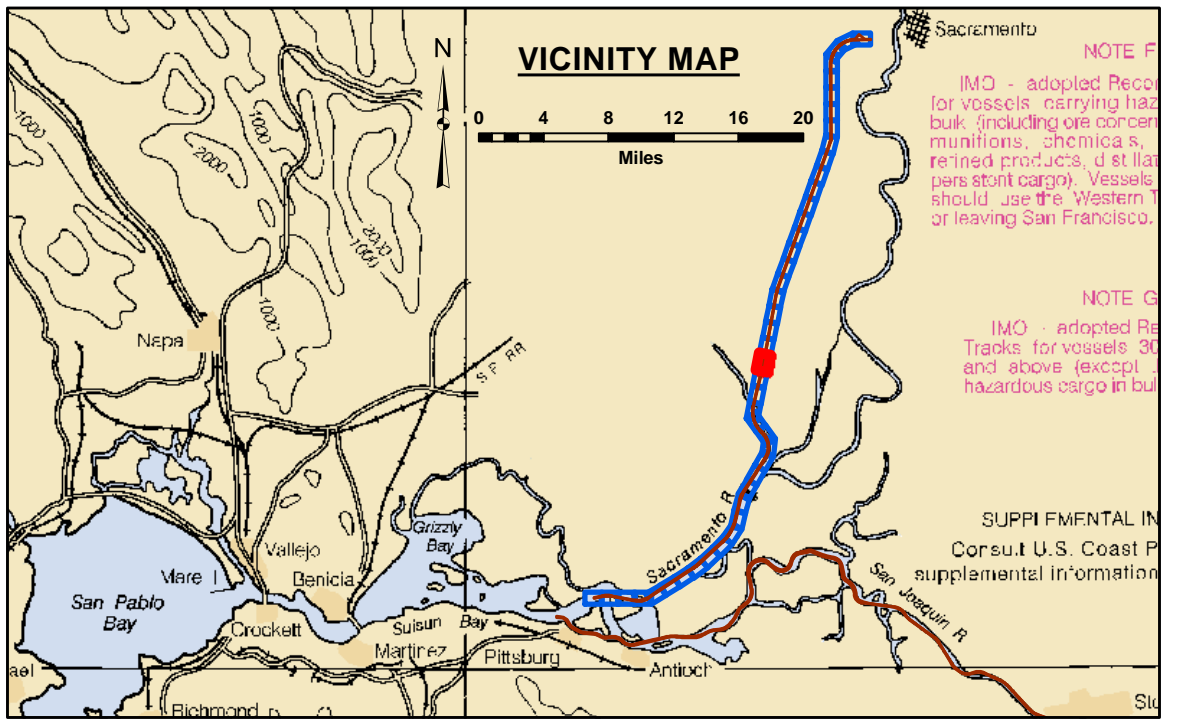

0 400 800 1,200 Feet

LEGEND		Contours	
--- Federal Navigation Channel	▨ Cable Area	— -30	
— Federal Navigation Center Line	□ Placement Area	— -29	
..... Cable Submarine	▨ Anchorage Area	— -28	
- - - Cable Overhead	⊗ Obstruction Point	— -27	
— Contour Line	✦ Wrecks-Submerged	— -26	
	● Shoaling Area		
	⊥ Beacon, General		
	◆ Red Navigation Buoy		
	◆ Green Navigation Buoy		

NOTES:
 DRAWING NOT TO BE USED FOR NAVIGATION. ONLY CHANNEL CONDITION AT DATE OF SURVEY.
 THE LOCATION OF ALL NAVIGATION AIDS ARE BASED ON INFORMATION PROVIDED BY THE U.S. COAST GUARD.
 BUOY LOCATIONS REPRESENT THE POSITION OF THE SINKER ONLY.

SOUNDINGS WERE TAKEN BY FATHOMETER AND ARE SHOWN TO THE NEAREST TENTH OF A FOOT.

SOUNDINGS ARE BASED ON THE DATUM OF MEAN LOWER LOW WATER AT THE LOCALITY.

NORTH AMERICAN DATUM OF 1983 (NAD83), PROJECTED TO THE STATE PLANE COORDINATE SYSTEM (SPCS), CA ZONE II (0402). DISTANCE UNITS IN U.S. SURVEY FEET.

PLANE GRID AND COORDINATES ARE BASED ON LAMBERT PROJECTION, NAD 83, ZONE II CALIFORNIA AS DESCRIBED IN SPECIAL PUBLICATION NO. 235, PUBLISHED BY THE NATIONAL OCEAN SURVEY.


PROJECT DEPTH: -30'
 VERTICAL DATUM: MLLW



THE LOCATION OF NAVIGATION AIDS ARE BASED ON AND PROVIDED BY THE U.S. COAST GUARD

CONTROLS:
 LOCATION: RIO VISTA
 NOAA STATION: 9415316
 BENCHMARK: 5316 B 1996 (NO PID)
 TIDE GAUGE: NAIL @ 8.2 FT MLLW
 METADATA: NAIL SET BY USACE 31 MARCH, 2014

LOCATION: PORT OF WEST SACRAMENTO
 NOAA STATION: 9416131
 BENCHMARK: POWS1 (NO PID)
 TIDE GAUGE: NAIL @ 10.0 FT MLLW
 METADATA: NAIL SET BY USACE 8 APRIL, 2014

ALL HORIZONTAL POSITIONS AND MLLW ELEVATIONS WERE POST-PROCESSED USING PUBLIC GPS REFERENCE STATIONS IN THE AREA.

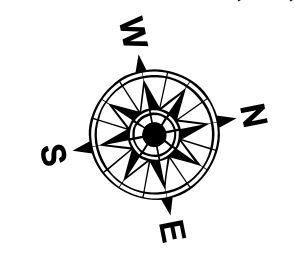

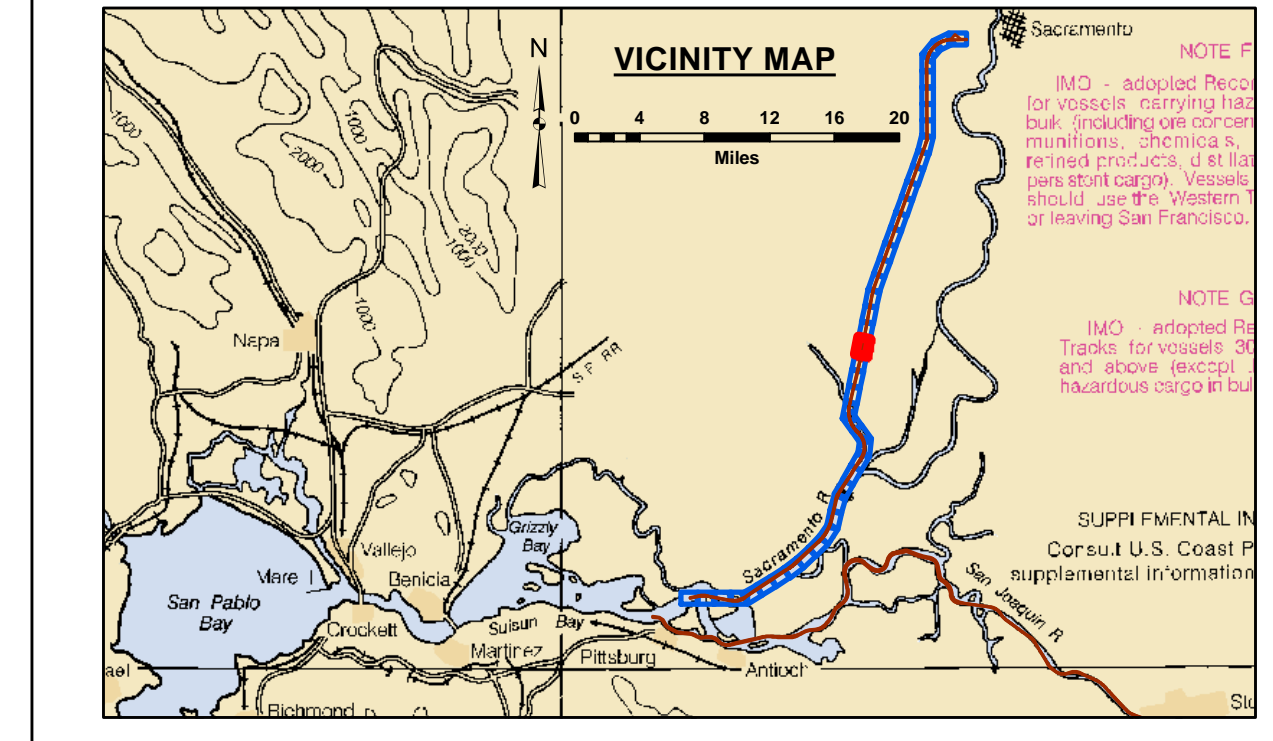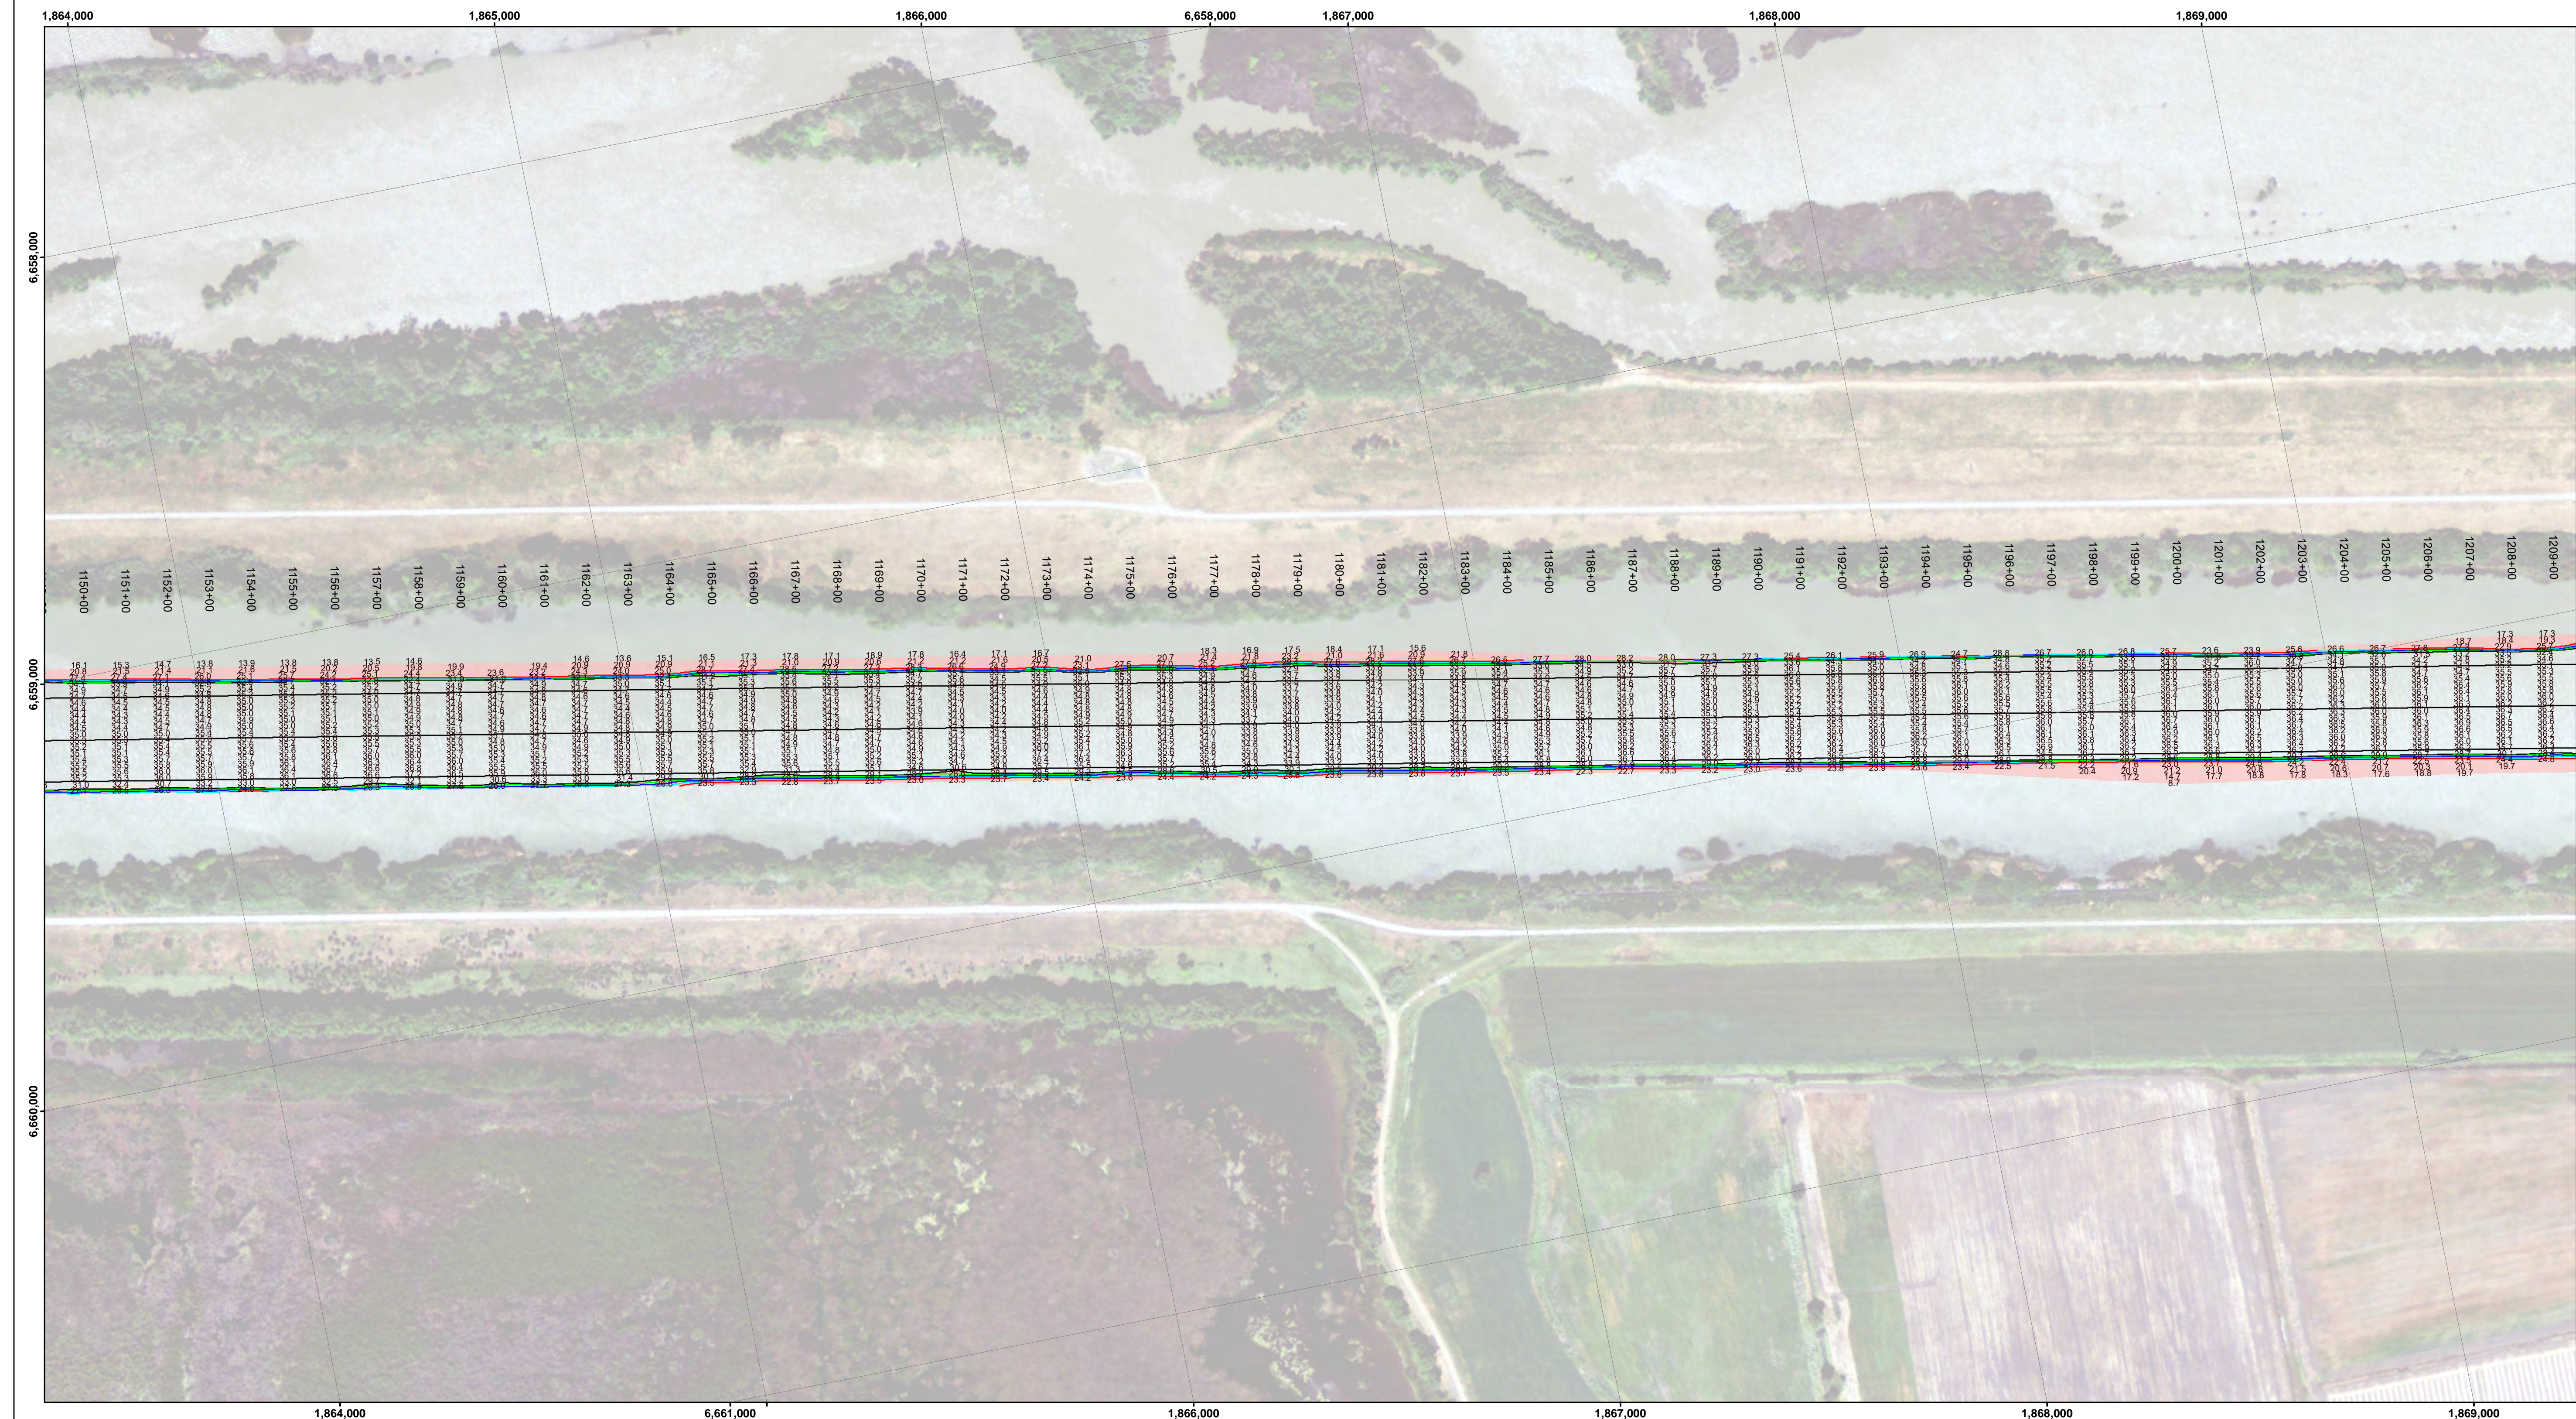

LEGEND

--- Federal Navigation Channel	Cable Area	Shoaling Area
— Federal Navigation Center Line	Placement Area	Shoalest Sounding**
..... Cable Submarine	Anchorage Area	Beacon, General
- - - Cable Overhead	Obstruction Point	Red Navigation Buoy
— Contour Line	Wrecks-Submerged	Green Navigation Buoy

Contours

- 30
- 29
- 28
- 27
- 26

NOTES:
DRAWING NOT TO BE USED FOR NAVIGATION. ONLY CHANNEL CONDITION AT DATE OF SURVEY.
THE LOCATION OF ALL NAVIGATION AIDS ARE BASED ON INFORMATION PROVIDED BY THE U.S. COAST GUARD.
BUOY LOCATIONS REPRESENT THE POSITION OF THE SINKER ONLY.

SOUNDINGS WERE TAKEN BY FATHOMETER AND ARE SHOWN TO THE NEAREST TENTH OF A FOOT.

SOUNDINGS ARE BASED ON THE DATUM OF MEAN LOWER LOW WATER AT THE LOCALITY.

NORTH AMERICAN DATUM OF 1983 (NAD83), PROJECTED TO THE STATE PLANE COORDINATE SYSTEM (SPCS), ZONE II CALIFORNIA AS DESCRIBED IN SPECIAL PUBLICATION NO. 235, PUBLISHED BY THE NATIONAL OCEAN SURVEY.

PROJECT DEPTH: -30'
VERTICAL DATUM: MLLW

THE LOCATION OF NAVIGATION AIDS ARE BASED ON AND PROVIDED BY THE U.S. COAST GUARD

CONTROLS:
LOCATION: RIO VISTA
NOAA STATION: 9415316
BENCHMARK: 5316 B 1996 (NO PID)
TIDE GAUGE: NAIL @ 8.2 FT MLLW
METADATA: NAIL SET BY USACE 31 MARCH, 2014

LOCATION: PORT OF WEST SACRAMENTO
NOAA STATION: 9416131
BENCHMARK: POWS1 (NO PID)
TIDE GAUGE: NAIL @ 10.0 FT MLLW
METADATA: NAIL SET BY USACE 8 APRIL, 2014

ALL HORIZONTAL POSITIONS AND MLLW ELEVATIONS WERE POST-PROCESSED USING PUBLIC GPS REFERENCE STATIONS IN THE AREA.



DISCLAIMER: The data represents the results of data collection/processing for a specific US Army Corps of Engineers project. The data is not intended for use in any other project. The user is responsible for the results of any application of the data for other than its intended purpose. The user is responsible for the results of any application of the data for other than its intended purpose.

Access Constraints: The United States Government furnishes these data and the results of the processing of these data to the user for use in the project for which they were prepared. The user is responsible for the results of any application of the data for other than its intended purpose. The user is responsible for the results of any application of the data for other than its intended purpose.


Chart Date:	Mar 12, 2018
Designed By:	PDT
Drawn By:	PDT
Surveyed By:	PDT
Plotted By:	PDT
Checked By:	PDT
Approved:	Chief, Construction Branch

PREPARED UNDER THE DIRECTION OF
TRAVIS J. RAYFIELD
LT COLONEL, C.E., DISTRICT ENGINEER

Submitted: Hydro Survey Team Leader
Recommended: Chief, Hydro Survey Section
Approved: Chief, Construction Branch

CALIFORNIA
SACRAMENTO RIVER
CONDITION SURVEY
21, 25, 27-28 FEBRUARY 2018

Sheet Reference Number
24 of 45

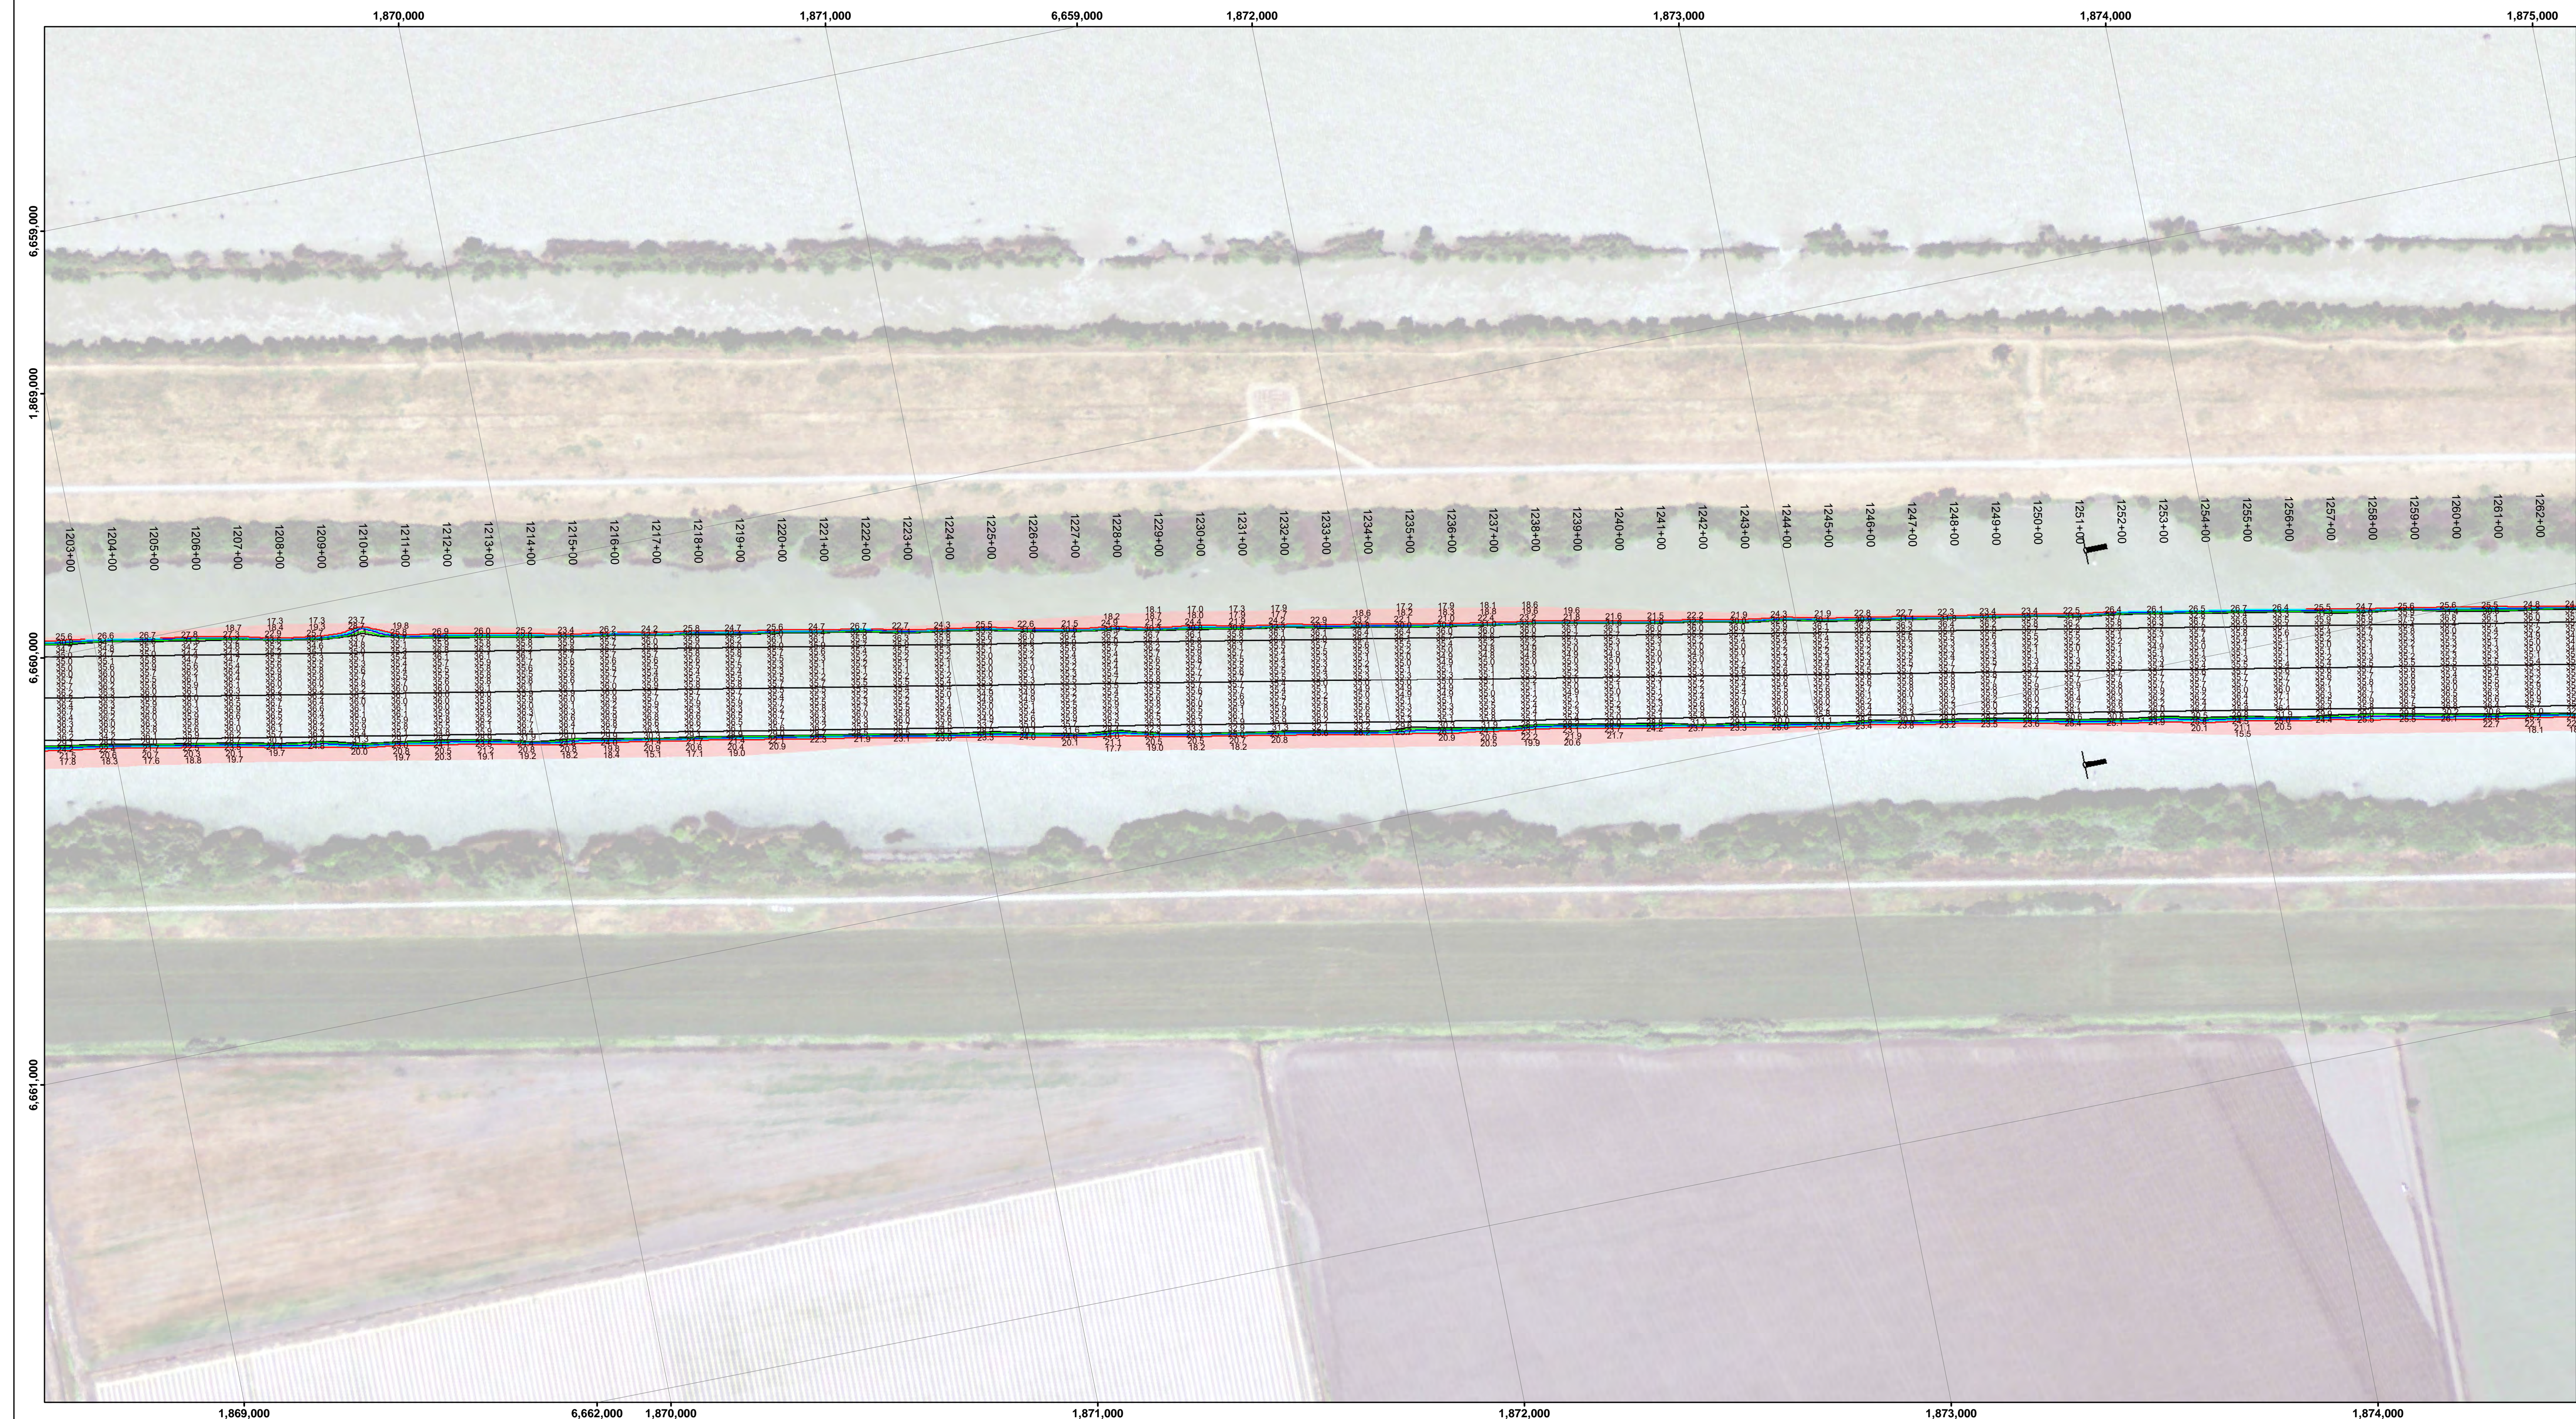




DISCLAIMER: The data represents the results of data collection/processing for a specific US Army Corps of Engineers project. It is not intended for use in any other project. Accuracy of the data is not guaranteed. The user is responsible for the results of any application of the data for other than its intended purpose.

Access Constraints: The United States Government furnishes these data and the results of any analysis thereof to the recipient under a license that does not constitute an endorsement or implied concern for accuracy, completeness, or timeliness. The recipient may not transfer these data to others without also transferring this Disclaimer.

Chart Date:	Mar 12, 2018
Designed By:	PDT
Drawn By:	PDT
Surveyed By:	PDT
Plotted By:	PDT
Checked By:	PDT
Approved:	Chief, Hydro Survey Section
Approved:	Chief, Construction Branch

CALIFORNIA
SACRAMENTO RIVER
 CONDITION SURVEY
 21, 25, 27-28 FEBRUARY 2018

Sheet Reference Number
25 of 45

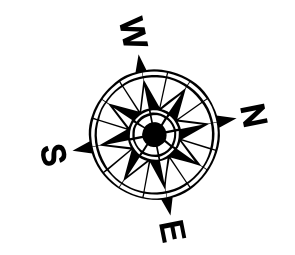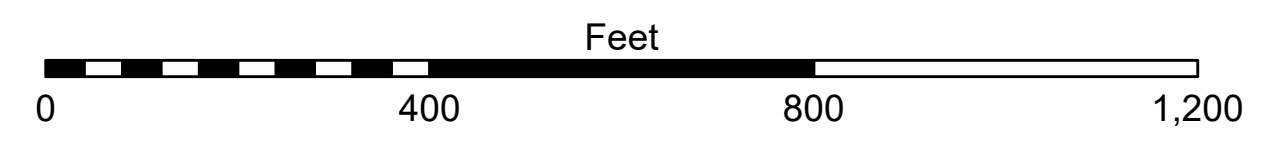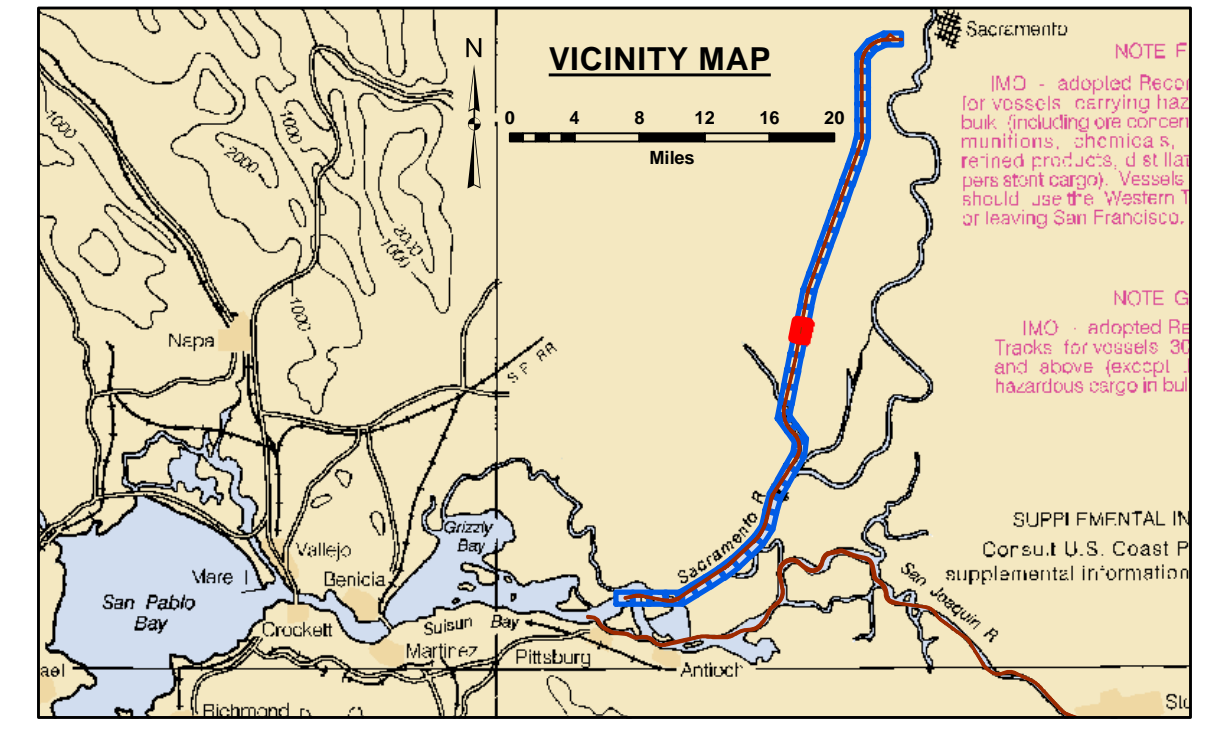

LEGEND

--- Federal Navigation Channel	Cable Area	Shoaling Area	-30
— Federal Navigation Center Line	Placement Area	Shoalest Sounding**	-29
..... Cable Submarine	Anchorage Area	Beacon, General	-28
- - - Cable Overhead	Obstruction Point	Red Navigation Buoy	-27
— Contour Line	Wrecks-Submerged	Green Navigation Buoy	-26

NOTES:
 DRAWING NOT TO BE USED FOR NAVIGATION. ONLY CHANNEL CONDITION AT DATE OF SURVEY.
 THE LOCATION OF ALL NAVIGATION AIDS ARE BASED ON INFORMATION PROVIDED BY THE U.S. COAST GUARD.
 BUOY LOCATIONS REPRESENT THE POSITION OF THE SINKER ONLY.

SOUNDINGS WERE TAKEN BY FATHOMETER AND ARE SHOWN TO THE NEAREST TENTH OF A FOOT.
 SOUNDINGS ARE BASED ON THE DATUM OF MEAN LOWER LOW WATER AT THE LOCALITY.

NORTH AMERICAN DATUM OF 1983 (NAD83), PROJECTED TO THE STATE PLANE COORDINATE SYSTEM (SPCS),
 CA ZONE II (0402). DISTANCE UNITS IN U.S. SURVEY FEET.

PLANE GRID AND COORDINATES ARE BASED ON LAMBERT PROJECTION, NAD 83,
 BENCHMARK: POWS1 (NO PID)
 TIDE GAUGE: NAIL @ 8.2 FT MLLW
 METADATA: NAIL SET BY USACE 31 MARCH, 2014

PROJECT DEPTH: -30'
 VERTICAL DATUM: MLLW

THE LOCATION OF NAVIGATION AIDS ARE BASED ON AND PROVIDED BY THE U.S. COAST GUARD

CONTROLS:
 LOCATION: RIO VISTA
 NOAA STATION: 9415316
 BENCHMARK: 5316 B 1996 (NO PID)
 TIDE GAUGE: NAIL @ 8.2 FT MLLW
 METADATA: NAIL SET BY USACE 31 MARCH, 2014

LOCATION: PORT OF WEST SACRAMENTO
 NOAA STATION: 9416131
 BENCHMARK: POWS1 (NO PID)
 TIDE GAUGE: NAIL @ 10.0 FT MLLW
 METADATA: NAIL SET BY USACE 8 APRIL, 2014

ALL HORIZONTAL POSITIONS AND MLLW ELEVATIONS WERE POST-PROCESSED USING PUBLIC GPS REFERENCE STATIONS IN THE AREA.




DISCLAIMER: The data represents the results of data collection/processing for a specific US Army Corps of Engineers project. It is not intended for use in any other project or application. The user is responsible for the results of any of the application of the data for other than its intended purpose.

Access Constraints: The United States Government furnishes these data and the results of the processing of these data as a public service. The US Army Corps of Engineers does not warrant the accuracy, completeness, or reliability of the data. The user is responsible for the results of any of the application of the data for other than its intended purpose.

Liability: The data represents the results of data collection/processing for a specific US Army Corps of Engineers project. It is not intended for use in any other project or application. The user is responsible for the results of any of the application of the data for other than its intended purpose.

Prepared Under the Direction of TRAVIS J. RAYFIELD LT COLONEL, C.E., DISTRICT ENGINEER	Chart Date: Mar 12, 2018
Standard: Hydro Survey Team Leader	Designed by: PDT
Recommended: Chief, Hydro Survey Section	Plotted by: PDT
Approved: Chief, Construction Branch	Checked by: PDT
	Drawn by: PDT

CALIFORNIA
SACRAMENTO RIVER
CONDITION SURVEY
21, 25, 27-28 FEBRUARY 2018

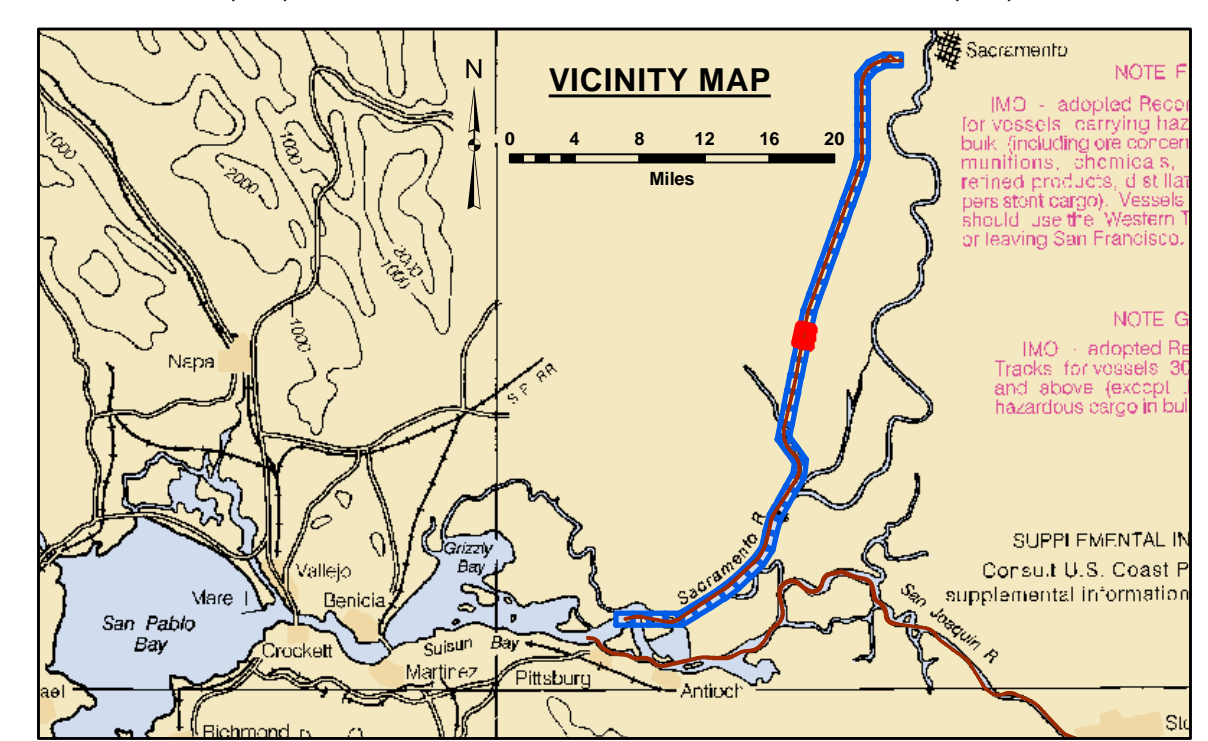

LEGEND

--- Federal Navigation Channel	Cable Area	Shoaling Area	-30
— Federal Navigation Center Line	Placement Area	Shoalest Sounding**	-29
..... Cable Submarine	Anchorage Area	Beacon, General	-28
- - - Cable Overhead	Obstruction Point	Red Navigation Buoy	-27
— Contour Line	Wrecks-Submerged	Green Navigation Buoy	-26

NOTES:
DRAWING NOT TO BE USED FOR NAVIGATION. ONLY CHANNEL CONDITION AT DATE OF SURVEY.
THE LOCATION OF ALL NAVIGATION AIDS ARE BASED ON INFORMATION PROVIDED BY THE U.S. COAST GUARD.
BUOY LOCATIONS REPRESENT THE POSITION OF THE SINKER ONLY.

SOUNDINGS WERE TAKEN BY FATHOMETER AND ARE SHOWN TO THE NEAREST TENTH OF A FOOT.

SOUNDINGS ARE BASED ON THE DATUM OF MEAN LOWER LOW WATER AT THE LOCALITY.

NORTH AMERICAN DATUM OF 1983 (NAD83), PROJECTED TO THE STATE PLANE COORDINATE SYSTEM (SPCS), CA ZONE II (0402). DISTANCE UNITS IN U.S. SURVEY FEET.

PLANE GRID AND COORDINATES ARE BASED ON LAMBERT PROJECTION, NAD 83, ZONE II CALIFORNIA AS DESCRIBED IN SPECIAL PUBLICATION NO. 235, PUBLISHED BY THE NATIONAL OCEAN SURVEY.


PROJECT DEPTH: -30'
VERTICAL DATUM: MLLW

THE LOCATION OF NAVIGATION AIDS ARE BASED ON AND PROVIDED BY THE U.S. COAST GUARD

CONTROLS:
LOCATION: RIO VISTA
NOAA STATION: 9415316
BENCHMARK: 5316 B 1996 (NO PID)
TIDE GAUGE: NAIL @ 8.2 FT MLLW
METADATA: NAIL SET BY USACE 31 MARCH, 2014

LOCATION: PORT OF WEST SACRAMENTO
NOAA STATION: 9416131
BENCHMARK: POWS1 (NO PID)
TIDE GAUGE: NAIL @ 10.0 FT MLLW
METADATA: NAIL SET BY USACE 8 APRIL, 2014


ALL HORIZONTAL POSITIONS AND MLLW ELEVATIONS WERE POST-PROCESSED USING PUBLIC GPS REFERENCE STATIONS IN THE AREA.

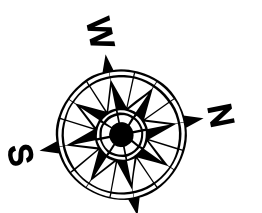



DISCLAIMER: The data represents the results of data collection/processing for a specific US Army Corps of Engineers project. It is not intended for use for any other purpose. Accuracy of the data is not guaranteed. The user is responsible for the results of any application of the data for other than its intended purpose. 

Prepared Under the Direction of TRAVIS J. RAYFIELD LT COLONEL, C.E., DISTRICT ENGINEER	Chart Date: Mar 12, 2018
Submitted: Hydro Survey Team Leader	Designed by: PDT
Recommended: Chief, Hydro Survey Section	Drawn by: PDT
Approved: Chief, Construction Branch	
Surveyed By:	
Plotted By:	
Checked By:	

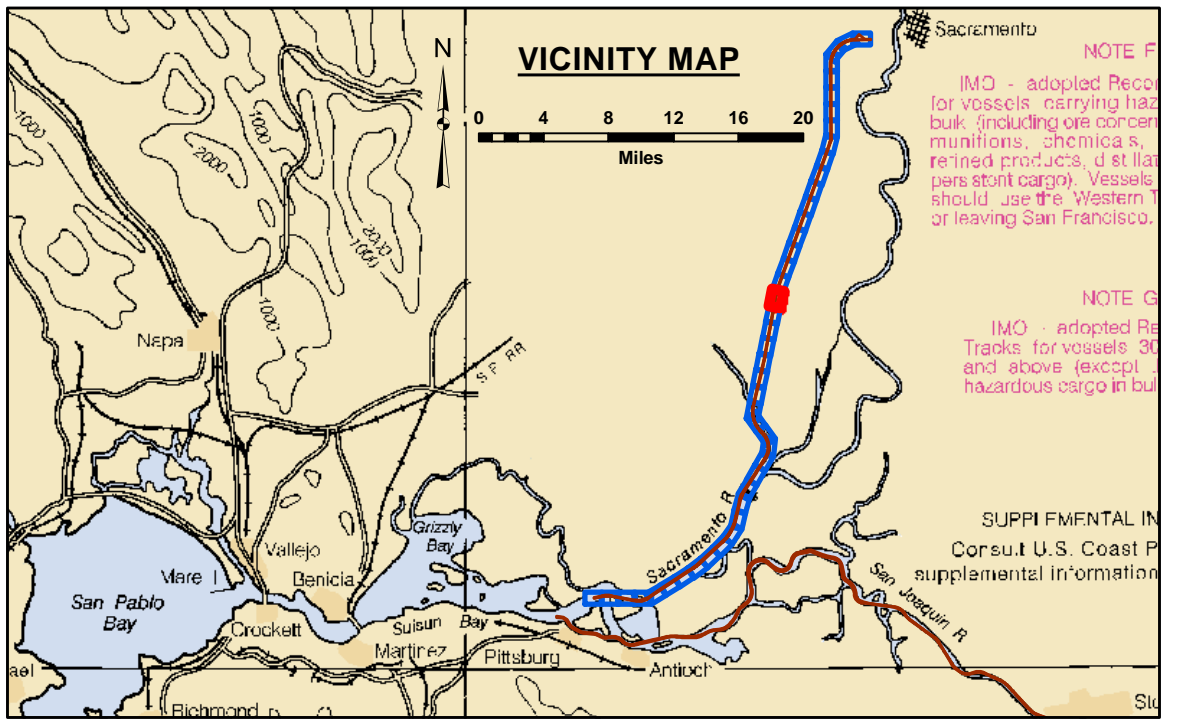

LEGEND		
--- Federal Navigation Channel	Cable Area	Shoaling Area
— Federal Navigation Center Line	Placement Area	Shoalest Sounding**
..... Cable Submarine	Anchorage Area	Beacon, General
- - - Cable Overhead	Obstruction Point	Red Navigation Buoy
— Contour Line	Wrecks-Submerged	Green Navigation Buoy


Contours	
	-30
	-29
	-28
	-27
	-26

NOTES:
DRAWING NOT TO BE USED FOR NAVIGATION. ONLY CHANNEL CONDITION AT DATE OF SURVEY.
THE LOCATION OF ALL NAVIGATION AIDS ARE BASED ON INFORMATION PROVIDED BY THE U.S. COAST GUARD.
BUOY LOCATIONS REPRESENT THE POSITION OF THE SINKER ONLY.
SOUNDINGS WERE TAKEN BY FATHOMETER AND ARE SHOWN TO THE NEAREST TENTH OF A FOOT.
SOUNDINGS ARE BASED ON THE DATUM OF MEAN LOWER LOW WATER AT THE LOCALITY.
NORTH AMERICAN DATUM OF 1983 (NAD83), PROJECTED TO THE STATE PLANE COORDINATE SYSTEM (SPCS),
CA ZONE II (0402), DISTANCE UNITS IN U.S. SURVEY FEET.
PLANE GRID AND COORDINATES ARE BASED ON LAMBERT PROJECTION, NAD 83,
ZONE II CALIFORNIA AS DESCRIBED IN SPECIAL PUBLICATION NO. 235,
PUBLISHED BY THE NATIONAL OCEAN SURVEY.
PROJECT DEPTH: -30'
VERTICAL DATUM: MLLW
THE LOCATION OF NAVIGATION AIDS ARE BASED ON AND PROVIDED BY THE U.S. COAST GUARD

CONTROLS:
LOCATION: RIO VISTA
NOAA STATION: 9415316
BENCHMARK: 5316 B 1996 (NO PID)
TIDE GAUGE: NAIL @ 8.2 FT MLLW
METADATA: NAIL SET BY USACE 31 MARCH, 2014
LOCATION: PORT OF WEST SACRAMENTO
NOAA STATION: 9416131
BENCHMARK: POWS1 (NO PID)
TIDE GAUGE: NAIL @ 10.0 FT MLLW
METADATA: NAIL SET BY USACE 8 APRIL, 2014
ALL HORIZONTAL POSITIONS AND MLLW ELEVATIONS WERE POST-PROCESSED USING PUBLIC GPS REFERENCE STATIONS IN THE AREA.



CALIFORNIA
SACRAMENTO RIVER
CONDITION SURVEY
21, 25, 27-28 FEBRUARY 2018
SAN JOAQUIN COUNTY

Sheet Reference Number
27 of 45

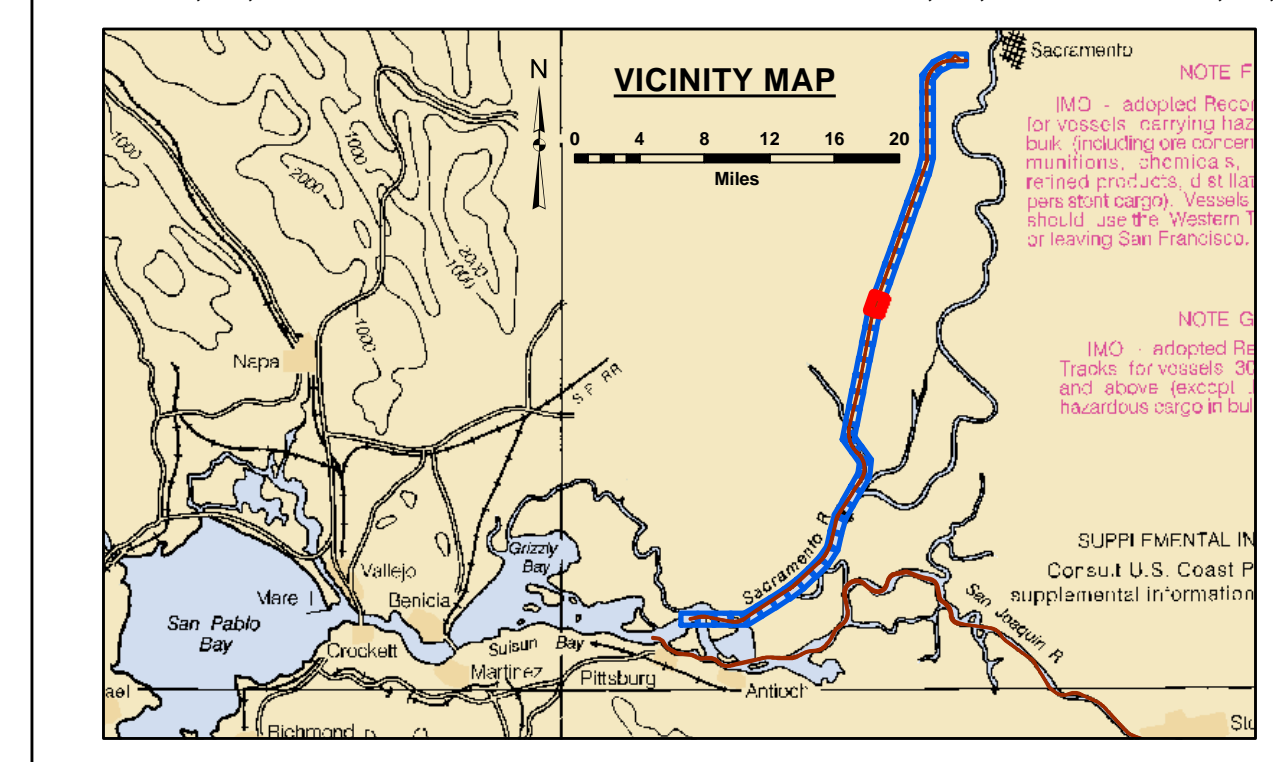

LEGEND

--- Federal Navigation Channel	Cable Area	Shoaling Area	-30
— Federal Navigation Center Line	Placement Area	Shoalest Sounding**	-29
..... Cable Submarine	Anchorage Area	Beacon, General	-28
- - - Cable Overhead	Obstruction Point	Red Navigation Buoy	-27
— Contour Line	Wrecks-Submerged	Green Navigation Buoy	-26

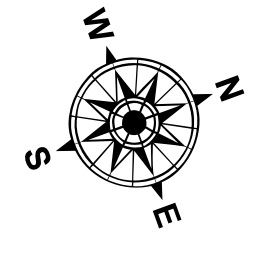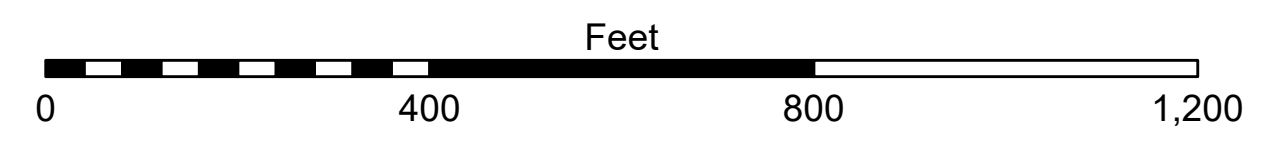

NOTES:
DRAWING NOT TO BE USED FOR NAVIGATION. ONLY CHANNEL CONDITION AT DATE OF SURVEY.
THE LOCATION OF ALL NAVIGATION AIDS ARE BASED ON INFORMATION PROVIDED BY THE U.S. COAST GUARD.
BUOY LOCATIONS REPRESENT THE POSITION OF THE SINKER ONLY.

SOUNDINGS WERE TAKEN BY FATHOMETER AND ARE SHOWN TO THE NEAREST TENTH OF A FOOT.
SOUNDINGS ARE BASED ON THE DATUM OF MEAN LOWER LOW WATER AT THE LOCALITY.

NORTH AMERICAN DATUM OF 1983 (NAD83), PROJECTED TO THE STATE PLANE COORDINATE SYSTEM (SPCS), ZONE II CALIFORNIA AS DESCRIBED IN SPECIAL PUBLICATION NO. 235, PUBLISHED BY THE NATIONAL OCEAN SURVEY.

PROJECT DEPTH: -30'
VERTICAL DATUM: MLLW

THE LOCATION OF NAVIGATION AIDS ARE BASED ON AND PROVIDED BY THE U.S. COAST GUARD

CONTROLS:
LOCATION: RIO VISTA
NOAA STATION: 9415316
BENCHMARK: 5316 B 1996 (NO PID)
TIDE GAUGE: NAIL @ 8.2 FT MLLW
METADATA: NAIL SET BY USACE 31 MARCH, 2014

LOCATION: PORT OF WEST SACRAMENTO
NOAA STATION: 9416131
BENCHMARK: POWS1 (NO PID)
TIDE GAUGE: NAIL @ 10.0 FT MLLW
METADATA: NAIL SET BY USACE 8 APRIL, 2014

ALL HORIZONTAL POSITIONS AND MLLW ELEVATIONS WERE POST-PROCESSED USING PUBLIC GPS REFERENCE STATIONS IN THE AREA.



DISCLAIMER: The United States Government furnishes these data and the information contained herein for the use of the recipient and does not warrant the accuracy, completeness, or reliability of the data. The recipient agrees to accept the data as provided and to release the United States Government from all liability whatsoever for any errors or omissions in the data. The recipient may not transfer these data to others without also transferring this Disclaimer.

Chart Date:	Mar 12, 2018
Designed by:	PDT
Drawn by:	PDT
Surveyed By:	TRAVIS J. RAYFIELD LT COLONEL, C.E. DISTRICT ENGINEER
Plotted By:	PDT
Checked By:	PDT
Approved:	Chief, Hydro Survey Section
Approved:	Chief, Construction Branch

CALIFORNIA
SAN JOAQUIN COUNTY
SACRAMENTO RIVER
CONDITION SURVEY
21, 25, 27-28 FEBRUARY 2018

Sheet Reference Number
28 of 45






DISCLAIMER: The United States Government furnishes these data and the information contained herein with the express understanding that it is not to be used for any purpose other than that for which it was prepared. The user is responsible for the results of any application of the data for other than its intended purpose. The United States Government assumes no liability whatsoever for any person by reason of any use of the information and the data furnished. This liability shall be the responsibility of the user. The recipient may not transfer these data to others without also transferring this Disclaimer.

Prepared Under the Direction of TRAVIS J. RAYFIELD LT Colonel, C.E., District Engineer	Chart Date: Mar 12, 2018
Submitted: Hydro Survey Team Leader	Designed by: PDT
Recommended: Chief, Hydro Survey Section	Drawn by: PDT
Approved: Chief, Construction Branch	

CALIFORNIA
SAN JOAQUIN COUNTY
SACRAMENTO RIVER
CONDITION SURVEY
21, 25, 27-28 FEBRUARY 2018

Sheet Reference Number
29 of 45

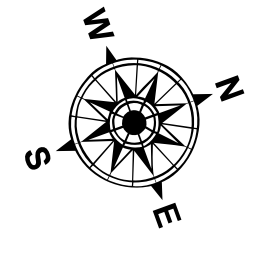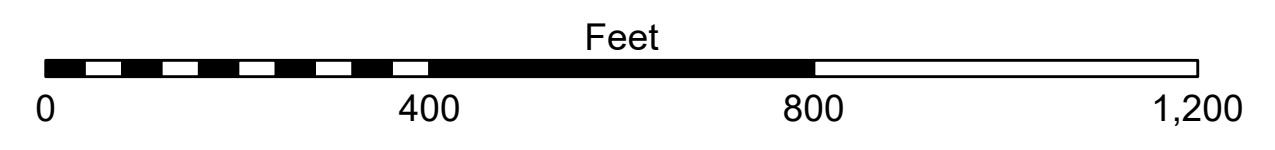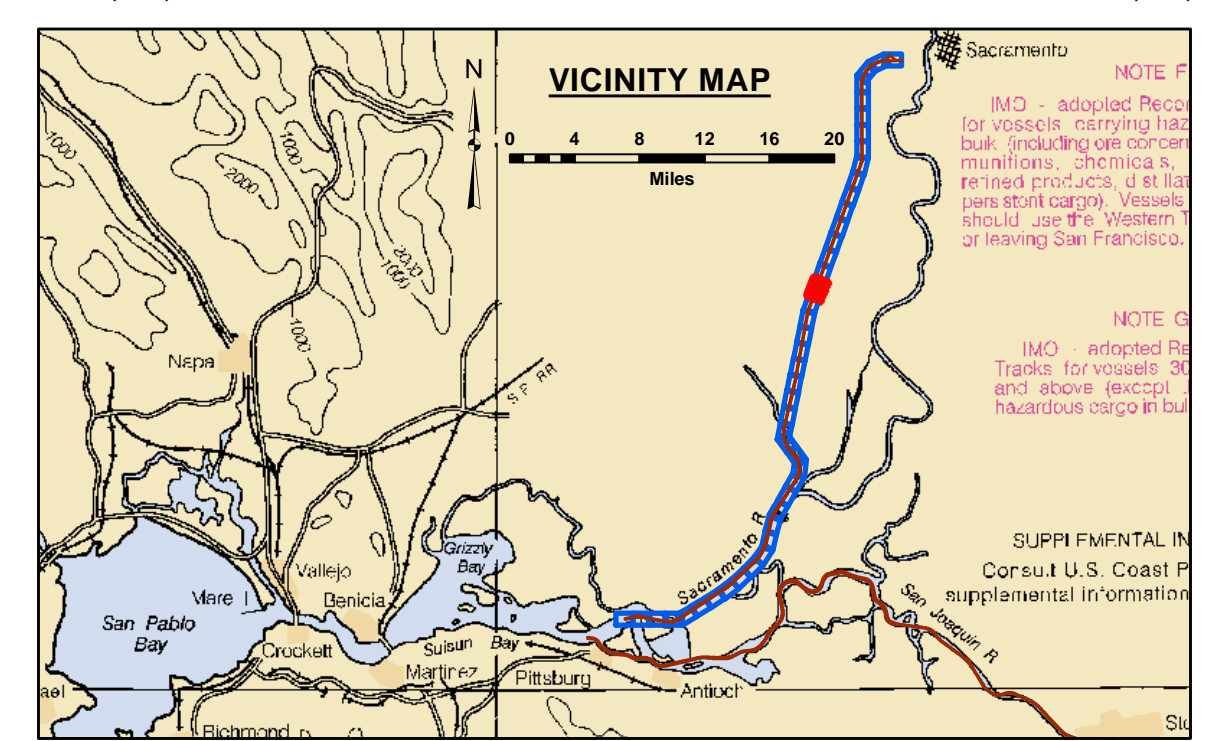

LEGEND			
--- Federal Navigation Channel	▨ Cable Area	■ Shoaling Area	— Contours
— Federal Navigation Center Line	□ Placement Area	● Shoalest Sounding**	— -30
⋯ Cable Submarine	⊠ Anchorage Area	⊥ Beacon, General	— -29
- - - Cable Overhead	⊗ Obstruction Point	◆ Red Navigation Buoy	— -28
— Contour Line	✦ Wrecks-Submerged	◆ Green Navigation Buoy	— -27
			— -26

NOTES:
DRAWING NOT TO BE USED FOR NAVIGATION. ONLY CHANNEL CONDITION AT DATE OF SURVEY.
THE LOCATION OF ALL NAVIGATION AIDS ARE BASED ON INFORMATION PROVIDED BY THE U.S. COAST GUARD.
BUOY LOCATIONS REPRESENT THE POSITION OF THE SINKER ONLY.

SOUNDINGS WERE TAKEN BY FATHOMETER AND ARE SHOWN TO THE NEAREST TENTH OF A FOOT.

SOUNDINGS ARE BASED ON THE DATUM OF MEAN LOWER LOW WATER AT THE LOCALITY.

NORTH AMERICAN DATUM OF 1983 (NAD83), PROJECTED TO THE STATE PLANE COORDINATE SYSTEM (SPCS), ZONE II (0402). DISTANCE UNITS IN U.S. SURVEY FEET.

PLANE GRID AND COORDINATES ARE BASED ON LAMBERT PROJECTION, NAD 83, ZONE II CALIFORNIA AS DESCRIBED IN SPECIAL PUBLICATION NO. 235, PUBLISHED BY THE NATIONAL OCEAN SURVEY.


PROJECT DEPTH: -30'
VERTICAL DATUM: MLLW

THE LOCATION OF NAVIGATION AIDS ARE BASED ON AND PROVIDED BY THE U.S. COAST GUARD

CONTROLS:
LOCATION: RIO VISTA
NOAA STATION: 9415316
BENCHMARK: 5316 B 1996 (NO PID)
TIDE GAUGE: NAIL @ 8.2 FT MLLW
METADATA: NAIL SET BY USACE 31 MARCH, 2014


LOCATION: PORT OF WEST SACRAMENTO
NOAA STATION: 9416131
BENCHMARK: POWS1 (NO PID)
TIDE GAUGE: NAIL @ 10.0 FT MLLW
METADATA: NAIL SET BY USACE 8 APRIL, 2014

ALL HORIZONTAL POSITIONS AND MLLW ELEVATIONS WERE POST-PROCESSED USING PUBLIC GPS REFERENCE STATIONS IN THE AREA.

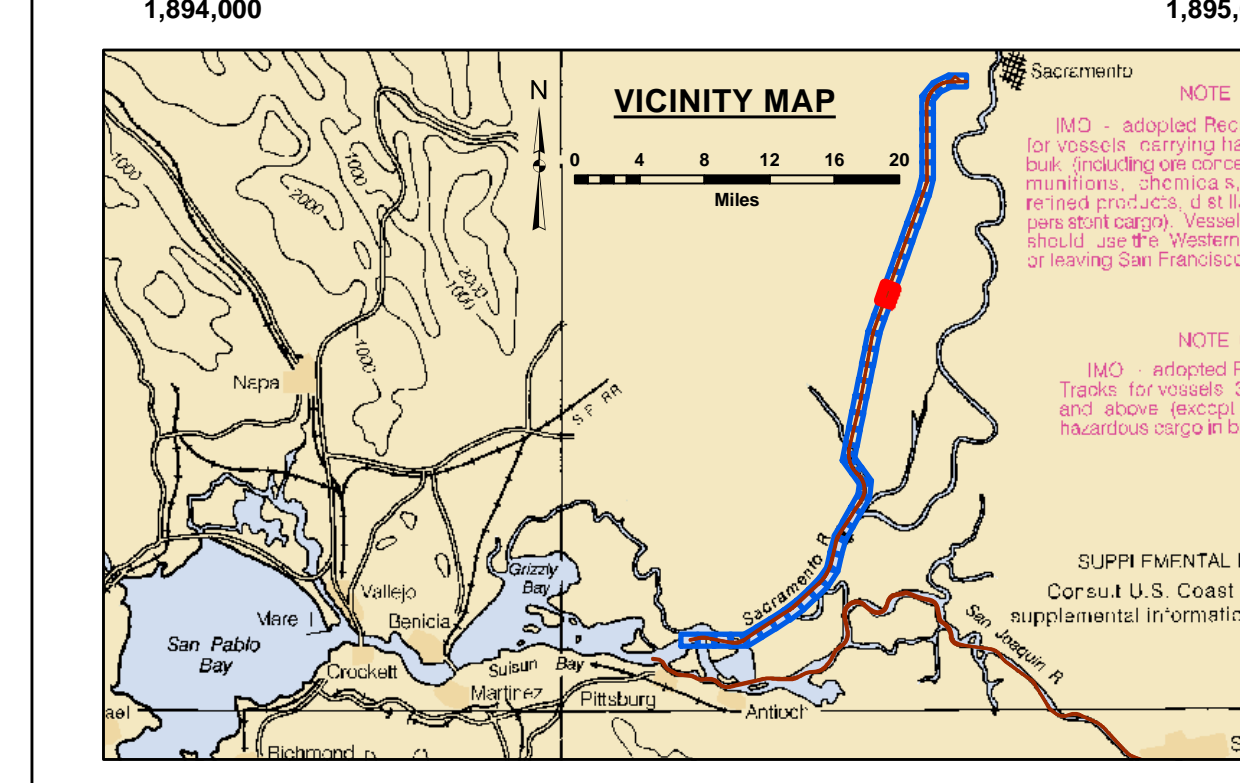

LEGEND

--- Federal Navigation Channel	[Hatched Box] Cable Area	[Pink Box] Shoaling Area	— -30
— Federal Navigation Center Line	[White Box] Placement Area	[Yellow Dot] Shoalest Sounding**	— -29
..... Cable Submarine	[Dashed Box] Anchorage Area	[T-shaped Symbol] Beacon, General	— -28
- - - Cable Overhead	[X Symbol] Obstruction Point	[Red Diamond] Red Navigation Buoy	— -27
— Contour Line	[Star Symbol] Wrecks-Submerged	[Green Diamond] Green Navigation Buoy	— -26

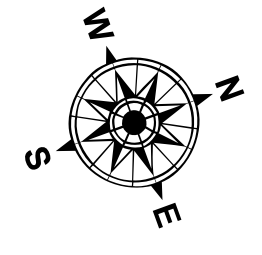

NOTES:
 DRAWING NOT TO BE USED FOR NAVIGATION. ONLY CHANNEL CONDITION AT DATE OF SURVEY.
 THE LOCATION OF ALL NAVIGATION AIDS ARE BASED ON INFORMATION PROVIDED BY THE U.S. COAST GUARD.
 BUOY LOCATIONS REPRESENT THE POSITION OF THE SINKER ONLY.

SOUNDINGS WERE TAKEN BY FATHOMETER AND ARE SHOWN TO THE NEAREST TENTH OF A FOOT.

SOUNDINGS ARE BASED ON THE DATUM OF MEAN LOWER LOW WATER AT THE LOCALITY.

NORTH AMERICAN DATUM OF 1983 (NAD83), PROJECTED TO THE STATE PLANE COORDINATE SYSTEM (SPCS), ZONE II (0402). DISTANCE UNITS IN U.S. SURVEY FEET.

PLANE GRID AND COORDINATES ARE BASED ON LAMBERT PROJECTION, NAD 83, ZONE II CALIFORNIA AS DESCRIBED IN SPECIAL PUBLICATION NO. 235, PUBLISHED BY THE NATIONAL OCEAN SURVEY.

PROJECT DEPTH: -30'
 VERTICAL DATUM: MLLW

THE LOCATION OF NAVIGATION AIDS ARE BASED ON AND PROVIDED BY THE U.S. COAST GUARD

CONTROLS:
 LOCATION: RIO VISTA
 NOAA STATION: 9415316
 BENCHMARK: 5316 B 1996 (NO PID)
 TIDE GAUGE: NAIL @ 8.2 FT MLLW
 METADATA: NAIL SET BY USACE 31 MARCH, 2014

LOCATION: PORT OF WEST SACRAMENTO
 NOAA STATION: 9416131
 BENCHMARK: POWS1 (NO PID)
 TIDE GAUGE: NAIL @ 10.0 FT MLLW
 METADATA: NAIL SET BY USACE 8 APRIL, 2014

ALL HORIZONTAL POSITIONS AND MLLW ELEVATIONS WERE POST-PROCESSED USING PUBLIC GPS REFERENCE STATIONS IN THE AREA.



DISCLAIMER: The data represents the results of data collection/processing for a specific US Army Corps of Engineers project. It is only valid for its intended use and accuracy. The user is responsible for the results of any application of the data for other than its intended purposes.





Chart Date:	Mar 12, 2018
Designed by:	PDT
Drawn by:	PDT
Checked by:	PDT
Approved:	Chief, Construction Branch
Surveyed By:	LT COLONEL C.E. DISTRICT ENGINEER
Plotted By:	Hydro Survey Team Leader
Checked By:	Chief, Hydro Survey Section
Approved:	Chief, Construction Branch

CALIFORNIA



SACRAMENTO RIVER
 CONDITION SURVEY
 21, 25, 27-28 FEBRUARY 2018

Sheet Reference Number
30 of 45

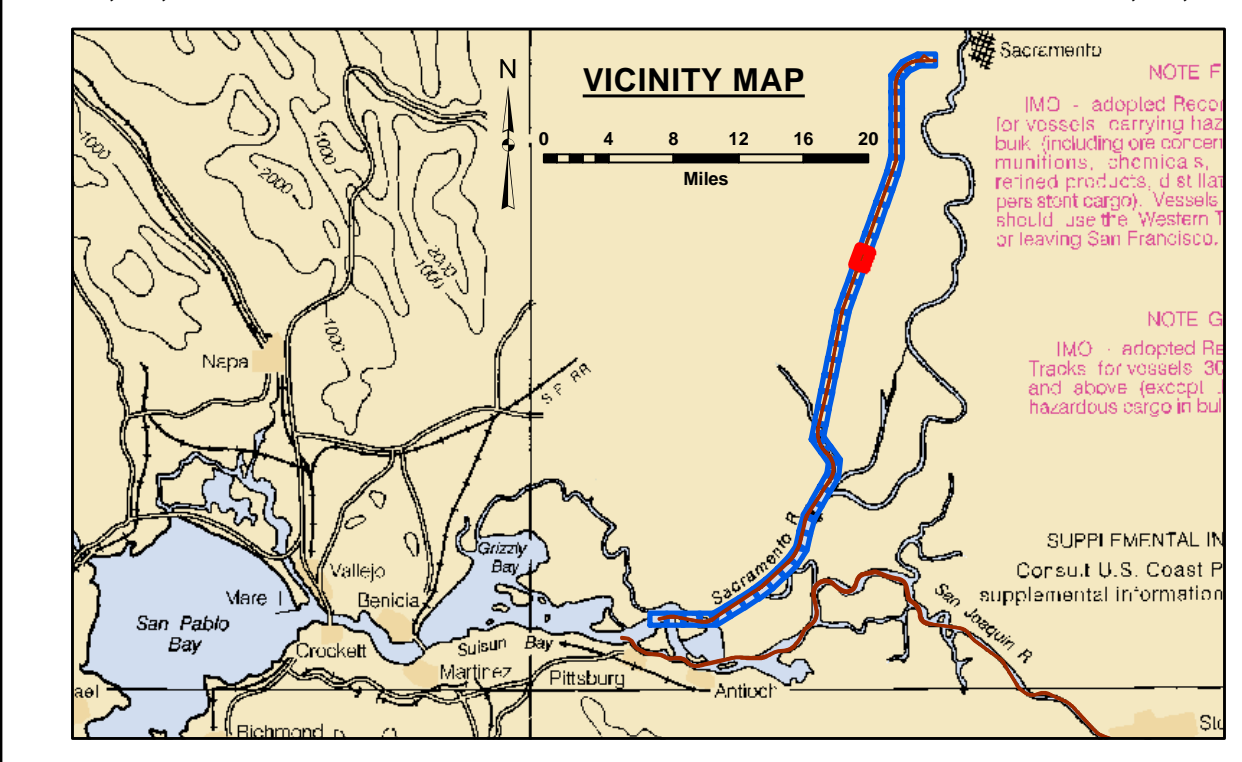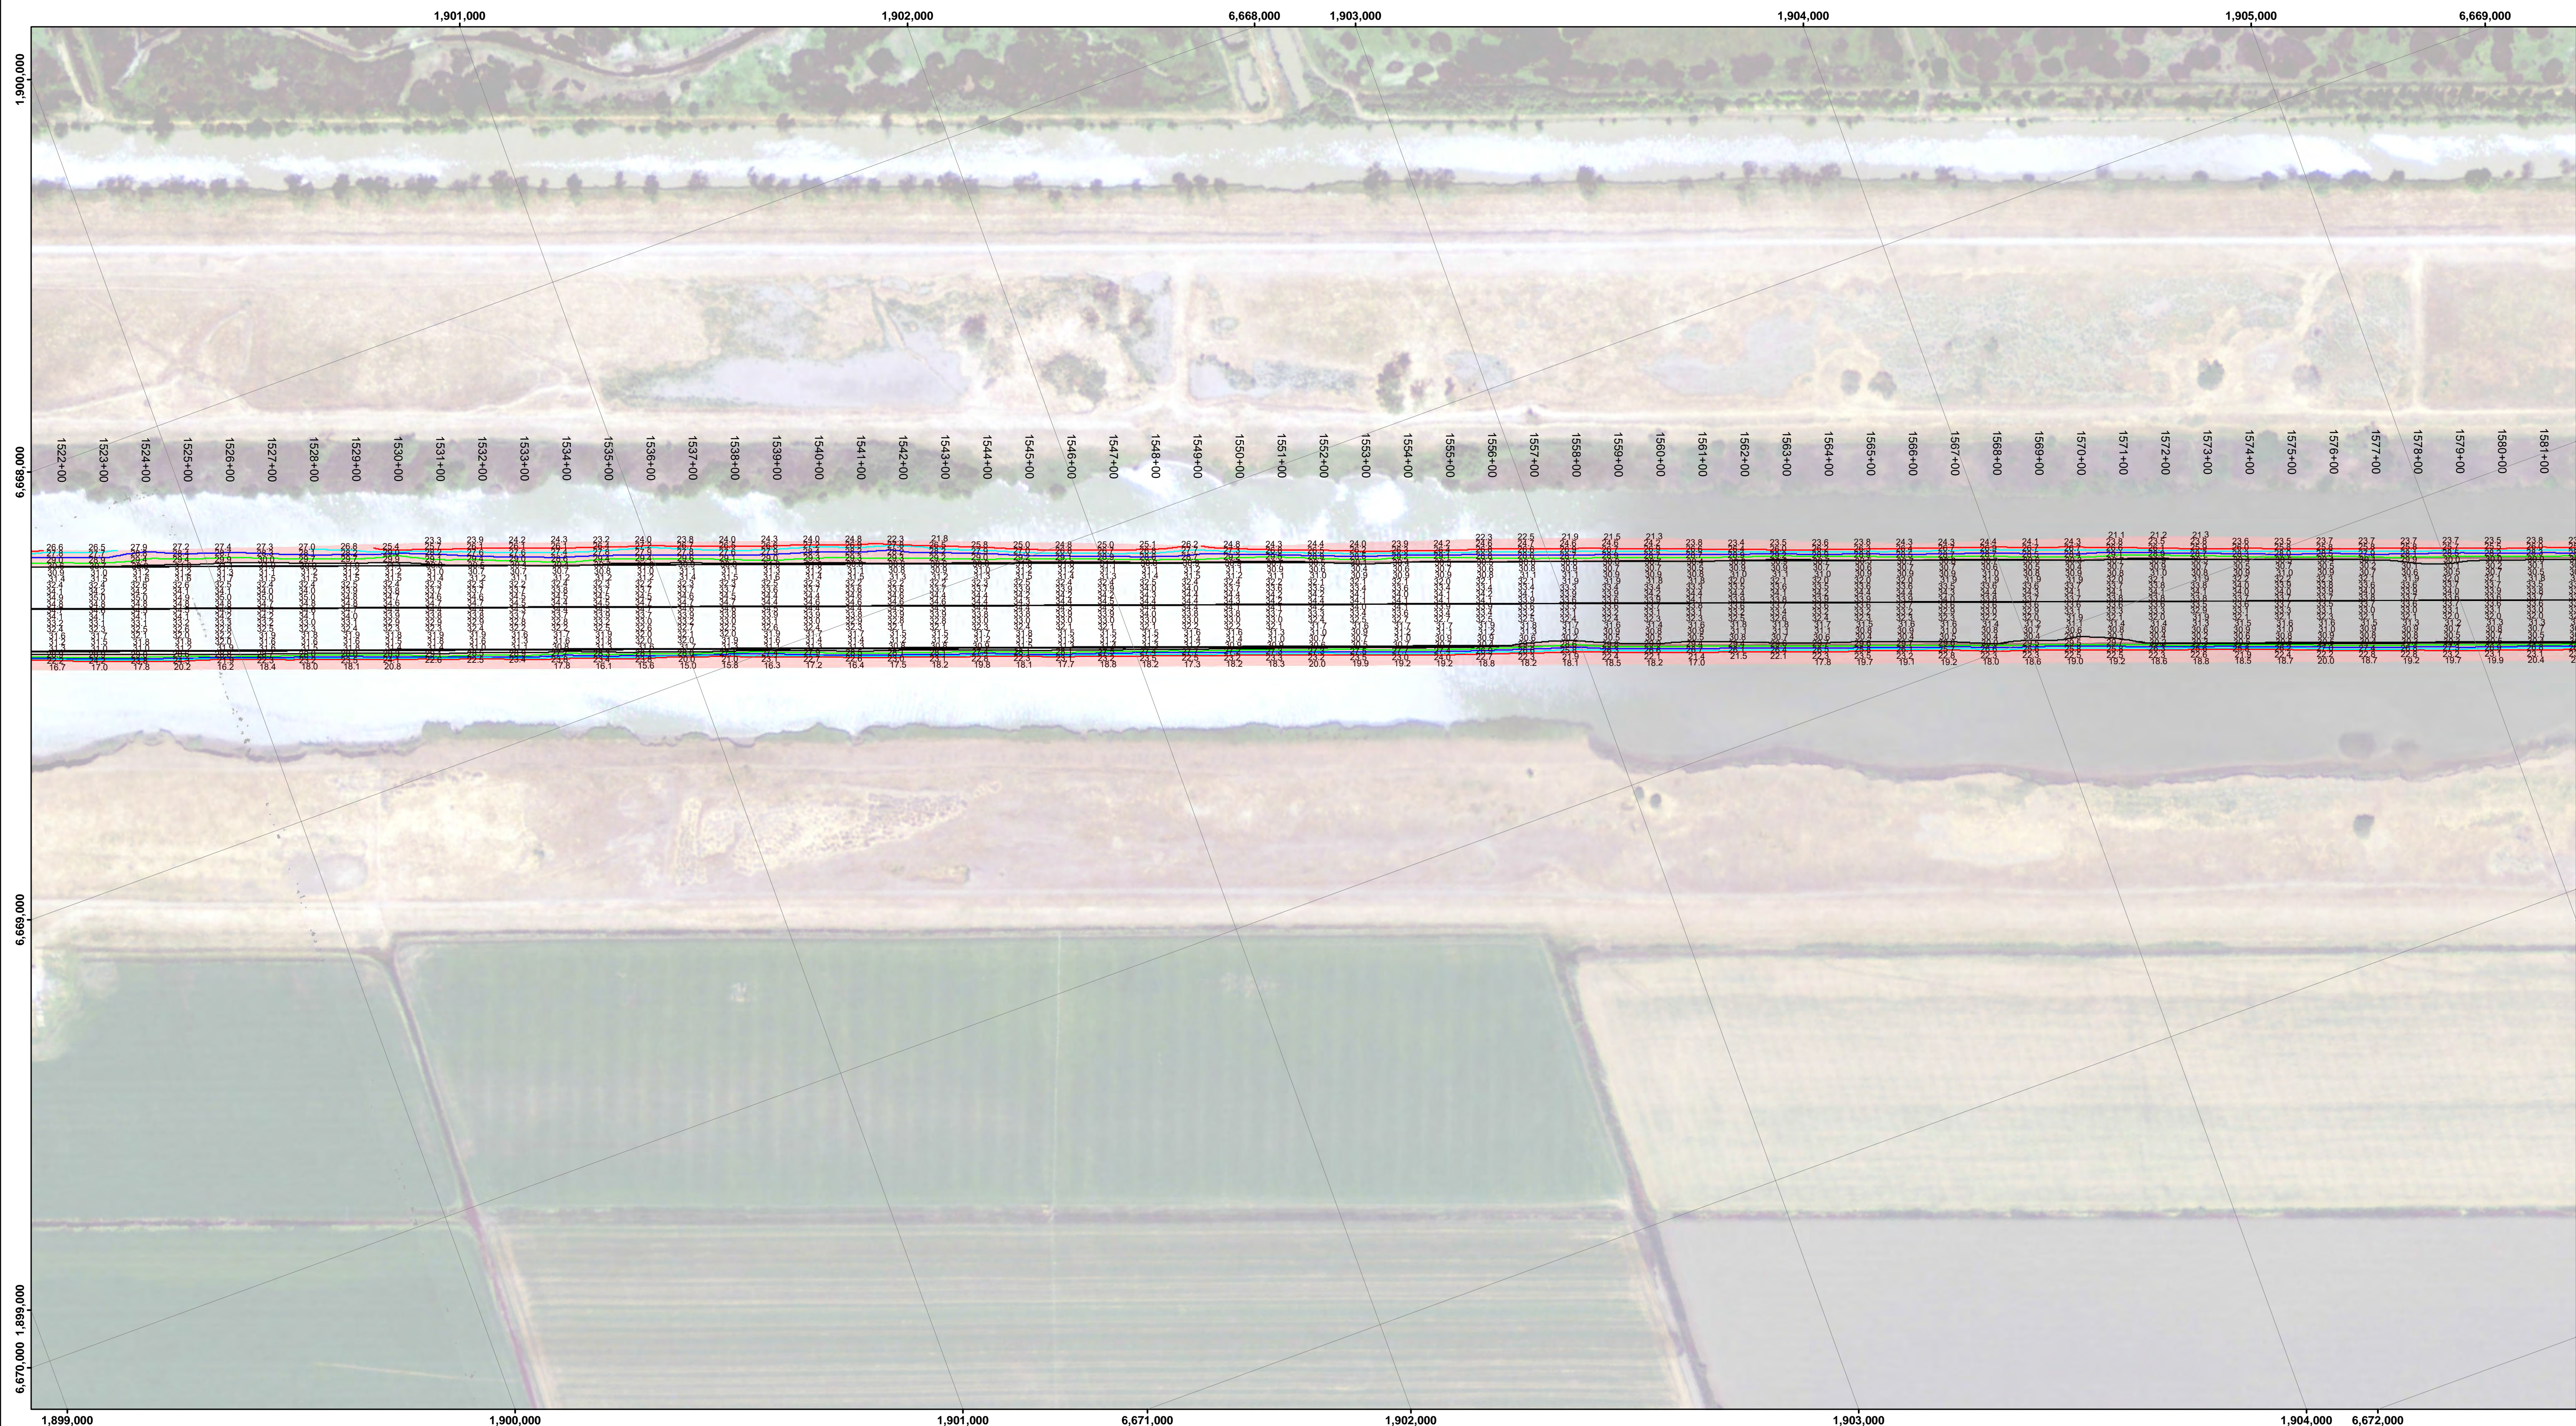

LEGEND

--- Federal Navigation Channel	Cable Area	Shoaling Area	-30
— Federal Navigation Center Line	Placement Area	Shoalest Sounding**	-29
..... Cable Submarine	Anchorage Area	Beacon, General	-28
- - - Cable Overhead	Obstruction Point	Red Navigation Buoy	-27
— Contour Line	Wrecks-Submerged	Green Navigation Buoy	-26

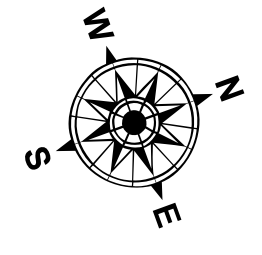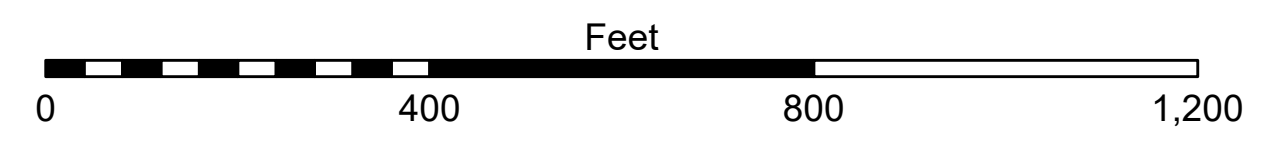

NOTES:
 DRAWING NOT TO BE USED FOR NAVIGATION. ONLY CHANNEL CONDITION AT DATE OF SURVEY.
 THE LOCATION OF ALL NAVIGATION AIDS ARE BASED ON INFORMATION PROVIDED BY THE U.S. COAST GUARD.
 BUOY LOCATIONS REPRESENT THE POSITION OF THE SINKER ONLY.

SOUNDINGS WERE TAKEN BY FATHOMETER AND ARE SHOWN TO THE NEAREST TENTH OF A FOOT.

SOUNDINGS ARE BASED ON THE DATUM OF MEAN LOWER LOW WATER AT THE LOCALITY.

NORTH AMERICAN DATUM OF 1983 (NAD83), PROJECTED TO THE STATE PLANE COORDINATE SYSTEM (SPCS), ZONE II CALIFORNIA AS DESCRIBED IN SPECIAL PUBLICATION NO. 235, PUBLISHED BY THE NATIONAL OCEAN SURVEY.

PROJECT DEPTH: -30'
 VERTICAL DATUM: MLLW

THE LOCATION OF NAVIGATION AIDS ARE BASED ON AND PROVIDED BY THE U.S. COAST GUARD

CONTROLS:
 LOCATION: RIO VISTA
 NOAA STATION: 9415316
 BENCHMARK: 5316 B 1996 (NO PID)
 TIDE GAUGE: NAIL @ 8.2 FT MLLW
 METADATA: NAIL SET BY USACE 31 MARCH, 2014

LOCATION: PORT OF WEST SACRAMENTO
 NOAA STATION: 9416131
 BENCHMARK: POWS1 (NO PID)
 TIDE GAUGE: NAIL @ 10.0 FT MLLW
 METADATA: NAIL SET BY USACE 8 APRIL, 2014

ALL HORIZONTAL POSITIONS AND MLLW ELEVATIONS WERE POST-PROCESSED USING PUBLIC GPS REFERENCE STATIONS IN THE AREA.





DISCLAIMER: The United States Government furnishes these data and the results therefrom with the express understanding that the user is responsible for the results expressed or implied concerning the accuracy, completeness, and reliability of the data. The United States shall be under no liability whatsoever to any person by reason of any use of the information and the data furnished. The United States shall be responsible for any use of the data for any purpose other than that for which the recipient fully agrees not to represent these data to anyone as other than Government provided data. The recipient may not transfer these data to others without also transferring this Disclaimer.

Chart Date:	Mar 12, 2018
Surveyed By:	LT COLONEL C.E. DISTRICT ENGINEER
Plotted By:	PDT
Checked By:	PDT
Designed by:	
Drawn by:	PDT



CALIFORNIA
 SAN JOAQUIN COUNTY
SACRAMENTO RIVER
 CONDITION SURVEY
 21, 25, 27-28 FEBRUARY 2018

Sheet Reference Number
 31 of 45

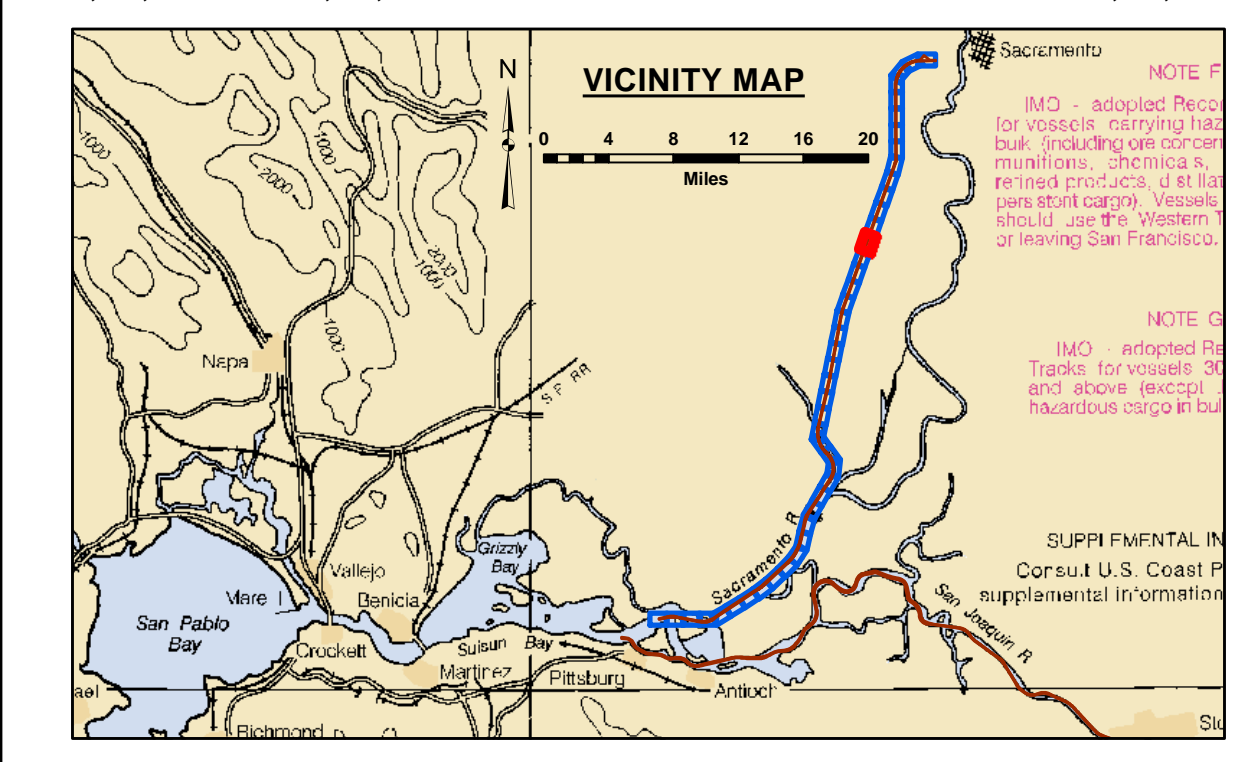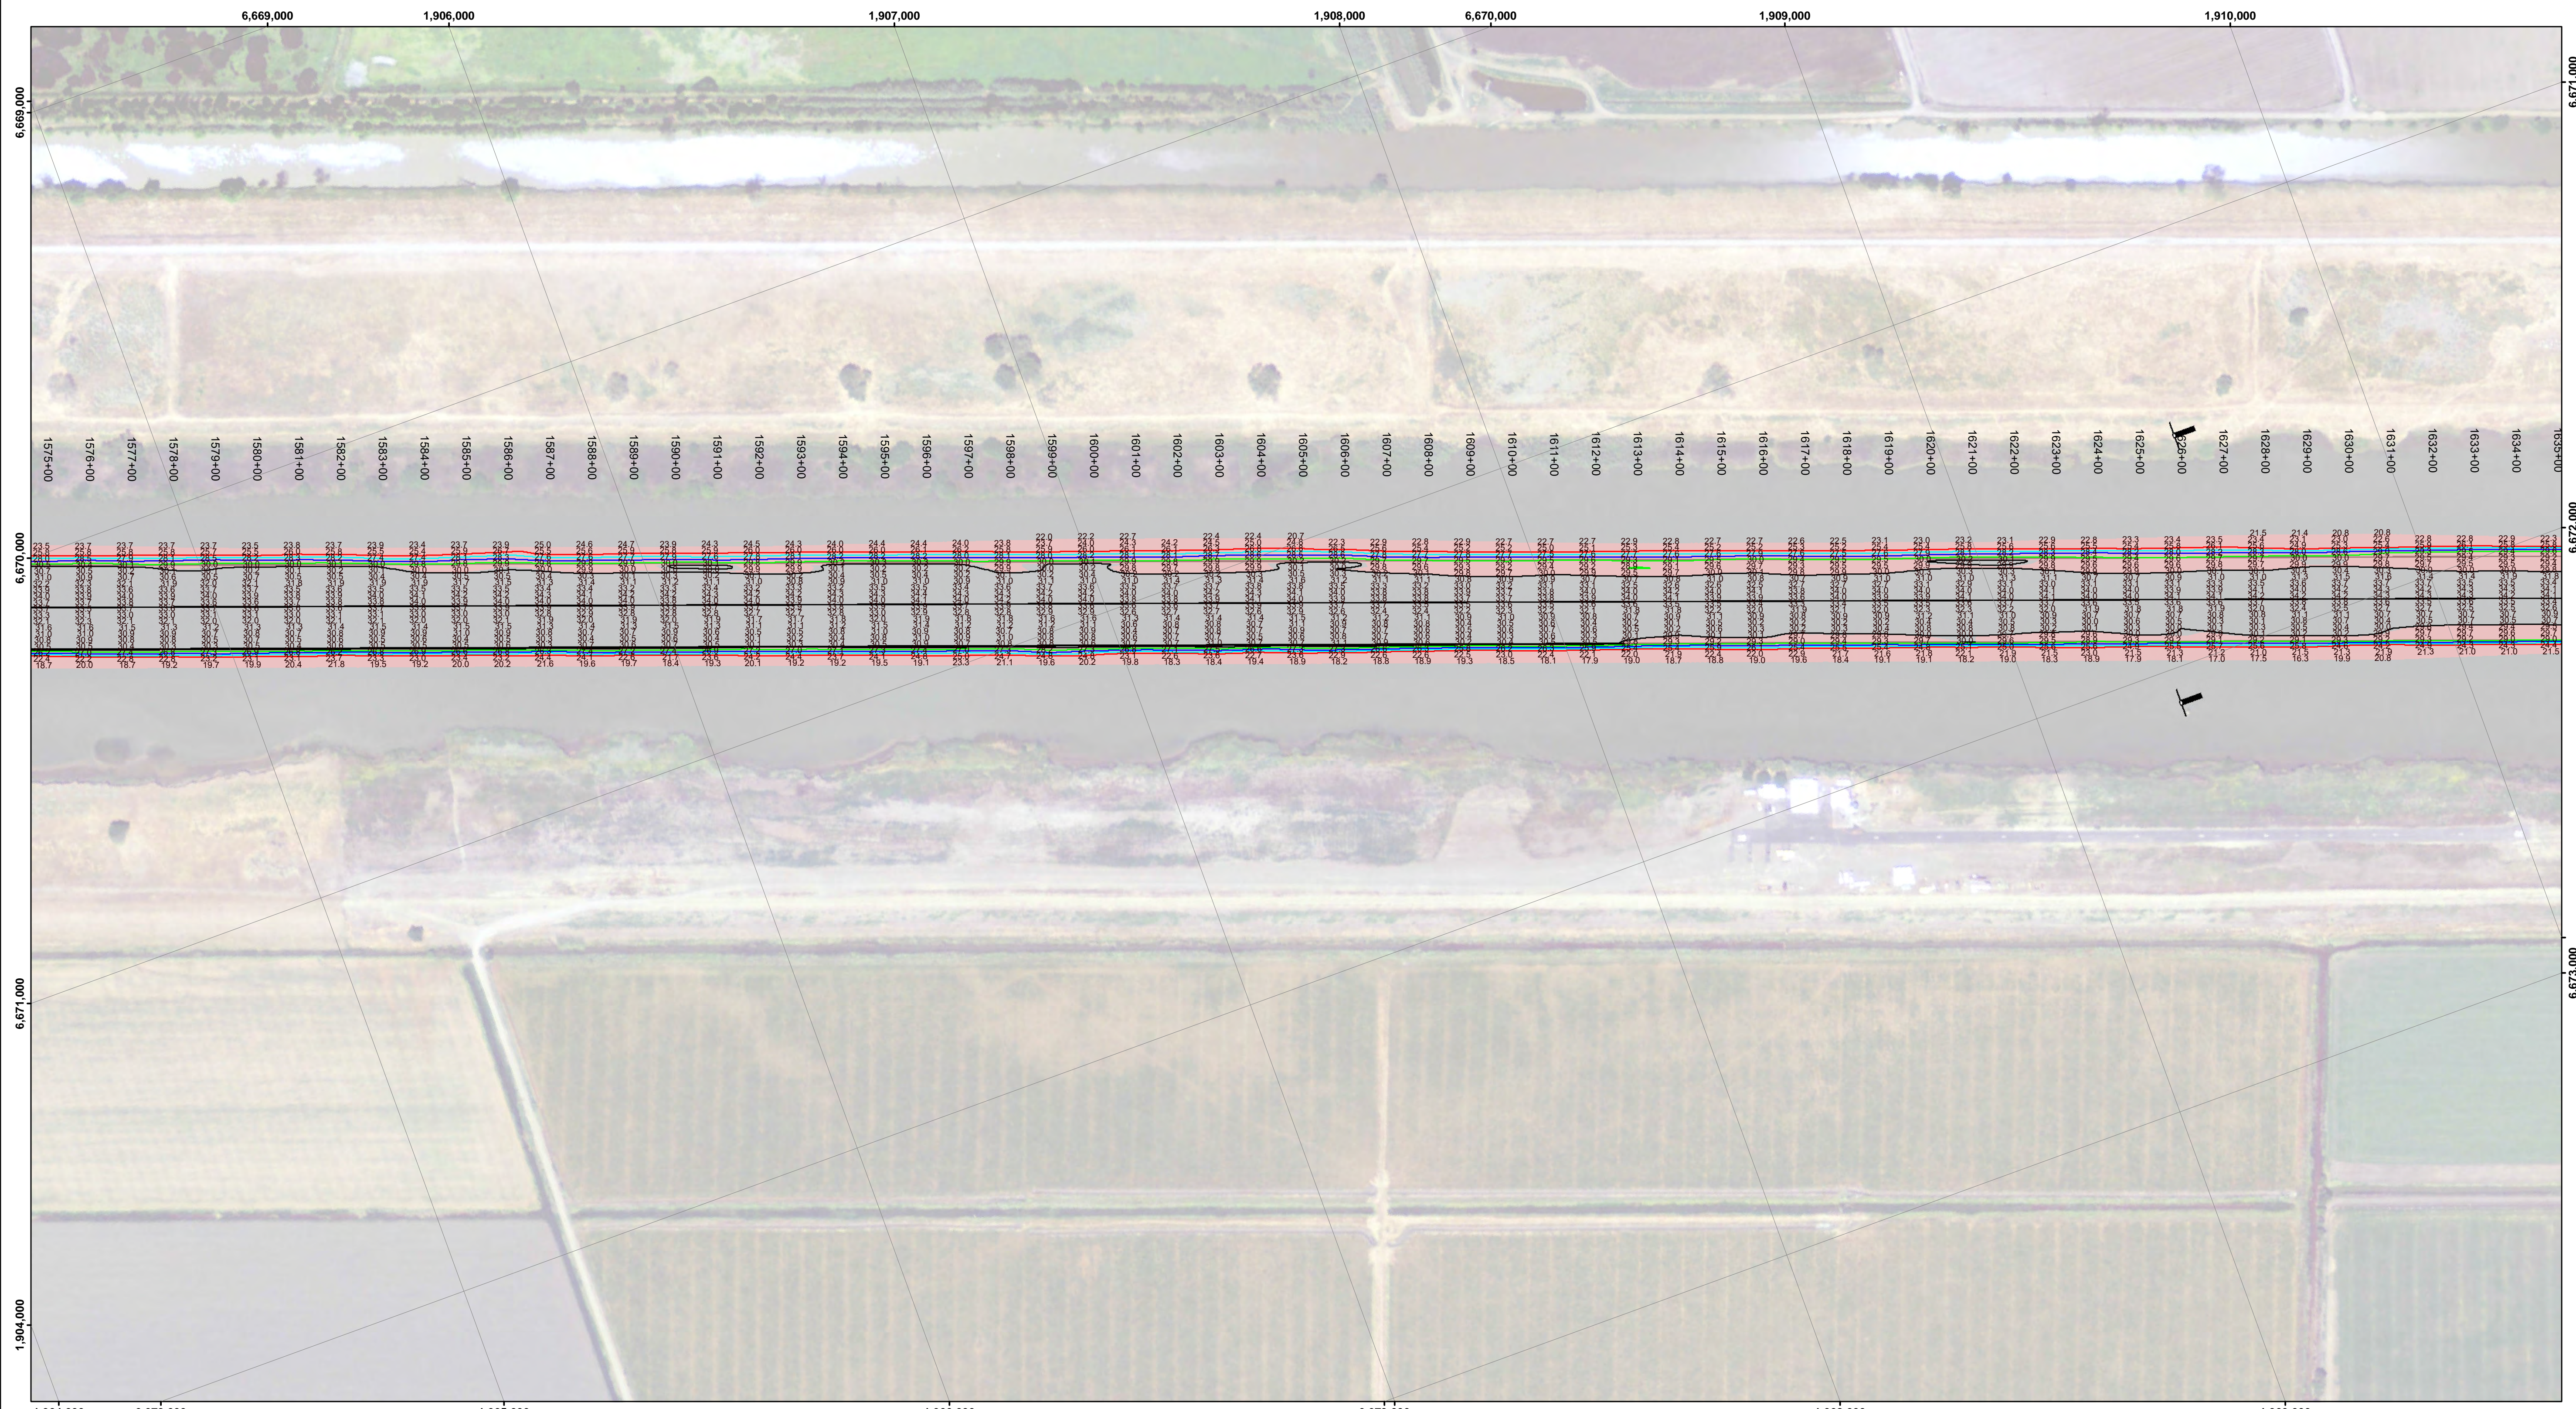

LEGEND

--- Federal Navigation Channel	▨ Cable Area	■ Shoaling Area	— Contours
— Federal Navigation Center Line	□ Placement Area	● Shoalest Sounding**	— -30
⋯ Cable Submarine	⊠ Anchorage Area	⊥ Beacon, General	— -29
- - - Cable Overhead	⊗ Obstruction Point	◆ Red Navigation Buoy	— -28
— Contour Line	✦ Wrecks-Submerged	◆ Green Navigation Buoy	— -27
			— -26

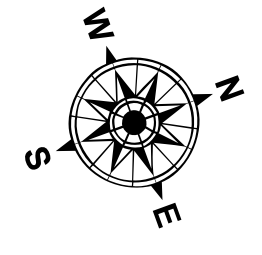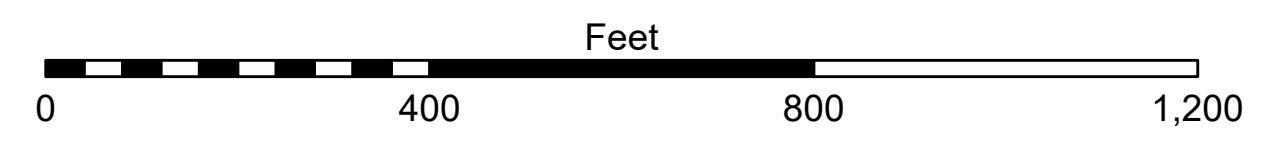

NOTES:
 DRAWING NOT TO BE USED FOR NAVIGATION. ONLY CHANNEL CONDITION AT DATE OF SURVEY.
 THE LOCATION OF ALL NAVIGATION AIDS ARE BASED ON INFORMATION PROVIDED BY THE U.S. COAST GUARD.
 BUOY LOCATIONS REPRESENT THE POSITION OF THE SINKER ONLY.
 SOUNDINGS WERE TAKEN BY FATHOMETER AND ARE SHOWN TO THE NEAREST TENTH OF A FOOT.
 SOUNDINGS ARE BASED ON THE DATUM OF MEAN LOWER LOW WATER AT THE LOCALITY.
 NORTH AMERICAN DATUM OF 1983 (NAD83), PROJECTED TO THE STATE PLANE COORDINATE SYSTEM (SPCS),
 CA ZONE II (0402). DISTANCE UNITS IN U.S. SURVEY FEET.
 PLANE GRID AND COORDINATES ARE BASED ON LAMBERT PROJECTION, NAD 83,
 ZONE II CALIFORNIA AS DESCRIBED IN SPECIAL PUBLICATION NO. 235,
 PUBLISHED BY THE NATIONAL OCEAN SURVEY.
 PROJECT DEPTH: -30'
 VERTICAL DATUM: MLLW
 THE LOCATION OF NAVIGATION AIDS ARE BASED ON AND PROVIDED BY THE U.S. COAST GUARD

CONTROLS:
 LOCATION: RIO VISTA
 NOAA STATION: 9415316
 BENCHMARK: 5316 B 1996 (NO PID)
 TIDE GAUGE: NAIL @ 8.2 FT MLLW
 METADATA: NAIL SET BY USACE 31 MARCH, 2014

LOCATION: PORT OF WEST SACRAMENTO
 NOAA STATION: 9416131
 BENCHMARK: POWS1 (NO PID)
 TIDE GAUGE: NAIL @ 10.0 FT MLLW
 METADATA: NAIL SET BY USACE 8 APRIL, 2014

ALL HORIZONTAL POSITIONS AND MLLW ELEVATIONS WERE POST-PROCESSED USING PUBLIC GPS REFERENCE STATIONS IN THE AREA.




DISCLAIMER: The United States Government furnishes these data and the results of the processing of these data for the use of the recipient for the purposes intended. The recipient agrees to indemnify the United States Government from and hold it harmless from all claims, damages, losses, and expenses, including reasonable attorneys' fees, arising out of or in connection with the use of these data for any purpose other than that for which they were originally prepared or intended. The user is responsible for the results of any application of the data for other than its intended purpose.

Prepared Under the Direction of TRAVIS J. RAYFIELD LT Colonel, C.E., District Engineer	Chart Date: Mar 12, 2018
Standard: Hydro Survey Team Leader	Designed by: PDT
Recommended: Chief, Hydro Survey Section	Drawn by: PDT
Approved: Chief, Construction Branch	

CALIFORNIA
SACRAMENTO RIVER
 CONDITION SURVEY
 21, 25, 27-28 FEBRUARY 2018

Sheet
 Reference
 Number
32 of 45


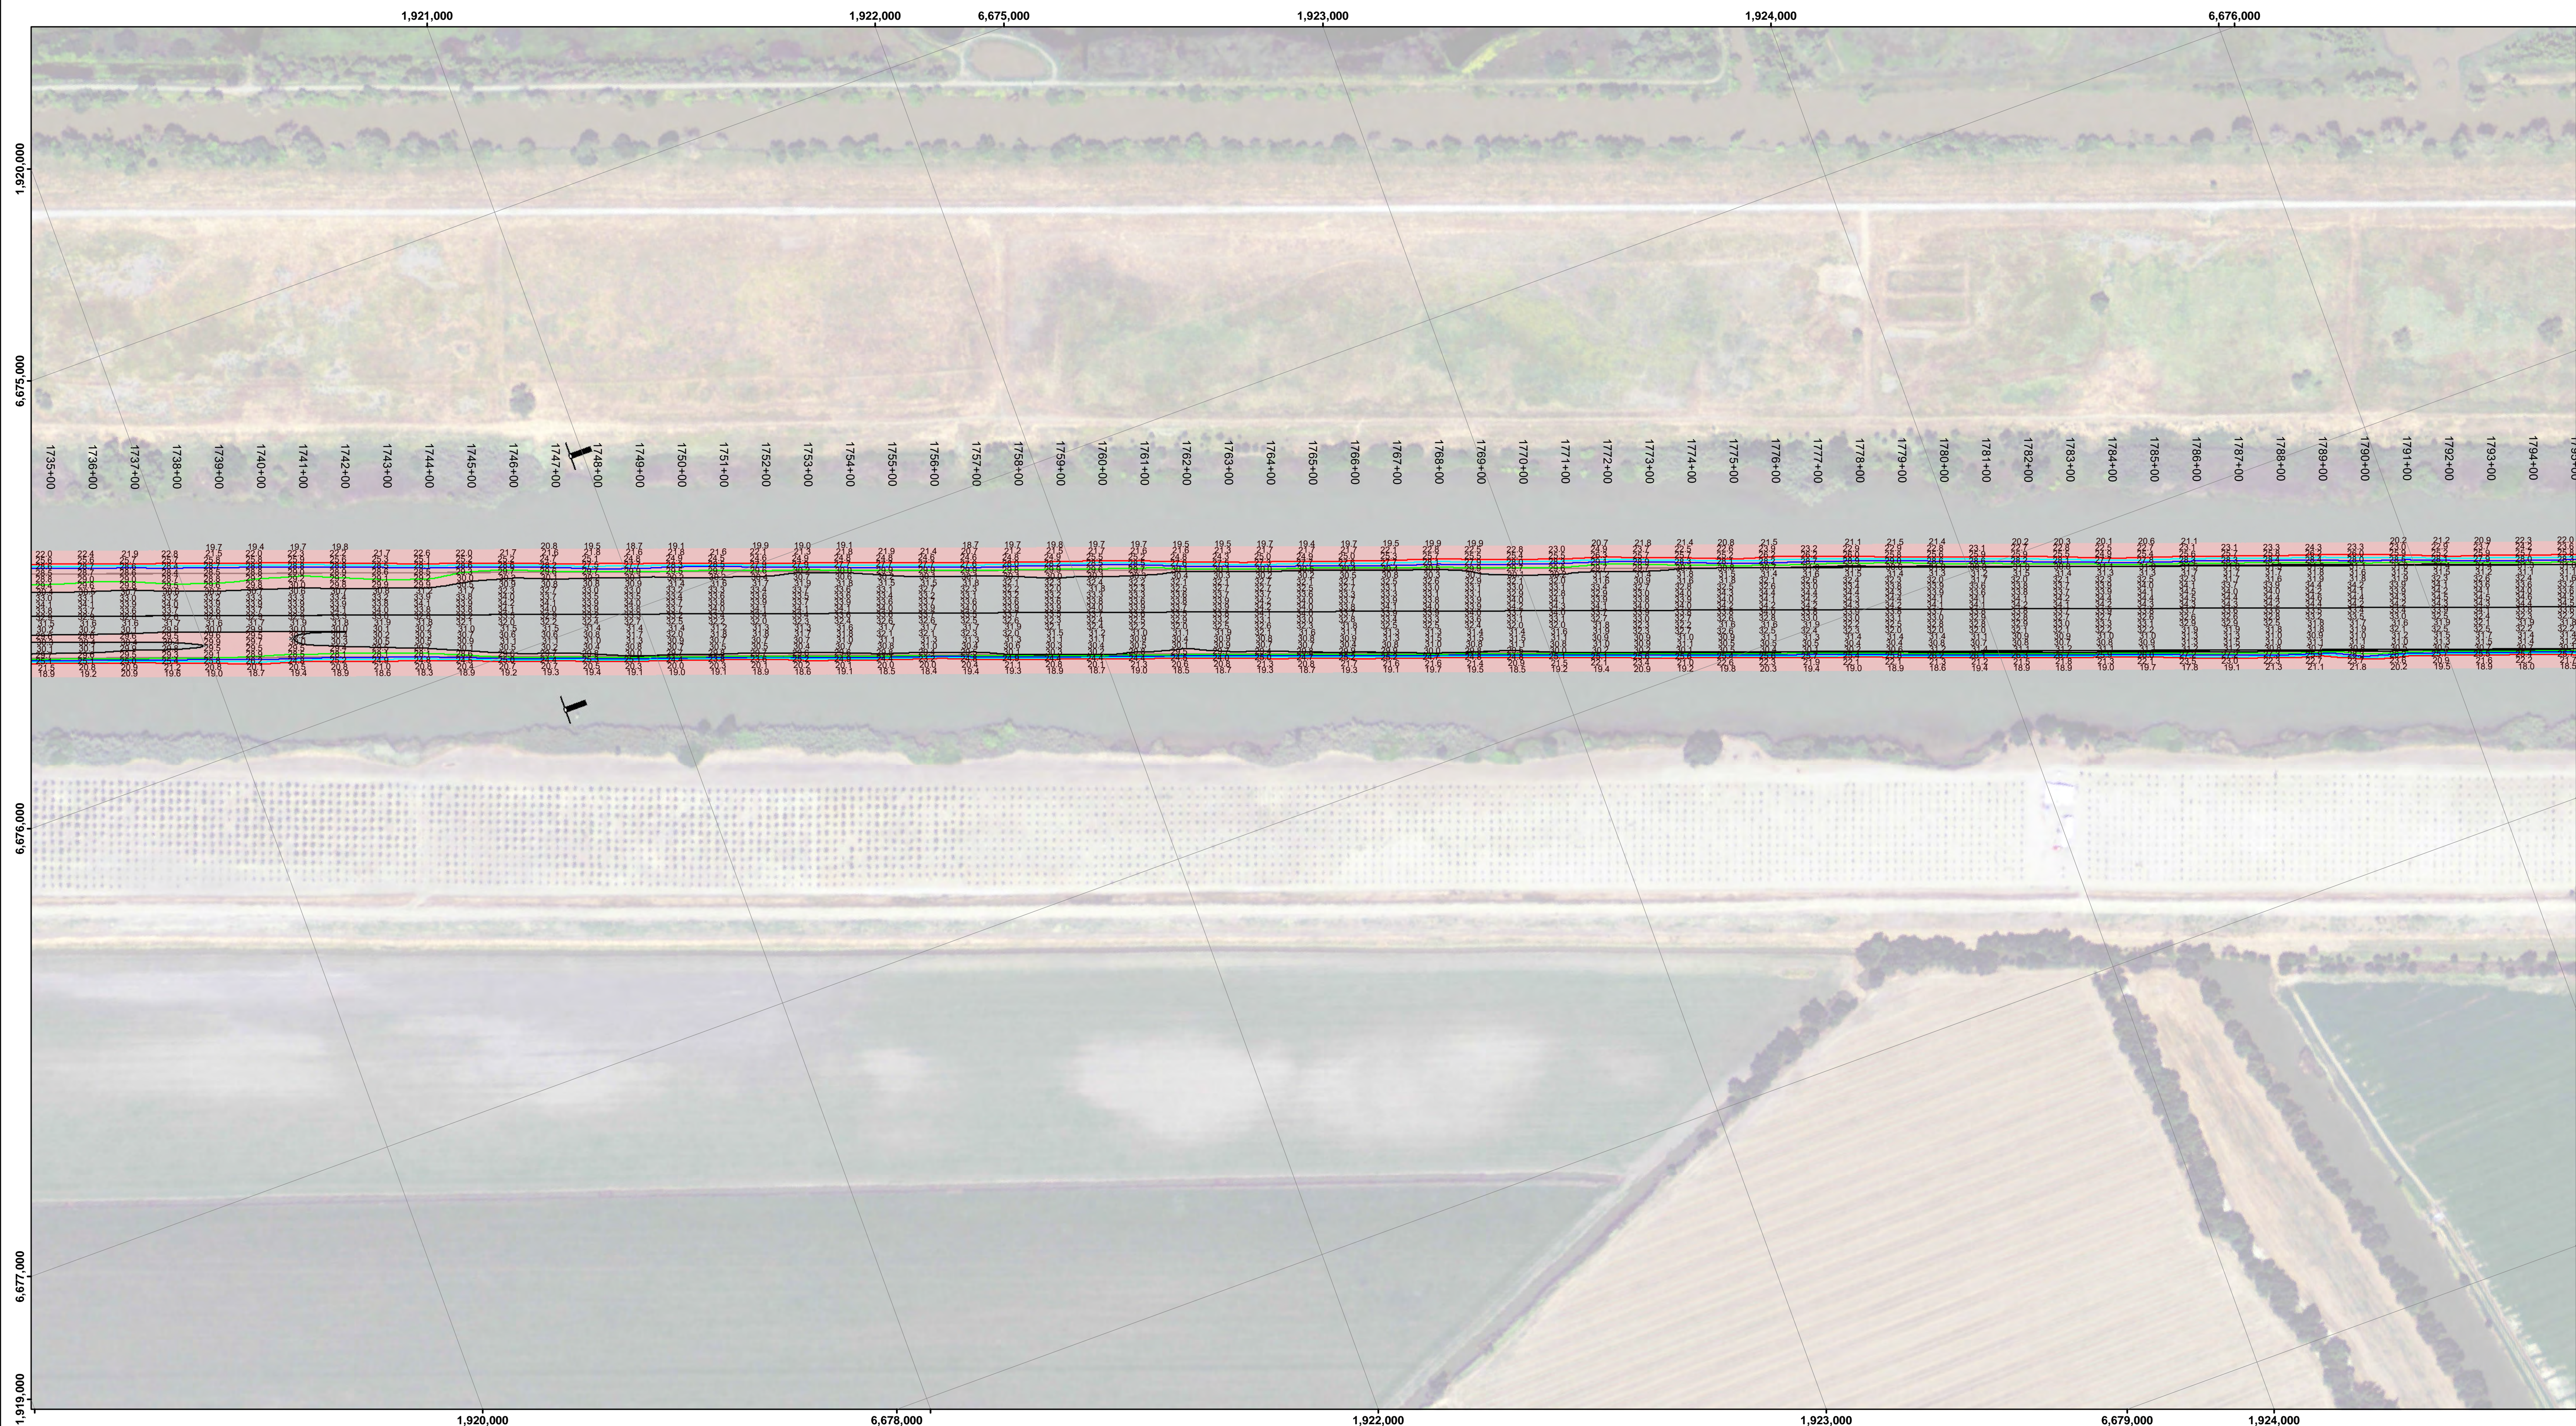


DISCLAIMER: The data represents the results of data collection/processing for a specific US Army Corps of Engineers project. It is not intended for use in any other project. The user is responsible for the results of any application of the data for other than its intended purpose. 

Chart Date:	Mar 12, 2018
Surveyed By:	LT COLONEL C.E. DISTRICT ENGINEER
Plotted By:	PDT
Checked By:	PDT
Drawn By:	PDT

SACRAMENTO RIVER
CONDITION SURVEY
21, 25, 27-28 FEBRUARY 2018

Sheet Reference Number
35 of 45

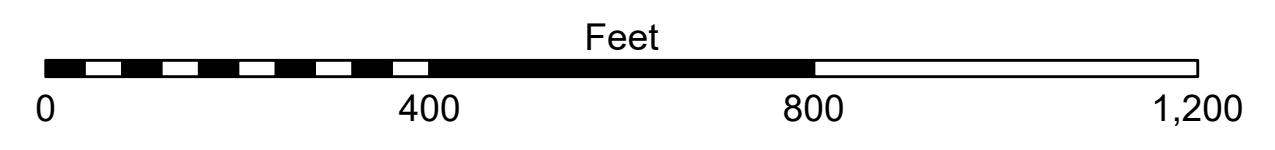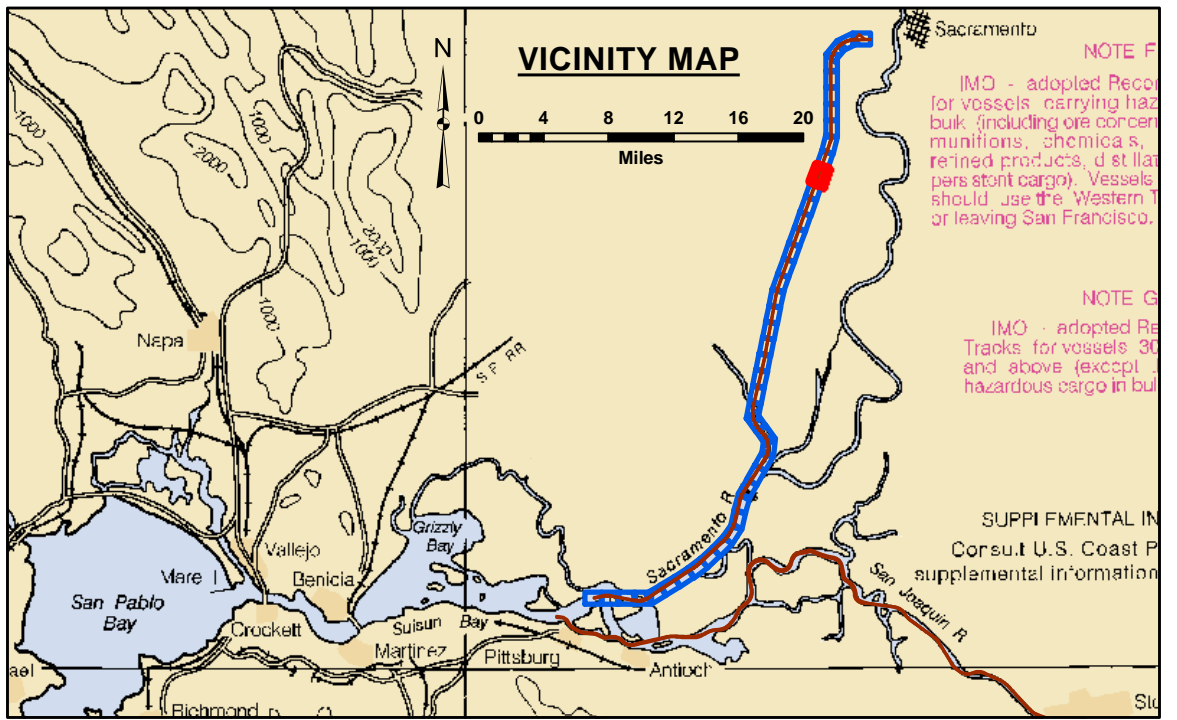

LEGEND		Contours	
--- Federal Navigation Channel	▨ Cable Area	— -30	
— Federal Navigation Center Line	□ Placement Area	— -29	
⋯ Cable Submarine	⊠ Anchorage Area	— -28	
- - - Cable Overhead	⊗ Obstruction Point	— -27	
— Contour Line	⚓ Wrecks-Submerged	— -26	
	● Shoaling Area		
	● Shoalest Sounding**		
	⌵ Beacon, General		
	◆ Red Navigation Buoy		
	◆ Green Navigation Buoy		

NOTES:
DRAWING NOT TO BE USED FOR NAVIGATION. ONLY CHANNEL CONDITION AT DATE OF SURVEY. THE LOCATION OF ALL NAVIGATION AIDS ARE BASED ON INFORMATION PROVIDED BY THE U.S. COAST GUARD. BUOY LOCATIONS REPRESENT THE POSITION OF THE SINKER ONLY.

SOUNDINGS WERE TAKEN BY FATHOMETER AND ARE SHOWN TO THE NEAREST TENTH OF A FOOT.

SOUNDINGS ARE BASED ON THE DATUM OF MEAN LOWER LOW WATER AT THE LOCALITY.

NORTH AMERICAN DATUM OF 1983 (NAD83), PROJECTED TO THE STATE PLANE COORDINATE SYSTEM (SPCS), CA ZONE II (0402). DISTANCE UNITS IN U.S. SURVEY FEET.

PLANE GRID AND COORDINATES ARE BASED ON LAMBERT PROJECTION, NAD 83, ZONE II CALIFORNIA AS DESCRIBED IN SPECIAL PUBLICATION NO. 235, PUBLISHED BY THE NATIONAL OCEAN SURVEY.

PROJECT DEPTH: -30'


VERTICAL DATUM: MLLW

THE LOCATION OF NAVIGATION AIDS ARE BASED ON AND PROVIDED BY THE U.S. COAST GUARD

CONTROLS:
LOCATION: RIO VISTA
NOAA STATION: 9415316
BENCHMARK: 5316 B 1996 (NO PID)
TIDE GAUGE: NAIL @ 8.2 FT MLLW
METADATA: NAIL SET BY USACE 31 MARCH, 2014

LOCATION: PORT OF WEST SACRAMENTO
NOAA STATION: 9416131
BENCHMARK: POWS1 (NO PID)
TIDE GAUGE: NAIL @ 10.0 FT MLLW
METADATA: NAIL SET BY USACE 8 APRIL, 2014


ALL HORIZONTAL POSITIONS AND MLLW ELEVATIONS WERE POST-PROCESSED USING PUBLIC GPS REFERENCE STATIONS IN THE AREA.

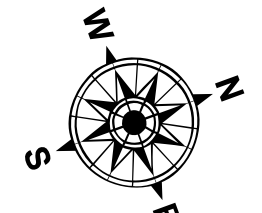




DISCLAIMER: The data represents the results of data collection/processing for a specific US Army Corps of Engineers project. The user is responsible for the results of any application of the data for other than its intended purpose. 

Chart Date:	Mar 12, 2018
Surveyed By:	Travis J. Rayfield
Plotted By:	PDT
Designed By:	PDT
Checked By:	PDT
Drawn By:	PDT

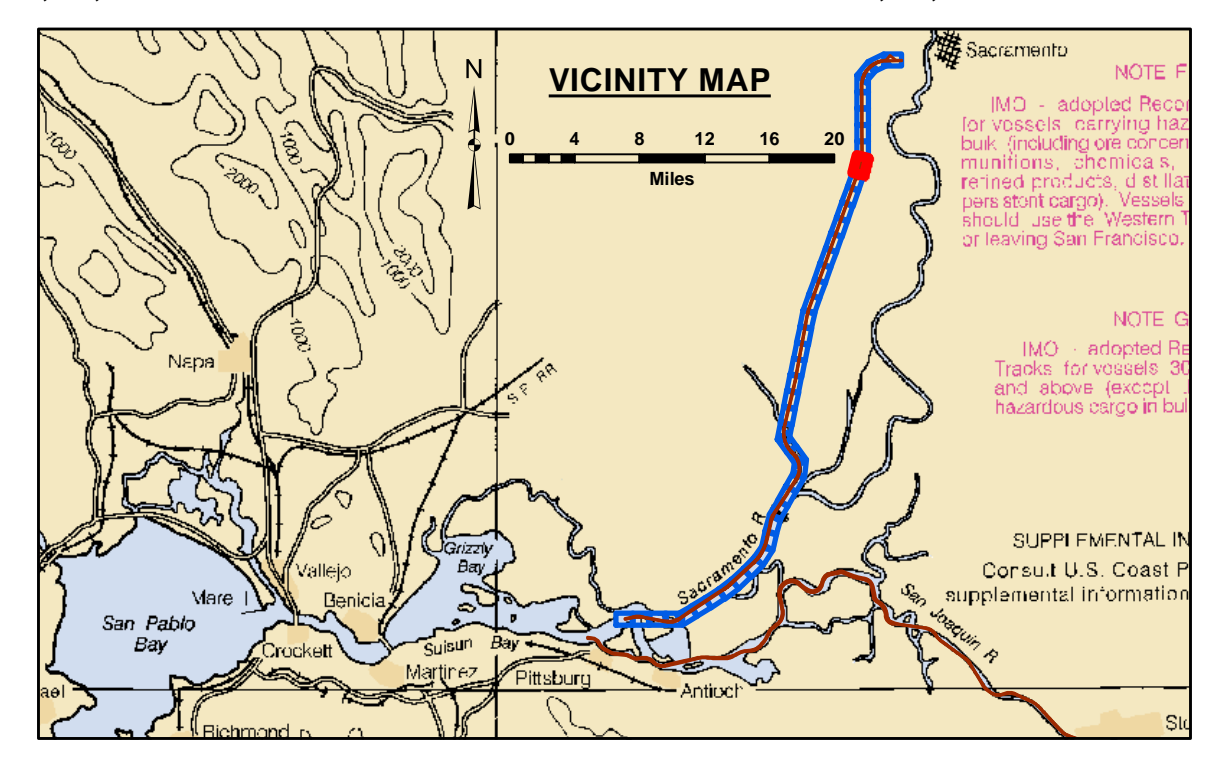


LEGEND		
--- Federal Navigation Channel	▨ Cable Area	■ Shoaling Area
— Federal Navigation Center Line	□ Placement Area	● Shoalest Sounding**
..... Cable Submarine	▤ Anchorage Area	⊥ Beacon, General
- - - Cable Overhead	⊗ Obstruction Point	◆ Red Navigation Buoy
— Contour Line	✦ Wrecks-Submerged	◆ Green Navigation Buoy


Contours	
—	-30
—	-29
—	-28
—	-27
—	-26

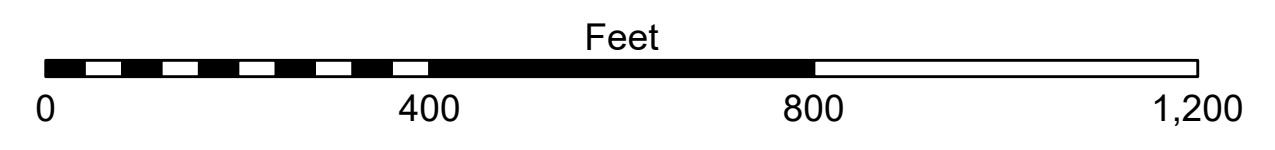

NOTES:
DRAWING NOT TO BE USED FOR NAVIGATION. ONLY CHANNEL CONDITION AT DATE OF SURVEY.
THE LOCATION OF ALL NAVIGATION AIDS ARE BASED ON INFORMATION PROVIDED BY THE U.S. COAST GUARD.
BUOY LOCATIONS REPRESENT THE POSITION OF THE SINKER ONLY.
SOUNDINGS WERE TAKEN BY FATHOMETER AND ARE SHOWN TO THE NEAREST TENTH OF A FOOT.
SOUNDINGS ARE BASED ON THE DATUM OF MEAN LOWER LOW WATER AT THE LOCALITY.
NORTH AMERICAN DATUM OF 1983 (NAD83), PROJECTED TO THE STATE PLANE COORDINATE SYSTEM (SPCS), ZONE II (0402). DISTANCE UNITS IN U.S. SURVEY FEET.
PLANE GRID AND COORDINATES ARE BASED ON LAMBERT PROJECTION, NAD 83, ZONE II CALIFORNIA AS DESCRIBED IN SPECIAL PUBLICATION NO. 235, PUBLISHED BY THE NATIONAL OCEAN SURVEY.
PROJECT DEPTH: -30'
VERTICAL DATUM: MLLW
THE LOCATION OF NAVIGATION AIDS ARE BASED ON AND PROVIDED BY THE U.S. COAST GUARD

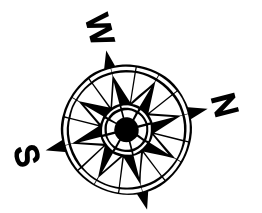

CALIFORNIA
SAN JOAQUIN COUNTY
SACRAMENTO RIVER
CONDITION SURVEY
21, 25, 27-28 FEBRUARY 2018
Sheet Reference Number
37 of 45

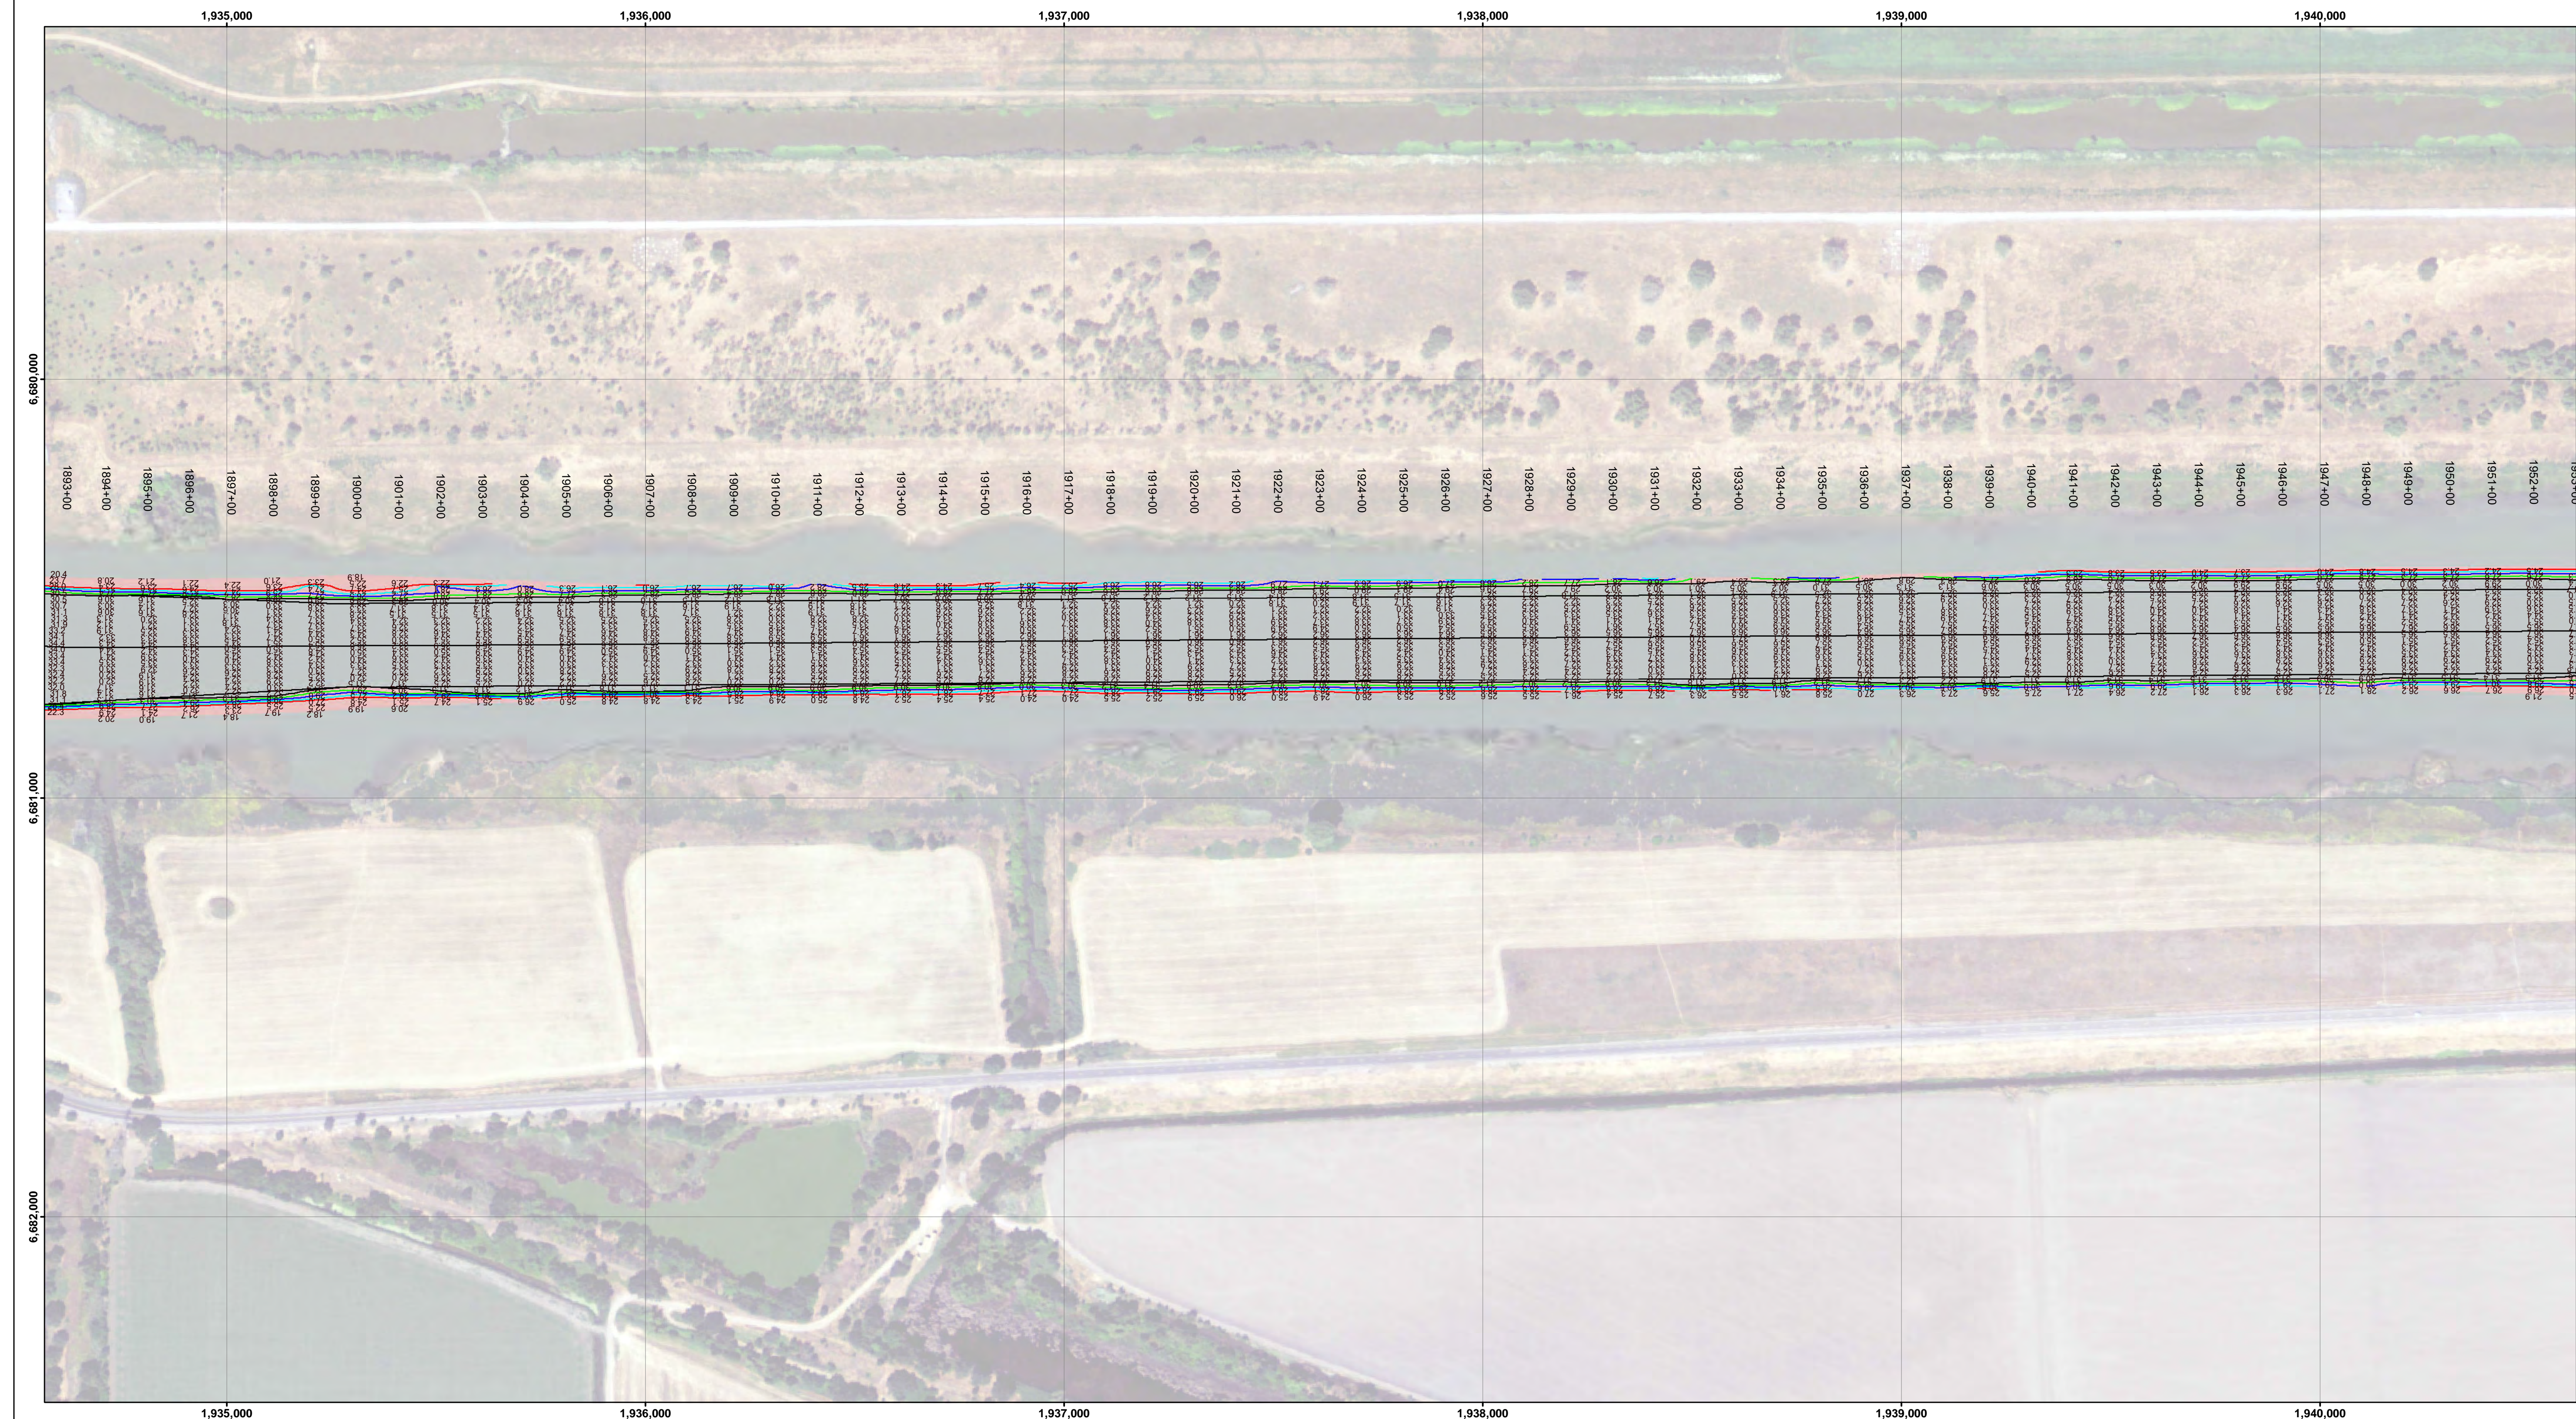




DISCLAIMER: The data represents the results of data collection/processing for a specific US Army Corps of Engineers project. It is not intended for use in any other project or application. The user is responsible for the results of any of the application of the data for other than its intended purpose.

Access Constraints: The United States Government furnishes this data and the results of this data to the recipient for use in the recipient's project. The recipient may not transfer this data to others without also transferring this Disclaimer.

Chart Date:	Mar 12, 2018
Surveyed By:	Travis J. Rayfield
Plotted By:	PDT
Designed By:	PDT
Checked By:	PDT
Drawn By:	PDT

CALIFORNIA
 SAN JOAQUIN COUNTY
SACRAMENTO RIVER
 CONDITION SURVEY
 21, 25, 27-28 FEBRUARY 2018

Sheet
 Reference
 Number
38 of 45

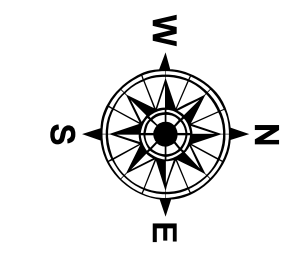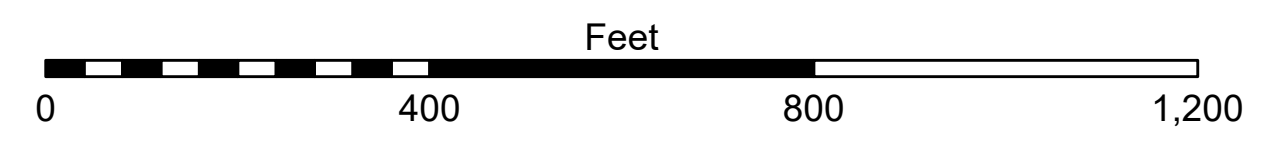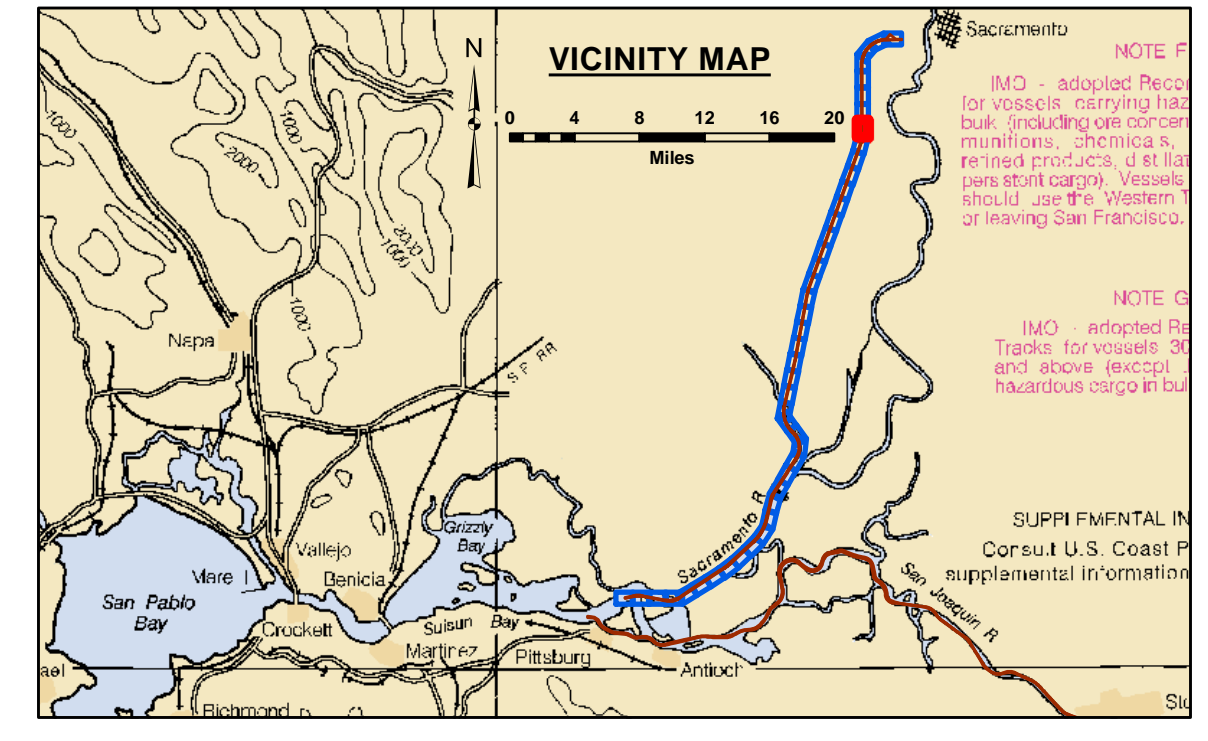

LEGEND			
--- Federal Navigation Channel	▨ Cable Area	■ Shoaling Area	— Contours
— Federal Navigation Center Line	□ Placement Area	● Shoalest Sounding**	— -30
..... Cable Submarine	▤ Anchorage Area	⊥ Beacon, General	— -29
- - - Cable Overhead	⊗ Obstruction Point	◆ Red Navigation Buoy	— -28
— Contour Line	✦ Wrecks-Submerged	◆ Green Navigation Buoy	— -27
			— -26

NOTES:
 DRAWING NOT TO BE USED FOR NAVIGATION. ONLY CHANNEL CONDITION AT DATE OF SURVEY.
 THE LOCATION OF ALL NAVIGATION AIDS ARE BASED ON INFORMATION PROVIDED BY THE U.S. COAST GUARD.
 BUOY LOCATIONS REPRESENT THE POSITION OF THE SINKER ONLY.

SOUNDINGS WERE TAKEN BY FATHOMETER AND ARE SHOWN TO THE NEAREST TENTH OF A FOOT.

SOUNDINGS ARE BASED ON THE DATUM OF MEAN LOWER LOW WATER AT THE LOCALITY.

NORTH AMERICAN DATUM OF 1983 (NAD83), PROJECTED TO THE STATE PLANE COORDINATE SYSTEM (SPCS), ZONE II (0402). DISTANCE UNITS IN U.S. SURVEY FEET.

PLANE GRID AND COORDINATES ARE BASED ON LAMBERT PROJECTION, NAD 83, ZONE II CALIFORNIA AS DESCRIBED IN SPECIAL PUBLICATION NO. 235, PUBLISHED BY THE NATIONAL OCEAN SURVEY.

PROJECT DEPTH: -30'
 VERTICAL DATUM: MLLW

THE LOCATION OF NAVIGATION AIDS ARE BASED ON AND PROVIDED BY THE U.S. COAST GUARD

CONTROLS:
 LOCATION: RIO VISTA
 NOAA STATION: 9415316
 BENCHMARK: 5316 B 1996 (NO PID)
 TIDE GAUGE: NAIL @ 8.2 FT MLLW
 METADATA: NAIL SET BY USACE 31 MARCH, 2014

LOCATION: PORT OF WEST SACRAMENTO
 NOAA STATION: 9416131
 BENCHMARK: POWS1 (NO PID)
 TIDE GAUGE: NAIL @ 10.0 FT MLLW
 METADATA: NAIL SET BY USACE 8 APRIL, 2014

ALL HORIZONTAL POSITIONS AND MLLW ELEVATIONS WERE POST-PROCESSED USING PUBLIC GPS REFERENCE STATIONS IN THE AREA.



DISCLAIMER: The data represents the results of data collection/processing for a specific US Army Corps of Engineers project. It is not intended for use in any other project. The user is responsible for the results of any application of the data for other than its intended purpose.


Access Constraints: The United States Government furnishes these data and the results of the processing thereof to the public and does not warrant the accuracy, completeness, or implied or expressed accuracy of the data. The user is responsible for the results of any application of the data for other than its intended purpose.

Liability: The United States Government does not assume any liability whatsoever for any use of the data for other than its intended purpose. The recipient may not transfer these data to others without also transferring this Disclaimer.

Chart Date:	Mar 12, 2018
Designed by:	PDT
Drawn by:	PDT
Surveyed By:	PDT
Plotted By:	PDT
Checked By:	PDT
Approved:	PDT
Chief, Construction Branch	

CALIFORNIA
SACRAMENTO RIVER
 CONDITION SURVEY
 21, 25, 27-28 FEBRUARY 2018

Sheet
 Reference
 Number
39 of 45

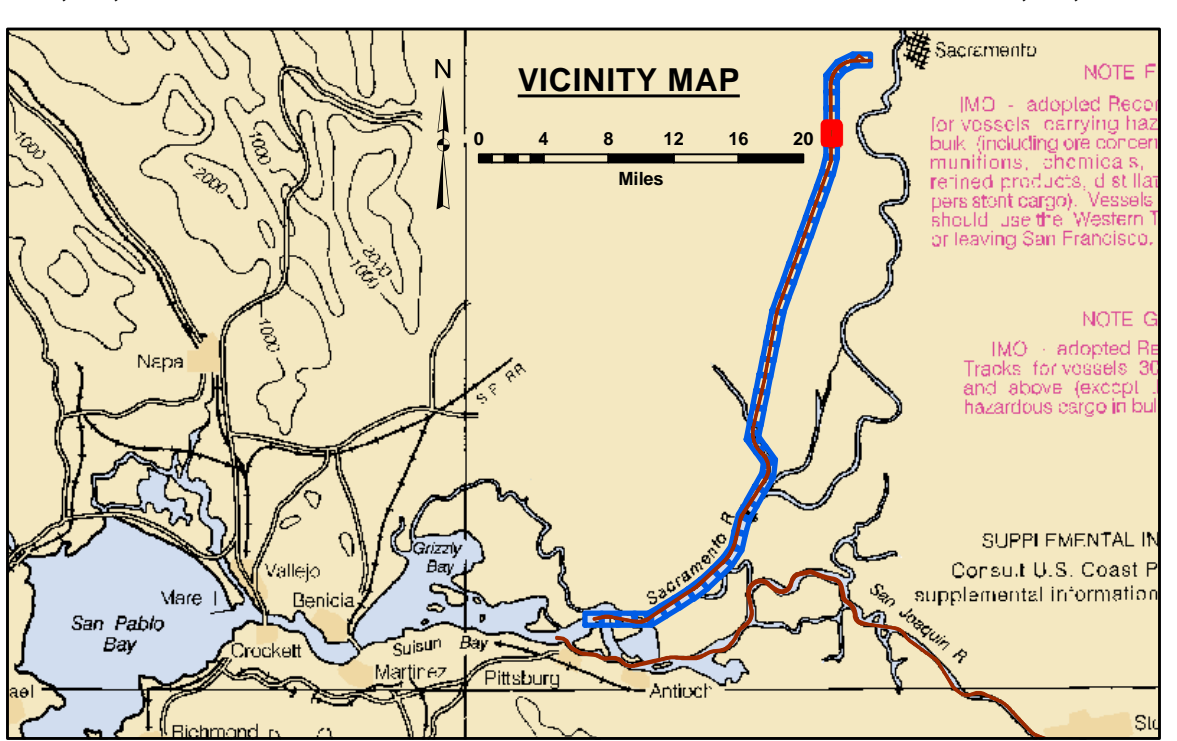

LEGEND		Contours	
--- Federal Navigation Channel	▨ Cable Area	— -30	
— Federal Navigation Center Line	□ Placement Area	— -29	
..... Cable Submarine	▨ Anchorage Area	— -28	
- - - Cable Overhead	⊗ Obstruction Point	— -27	
— Contour Line	✦ Wrecks-Submerged	— -26	
	● Shoaling Area		
	● Shoalest Sounding**		
	⊥ Beacon, General		
	◆ Red Navigation Buoy		
	◆ Green Navigation Buoy		

NOTES:
 DRAWING NOT TO BE USED FOR NAVIGATION. ONLY CHANNEL CONDITION AT DATE OF SURVEY.
 THE LOCATION OF ALL NAVIGATION AIDS ARE BASED ON INFORMATION PROVIDED BY THE U.S. COAST GUARD.
 BUOY LOCATIONS REPRESENT THE POSITION OF THE SINKER ONLY.

SOUNDINGS WERE TAKEN BY FATHOMETER AND ARE SHOWN TO THE NEAREST TENTH OF A FOOT.

SOUNDINGS ARE BASED ON THE DATUM OF MEAN LOWER LOW WATER AT THE LOCALITY.

NORTH AMERICAN DATUM OF 1983 (NAD83), PROJECTED TO THE STATE PLANE COORDINATE SYSTEM (SPCS), CA ZONE II (0402). DISTANCE UNITS IN U.S. SURVEY FEET.

PLANE GRID AND COORDINATES ARE BASED ON LAMBERT PROJECTION, NAD 83, ZONE II CALIFORNIA AS DESCRIBED IN SPECIAL PUBLICATION NO. 235, PUBLISHED BY THE NATIONAL OCEAN SURVEY.

PROJECT DEPTH: -30'


VERTICAL DATUM: MLLW

THE LOCATION OF NAVIGATION AIDS ARE BASED ON AND PROVIDED BY THE U.S. COAST GUARD

CONTROLS:
 LOCATION: RIO VISTA
 NOAA STATION: 9415316
 BENCHMARK: 5316 B 1996 (NO PID)
 TIDE GAUGE: NAIL @ 8.2 FT MLLW
 METADATA: NAIL SET BY USACE 31 MARCH, 2014

LOCATION: PORT OF WEST SACRAMENTO
 NOAA STATION: 9416131
 BENCHMARK: POWS1 (NO PID)
 TIDE GAUGE: NAIL @ 10.0 FT MLLW
 METADATA: NAIL SET BY USACE 8 APRIL, 2014

ALL HORIZONTAL POSITIONS AND MLLW ELEVATIONS WERE POST-PROCESSED USING PUBLIC GPS REFERENCE STATIONS IN THE AREA.

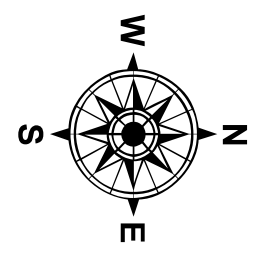





DISCLAIMER: The data represents the results of data collection/processing for a specific US Army Corps of Engineers project. It is not intended for use in any other project. The user is responsible for the results of any application of the data for other than its intended purpose.

Access Constraints: The United States Government furnishes these data and the results of any analysis or use of these data for the purpose of conducting business with the United States Government. The user is responsible for the results of any application of the data for other than its intended purpose.

Chart Date:	Mar 12, 2018
Designed by:	PDT
Drawn by:	PDT
Surveyed By:	PDT
Plotted By:	PDT
Checked By:	PDT
Approved:	Chief, Construction Branch

CALIFORNIA
SACRAMENTO RIVER
 CONDITION SURVEY
 21, 25, 27-28 FEBRUARY 2018

Sheet
 Reference
 Number
40 of 45

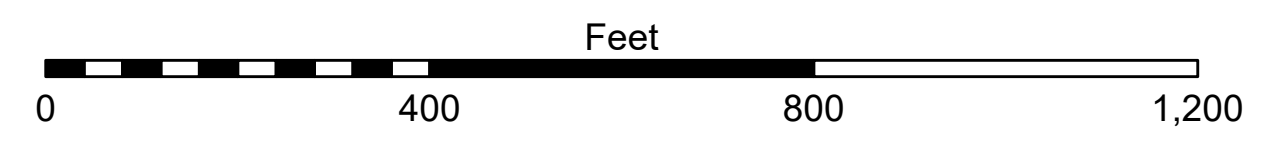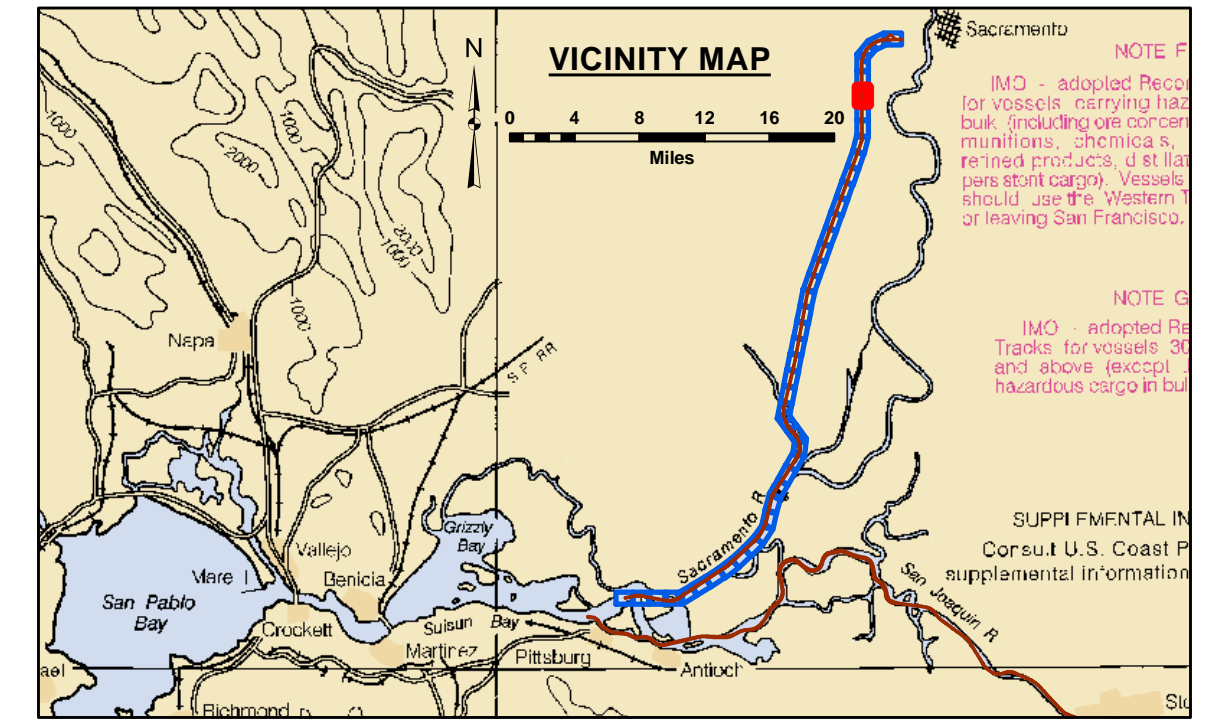

LEGEND			
--- Federal Navigation Channel	▨ Cable Area	■ Shoaling Area	— Contours
— Federal Navigation Center Line	□ Placement Area	● Shoalest Sounding**	— -30
..... Cable Submarine	▨ Anchorage Area	⊥ Beacon, General	— -29
- - - Cable Overhead	⊗ Obstruction Point	◆ Red Navigation Buoy	— -28
— Contour Line	✦ Wrecks-Submerged	◆ Green Navigation Buoy	— -27
			— -26

NOTES:
 DRAWING NOT TO BE USED FOR NAVIGATION. ONLY CHANNEL CONDITION AT DATE OF SURVEY.
 THE LOCATION OF ALL NAVIGATION AIDS ARE BASED ON INFORMATION PROVIDED BY THE U.S. COAST GUARD.
 BUOY LOCATIONS REPRESENT THE POSITION OF THE SINKER ONLY.

SOUNDINGS WERE TAKEN BY FATHOMETER AND ARE SHOWN TO THE NEAREST TENTH OF A FOOT.

SOUNDINGS ARE BASED ON THE DATUM OF MEAN LOWER LOW WATER AT THE LOCALITY.

NORTH AMERICAN DATUM OF 1983 (NAD83), PROJECTED TO THE STATE PLANE COORDINATE SYSTEM (SPCS), ZONE II (0402), DISTANCE UNITS IN U.S. SURVEY FEET.

PLANE GRID AND COORDINATES ARE BASED ON LAMBERT PROJECTION, NAD 83, ZONE II CALIFORNIA AS DESCRIBED IN SPECIAL PUBLICATION NO. 235, PUBLISHED BY THE NATIONAL OCEAN SURVEY.


PROJECT DEPTH: -30'
 VERTICAL DATUM: MLLW

THE LOCATION OF NAVIGATION AIDS ARE BASED ON AND PROVIDED BY THE U.S. COAST GUARD

CONTROLS:
 LOCATION: RIO VISTA
 NOAA STATION: 9415316
 BENCHMARK: 5316 B 1996 (NO PID)
 TIDE GAUGE: NAIL @ 8.2 FT MLLW
 METADATA: NAIL SET BY USACE 31 MARCH, 2014

LOCATION: PORT OF WEST SACRAMENTO
 NOAA STATION: 9416131
 BENCHMARK: POWS1 (NO PID)
 TIDE GAUGE: NAIL @ 10.0 FT MLLW
 METADATA: NAIL SET BY USACE 8 APRIL, 2014

ALL HORIZONTAL POSITIONS AND MLLW ELEVATIONS WERE POST-PROCESSED USING PUBLIC GPS REFERENCE STATIONS IN THE AREA.

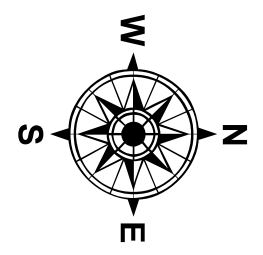



DISCLAIMER: The data represents the results of data collection/processing for a specific US Army Corps of Engineers project. It is not intended for use in any other project. The user is responsible for the results of any application of the data for other than its intended purpose.

Access Constraints: The United States Government furnishes these data and the user must acknowledge and use them with the express understanding that the US Government makes no warranty, expressed or implied, concerning the accuracy, completeness, or timeliness of the data. The user is responsible for the results of any application of the data for other than its intended purpose.

Liability: The data represents the results of data collection/processing for a specific US Army Corps of Engineers project. It is not intended for use in any other project. The user is responsible for the results of any application of the data for other than its intended purpose.




Chart Date:	Mar 12, 2018
Designed by:	PDT
Drawn by:	PDT
Surveyed By:	PDT
Plotted By:	PDT
Checked By:	PDT
Approved:	Chief, Hydro Survey Section
Approved:	Chief, Construction Branch

CALIFORNIA

SACRAMENTO RIVER
CONDITION SURVEY
21, 25, 27-28 FEBRUARY 2018

SAN JOAQUIN COUNTY

Sheet Reference Number
41 of 45

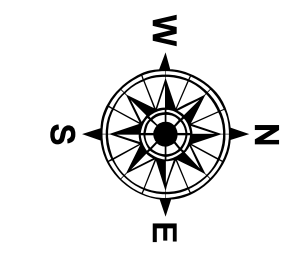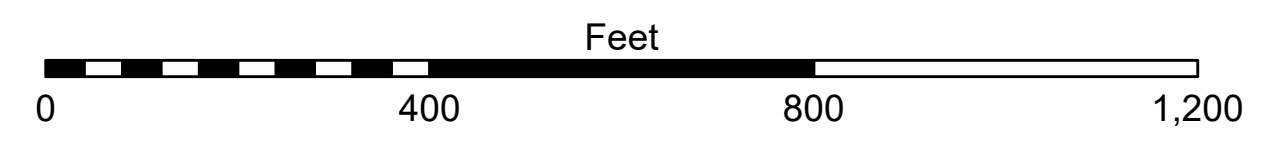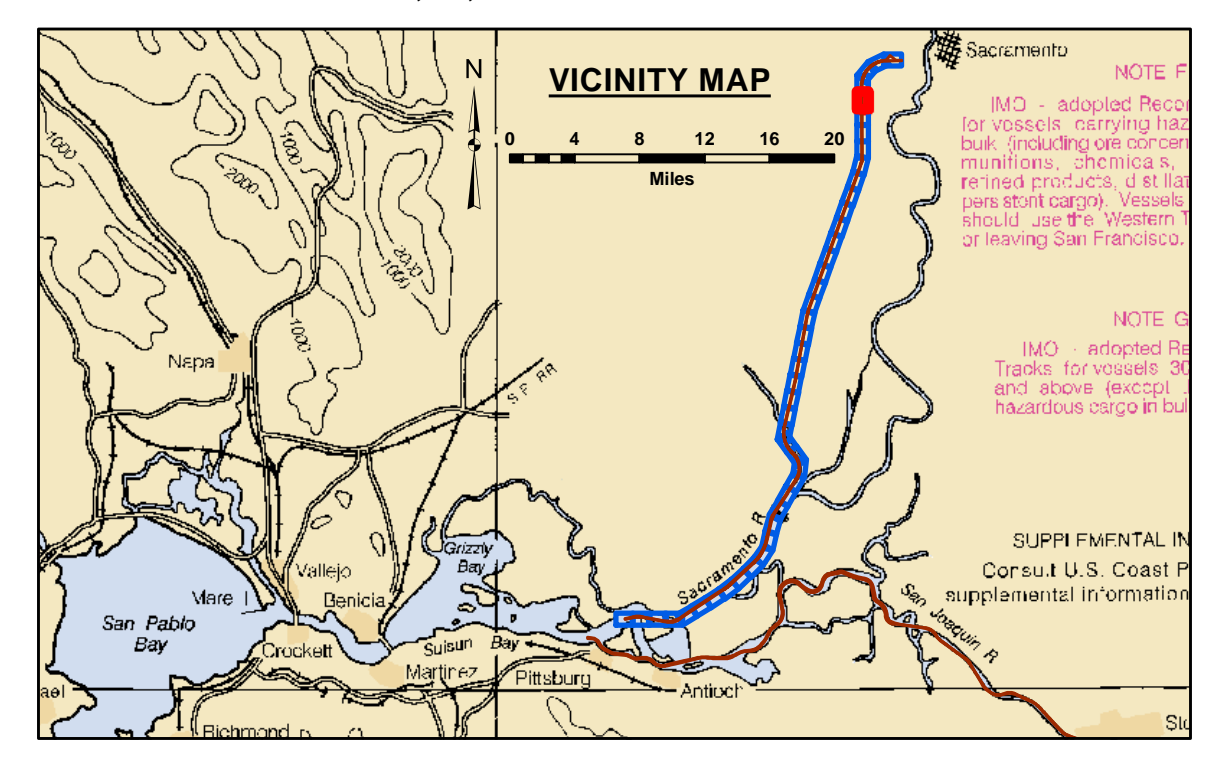

LEGEND		
--- Federal Navigation Channel	▨ Cable Area	■ Shoaling Area
— Federal Navigation Center Line	□ Placement Area	● Shoalest Sounding**
..... Cable Submarine	▤ Anchorage Area	⊥ Beacon, General
- - - Cable Overhead	⊗ Obstruction Point	◆ Red Navigation Buoy
— Contour Line	✦ Wrecks-Submerged	◆ Green Navigation Buoy

Contours

—	-30
—	-29
—	-28
—	-27
—	-26

NOTES:
DRAWING NOT TO BE USED FOR NAVIGATION. ONLY CHANNEL CONDITION AT DATE OF SURVEY.
THE LOCATION OF ALL NAVIGATION AIDS ARE BASED ON INFORMATION PROVIDED BY THE U.S. COAST GUARD.
BUOY LOCATIONS REPRESENT THE POSITION OF THE SINKER ONLY.

SOUNDINGS WERE TAKEN BY FATHOMETER AND ARE SHOWN TO THE NEAREST TENTH OF A FOOT.
SOUNDINGS ARE BASED ON THE DATUM OF MEAN LOWER LOW WATER AT THE LOCALITY.

NORTH AMERICAN DATUM OF 1983 (NAD83), PROJECTED TO THE STATE PLANE COORDINATE SYSTEM (SPCS), ZONE II (0402), DISTANCE UNITS IN U.S. SURVEY FEET.

PLANE GRID AND COORDINATES ARE BASED ON LAMBERT PROJECTION, NAD 83, ZONE II CALIFORNIA AS DESCRIBED IN SPECIAL PUBLICATION NO. 235, PUBLISHED BY THE NATIONAL OCEAN SURVEY.


PROJECT DEPTH: -30'
VERTICAL DATUM: MLLW

THE LOCATION OF NAVIGATION AIDS ARE BASED ON AND PROVIDED BY THE U.S. COAST GUARD

CONTROLS:
LOCATION: RIO VISTA
NOAA STATION: 9415316
BENCHMARK: 5316 B 1996 (NO PID)
TIDE GAUGE: NAIL @ 8.2 FT MLLW
METADATA: NAIL SET BY USACE 31 MARCH, 2014

LOCATION: PORT OF WEST SACRAMENTO
NOAA STATION: 9416131
BENCHMARK: POWS1 (NO PID)
TIDE GAUGE: NAIL @ 10.0 FT MLLW
METADATA: NAIL SET BY USACE 8 APRIL, 2014

ALL HORIZONTAL POSITIONS AND MLLW ELEVATIONS WERE POST-PROCESSED USING PUBLIC GPS REFERENCE STATIONS IN THE AREA.



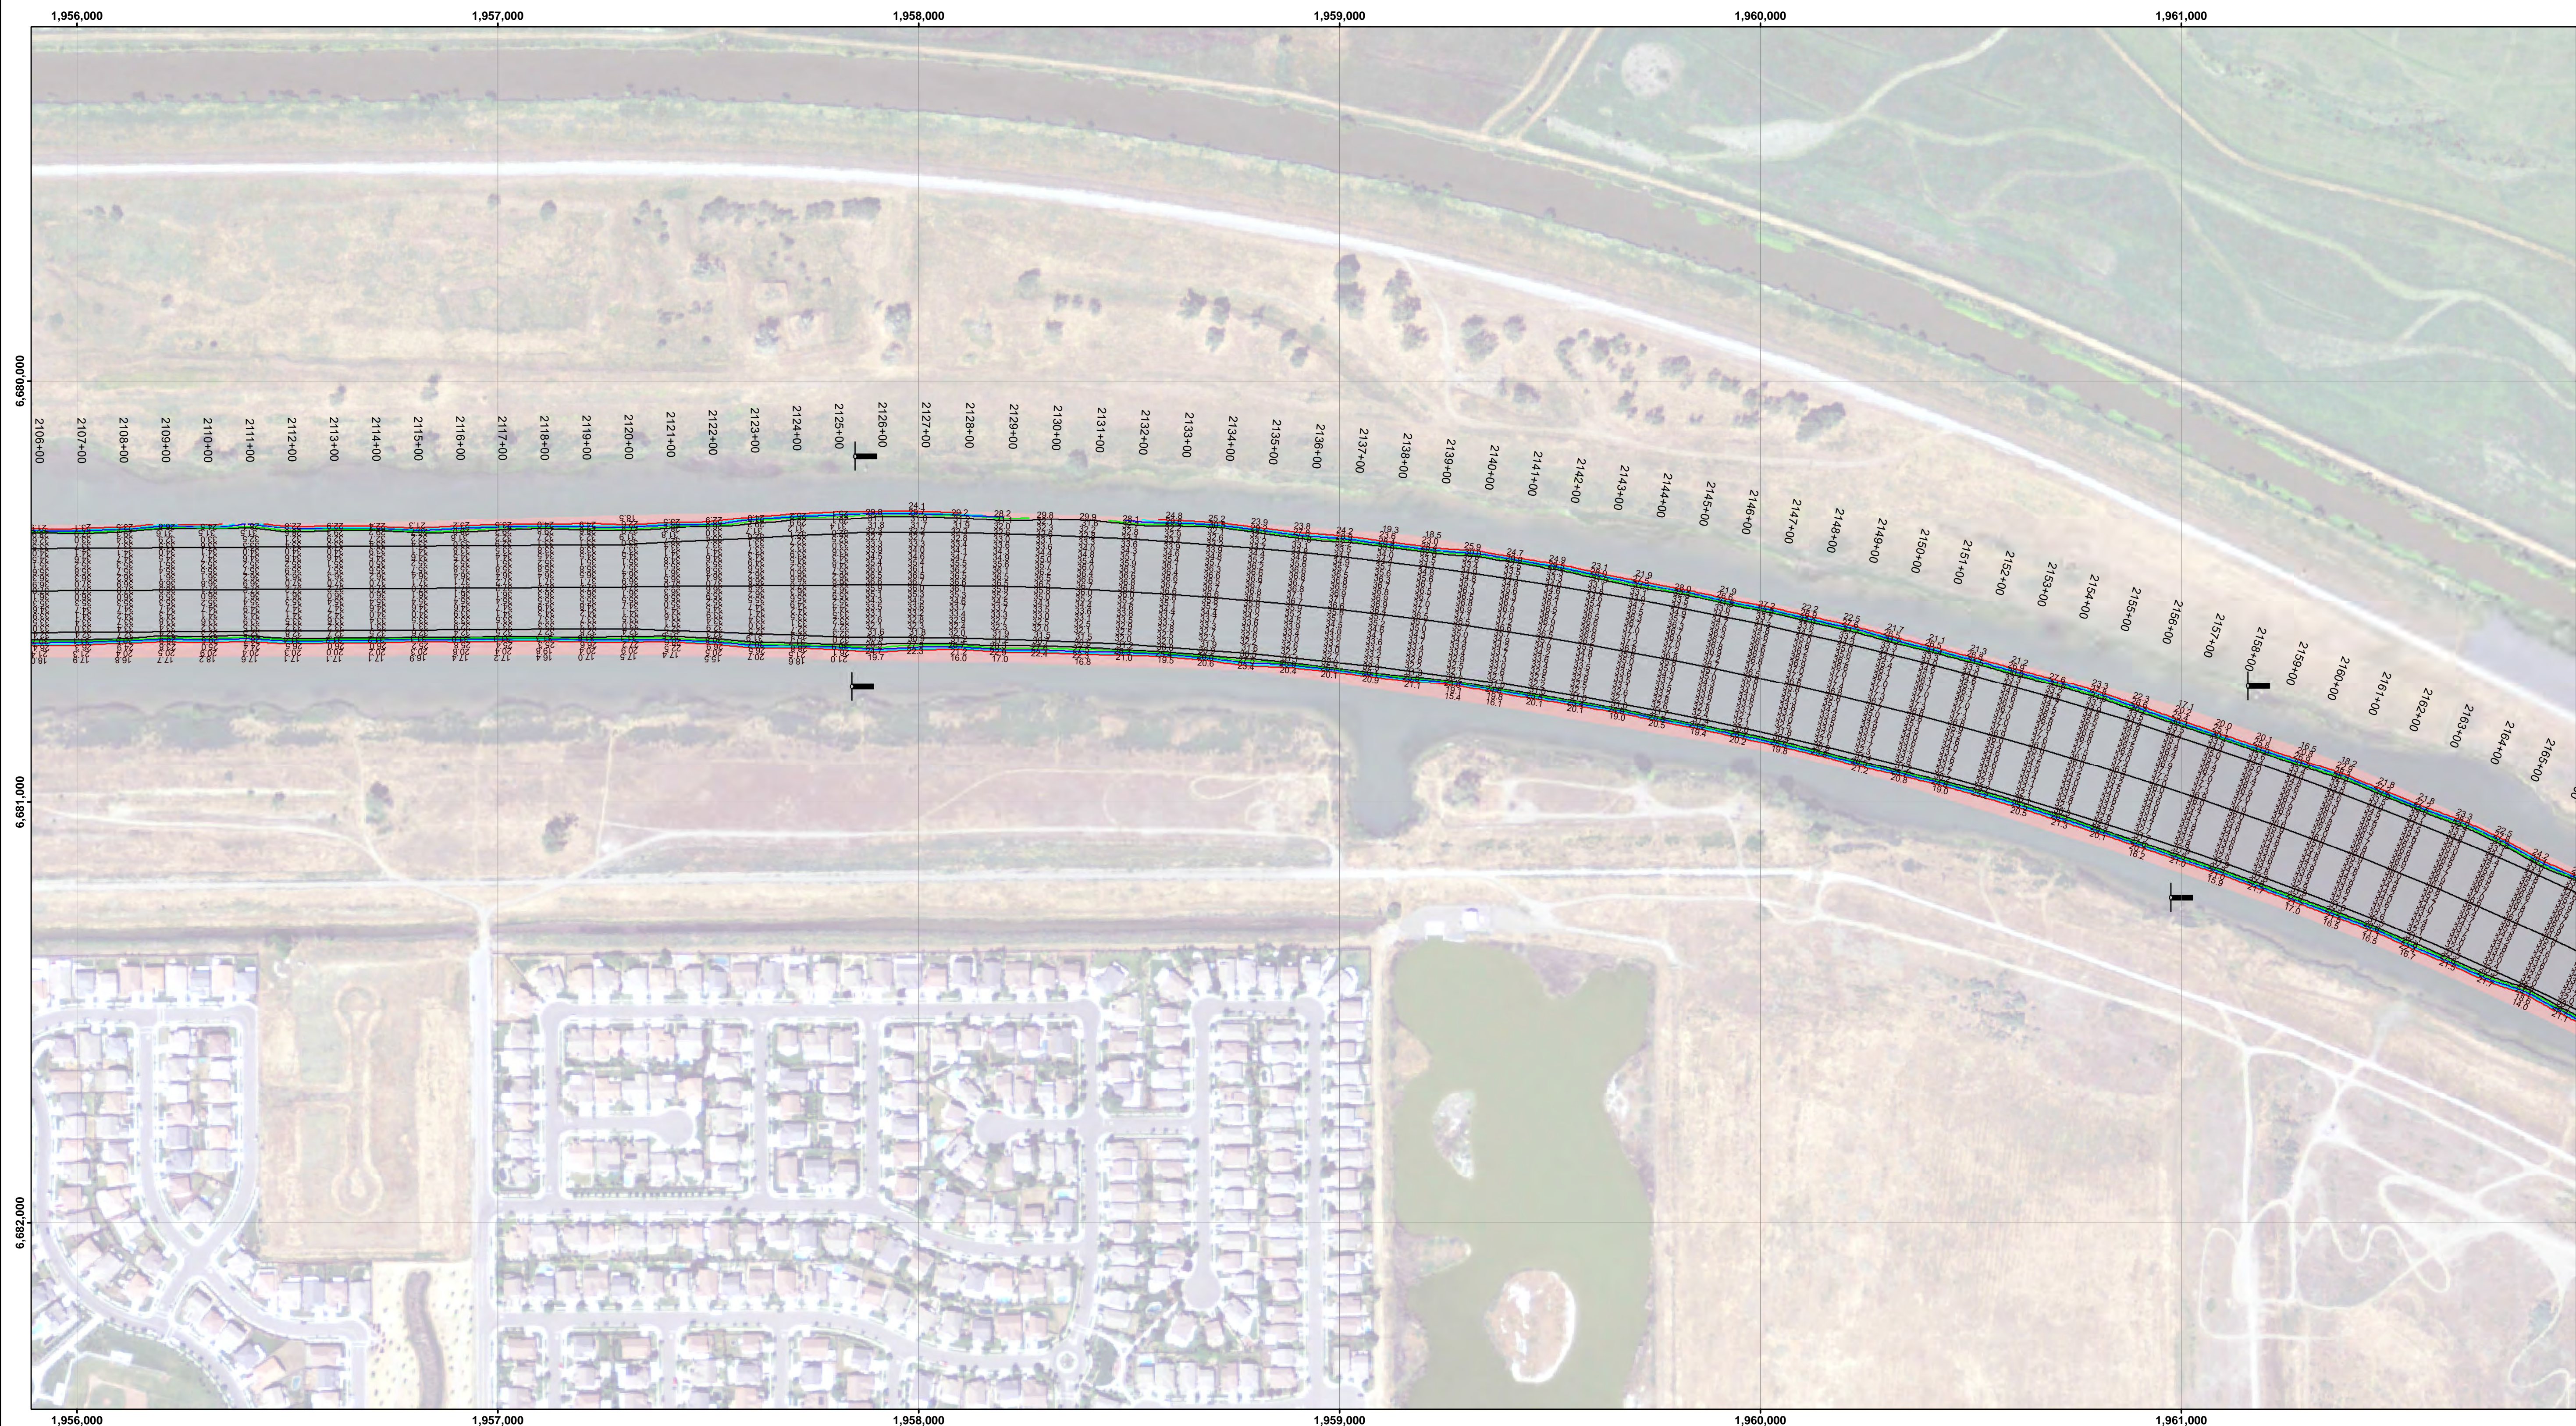


DISCLAIMER: The data represents the results of data collection/processing for a specific US Army Corps of Engineers project. It is not intended for use in any other project. The user is responsible for the results of any application of the data for other than its intended purpose.

Access Constraints: The United States Government furnishes these data and the results of any processing of these data for the use of the US Army Corps of Engineers. The user is responsible for the accuracy, completeness, and timeliness of the data. 

Chart Date:	Mar 12, 2018
Designed by:	PDT
Drawn by:	PDT
Surveyed By:	PDT
Plotted By:	PDT
Checked By:	PDT
Approved:	Chief, Construction Branch

CALIFORNIA
SACRAMENTO RIVER
 CONDITION SURVEY
 21, 25, 27-28 FEBRUARY 2018

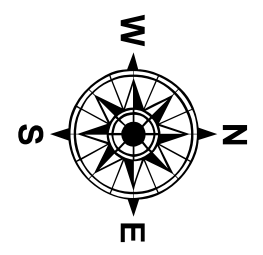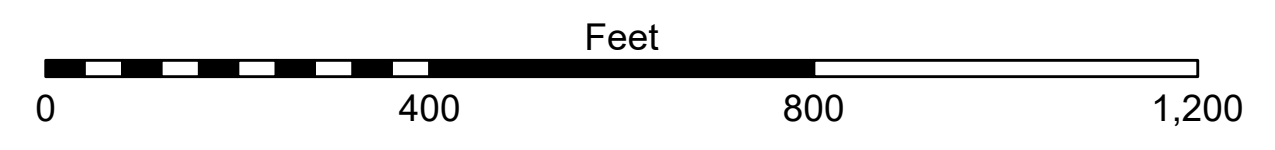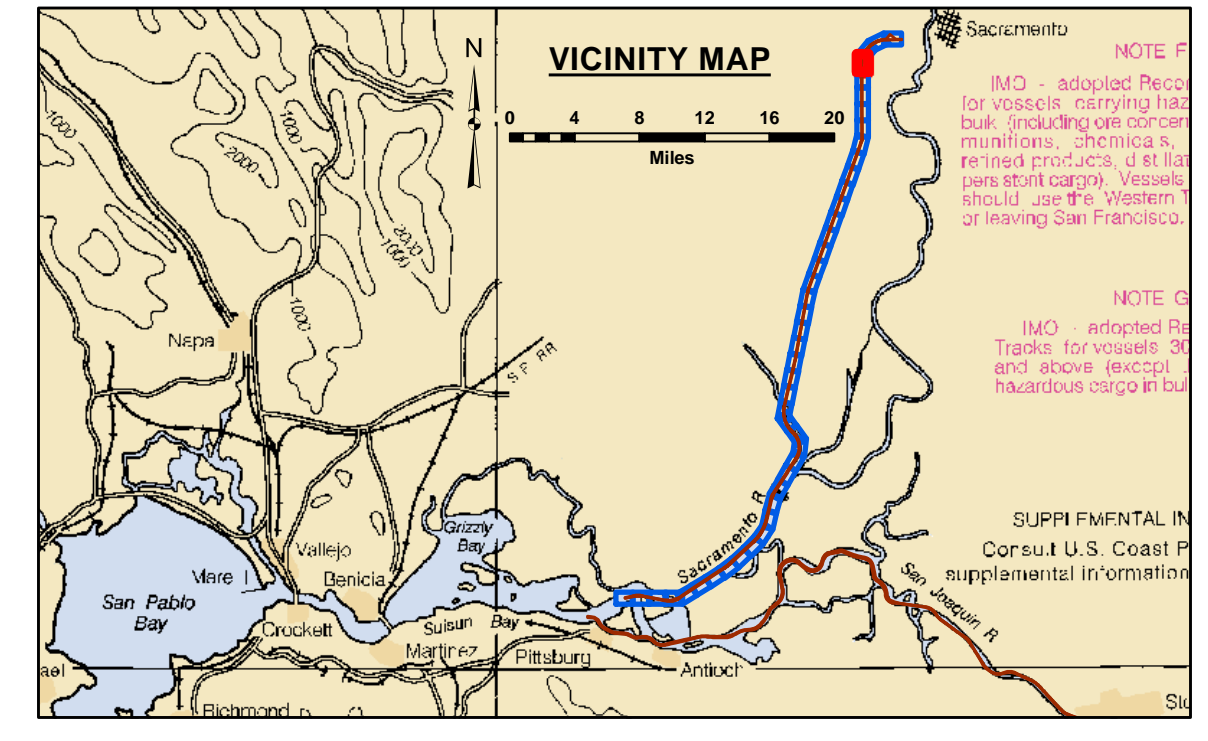

LEGEND		
--- Federal Navigation Channel	▨ Cable Area	■ Shoaling Area
— Federal Navigation Center Line	□ Placement Area	● Shoalest Sounding**
..... Cable Submarine	▤ Anchorage Area	⊥ Beacon, General
- - - Cable Overhead	⊗ Obstruction Point	◆ Red Navigation Buoy
— Contour Line	✦ Wrecks-Submerged	◆ Green Navigation Buoy

Contours

—	-30
—	-29
—	-28
—	-27
—	-26

NOTES:
 DRAWING NOT TO BE USED FOR NAVIGATION. ONLY CHANNEL CONDITION AT DATE OF SURVEY.
 THE LOCATION OF ALL NAVIGATION AIDS ARE BASED ON INFORMATION PROVIDED BY THE U.S. COAST GUARD.
 BUOY LOCATIONS REPRESENT THE POSITION OF THE SINKER ONLY.

SOUNDINGS WERE TAKEN BY FATHOMETER AND ARE SHOWN TO THE NEAREST TENTH OF A FOOT.

SOUNDINGS ARE BASED ON THE DATUM OF MEAN LOWER LOW WATER AT THE LOCALITY.

NORTH AMERICAN DATUM OF 1983 (NAD83), PROJECTED TO THE STATE PLANE COORDINATE SYSTEM (SPCS), ZONE II CALIFORNIA AS DESCRIBED IN SPECIAL PUBLICATION NO. 235, PUBLISHED BY THE NATIONAL OCEAN SURVEY.


PROJECT DEPTH: -30'
 VERTICAL DATUM: MLLW

THE LOCATION OF NAVIGATION AIDS ARE BASED ON AND PROVIDED BY THE U.S. COAST GUARD

CONTROLS:
 LOCATION: RIO VISTA
 NOAA STATION: 9415316
 BENCHMARK: 5316 B 1996 (NO PID)
 TIDE GAUGE: NAIL @ 8.2 FT MLLW
 METADATA: NAIL SET BY USACE 31 MARCH, 2014

LOCATION: PORT OF WEST SACRAMENTO
 NOAA STATION: 9416131
 BENCHMARK: POWS1 (NO PID)
 TIDE GAUGE: NAIL @ 10.0 FT MLLW
 METADATA: NAIL SET BY USACE 8 APRIL, 2014

ALL HORIZONTAL POSITIONS AND MLLW ELEVATIONS WERE POST-PROCESSED USING PUBLIC GPS REFERENCE STATIONS IN THE AREA.

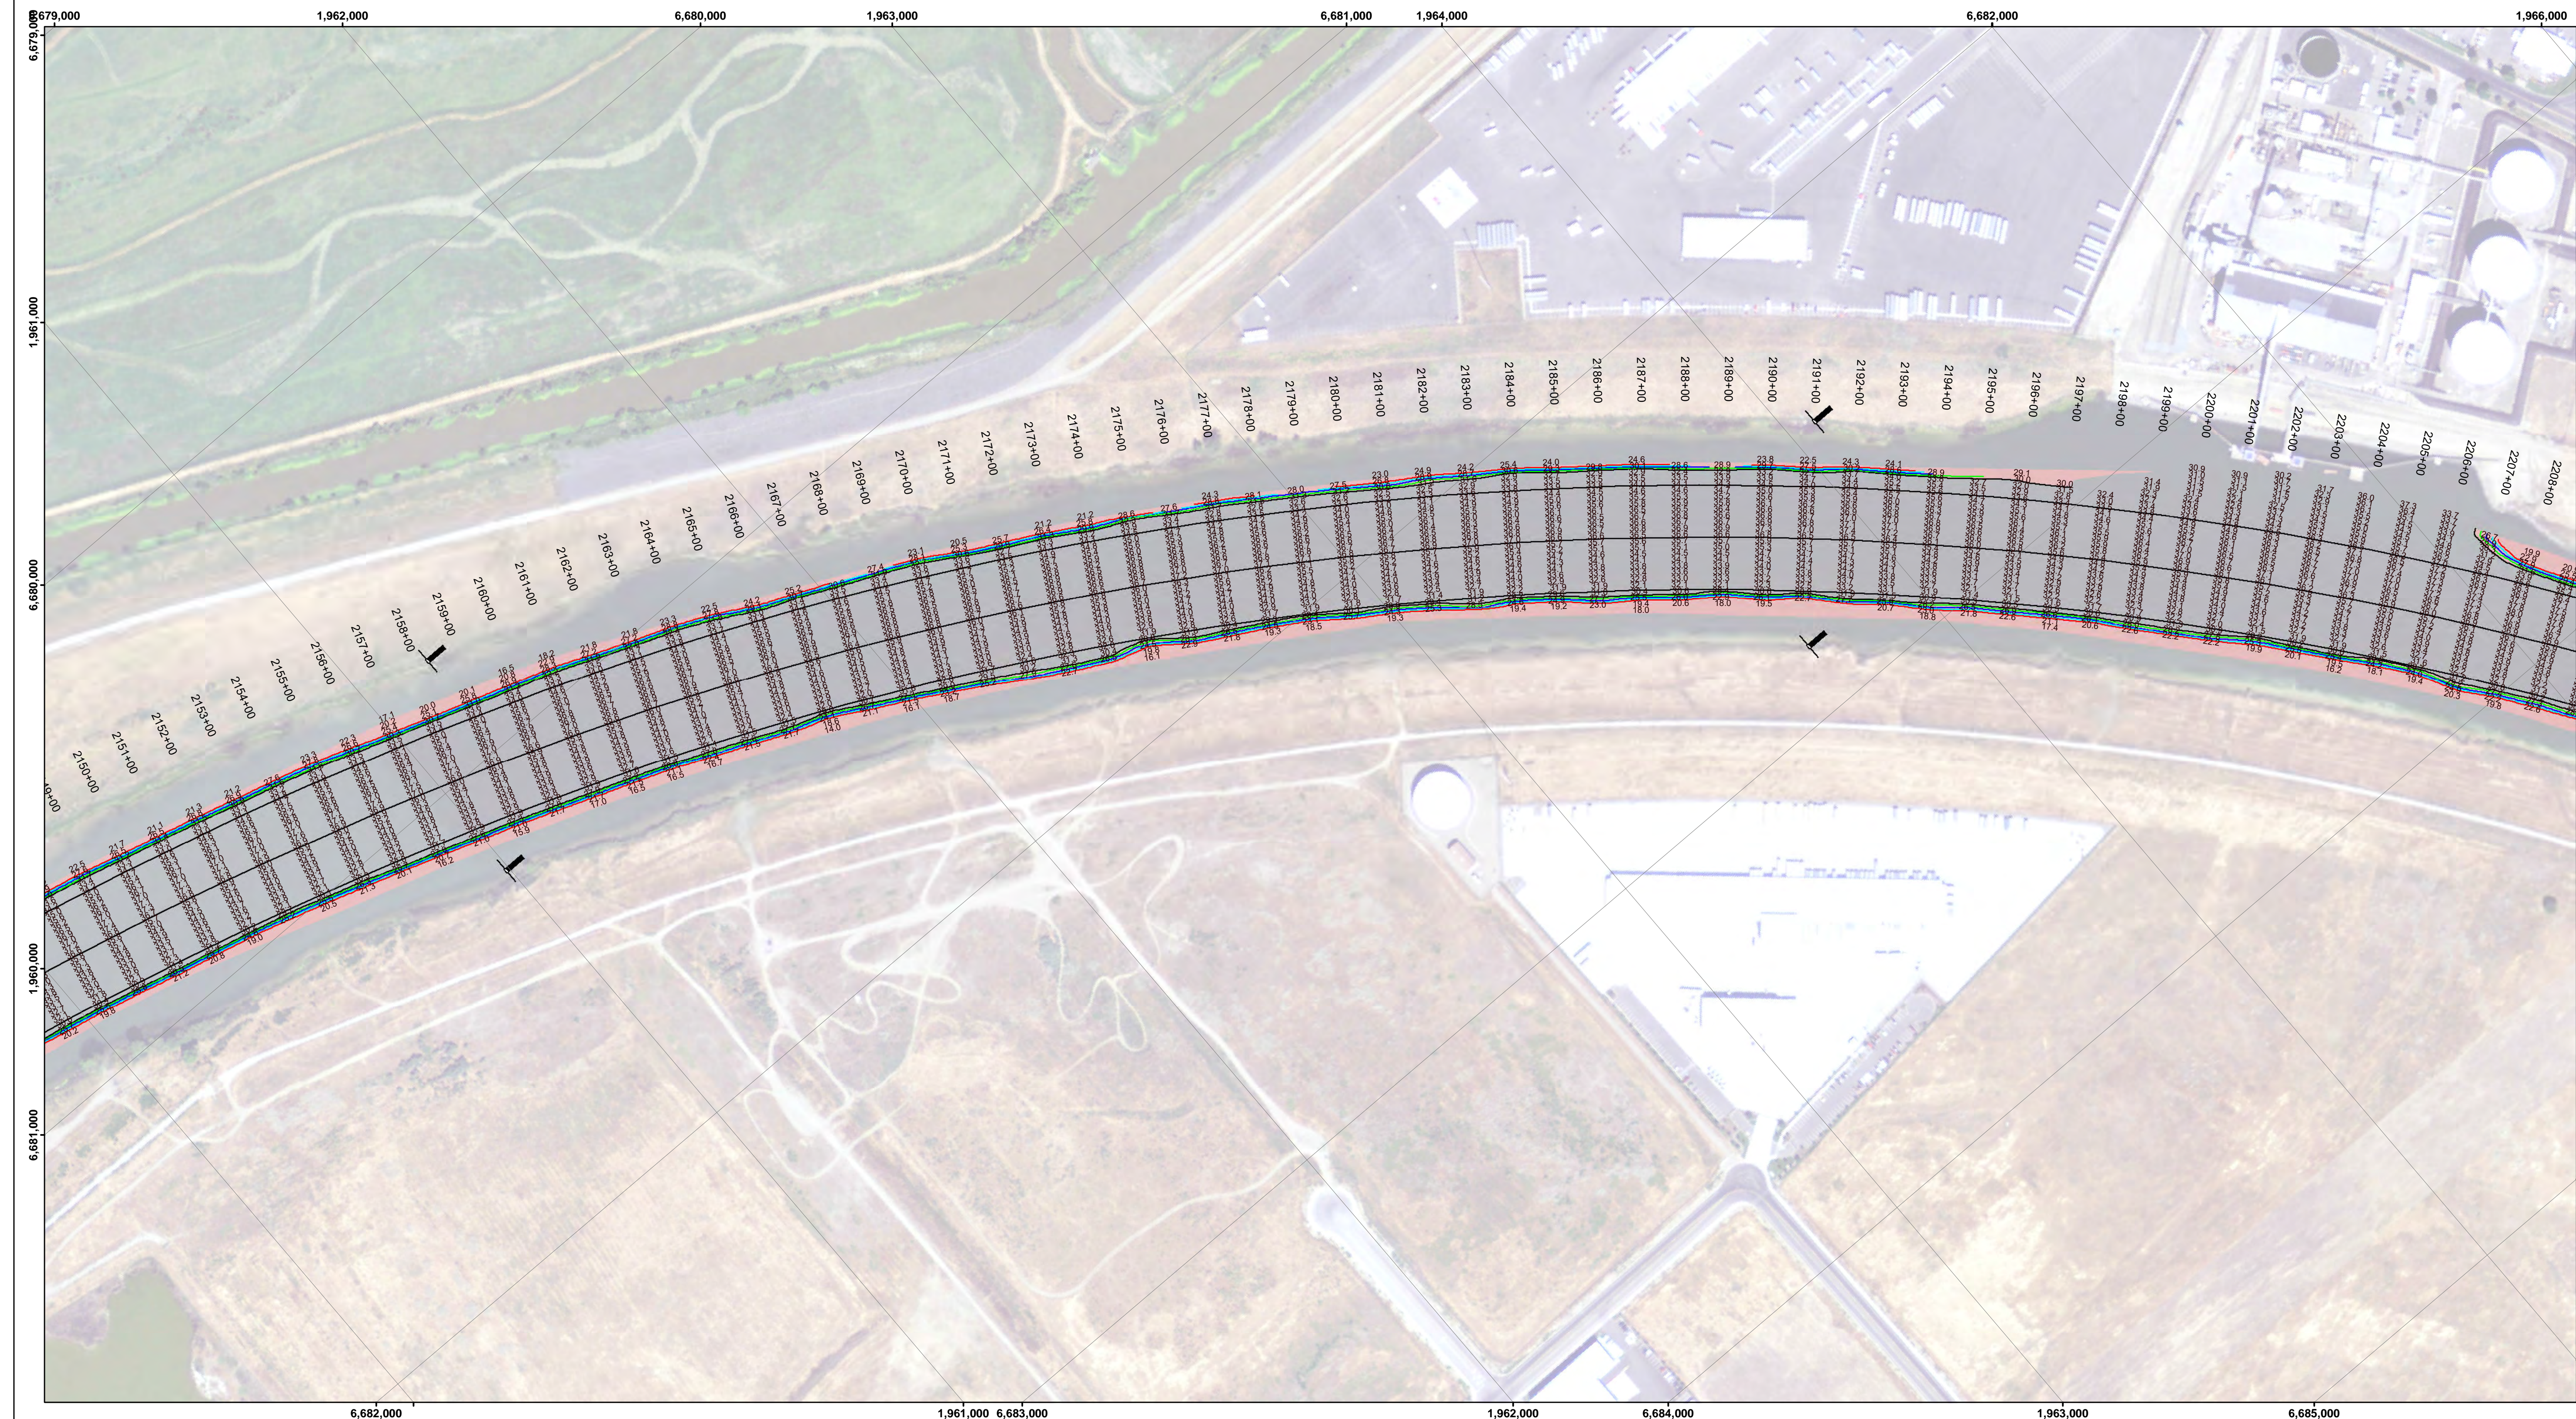


DISCLAIMER: The data represents the results of data collection/processing for a specific US Army Corps of Engineers project. It is not intended for use in any other project. Accuracy of the data is not guaranteed. The user is responsible for the results of any application of the data for other than its intended purpose.

Access Constraints: The United States Government furnishes this data and the results of its processing and uses them with the express understanding that they are not to be distributed, reproduced, or used in any way that might imply endorsement or implied concern for the accuracy, completeness, or reliability of the data. The United States shall be under no liability whatsoever to any person by reason of any use of the data, and the user shall be responsible for the results of any use of the data. The user shall be responsible for the results of any use of the data.

Prepared Under the Direction of TRAVIS J. RAYFIELD LT Colonel, C.E., District Engineer	Chart Date: Mar 12, 2018
Submitted: Hydro Survey Team Leader	Designed by: PDT
Recommended: Chief, Hydro Survey Section	Checked by: PDT
Approved: Chief, Construction Branch	Drawn by: PDT

CALIFORNIA
SAN JOAQUIN COUNTY
SACRAMENTO RIVER
CONDITION SURVEY
21, 25, 27-28 FEBRUARY 2018

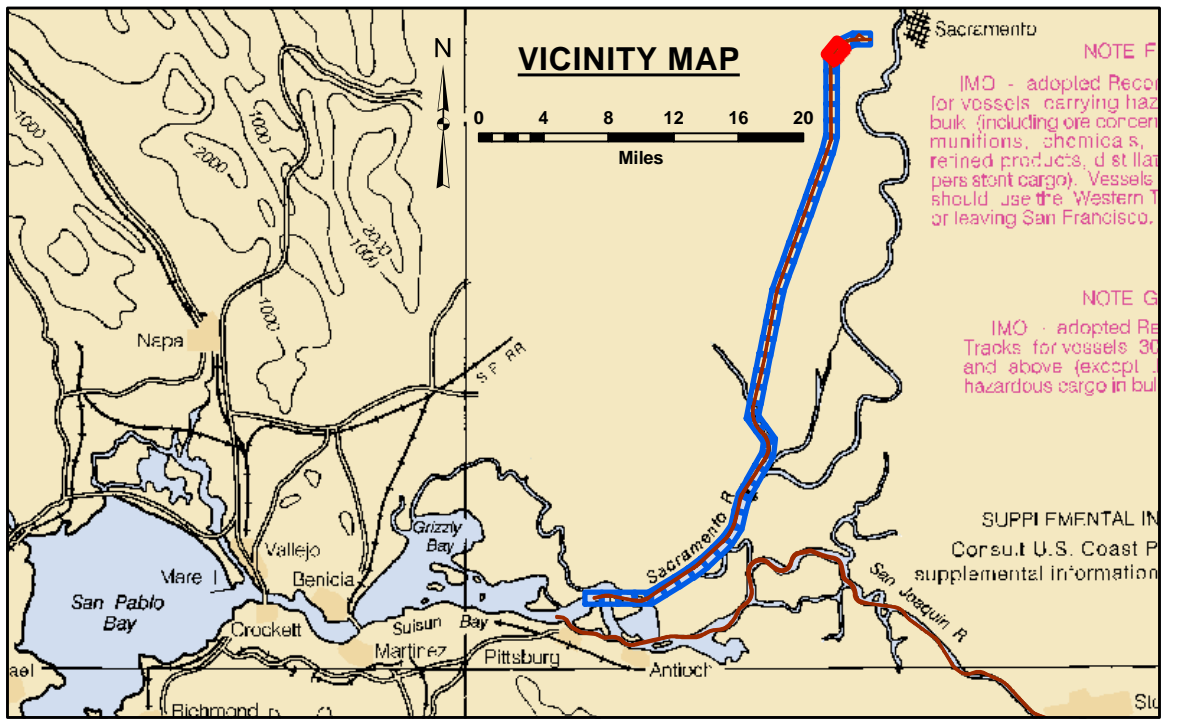

0 400 800 1,200 Feet

LEGEND

--- Federal Navigation Channel	▨ Cable Area	■ Shoaling Area	— Contours
— Federal Navigation Center Line	□ Placement Area	● Shoalest Sounding**	— -30
⋯ Cable Submarine	⊠ Anchorage Area	⊥ Beacon, General	— -29
- - - Cable Overhead	⊗ Obstruction Point	◆ Red Navigation Buoy	— -28
— Contour Line	✦ Wrecks-Submerged	◆ Green Navigation Buoy	— -27
			— -26

NOTES:
DRAWING NOT TO BE USED FOR NAVIGATION. ONLY CHANNEL CONDITION AT DATE OF SURVEY.
THE LOCATION OF ALL NAVIGATION AIDS ARE BASED ON INFORMATION PROVIDED BY THE U.S. COAST GUARD.
BUOY LOCATIONS REPRESENT THE POSITION OF THE SINKER ONLY.

SOUNDINGS WERE TAKEN BY FATHOMETER AND ARE SHOWN TO THE NEAREST TENTH OF A FOOT.

SOUNDINGS ARE BASED ON THE DATUM OF MEAN LOWER LOW WATER AT THE LOCALITY.

NORTH AMERICAN DATUM OF 1983 (NAD83), PROJECTED TO THE STATE PLANE COORDINATE SYSTEM (SPCS), CA ZONE II (0402), DISTANCE UNITS IN U.S. SURVEY FEET.

PLANE GRID AND COORDINATES ARE BASED ON LAMBERT PROJECTION, NAD 83, ZONE II CALIFORNIA AS DESCRIBED IN SPECIAL PUBLICATION NO. 235, PUBLISHED BY THE NATIONAL OCEAN SURVEY.


PROJECT DEPTH: -30'
VERTICAL DATUM: MLLW


THE LOCATION OF NAVIGATION AIDS ARE BASED ON AND PROVIDED BY THE U.S. COAST GUARD

CONTROLS:
LOCATION: RIO VISTA
NOAA STATION: 9415316
BENCHMARK: 5316 B 1996 (NO PID)
TIDE GAUGE: NAIL @ 8.2 FT MLLW
METADATA: NAIL SET BY USACE 31 MARCH, 2014

LOCATION: PORT OF WEST SACRAMENTO
NOAA STATION: 9416131
BENCHMARK: POWS1 (NO PID)
TIDE GAUGE: NAIL @ 10.0 FT MLLW
METADATA: NAIL SET BY USACE 8 APRIL, 2014

ALL HORIZONTAL POSITIONS AND MLLW ELEVATIONS WERE POST-PROCESSED USING PUBLIC GPS REFERENCE STATIONS IN THE AREA.


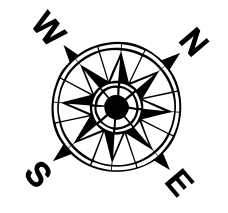


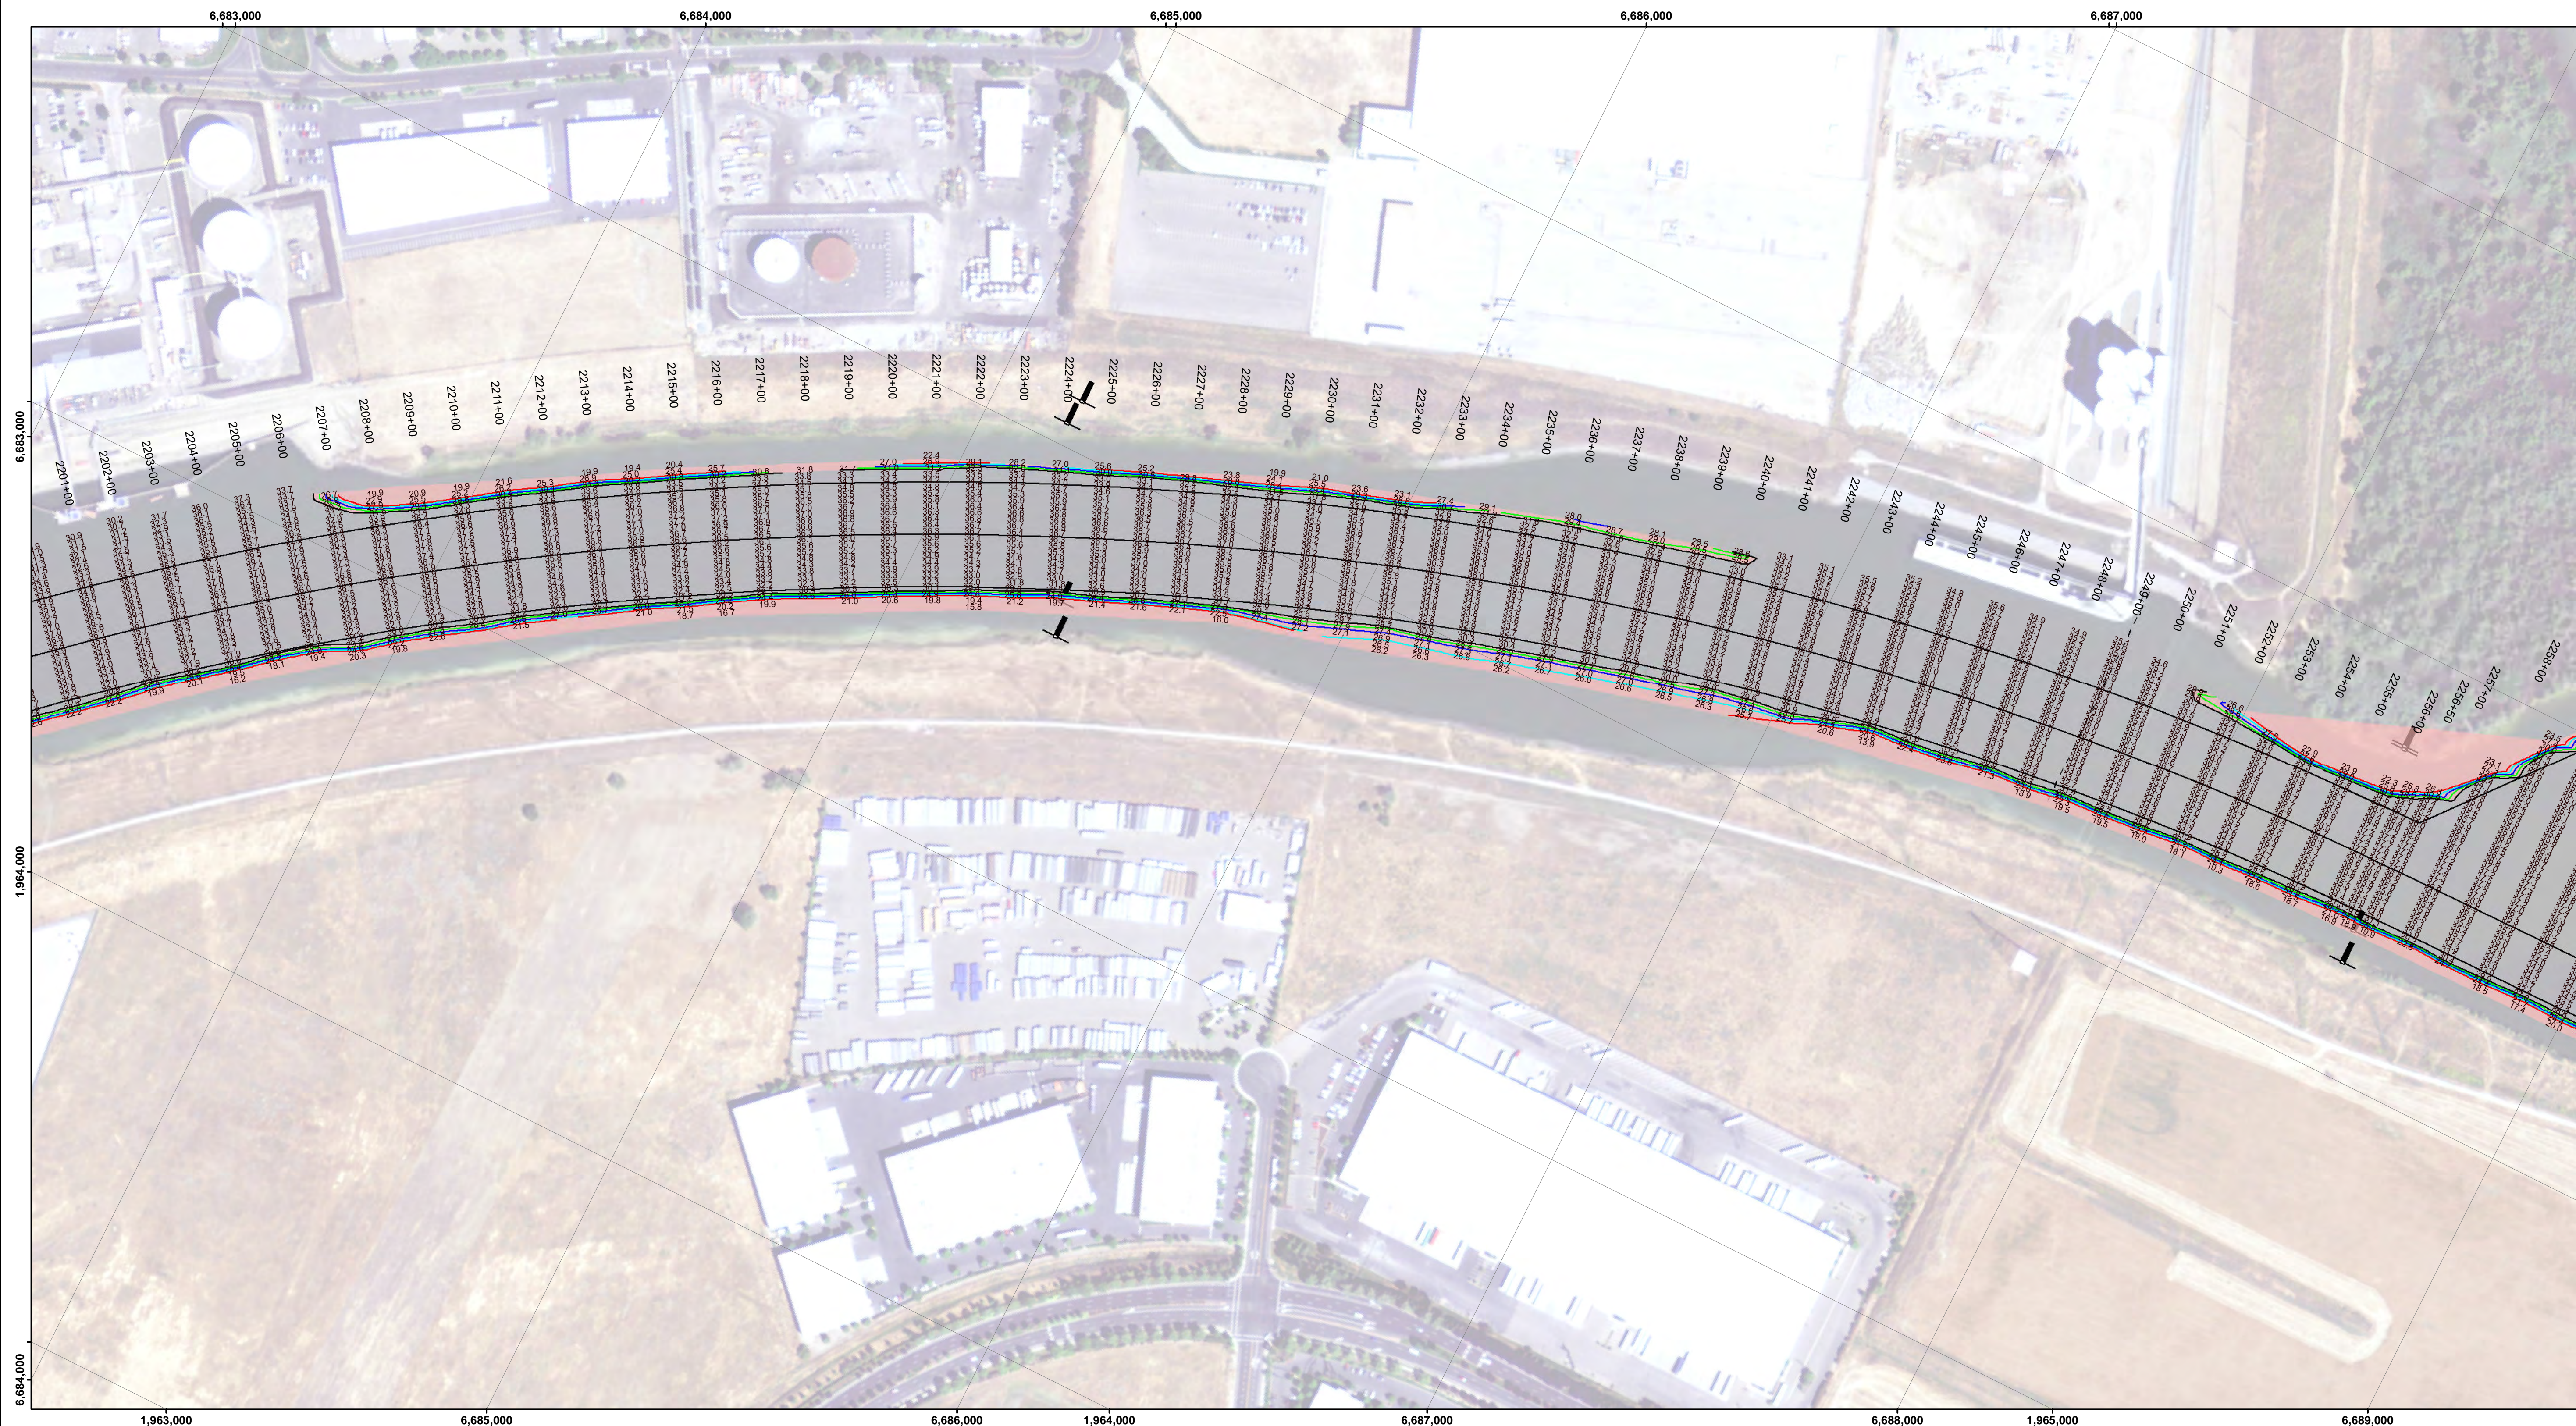

DISCLAIMER: The United States Government furnishes these data and the results therefrom to the recipient for use in connection with the recipient's operations. The user is responsible for the accuracy of the data and the results therefrom. 

Chart Date:	Mar 12, 2018
Designed by:	PDT
Drawn by:	PDT
Surveyed By:	PDT
Plotted By:	PDT
Checked By:	PDT
Approved:	Chief, Construction Branch

CALIFORNIA
 SAN JOAQUIN COUNTY
SACRAMENTO RIVER
 CONDITION SURVEY
 21, 25, 27-28 FEBRUARY 2018

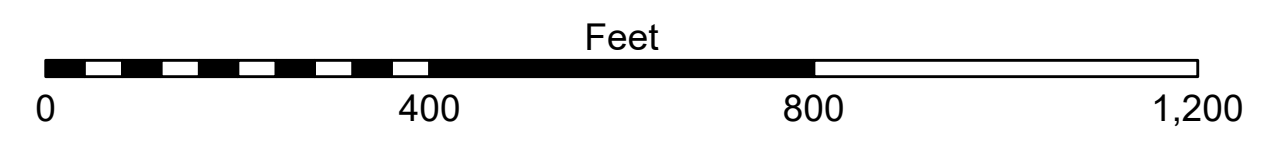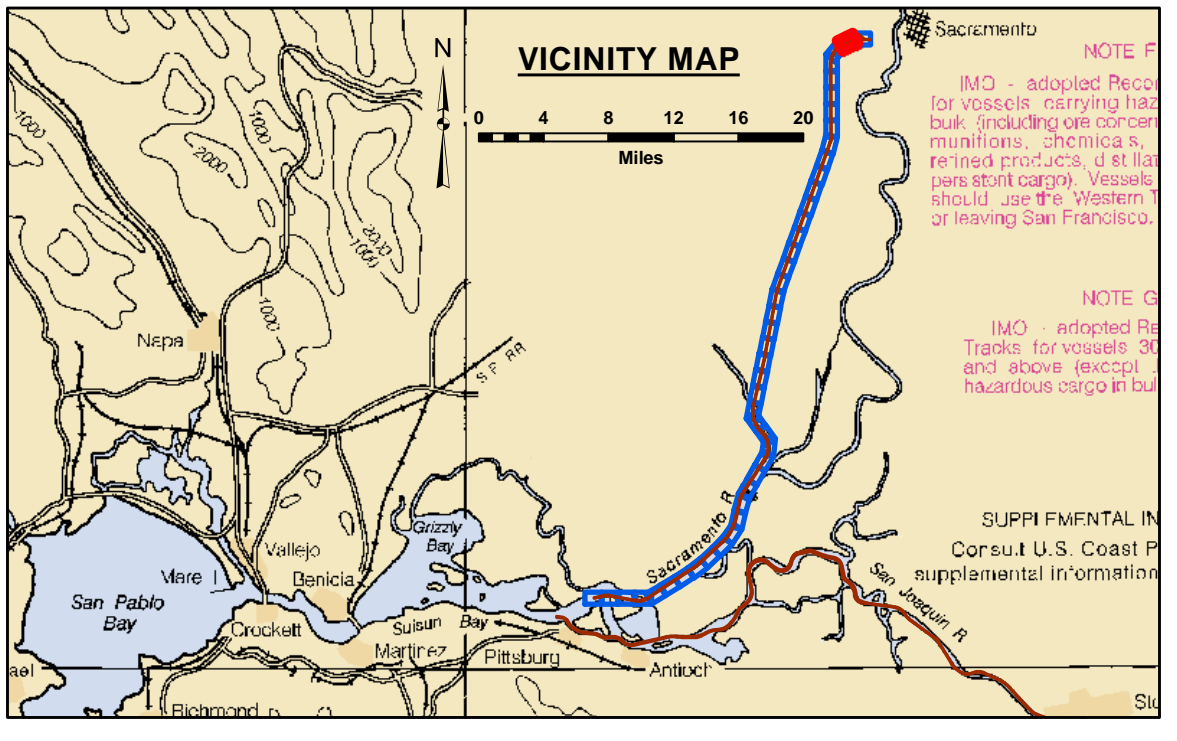

LEGEND		
--- Federal Navigation Channel	▨ Cable Area	■ Shoaling Area
— Federal Navigation Center Line	□ Placement Area	● Shoalest Sounding**
⋯ Cable Submarine	⊞ Anchorage Area	⊥ Beacon, General
- - - Cable Overhead	⊗ Obstruction Point	◆ Red Navigation Buoy
— Contour Line	✈ Wrecks-Submerged	◆ Green Navigation Buoy

Contours	
—	-30
—	-29
—	-28
—	-27
—	-26

NOTES:
 DRAWING NOT TO BE USED FOR NAVIGATION. ONLY CHANNEL CONDITION AT DATE OF SURVEY.
 THE LOCATION OF ALL NAVIGATION AIDS ARE BASED ON INFORMATION PROVIDED BY THE U.S. COAST GUARD.
 BUOY LOCATIONS REPRESENT THE POSITION OF THE SINKER ONLY.
 SOUNDINGS WERE TAKEN BY FATHOMETER AND ARE SHOWN TO THE NEAREST TENTH OF A FOOT.
 SOUNDINGS ARE BASED ON THE DATUM OF MEAN LOWER LOW WATER AT THE LOCALITY.
 NORTH AMERICAN DATUM OF 1983 (NAD83), PROJECTED TO THE STATE PLANE COORDINATE SYSTEM (SPCS), CA ZONE II (0402), DISTANCE UNITS IN U.S. SURVEY FEET.
 PLANE GRID AND COORDINATES ARE BASED ON LAMBERT PROJECTION, NAD 83, ZONE II CALIFORNIA AS DESCRIBED IN SPECIAL PUBLICATION NO. 235, PUBLISHED BY THE NATIONAL OCEAN SURVEY.
 PROJECT DEPTH: -30'
 VERTICAL DATUM: MLLW
 THE LOCATION OF NAVIGATION AIDS ARE BASED ON AND PROVIDED BY THE U.S. COAST GUARD

CONTROLS:
 LOCATION: RIO VISTA
 NOAA STATION: 9415316
 BENCHMARK: 5316 B 1996 (NO PID)
 TIDE GAUGE: NAIL @ 8.2 FT MLLW
 METADATA: NAIL SET BY USACE 31 MARCH, 2014
 LOCATION: PORT OF WEST SACRAMENTO
 NOAA STATION: 9416131
 BENCHMARK: POWS1 (NO PID)
 TIDE GAUGE: NAIL @ 10.0 FT MLLW
 METADATA: NAIL SET BY USACE 8 APRIL, 2014
 ALL HORIZONTAL POSITIONS AND MLLW ELEVATIONS WERE POST-PROCESSED USING PUBLIC GPS REFERENCE STATIONS IN THE AREA.





DISCLAIMER
 The United States Government furnishes these data and the results therefrom as they are received from the contractor and does not warrant the accuracy, completeness, or reliability of the data or the results therefrom. The user is responsible for the results of any application of the data for other than its intended purpose.
 The United States Government assumes no liability for the use of the data for other than its intended purpose. The user is responsible for the results of any application of the data for other than its intended purpose.

Chart Date:	Mar 12, 2018
Designed by:	PDT
Drawn by:	PDT
Surveyed By:	PDT
Plotted By:	PDT
Checked By:	PDT
Approved:	Chief, Construction Branch

PREPARED UNDER THE DIRECTION OF
TRAVIS J. RAYFIELD
 LT COLONEL, C.E., DISTRICT ENGINEER
 Standard: Hydro Survey Team Leader
 Recommended: Chief, Hydro Survey Section
 Approved: Chief, Construction Branch

SACRAMENTO RIVER
 CONDITION SURVEY
 21, 25, 27-28 FEBRUARY 2018
45 of 45

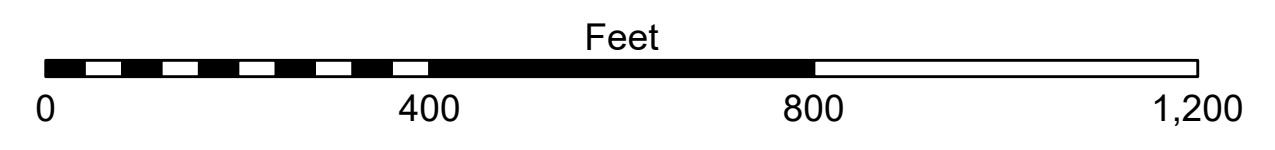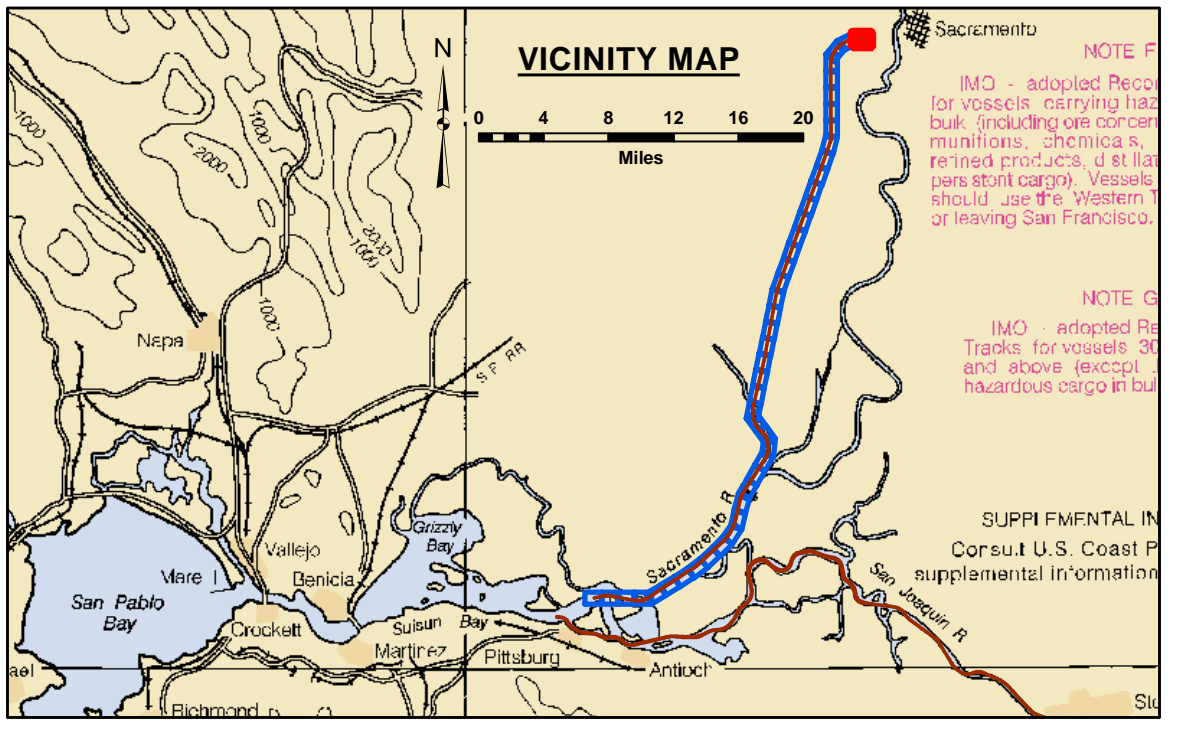

LEGEND		Contours	
--- Federal Navigation Channel	▨ Cable Area	— -30	
— Federal Navigation Center Line	□ Placement Area	— -29	
⋯ Cable Submarine	⊠ Anchorage Area	— -28	
- - - Cable Overhead	⊗ Obstruction Point	— -27	
— Contour Line	⚓ Wrecks-Submerged	— -26	
			● Shoalest Sounding**
			⬇ Beacon, General
			◆ Red Navigation Buoy
			◆ Green Navigation Buoy

NOTES:
 DRAWING NOT TO BE USED FOR NAVIGATION. ONLY CHANNEL CONDITION AT DATE OF SURVEY.
 THE LOCATION OF ALL NAVIGATION AIDS ARE BASED ON INFORMATION PROVIDED BY THE U.S. COAST GUARD.
 BUOY LOCATIONS REPRESENT THE POSITION OF THE SINKER ONLY.
 SOUNDINGS WERE TAKEN BY FATHOMETER AND ARE SHOWN TO THE NEAREST TENTH OF A FOOT.
 SOUNDINGS ARE BASED ON THE DATUM OF MEAN LOWER LOW WATER AT THE LOCALITY.
 NORTH AMERICAN DATUM OF 1983 (NAD83), PROJECTED TO THE STATE PLANE COORDINATE SYSTEM (SPCS),
 CA ZONE II (0402), DISTANCE UNITS IN U.S. SURVEY FEET.
 PLANE GRID AND COORDINATES ARE BASED ON LAMBERT PROJECTION, NAD 83,
 ZONE II CALIFORNIA AS DESCRIBED IN SPECIAL PUBLICATION NO. 235,
 PUBLISHED BY THE NATIONAL OCEAN SURVEY.
 PROJECT DEPTH: -30'
 VERTICAL DATUM: MLLW
 THE LOCATION OF NAVIGATION AIDS ARE BASED ON AND PROVIDED BY THE U.S. COAST GUARD

CONTROLS:
 LOCATION: RIO VISTA
 NOAA STATION: 9415316
 BENCHMARK: 5316 B 1996 (NO PID)
 TIDE GAUGE: NAIL @ 8.2 FT MLLW
 METADATA: NAIL SET BY USACE 31 MARCH, 2014
 LOCATION: PORT OF WEST SACRAMENTO
 NOAA STATION: 9416131
 BENCHMARK: POWS1 (NO PID)
 TIDE GAUGE: NAIL @ 10.0 FT MLLW
 METADATA: NAIL SET BY USACE 8 APRIL, 2014
 ALL HORIZONTAL POSITIONS AND MLLW ELEVATIONS WERE
 POST-PROCESSED USING PUBLIC GPS
 REFERENCE STATIONS IN THE AREA.

